



Wisconsin Department of Transportation

November 30, 2015

Division of Transportation Systems Development

Bureau of Project Development
 4802 Sheboygan Avenue, Rm 601
 P O Box 7916
 Madison, WI 53707-7916

Telephone: (608) 266-1631
 Facsimile (FAX): (608) 266-8459

NOTICE TO ALL CONTRACTORS:

Proposal #10: 1060-34-84
Zoo IC, Center Street Bridge
Over USH 45
USH 45
Milwaukee County

1060-35-85
Zoo IC, Center Street Sidewalk
114th Street to 117th Street
Off System
Milwaukee County

Letting of December 8, 2015

This is Addendum No. 01, which provides for the following:

Special Provisions

| Revised Special Provisions | |
|----------------------------|---|
| Article No. | Description |
| 3 | Prosecution and Progress – Added Northern Long-Eared Bat language |
| 8 | Other Contracts – Added information regarding City of Wauwatosa Storm Sewer project |

Schedule of Items

| Revised Bid Item Quantities | | | | | |
|-----------------------------|--|------|--------------|------------------|----------------|
| Bid Item | Item Description | Unit | Old Quantity | Revised Quantity | Proposal Total |
| 204.0220 | Removing Inlets | EACH | 13 | -5 | 8 |
| 204.0245 | Removing Storm Sewer (size) 0001. (12-Inch) | LF | 111 | -60 | 51 |
| 204.0245 | Removing Storm Sewer (size) 0002. (15-Inch) | LF | 114 | -21 | 93 |
| 204.0280 | Sealing Pipes | EACH | 10 | -1 | 9 |
| 520.8000 | Concrete Collars For Pipe | EACH | 12 | -6 | 6 |
| 608.0312 | Storm Sewer Pipe Reinforced Concrete Class III 12-Inch | LF | 395 | -198 | 197 |
| 608.0315 | Storm Sewer Pipe Reinforced Concrete Class III 15-Inch | LF | 216 | -80 | 136 |
| 608.0318 | Storm Sewer Pipe Reinforced Concrete Class III 18-Inch | LF | 211 | -27 | 184 |
| 611.0535 | Manhole Covers Type J-Special | EACH | 3 | -1 | 2 |
| 611.0624 | Inlet Covers Type H | EACH | 16 | -8 | 8 |

| | | | | | |
|----------|--------------------------|------|----|----|----|
| 611.0642 | Inlet Covers Type MS | EACH | 5 | -2 | 3 |
| 611.2008 | Manholes 8-Ft Diameter | EACH | 2 | -1 | 1 |
| 611.3004 | Inlets 4-Ft Diameter | EACH | 22 | -3 | 19 |
| 611.3230 | Inlets 2x3-Ft | EACH | 6 | -5 | 1 |
| 611.3901 | Inlets Median 1 Grate | EACH | 5 | -2 | 3 |
| 611.8110 | Adjusting Manhole Covers | EACH | 4 | -1 | 3 |
| 611.8115 | Adjusting Inlet Covers | EACH | 9 | -2 | 7 |

| Added Bid Item Quantities | | | | | |
|---------------------------|--------------------------------------|------|--------------|------------------|----------------|
| Bid Item | Item Description | Unit | Old Quantity | Revised Quantity | Proposal Total |
| 616.0329 | Gates Chain Link (Width) 0002. 12-Ft | EACH | 0 | 4 | 4 |

| Deleted Bid Item Quantities | | | | | |
|-----------------------------|--------------------------------------|------|--------------|------------------|----------------|
| Bid Item | Item Description | Unit | Old Quantity | Revised Quantity | Proposal Total |
| 611.0420 | Reconstructing Manholes | EACH | 2 | -2 | 0 |
| 616.0329 | Gates Chain Link (Width) 0001. 10-Ft | EACH | 4 | -4 | 0 |

Plan Sheets

| Revised Plan Sheets | |
|---------------------|---|
| Plan Sheet | Plan Sheet Title (brief description of changes to sheet) |
| 39 | Plan Details – Removed sections of proposed storm sewer due to Wauwatosa storm sewer project |
| 40 | Plan Details – Removed sections of proposed storm sewer due to Wauwatosa storm sewer project |
| 47 | Grades – Removed sections of proposed storm sewer due to Wauwatosa storm sewer project |
| 58 | Contour Map – Removed sections of proposed storm sewer due to Wauwatosa storm sewer project |
| 59 | Contour Map – Removed sections of proposed storm sewer due to Wauwatosa storm sewer project |
| 67 | Erosion Control - Legend – Update notes with information regarding inlet protection for future Wauwatosa Storm Sewer project installed inlets |
| 68 | Erosion Control – Removed sections of proposed storm sewer due to Wauwatosa storm sewer project |
| 69 | Erosion Control – Removed sections of proposed storm sewer due to Wauwatosa storm sewer project |
| 75 | Storm Sewer - Construction Details – Added applicable station ranges for backfill slurry |
| 79 | Storm Sewer - Removals – Removed activities due to Wauwatosa Storm Sewer project |
| 82 | Storm Sewer - Removals – Removed activities due to Wauwatosa Storm Sewer project |
| 89 | Planting – Removed sections of proposed storm sewer due to Wauwatosa storm sewer project |
| 164 | Alignment Layout - Survey Control Overview – updated survey control point data |
| 165 | Alignment Layout - Survey Control Overview – updated survey control point data |
| 166 | Alignment Layout - Survey Control – updated survey control point data |
| 167 | Alignment Layout - Survey Control – removed incorrect background mapping |
| 193 | Miscellaneous Quantities – Increased size of Fence Gate (Bid Item No. 616.0329.0001) from 10-FT to 12-FT |
| 195 | Miscellaneous Quantities – Decreased quantities due to Wauwatosa Storm Sewer project |
| 196 | Miscellaneous Quantities – Adjusted quantities due to Wauwatosa Storm Sewer project |
| 199 | Miscellaneous Quantities – Added remaining data from previous sheet 198 to sheet 199 |

| | |
|-----|---|
| 200 | Miscellaneous Quantities – Added comments to structure comments column |
| 201 | Miscellaneous Quantities – Added comments to structure comments column |
| 202 | Miscellaneous Quantities – Decreased quantities due to Wauwatosa Storm Sewer project |
| 229 | Plan and Profile: W. Center Street – Removed sections of proposed storm sewer due to Wauwatosa storm sewer project |
| 231 | Plan and Profile: N. 113 th Street – Removed sections of proposed storm sewer due to Wauwatosa storm sewer project |
| 399 | Structure R-40-577 – Clarified General Notes |
| 406 | Structure R-40-578 – Clarified General Notes |

| Added Plan Sheets | |
|--------------------------|---|
| Plan Sheet | Plan Sheet Title (brief description of why sheet was added) |
| 167A | Alignment Layout - Survey Control – Added survey control points |
| 264A | S.D.D. 13C1-18 – Added due to inclusion of S.D.D. 13C13-8 |

| Deleted Plan Sheets | |
|----------------------------|--|
| Plan Sheet | Plan Sheet Title (brief description of why sheet was deleted) |
| 70 | Erosion Control – Duplicate of Sheet 68 |
| 198 | Miscellaneous Quantities – Deleted data due to Wauwatosa Storm Sewer project and combined remaining information onto Sheet 199 |

The responsibility for notifying potential subcontractors and suppliers of these changes remains with the prime contractor.

Sincerely,

Mike Coleman

Proposal Development Specialist
Proposal Management Section

ADDENDUM NO. 1
1060-34-84/1060-35-85
November 30, 2015

Special Provisions

3. Prosecution and Progress

*Replace entire language under section titled **Northern Long-Eared Bat** with the following:*

Northern Long-eared Bat (*Myotis septentrionalis*)

Northern Long-eared Bats (NLEB) have the potential to inhabit the project limits because they roost in trees and structures (bridges, culverts, buildings). Roosts may not have been observed on this project, but conditions to support the species exist. The species and all active roosts are protected by the Federal Endangered Species Act.

In order to avoid adverse impacts upon the NLEBs, no vegetation clearing and grubbing within the identified clearing and grubbing limits will be allowed from April 1 to September 30, both dates inclusive.

If the required clearing and removal is not completed by March 31, the department will suspend all clearing and associated work directly impacted by clearing. The department will issue a notice to proceed with clearing and associated work directly impacted by clearing after consulting with the United States Fish and Wildlife Service (USFWS).

Submit a schedule and description of Clearing and/or Grubbing operations with the ECIP 14 days prior to any Clearing operations. The department will determine, based on schedule and scope of work, what additional erosion control measures shall be implemented prior to the start of Clearing operations, and list those additional measures in the ECIP.

Notify the Project Leader 14 days in advance of any work on box culverts or bridges between April 1 and September 30 to allow time for department to complete the Bat Presence Structure Inspection Form.

If bats or evidence of bats are not found during the inspection, construction may proceed.

If bats or evidence of bats are found during the inspection, construction activities affecting the structure's roosting potential must stop until the WisDOT Regional Environmental Coordinator completes consultation with the Wisconsin Department of Natural Resources (WDNR) and/or United States Fish and Wildlife Service (USFWS).

8. Other Contracts

Replace entire article language with the following:

Coordinate your work according to standard spec 105.5.

Modifications to the traffic control plan may be required by the engineer to be safe and consistent with the adjacent work by others.

The following projects may be under construction concurrently with the work under this contract. Coordinate activities, detours, work zone traffic control, roadway and lane closures, and other work items as required with other contracts.

Modifications to the traffic control plan may be required by the engineer to be safe and consistent with the adjacent work by others.

City of Wauwatosa – Center Street Storm Sewer

City let reconstruction project of storm sewer from 113th Street to 116th Street. Project scope consists of total reconstruct of storm sewer system on Center Street from 113th Street to 116th Street including reconstruction of storm sewer trunk line and laterals. In addition, storm sewer reconstruction work will also occur north of Center Street and east of Wauwatosa West High School, on 113th Street and on 116th Street. Work is anticipated in spring/summer 2016 and will need to be coordinated with the 1060-34-84 and 1060-35-85 projects.

City of Wauwatosa contact: Bill Wehrley; (414)-479-8929

Project 1060-33-80

Zoo IC, Zoo Interchange Phase 1

WisDOT contact: Mark Klipstein; (414) 750-1496

Project 1060-33-81

Zoo IC, Zoo Interchange Phase 2

WisDOT contact: Mark Klipstein; (414) 750-1496

Schedule of Items

Attached, dated November 30, 2015, are the revised Schedule of Items Pages 1 – 27.

Plan Sheets


The following 8½ x 11-inch sheets are attached and made part of the plans for this proposal:

Revised: 39, 40, 47, 58, 59, 67, 68, 69, 75, 79, 82, 89, 164, 165, 166, 167, 193, 195, 196, 199, 200, 201, 202, 229, 231, 399, and 406.


Added: 167A, and 264A.

END OF ADDENDUM

Addendum No. 01
 ID 1060-34-84 &
 ID 1060-35-85
 Revised Sheet 39
 November 30, 2015

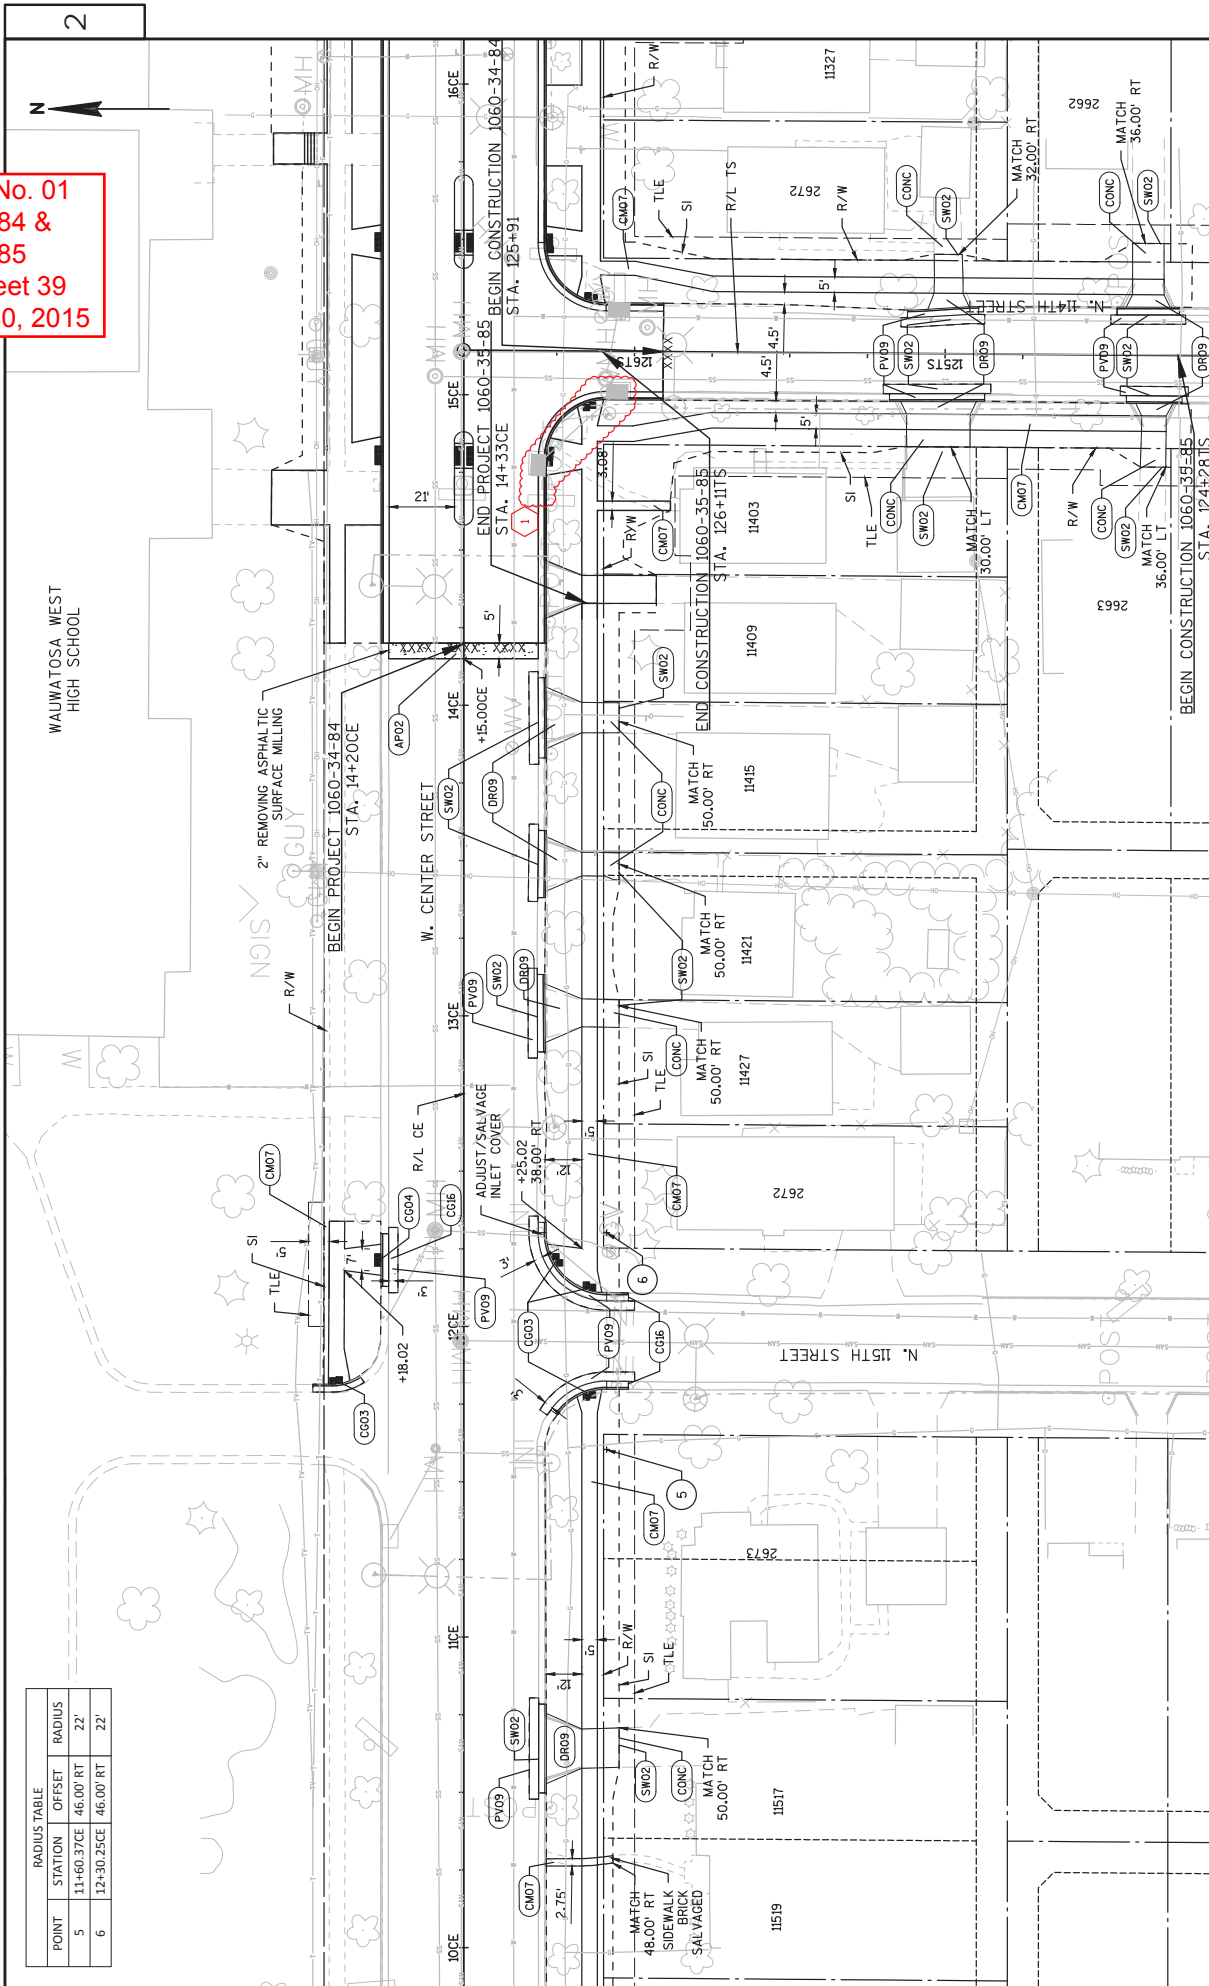

| RADIUS TABLE | | |
|--------------|------------|-----------|
| POINT | STATION | RADIUS |
| 5 | 11+60.37CE | 46.00' RT |
| 6 | 12+30.25CE | 46.00' RT |

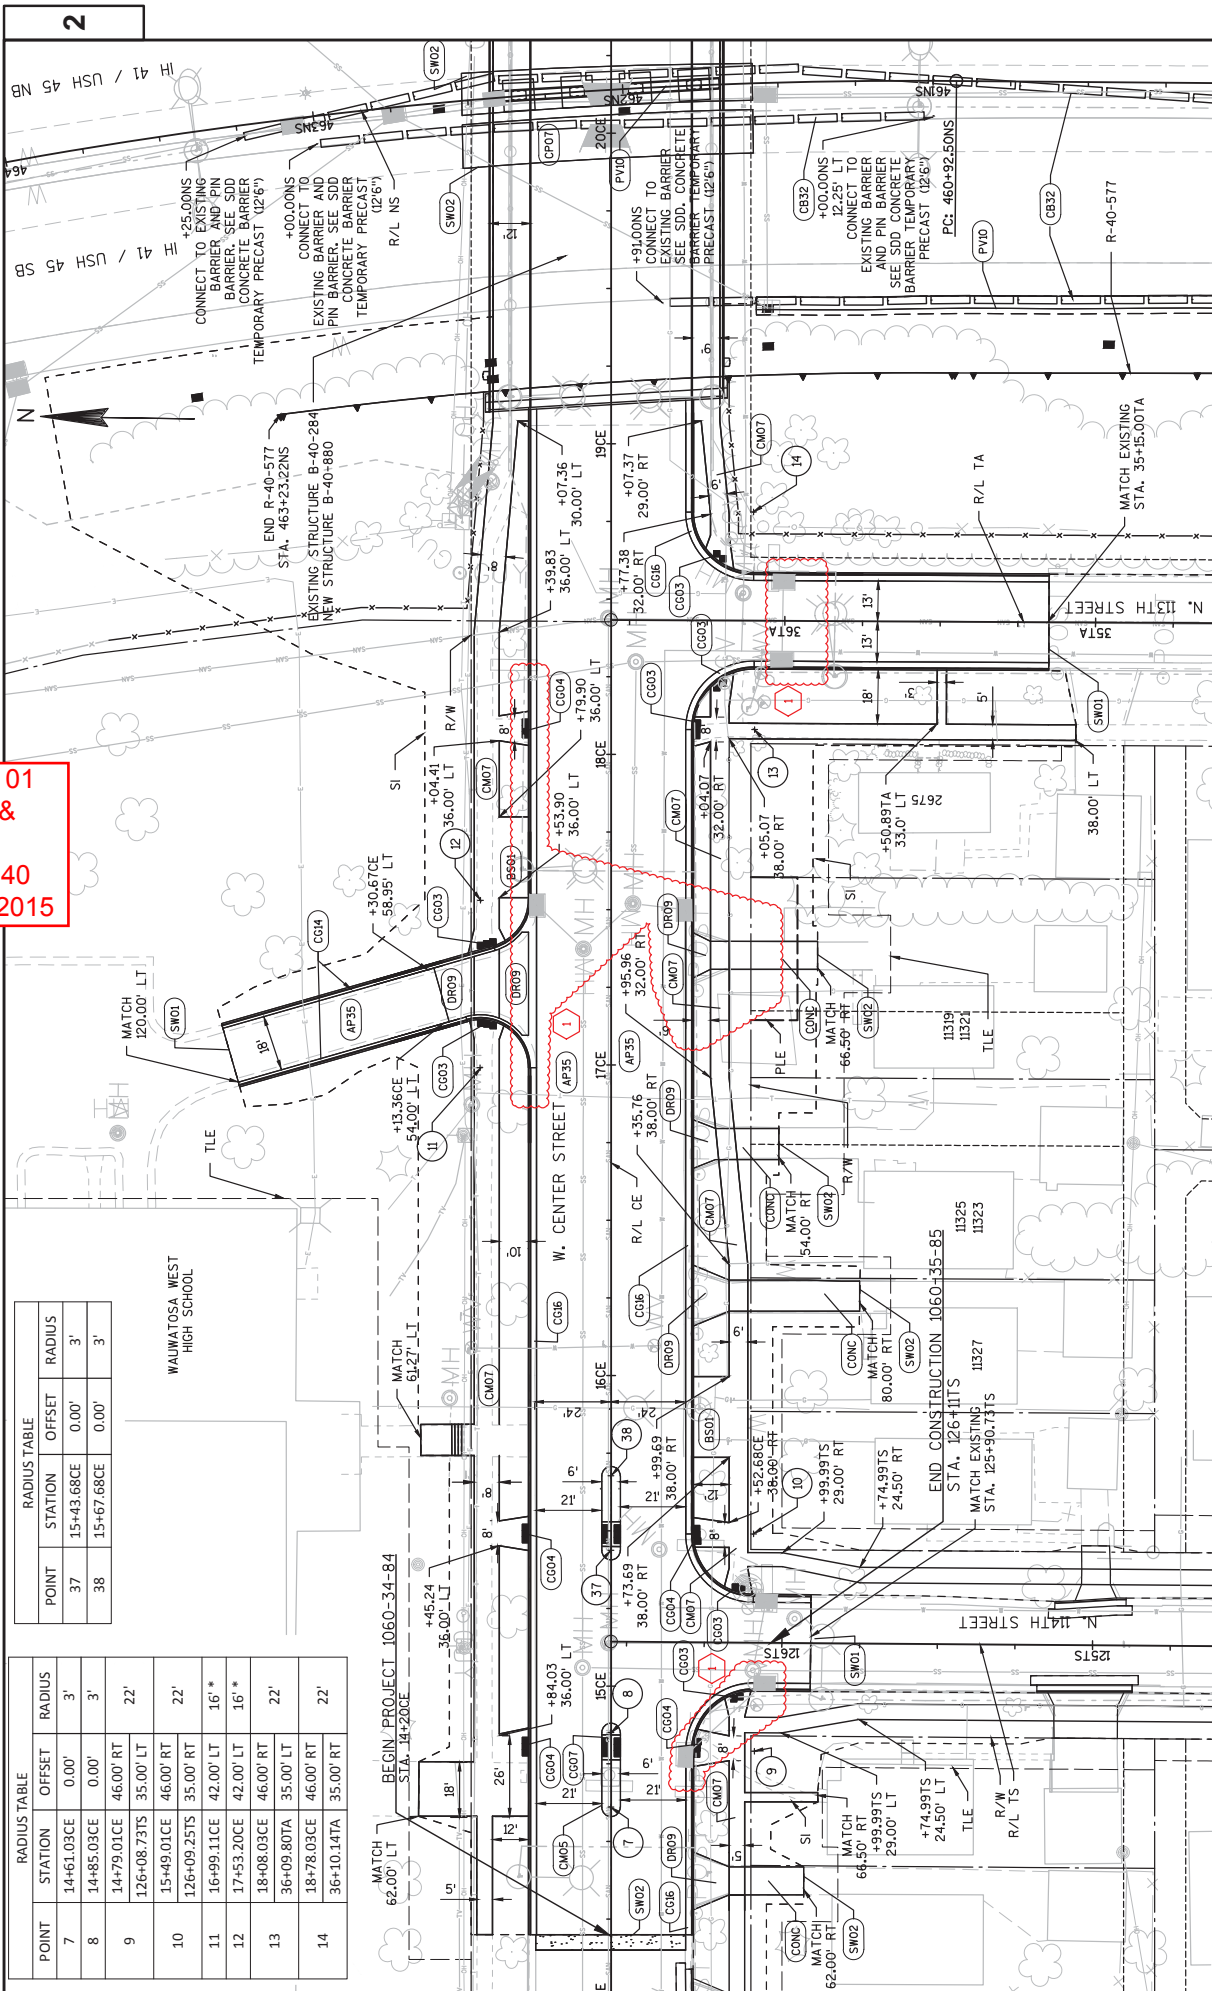

| RADIUS TABLE | | | |
|--------------|------------|--------|--------|
| POINT | STATION | OFFSET | RADIUS |
| 37 | 15+43.68CE | 0.00' | 3' |
| 38 | 15+67.68CE | 0.00' | 3' |


| RADIUS TABLE | | | |
|--------------|-------------|-----------|--------|
| POINT | STATION | OFFSET | RADIUS |
| 7 | 14+61.03CE | 0.00' | 3' |
| 8 | 14+85.03CE | 0.00' | 3' |
| 9 | 14+79.01CE | 46.00' RT | 22' |
| | 126+08.73TS | 35.00' LT | |
| 10 | 15+49.01CE | 46.00' RT | 22' |
| | 126+09.25TS | 35.00' RT | |
| 11 | 16+99.11CE | 42.00' LT | 16' |
| 12 | 17+53.20CE | 42.00' LT | 16' |
| 13 | 18+08.03CE | 46.00' RT | 22' |
| | 18+78.03CE | 46.00' RT | |
| 14 | 36+10.14TA | 35.00' RT | 22' |

Addendum No. 01
 ID 1060-34-84 &
 ID 1060-35-85
 Revised Sheet 40
 November 30, 2015

2

NOTES:
 CURB AND GUTTER GRADES ARE GIVEN TO THE FLANGE
 OF CURB AND GUTTER
 EXISTING GROUND ELEVATIONS TO BE VERIFIED BY CONTRACTOR
 XXX.XXE = EXISTING GRADES
 XXX.XX = PROPOSED GRADES

2

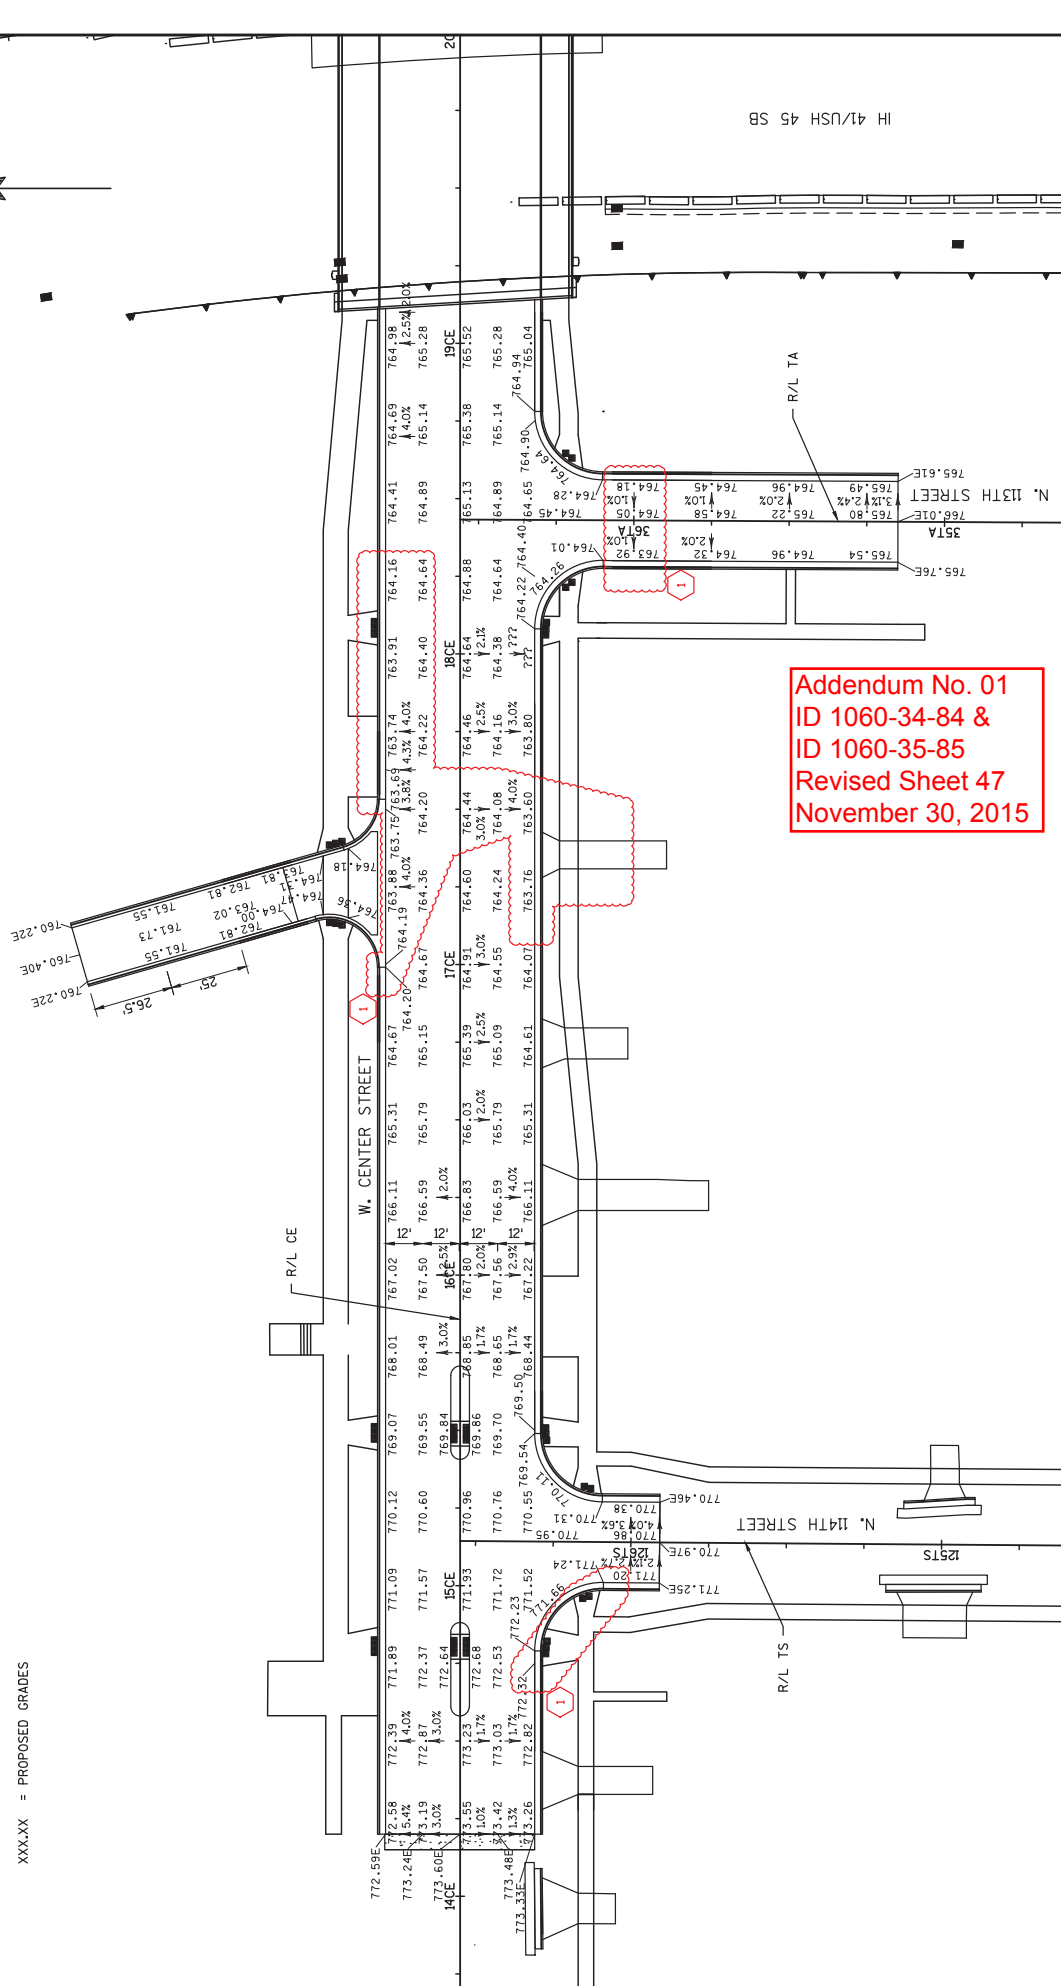

Addendum No. 01
 ID 1060-34-84 &
 ID 1060-35-85
 Revised Sheet 47
 November 30, 2015

PROJECT NO: 1060-34-84/1060-35-85

HWY: IH 41


COUNTY: MILWAUKEE

GRADES

SHEET 47

FILE NAME : W:\NPOS\C3D\CAD\10603484\021401_OR.DWG
 PLOT DATE : 11/23/2015 2:26 PM
 PLOT BY : GIBSON, NICOLE E
 PLOT NAME : PLOT SCALE : 1" = 40' .XREF
 WSDOT/CADD SHEET 42

Addendum No. 01
ID 1060-34-84 &
ID 1060-35-85
Revised Sheet 58
November 30, 2015

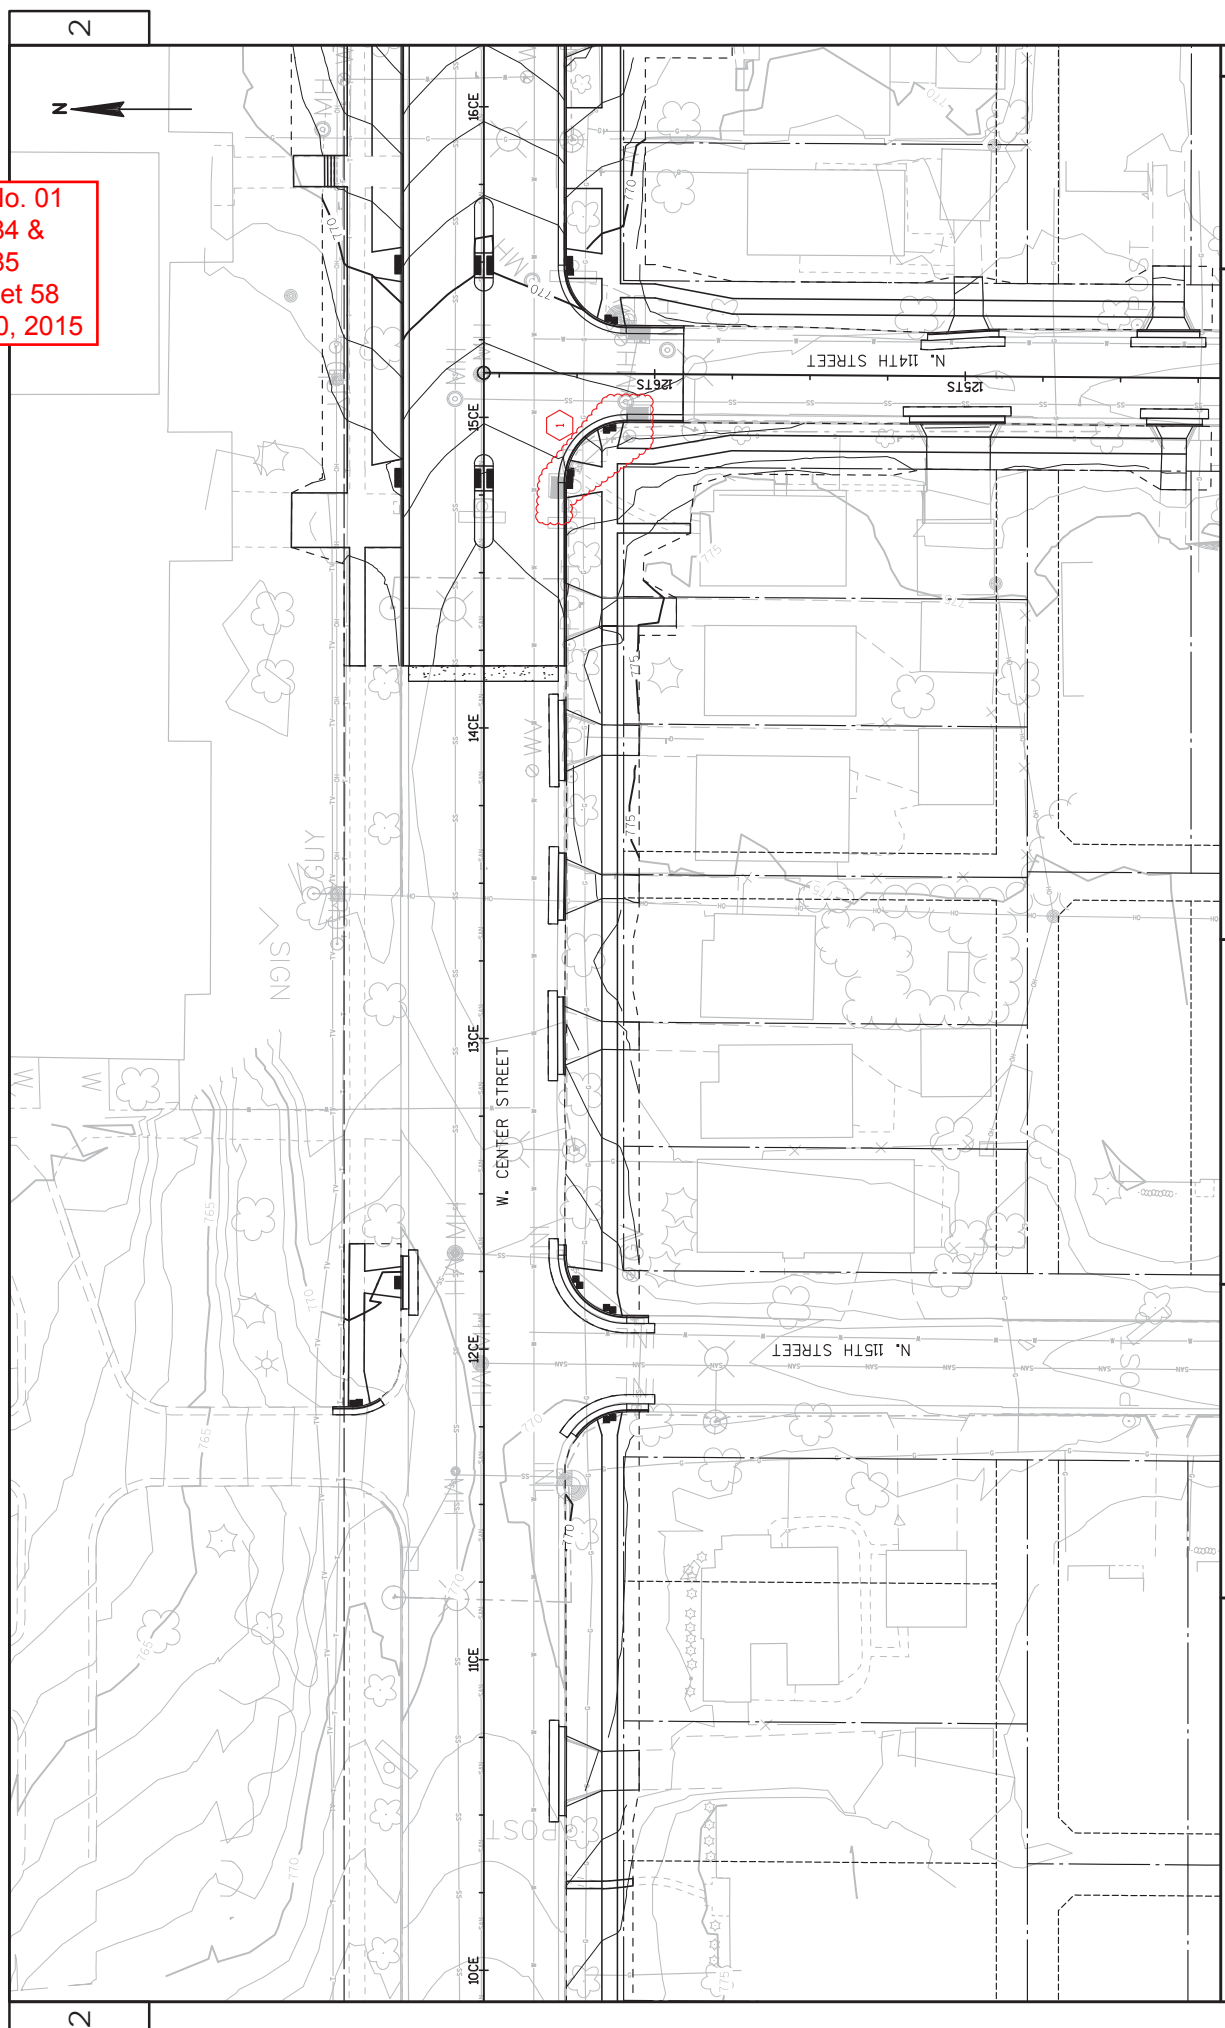


2


2

PROJECT NO: 1060-34-84/1060-35-85
HWY: IH 41
COUNTY: MILWAUKEE
CONTOUR MAP
SHEET 58
E

FILE NAME : W:\POS\CAD\10603484\021601_CM.DWG
LAYOUT NAME - 021602_CM
PLOT DATE : 11/23/2015 3:23 PM
PLOT BY : GIBSON, NICOLE E
PLOT NAME :
PLOT SCALE : 1 IN=40 FT
WSDOT/CADD SHEET 42

Addendum No. 01
ID 1060-34-84 &
ID 1060-35-85
Revised Sheet 59
November 30, 2015

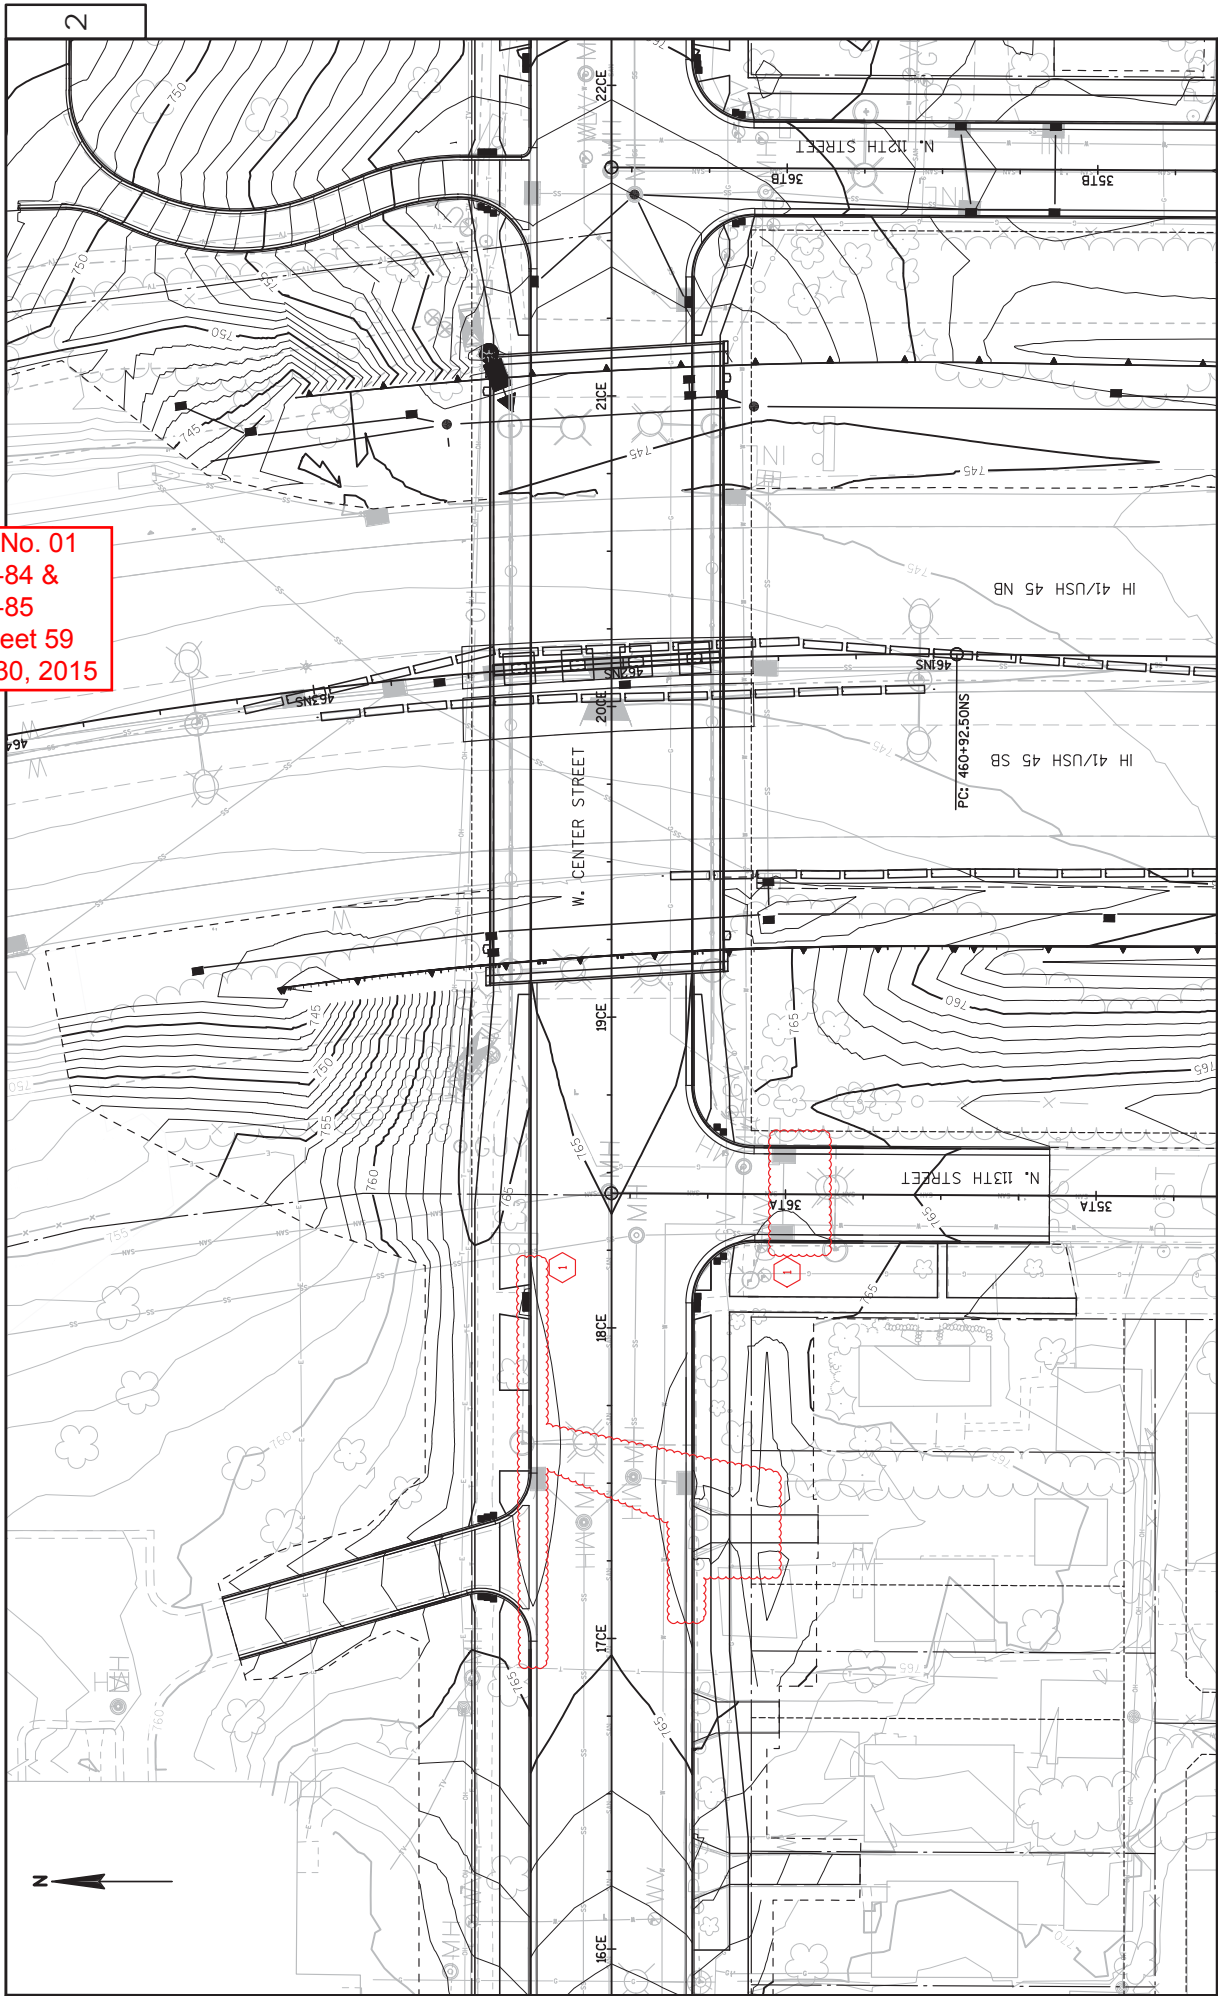


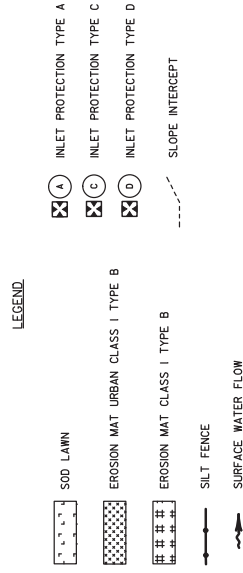

NOTES:


1. USE EROSION MAT CLASS I TYPE B WITHIN THE RIGHT-OF-WAY FENCE. EROSION MAT URBAN CLASS I TYPE B SHOULD BE USED ON DISTURBED AREAS OUTSIDE THE RIGHT-OF-WAY FENCE. EROSION MATS ARE NOT TO BE INSTALLED IN WATER.
2. INSTALL TYPE A INLET PROTECTION AS SHOWN IN THE PLANS. UNTIL GRADES ARE FINALIZED, AFTER GRADING AROUND INLETS IS FINISHED, INSTALL ALTERNATE INLET PROTECTION AS IDENTIFIED IN THE PLANS.
3. INLET PROTECTION SHOWN ON PLANS SHOULD BE ADJUSTED IN THE FIELD AS NEEDED TO MATCH THE CITY OF WAUWATOSA'S LOCAL STORM SEWER PROJECT.

Addendum No. 01
 ID 1060-34-84 &
 ID 1060-35-85
 Revised Sheet 67
 November 30, 2015

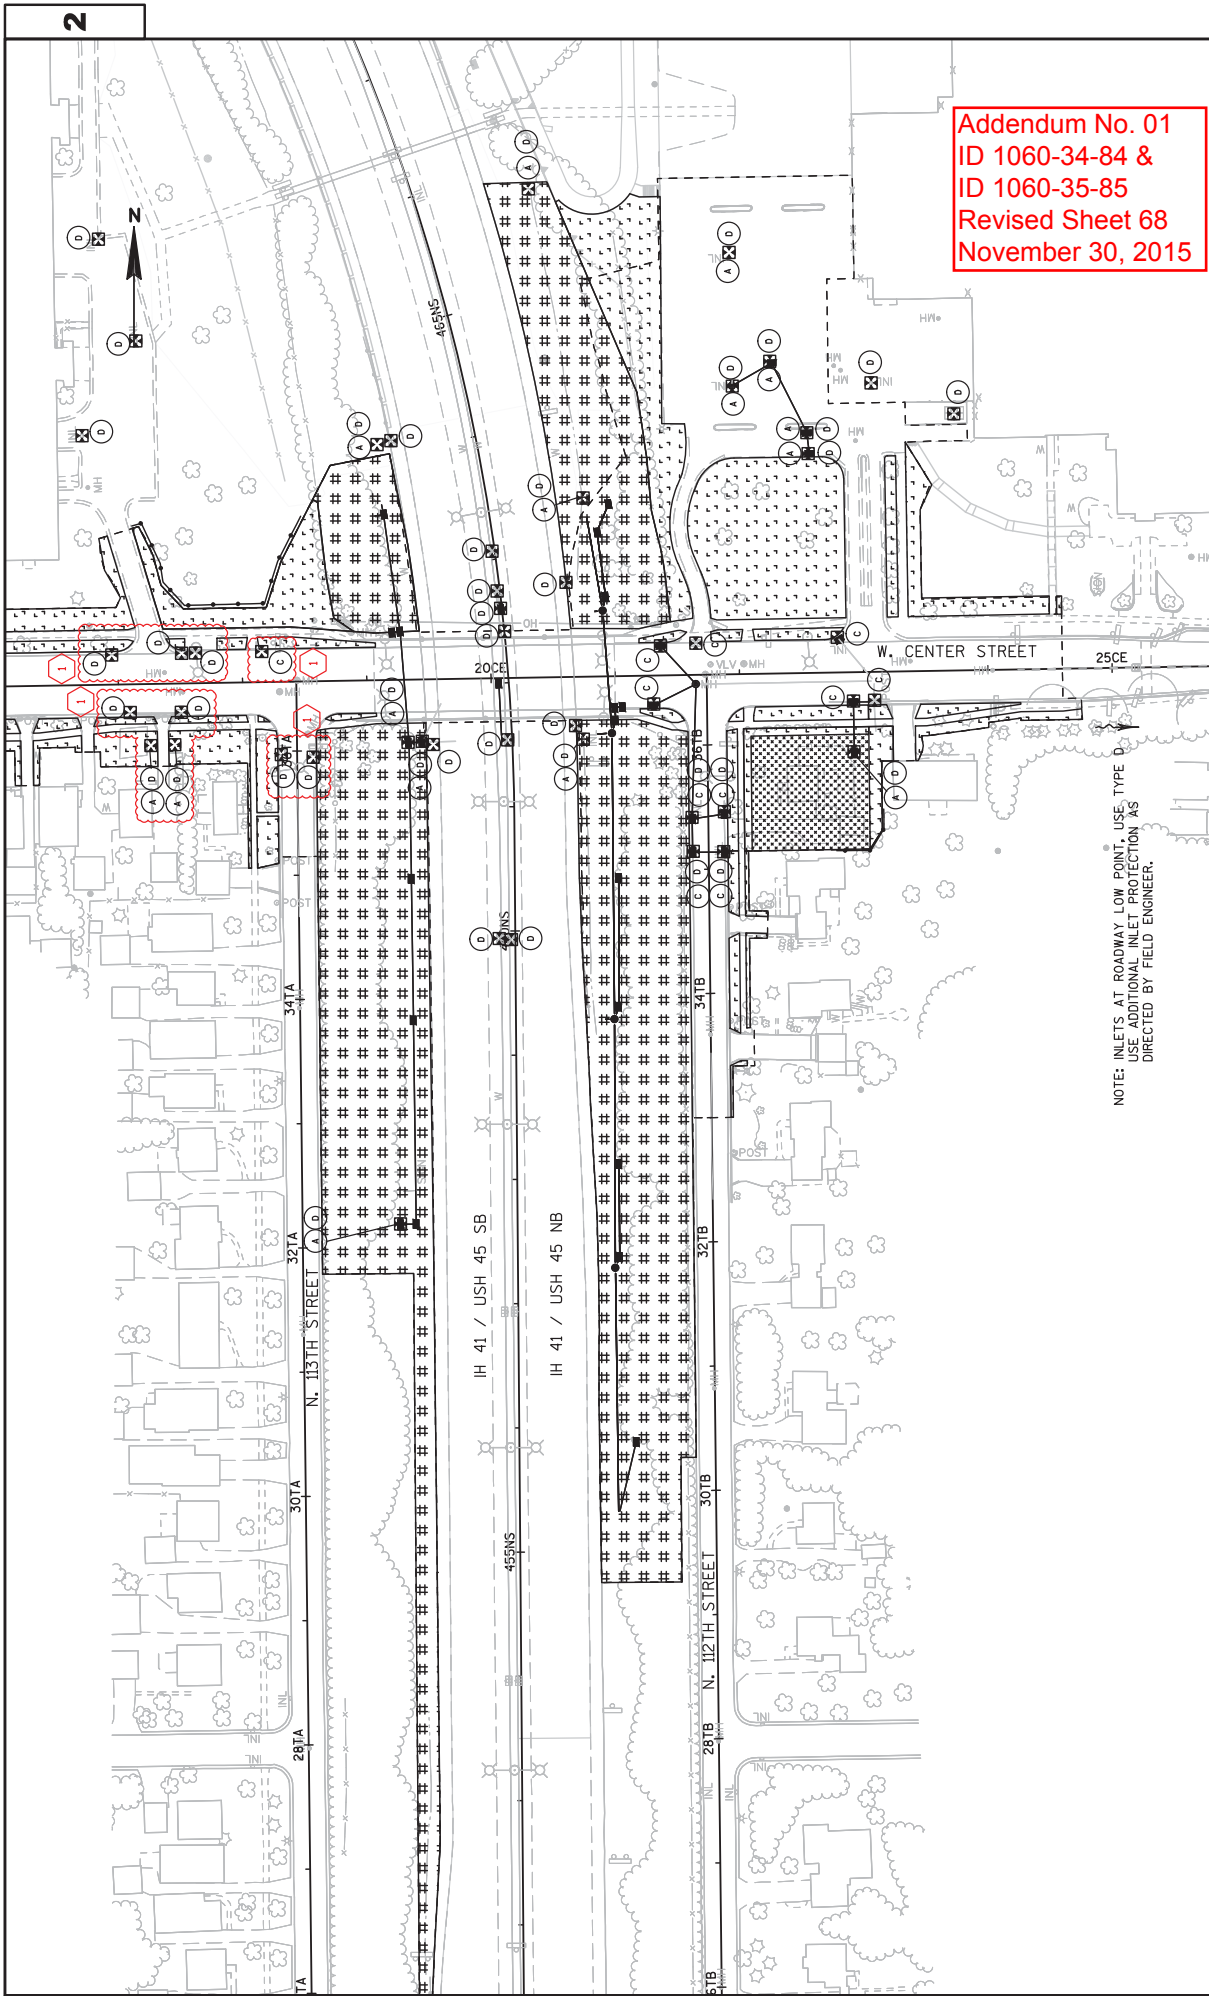

Addendum No. 01
 ID 1060-34-84 &
 ID 1060-35-85
 Revised Sheet 68
 November 30, 2015

NOTE: INLETS AT ROADWAY LOW POINT. USE TYPE D
 USE ADDITIONAL INLET PROTECTION AS
 DIRECTED BY FIELD ENGINEER.

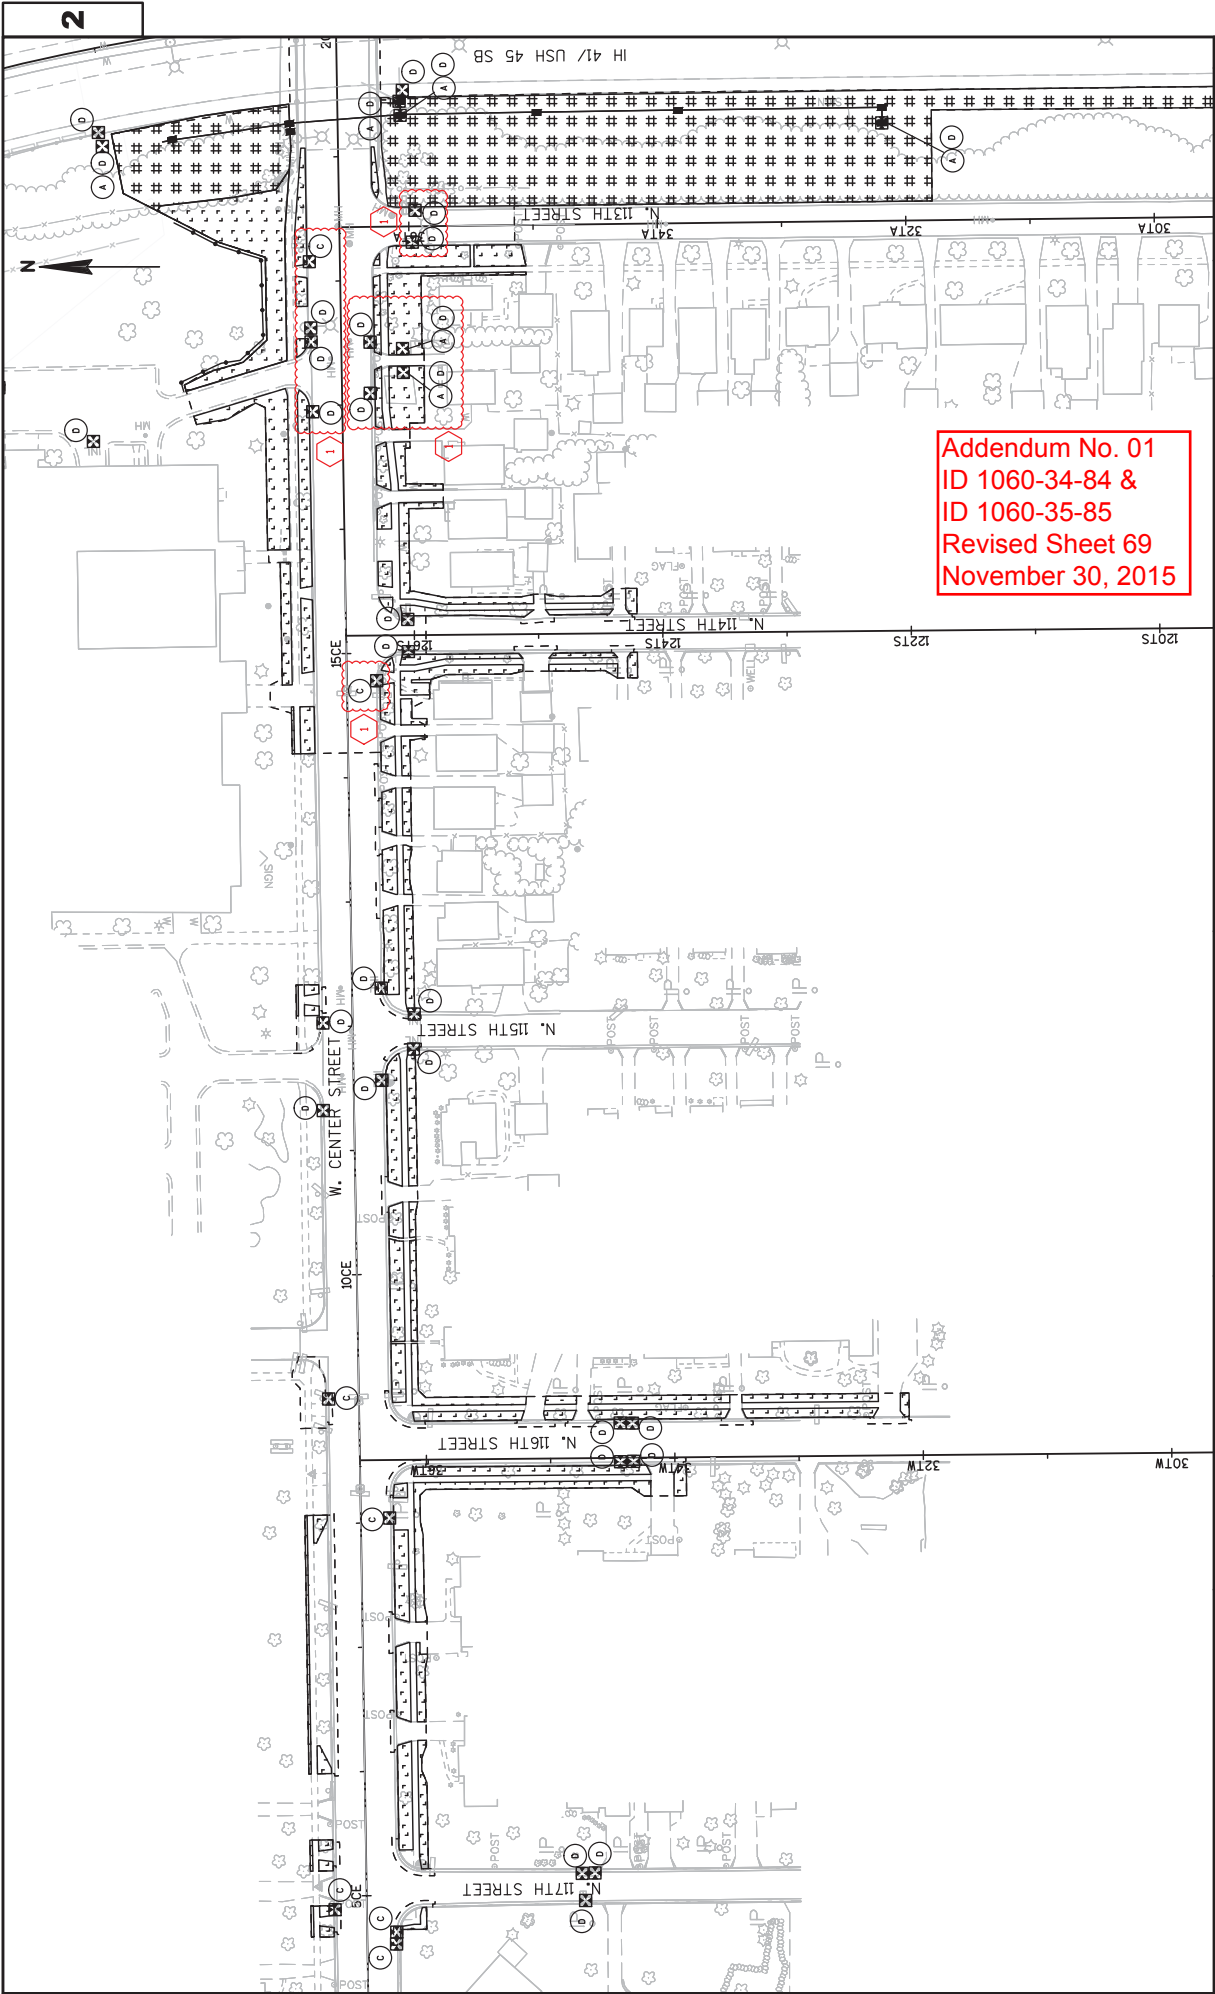

Addendum No. 01
 ID 1060-34-84 &
 ID 1060-35-85
 Revised Sheet 69
 November 30, 2015

2

2

PROJECT NO: 1060-34-84/1060-35-85 HWY: IH 41 COUNTY: MILWAUKEE EROSION CONTROL SHEET 69


FILE NAME : W:\PDS\CADD\CAD\10603484\022001.LEC.DWG PLOT DATE : 11/23/2015 3:47 PM PLOT BY : SCHWENN, BRANDON C PLOT NAME : WISDOT/CADD SHEET 42

LAYOUT NAME : - - - - - PLOT SCALE : 1 IN:100 FT

BACKFILL SLURRY STRUCTURES FOR INFORMATION ONLY

| DESCRIPTION | D | RW | T | INCH | L | FT | W | FT | SA | SF | STRUCTURE EXCAVATION AREA | STRUCTURE AREA | BACKFILL SLURRY AREA |
|------------------------|-----|------|----|-------|-------|-----|----|-----|----|----|---------------------------|----------------|----------------------|
| INLETS 20-FT | 2 | 3 | 5 | 8.63 | 9.63 | 87 | 11 | 76 | | | | | |
| INLETS MEDIAN 1 GRATE | 2.5 | 2.5 | 8 | 9.63 | 9.63 | 97 | 15 | 82 | | | | | |
| INLETS MEDIAN 2 GRATE | 2.5 | 5.33 | 8 | 9.63 | 12.66 | 125 | 26 | 99 | | | | | |
| INLETS 3-FT DIAMETER | 3 | ... | 4 | 9.67 | 9.67 | 93 | 11 | 83 | | | | | |
| INLETS 4-FT DIAMETER | 4 | ... | 5 | 10.83 | 10.83 | 117 | 16 | 99 | | | | | |
| MANHOLES 4-FT DIAMETER | 4 | ... | 5 | 10.83 | 10.83 | 117 | 16 | 99 | | | | | |
| MANHOLES 5-FT DIAMETER | 5 | ... | 6 | 12.00 | 12.00 | 144 | 28 | 116 | | | | | |
| MANHOLES 6-FT DIAMETER | 6 | ... | 7 | 13.17 | 13.17 | 173 | 40 | 133 | | | | | |
| MANHOLES 8-FT DIAMETER | 8 | ... | 9 | 15.50 | 15.50 | 240 | 71 | 169 | | | | | |
| MANHOLES 9-FT SPECIAL | 9 | ... | 10 | 16.67 | 16.67 | 278 | 86 | 188 | | | | | |

H = UP TO 6" ABOVE THE TOP OF THE HIGHEST PIPE IN THE STRUCTURE
 BACKFILL SLURRY VOLUME (CUBIC YARDS) = BACKFILL SLURRY AREA X H

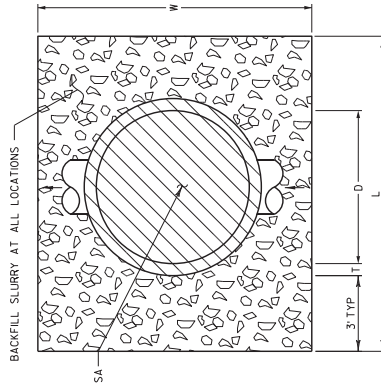

NOTES
 (1) IF THE STRUCTURE IS OUTSIDE THE PROPOSED OR FUTURE TRAVELED WAY INCLUSIVE OF SHOULDERS AND AUXILIARY LANES, BACKFILL SLURRY AND SHALL CONFORM TO SECTION 209.
 (2) IF THE STRUCTURE IS WITHIN THE PROPOSED OR FUTURE TRAVELED WAY INCLUSIVE OF SHOULDERS AND AUXILIARY LANES, BACKFILL ABOVE BACKFILL SLURRY SHALL CONFORM TO SECTION 209.

(3) BACKFILL SLURRY IS CONSIDERED INCIDENTAL TO DRAINAGE STRUCTURES. NO SEPARATE PAYMENTS WILL BE MADE.
 (4) WHEN TEMPORARY SUBGRADE IS HIGHER THAN PROPOSED FINISHED SUBGRADE, PROVIDE GRANULAR BACKFILL AT ALL LOCATIONS. COST FOR GRANULAR BACKFILL IS CONSIDERED INCIDENTAL TO CONSTRUCTION.

BACKFILL SLURRY DETAIL - STORM SEWER STRUCTURES

APPLICABLE STATION RANGES:
 455NS+0.0 TO 464NS+0.0

HWY: IH 41

COUNTY: MILWAUKEE

STORM SEWER - CONSTRUCTION DETAILS

APPLICABLE STATION RANGES:
 455NS+0.0 TO 464NS+0.0

SHEET 75


E

BACKFILL SLURRY TRENCHES (FOR INFORMATION ONLY)

| PIPE DIAMETER D | WALL THICKNESS T | TRENCH WIDTH W | HEIGHT OF PIPE ZONE H | AREA OF PIPE ZONE PA | BACKFILL SLURRY AREA |
|-----------------|------------------|----------------|-----------------------|----------------------|----------------------|
| 12 | 2.00 | 2.67 | 1.83 | 4.89 | 1.40 |
| 15 | 2.25 | 3.25 | 2.13 | 6.91 | 2.07 |
| 18 | 2.50 | 3.83 | 2.42 | 9.26 | 2.89 |
| 24 | 3.00 | 5.00 | 3.00 | 15.00 | 4.91 |
| 30 | 3.50 | 6.17 | 3.58 | 22.10 | 7.47 |
| 60 | 6.75 | 12.25 | 6.63 | 81.16 | 29.46 |

*H.E. PIPE ARE APPROXIMATED TO EQUIVALENT CIRCULAR PIPE FOR BACKFILL SLURRY PURPOSES

BACKFILL SLURRY VOLUME (CUBIC YARDS) = (PIPE ZONE AREA - PIPE AREA) X PIPE PLAN LENGTH

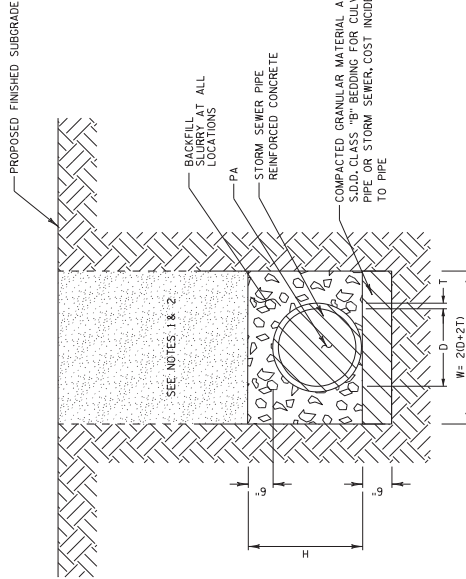

NOTES
 (1) IF THE PIPE IS OUTSIDE THE PROPOSED OR FUTURE TRAVELED WAY INCLUSIVE OF SHOULDERS AND AUXILIARY LANES, NATIVE BACKFILL MAY BE USED ABOVE BACKFILL SLURRY AND SHALL CONFORM TO SECTION 209.

(2) IF THE PIPE IS WITHIN THE PROPOSED OR FUTURE TRAVELED WAY INCLUSIVE OF SHOULDERS AND AUXILIARY LANES, BACKFILL ABOVE BACKFILL SLURRY SHALL CONFORM TO SECTION 209.

(3) BACKFILL SLURRY IS CONSIDERED INCIDENTAL TO DRAINAGE PIPE. NO SEPARATE PAYMENTS WILL BE MADE.

(4) WHEN TEMPORARY SUBGRADE IS HIGHER THAN PROPOSED FINISHED SUBGRADE, PROVIDE GRANULAR BACKFILL AT ALL LOCATIONS. COST FOR GRANULAR BACKFILL IS CONSIDERED INCIDENTAL TO CONSTRUCTION.

BACKFILL SLURRY DETAIL - STORM SEWER TRENCH

APPLICABLE STATION RANGES:
 455NS+0.0 TO 464NS+0.0


STORM SEWER - CONSTRUCTION DETAILS

SHEET 75

E

Addendum No. 01
 ID 1060-34-84 &
 ID 1060-35-85
 Revised Sheet 75
 November 30, 2015

Addendum No. 01
ID 1060-34-84 &
ID 1060-35-85
Revised Sheet 79
November 30, 2015


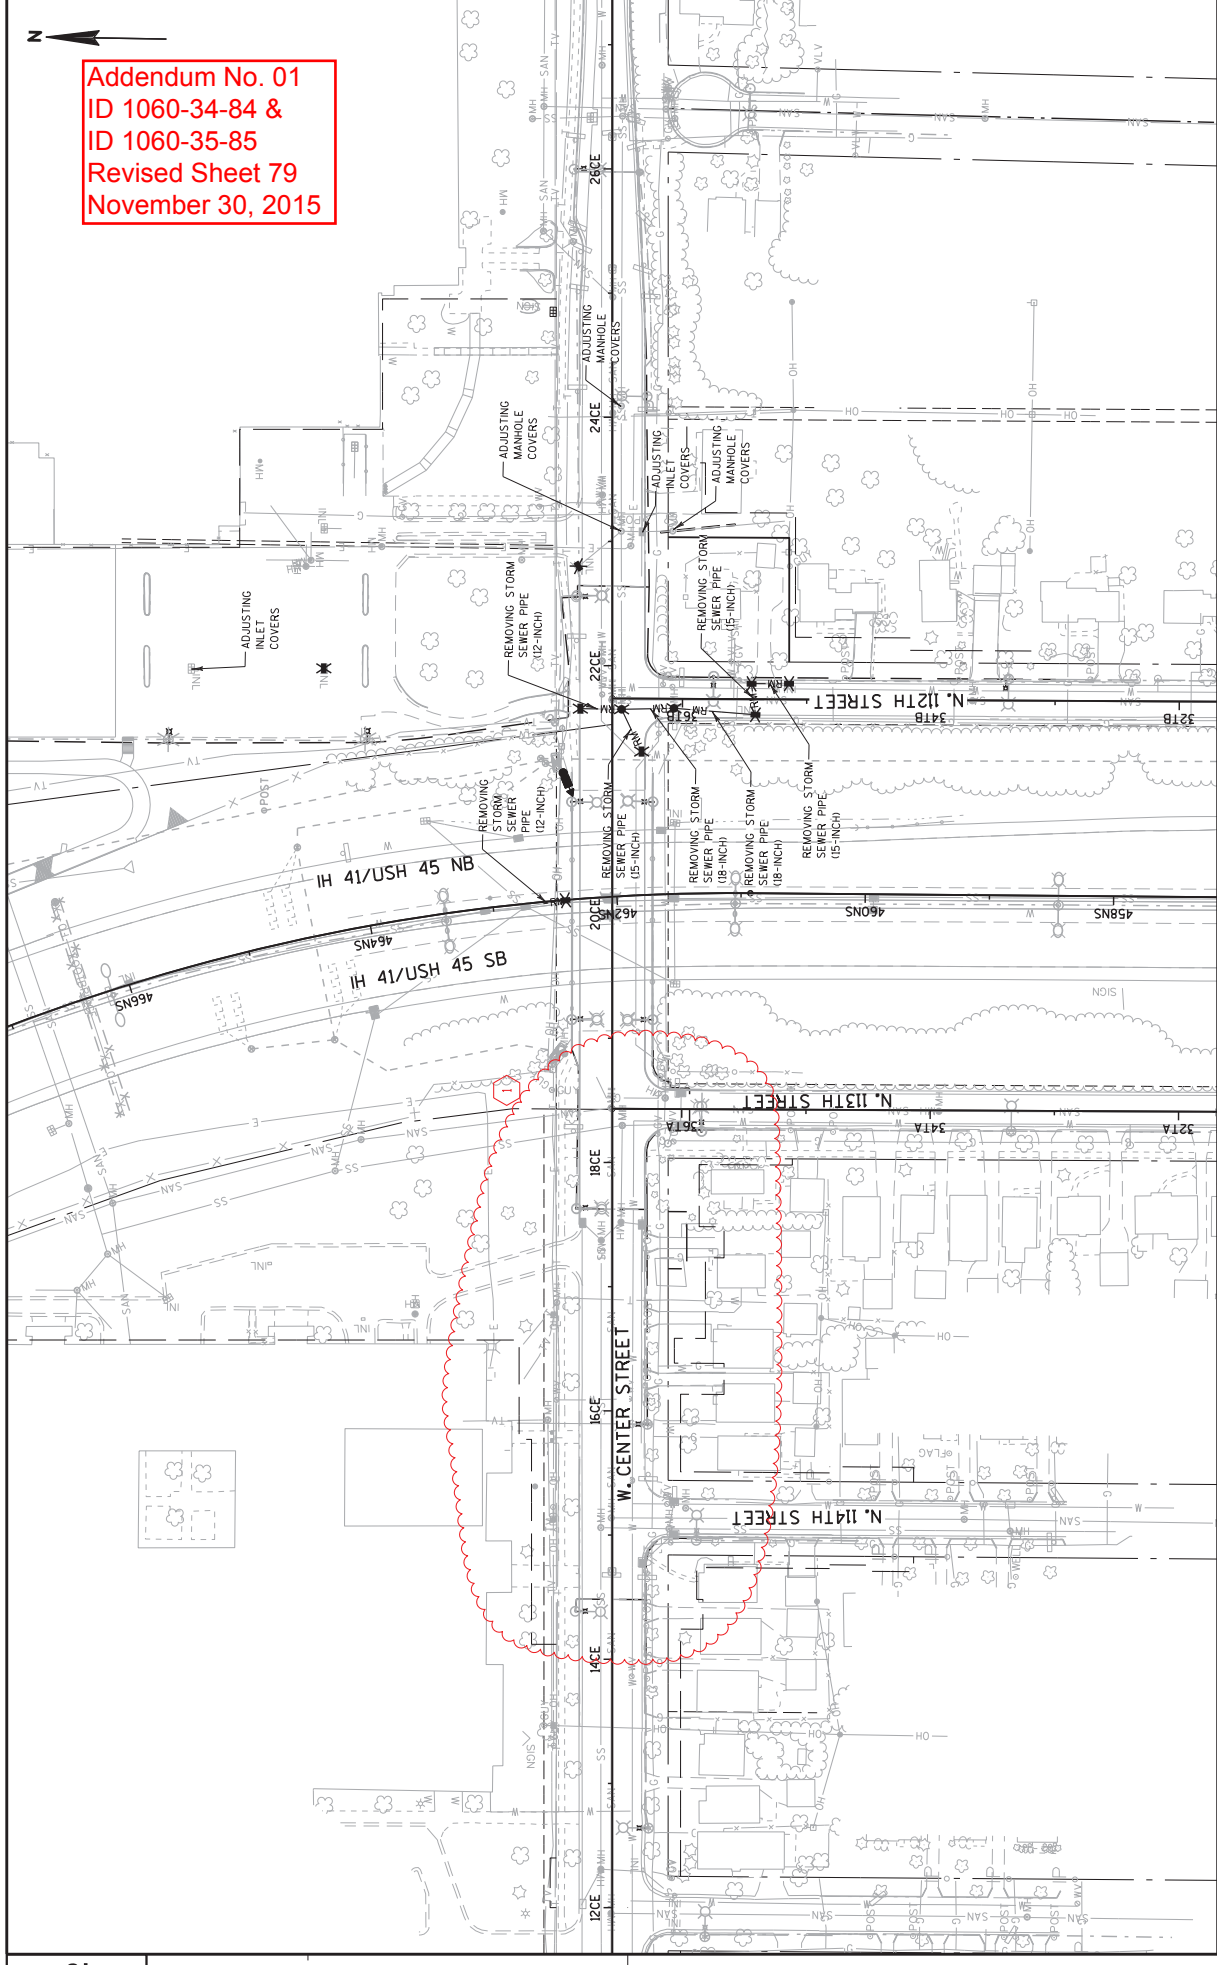


| | | | | | |
|------------------------|------------|-------------------|------------------------|----------|---|
| PROJECT NO: 1060-34-84 | HWY: IH 41 | COUNTY: MILWAUKEE | STORM SEWER - REMOVALS | SHEET 79 | E |
|------------------------|------------|-------------------|------------------------|----------|---|


FILE NAME : W:\Cadd\VF\10603484_ZN\Roads\Acces\022509_845.dgn PLOT DATE : 19-NOV-2015 08:52 PLOT BY : MEGJAF PLOT NAME : 022509_845

PLOT SCALE : 1:100:1

Addendum No. 01
ID 1060-34-84 &
ID 1060-35-85
Revised Sheet 82
November 30, 2015

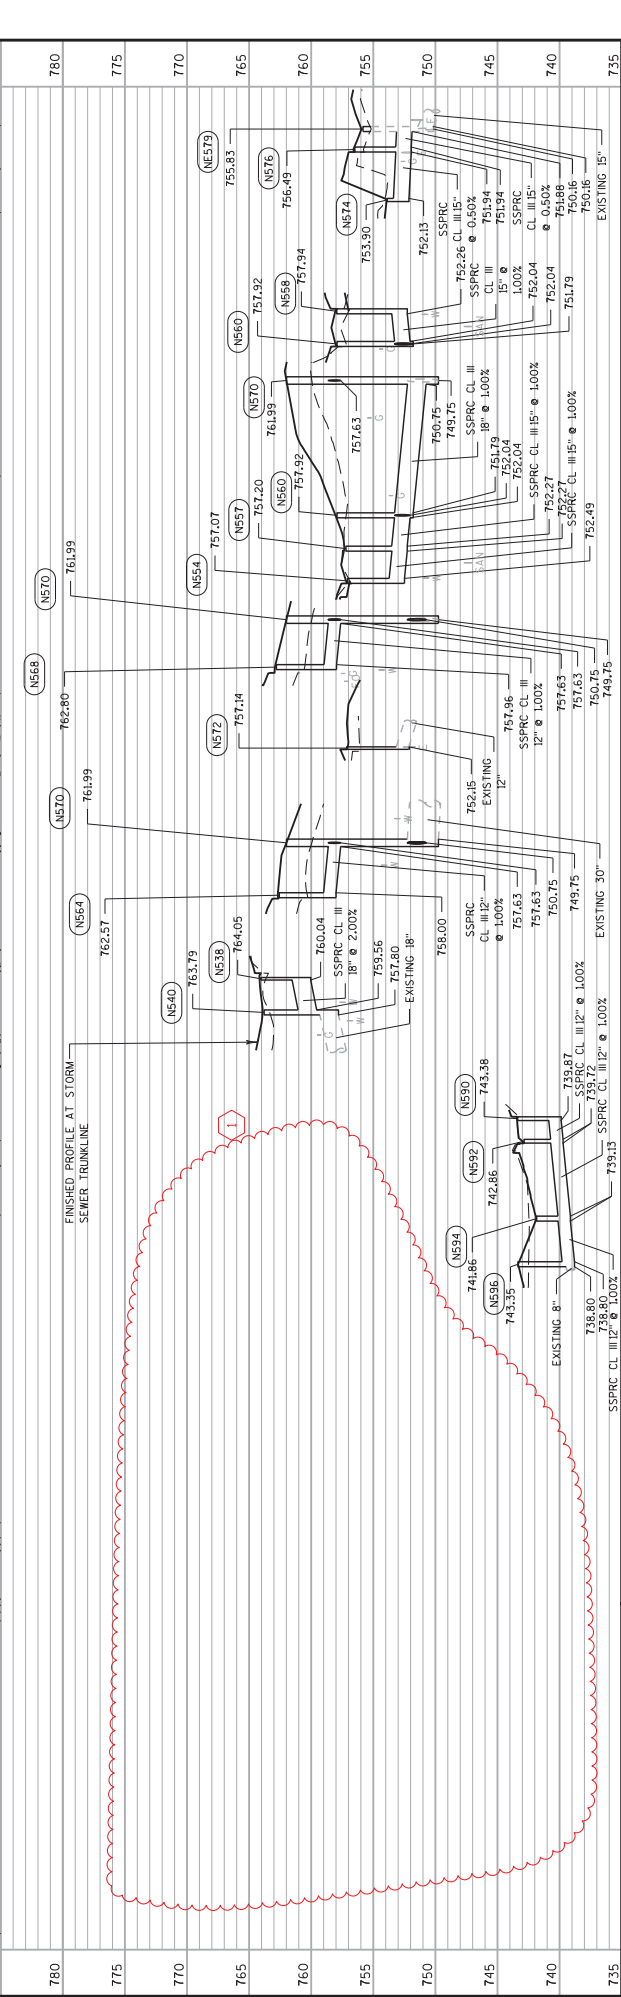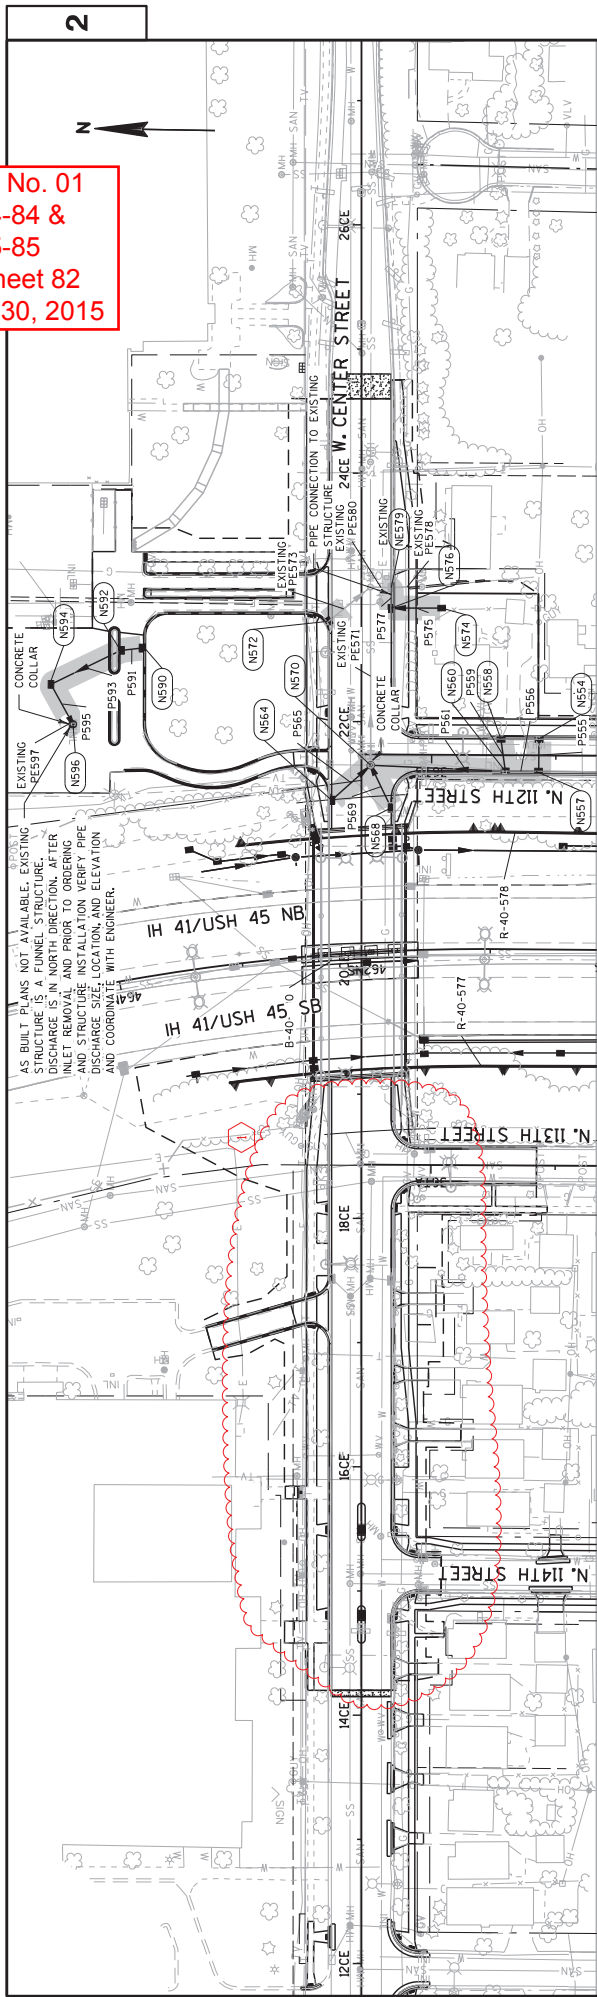


IH 41 / USH 45 NB

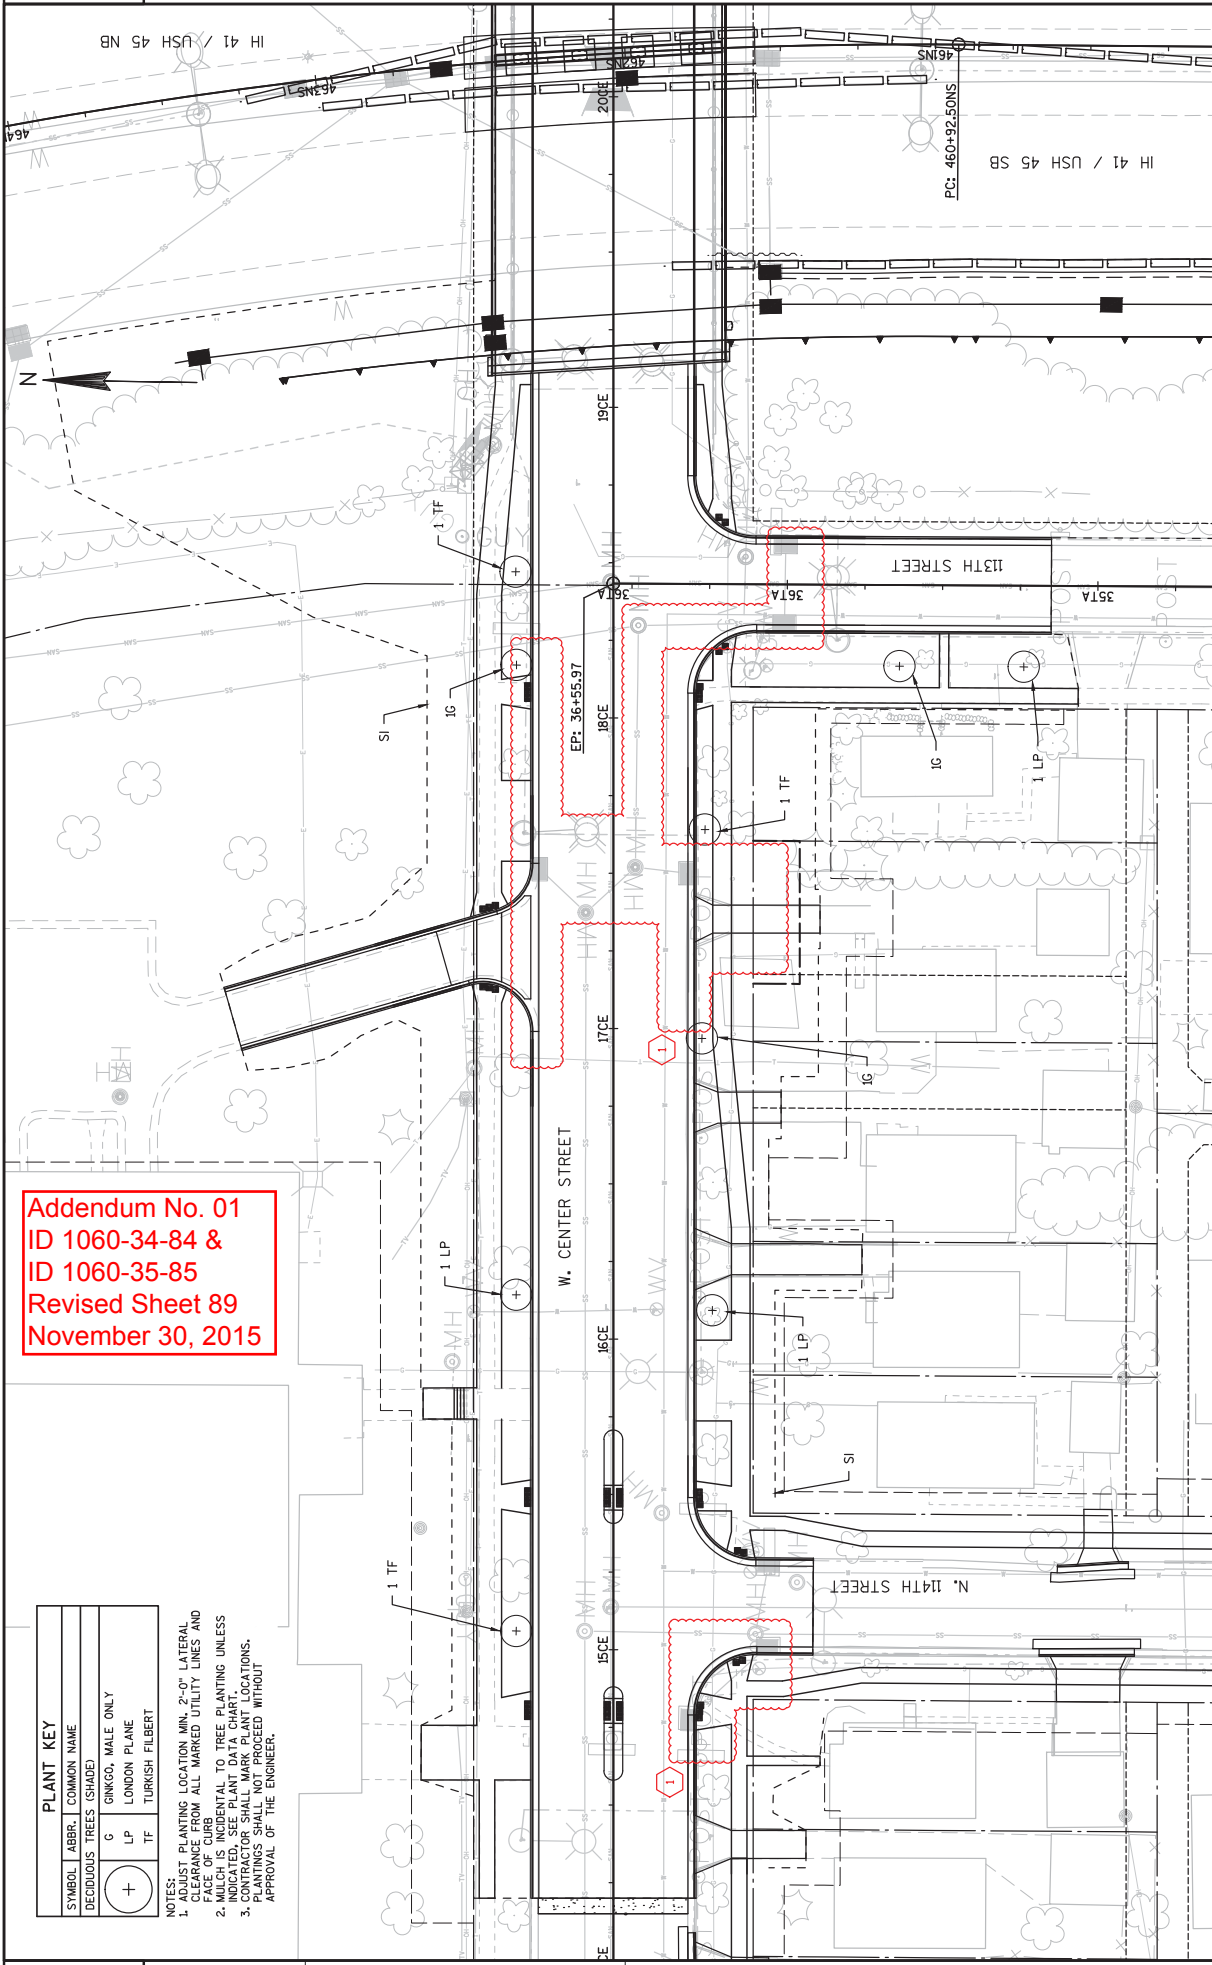

Addendum No. 01
ID 1060-34-84 &
ID 1060-35-85
Revised Sheet 89
November 30, 2015

| PLANT KEY | |
|-----------|-------------------------|
| SYMBOL | COMMON NAME |
| + | DECIDUOUS TREES (SHADE) |
| G | GINKGO, MALE ONLY |
| LP | LONDON PLANE |
| TF | TURKISH FILBERT |

- NOTES:
1. ADJUST PLANTING LOCATION MIN. 2'-0" LATERAL CLEARANCE FROM ALL MARRIED UTILITY LINES AND CURBS.
 2. MULCH IS INCIDENTAL TO TREE PLANTING UNLESS INDICATED. SEE PLANT DATA CHART.
 3. CONTRACTOR SHALL MARK PLANT LOCATIONS. LOCATIONS TO BE VERIFIED WITHOUT APPROVAL OF THE ENGINEER.

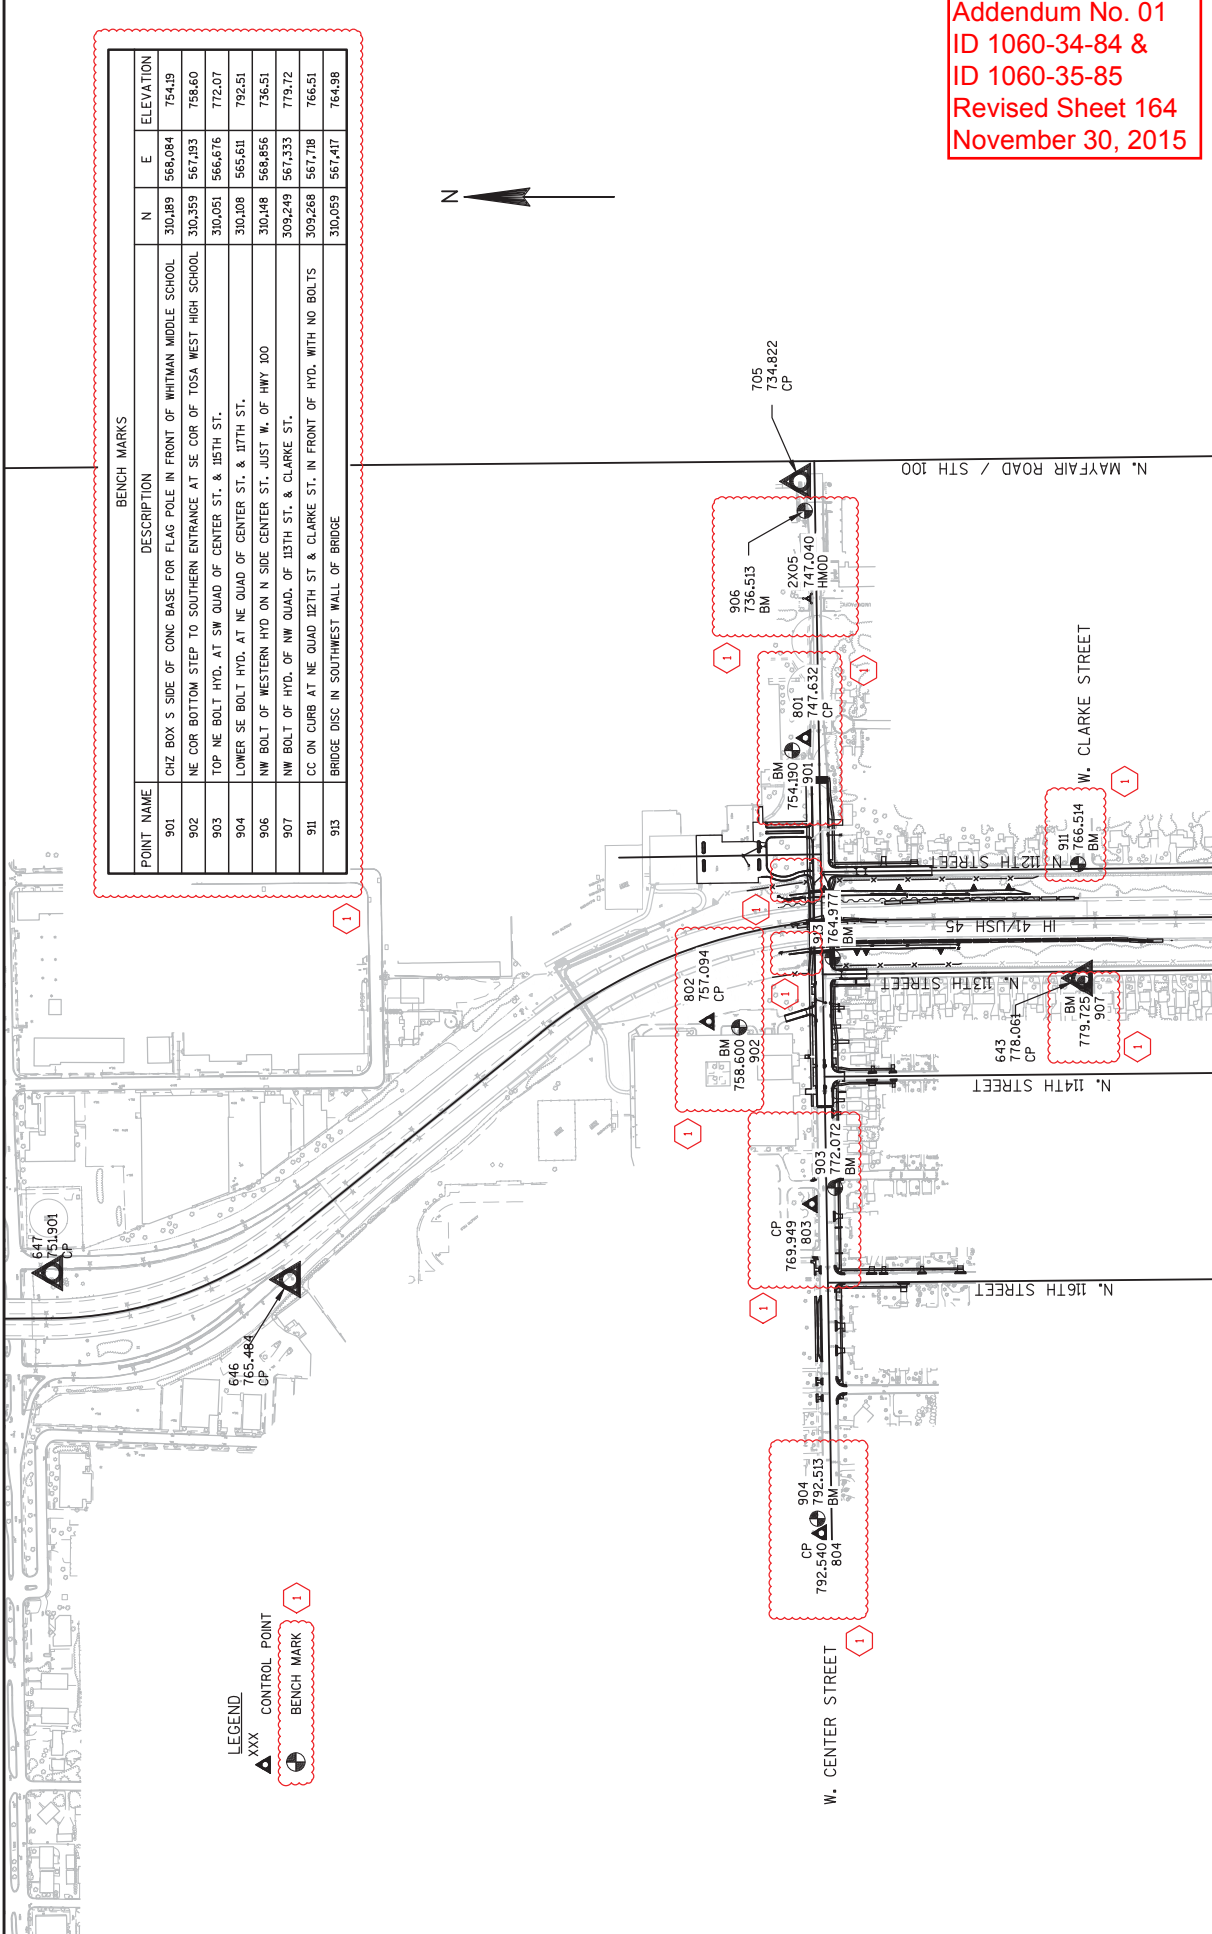

BENCH MARKS


| POINT NAME | DESCRIPTION | N | E | ELEVATION |
|------------|---|---------|---------|-----------|
| 901 | CHZ BOX S SIDE OF CONC BASE FOR FLAG POLE IN FRONT OF WHITMAN MIDDLE SCHOOL | 310.189 | 568.084 | 754.19 |
| 902 | NE COR BOTTOM STEP TO SOUTHERN ENTRANCE AT SE COR OF TOSA WEST HIGH SCHOOL | 310.359 | 567.193 | 758.60 |
| 903 | TOP NE BOLT HYD. AT SW QUAD OF CENTER ST. & 115TH ST. | 310.051 | 566.676 | 772.07 |
| 904 | LOWER SE BOLT HYD. AT NE QUAD OF CENTER ST. & 117TH ST. | 310.108 | 565.611 | 792.51 |
| 906 | NW BOLT OF WESTERN HYD ON N SIDE CENTER ST. JUST W. OF HWY 100 | 310.148 | 568.856 | 736.51 |
| 907 | NW BOLT OF HYD. OF NW QUAD. OF 113TH ST. & CLARKE ST. | 309.249 | 567.333 | 779.72 |
| 911 | CC ON CURB AT NE QUAD 112TH ST & CLARKE ST. IN FRONT OF HYD. WITH NO BOLTS | 309.668 | 567.718 | 766.51 |
| 913 | BRIDGE DISC IN SOUTHWEST WALL OF BRIDGE | 310.059 | 567.417 | 764.98 |

LEGEND
 ▲ xxx CONTROL POINT
 ● BENCH MARK

Addendum No. 01
 ID 1060-34-84 &
 ID 1060-35-85
 Revised Sheet 164
 November 30, 2015




Addendum No. 01
ID 1060-34-84 &
ID 1060-35-85
Revised Sheet 165
November 30, 2015

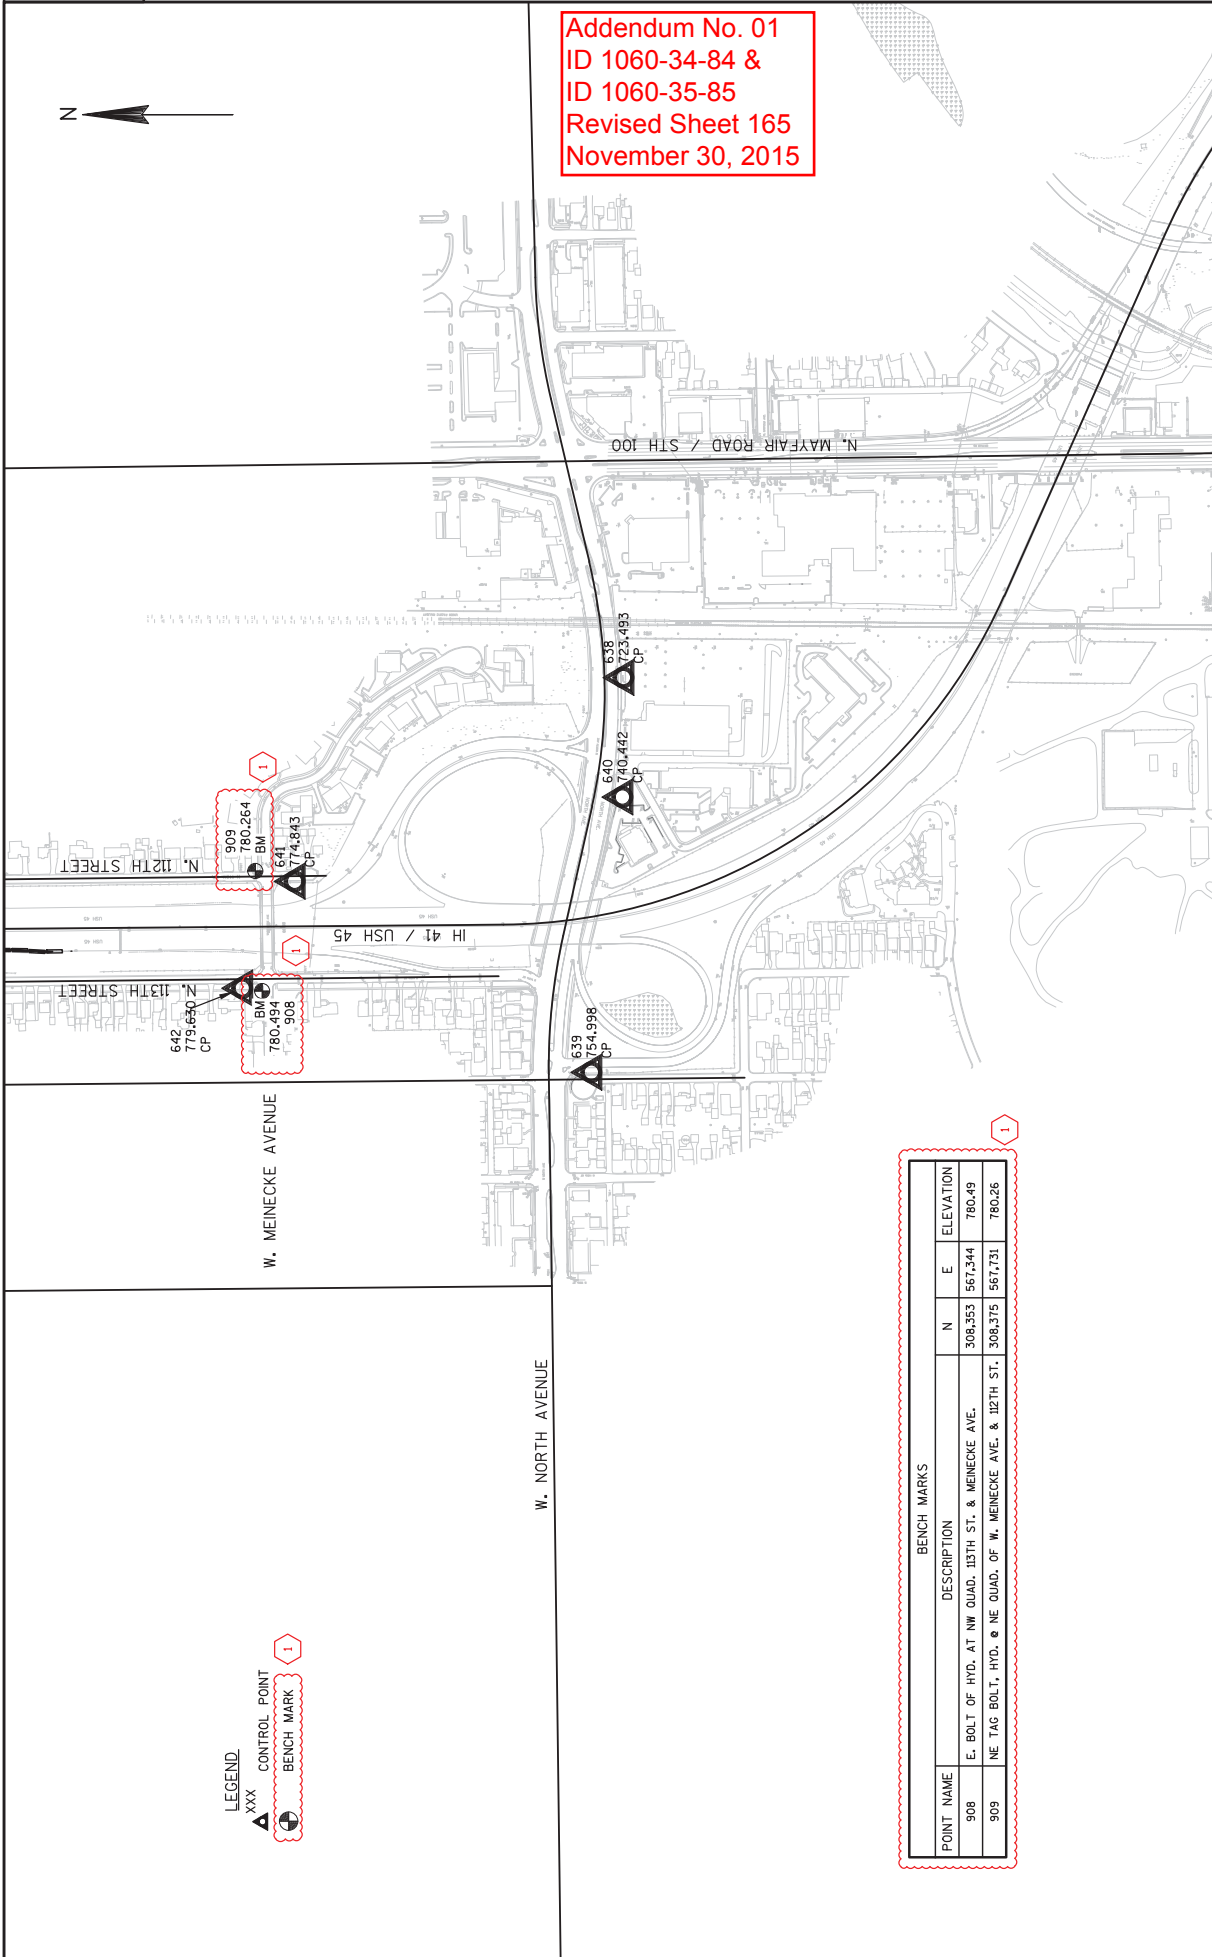


LEGEND
xxx CONTROL POINT
BENCH MARK

| POINT NAME | DESCRIPTION | BENCH MARKS | | ELEVATION |
|------------|--|-------------|---------|-----------|
| | | N | E | |
| 908 | E. BOLT OF HYD. AT NW QUAD. 113TH ST. & MEINECKE AVE. | 308.353 | 567.344 | 780.49 |
| 909 | NE TAG BOLT, HYD. @ NE QUAD. OF W. MEINECKE AVE. & 112TH ST. | 306.375 | 567.731 | 780.26 |


Addendum No. 01
 ID 1060-34-84 &
 ID 1060-35-85
 Revised Sheet 166
 November 30, 2015

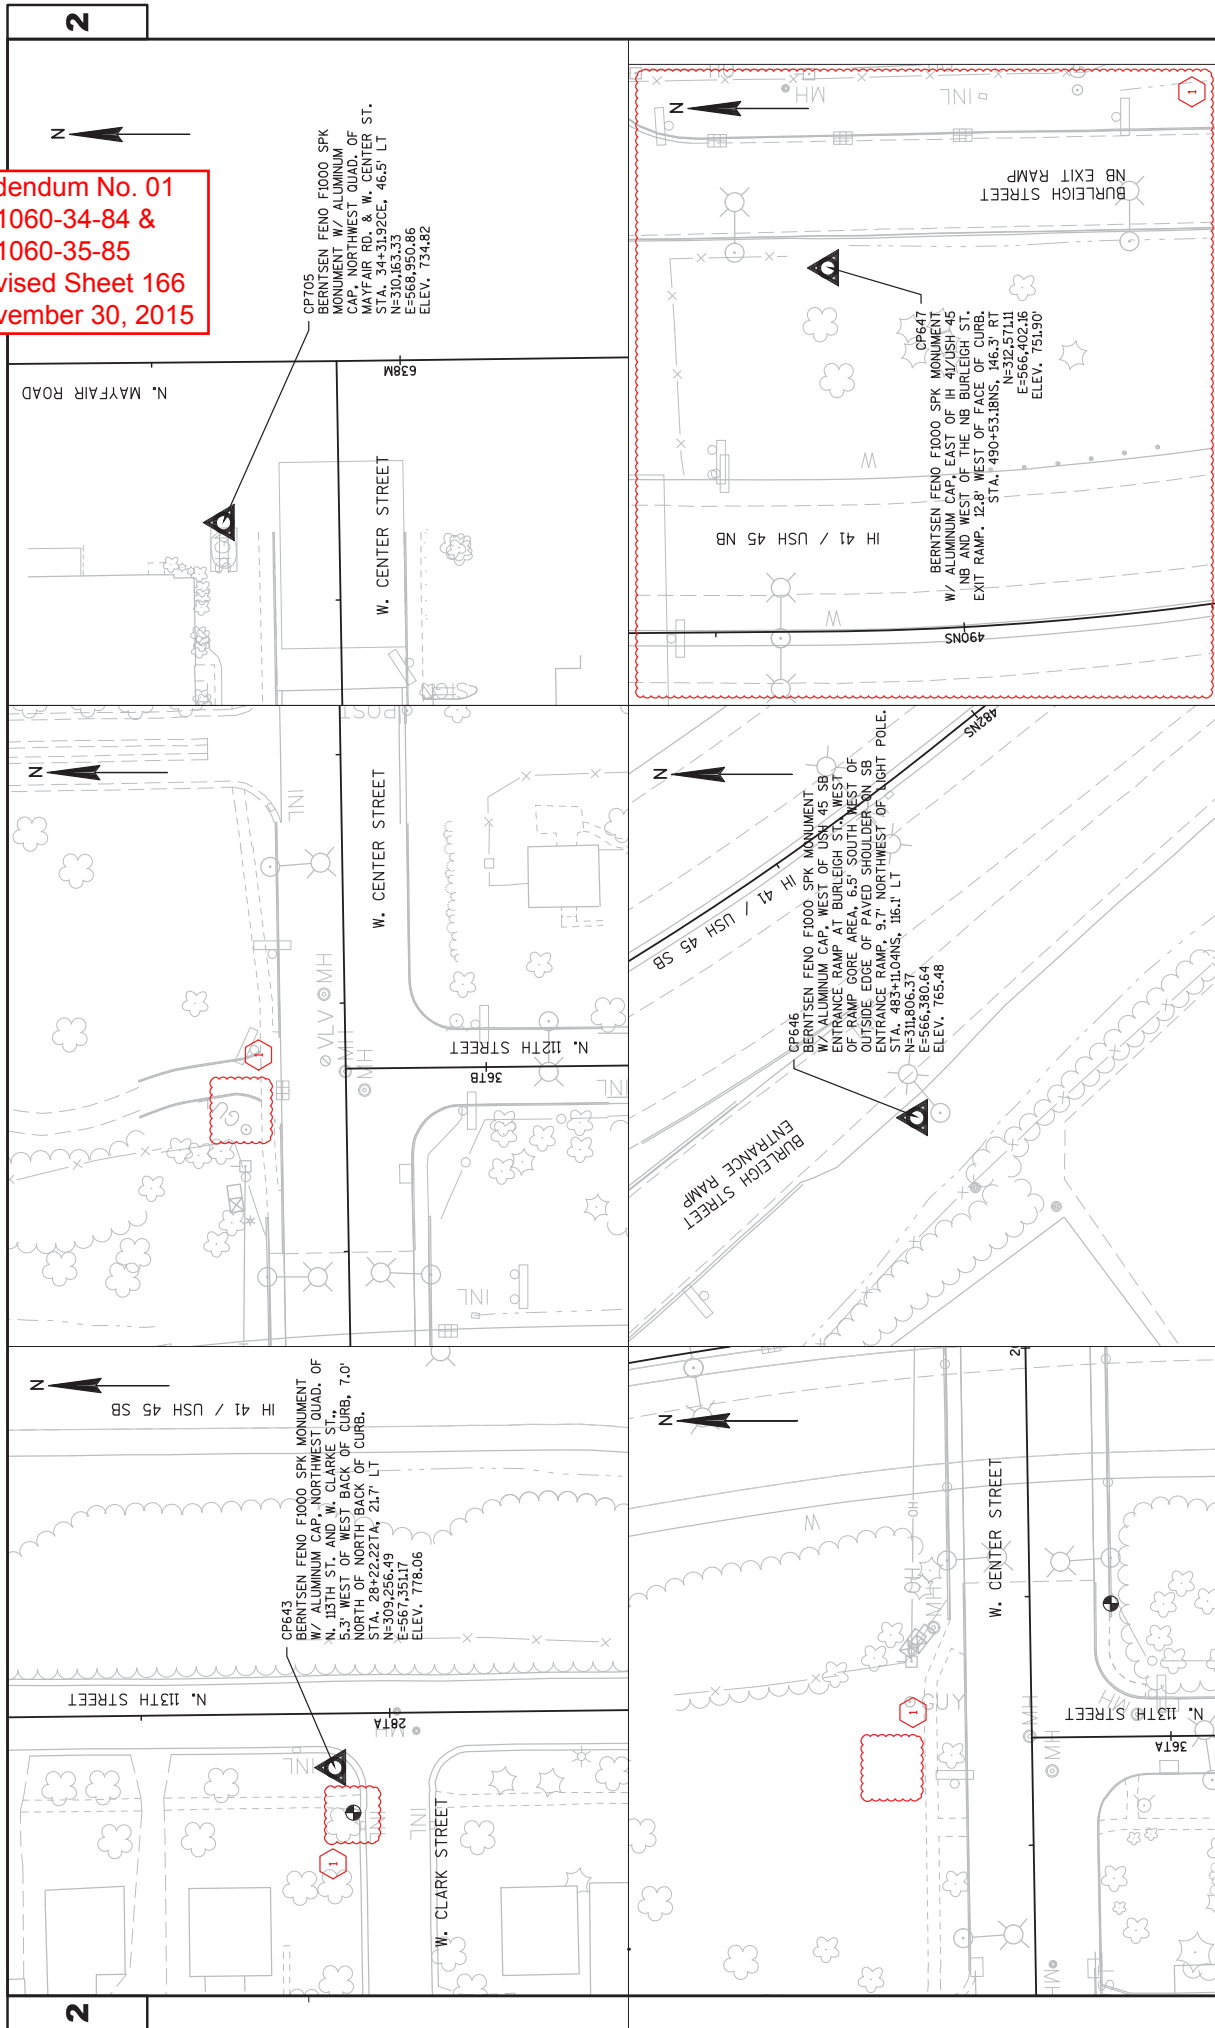

| | | | | | |
|--|------------|-------------------|-----------------------------------|-----------|---|
| PROJECT NO: 1060-34-84/1060-35-85 | HWY: IH 41 | COUNTY: MILWAUKEE | ALIGNMENT LAYOUT - SURVEY CONTROL | SHEET 166 | E |
| FILE NAME : W:\NPS\CAD\10603484\027260_A0.DWG LAYOUT NAME : 027260_A0 PLOT DATE : 11/23/2015 10:53 AM PLOT BY : SCHMENN, BRANDON C PLOT NAME : PLOT SCALE : ***** | | | | | |

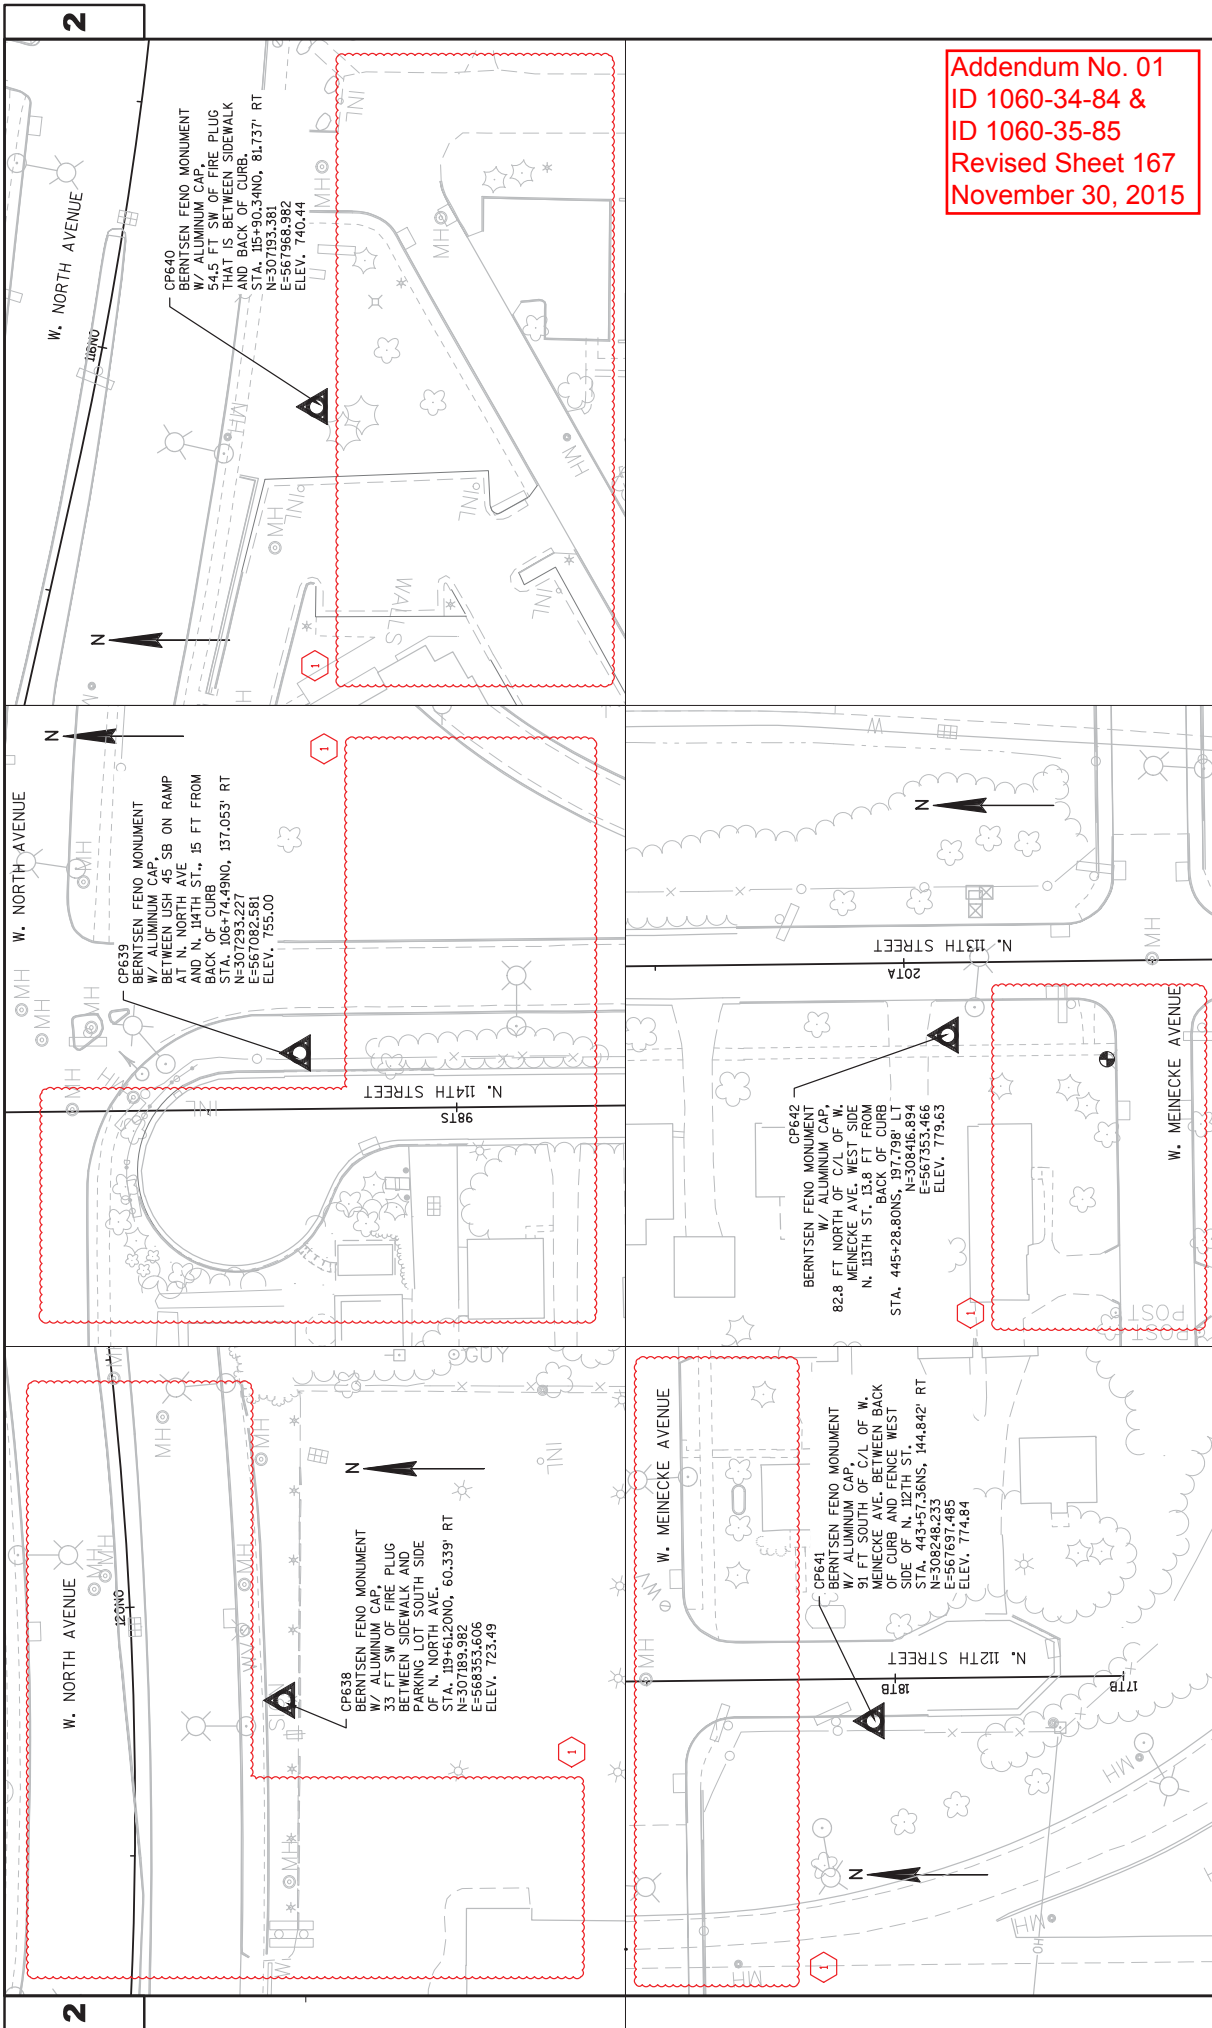

Addendum No. 01
 ID 1060-34-84 &
 ID 1060-35-85
 Revised Sheet 167
 November 30, 2015

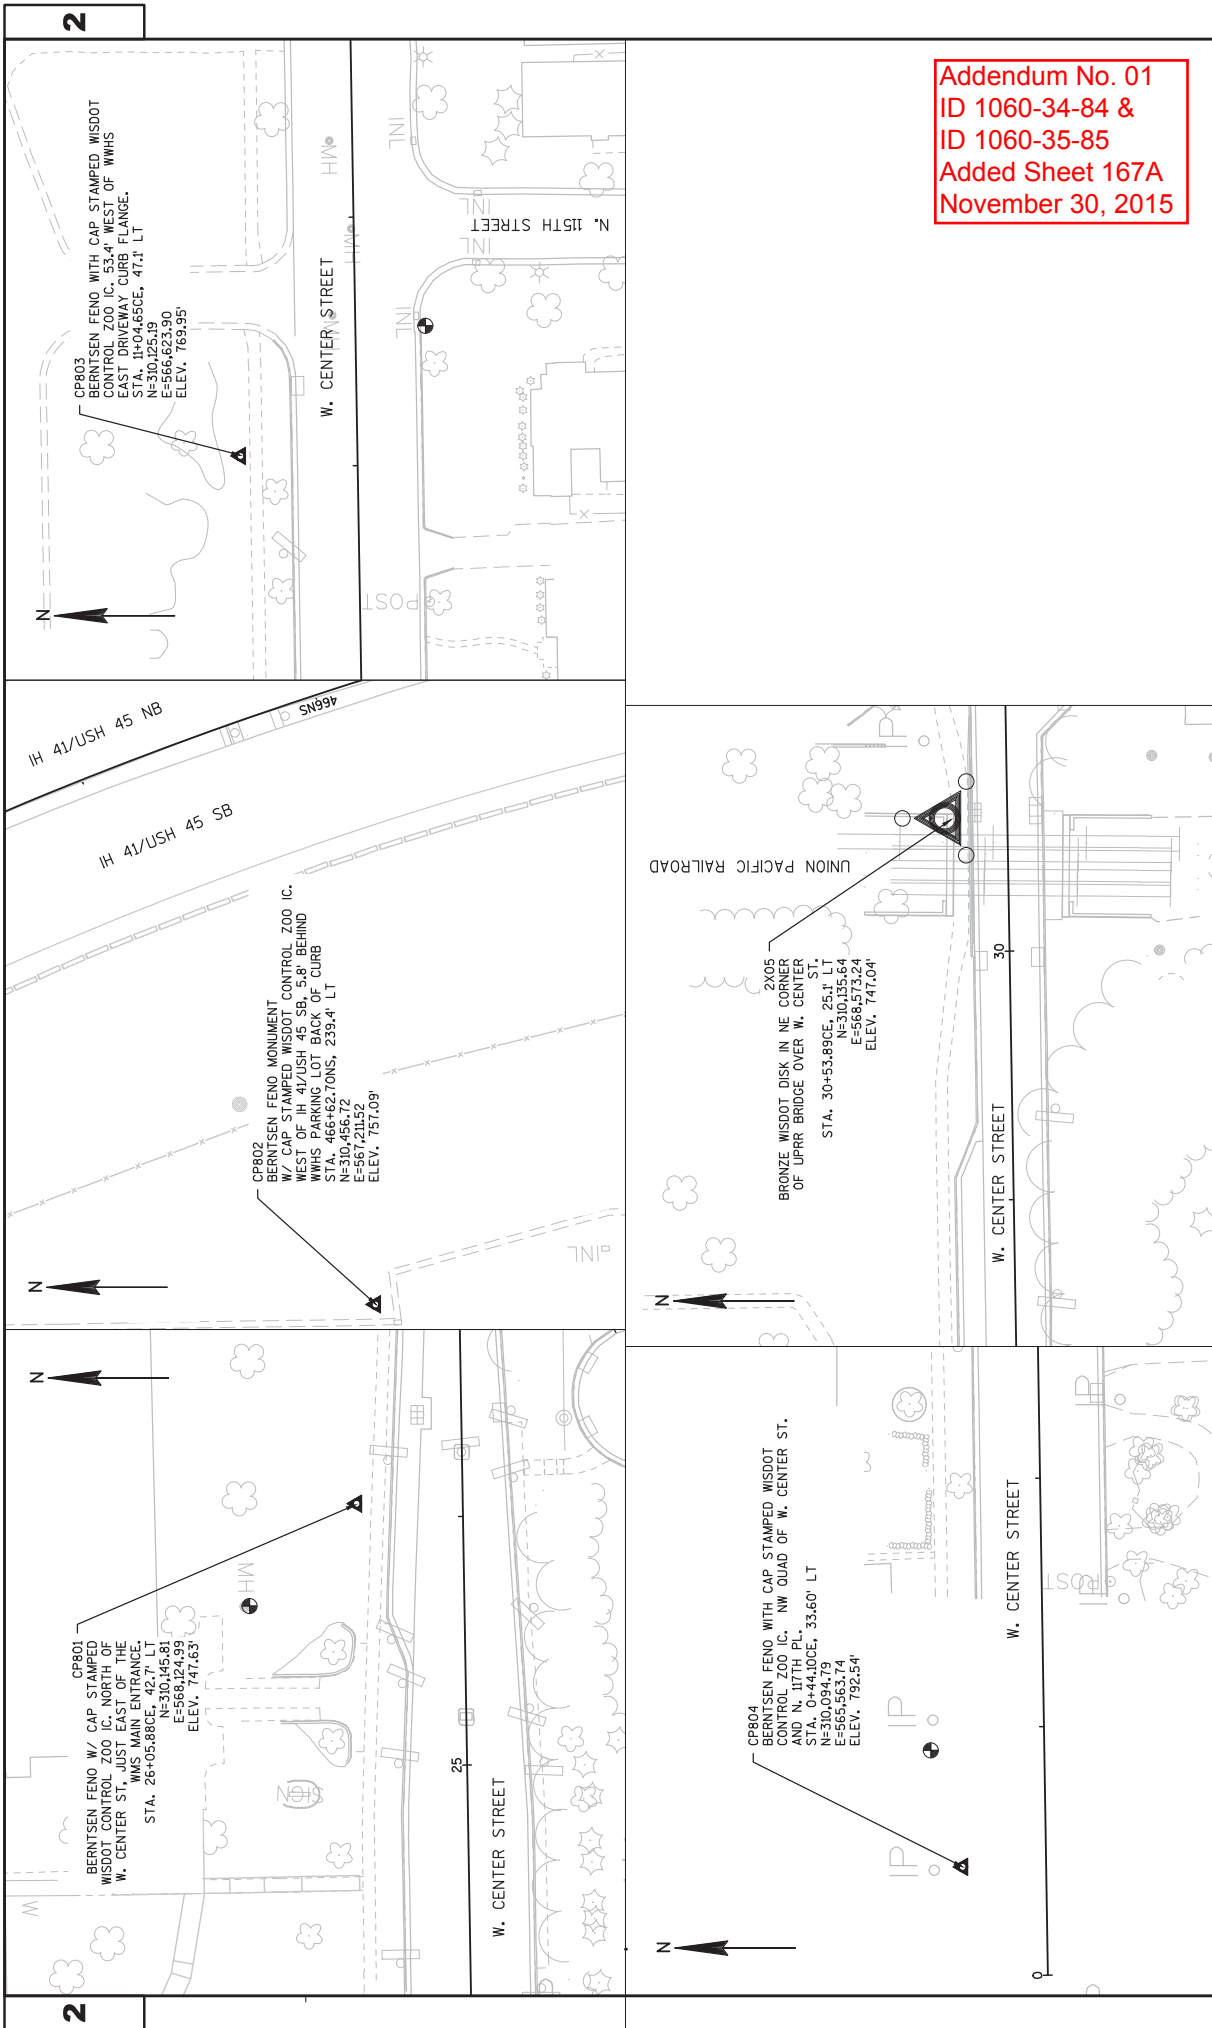

Addendum No. 01
 ID 1060-34-84 &
 ID 1060-35-85
 Added Sheet 167A
 November 30, 2015

PROJECT NO: 1060-34-84/1060-35-85
 COUNTY: MILWAUKEE
 HWY: IH 41
 SHEET 167A
 ALIGNMENT LAYOUT - SURVEY CONTROL
 PLOT DATE: 11/24/2015 8:54 AM
 PLOT BY: SCHMENN, BRANDON C
 PLOT NAME: WISDOT/CADD SHEET 42
 FILE NAME: W:\NPOS\CADD\10603484\027281_A0.DWG
 LAYOUT NAME: 027281_A0

CONCRETE STEPS

| ROADWAY | STATION | TO | STATION | OFFSET | SF |
|-----------------------|---------|----|---------|--------|----|
| | 15+74CE | | 15+84CE | LT | 52 |
| CONTRACT TOTAL | | | | | |
| | | | | | 52 |

| STAGE | LOCATION | EACH |
|-----------------------|----------|------|
| ALL | PROJECT | 1 |
| CONTRACT TOTAL | | |
| | | 1 |

TRAFFIC CONTROL

| STAGE | ROADWAY | SF | LF |
|-----------------------------------|---------|-----|-----|
| TEMPORARY PEDESTRIAN SURFACE | ASPHALT | 296 | |
| TEMPORARY PEDESTRIAN SAFETY FENCE | | | 224 |
| CONTRACT TOTAL | | | |
| | | 296 | 224 |

TEMPORARY PEDESTRIAN ACCOMMODATION

| ROADWAY | STATION | TO | STATION | OFFSET | SF |
|-----------------------|---------|----|---------|--------|----|
| | 15+74CE | | 15+84CE | LT | 52 |
| CONTRACT TOTAL | | | | | |
| | | | | | 52 |

Addendum No. 01
ID 1060-34-84 &
ID 1060-35-85
Revised Sheet 193
November 30, 2015

FENCE

| ROADWAY | STATION | TO | STATION | OFFSET | LF | 616.0206 FENCE CHAIN LINK 6-FT | 616.0229.0001 GATES CHAIN LINK 12-FT EACH | 616.0700.S FENCE SAFETY LF | SPV .0090.0008 FENCE TEMPORARY 6-FT LF |
|------------------------------|----------|----|----------|--------|-----|--------------------------------------|--|-------------------------------------|---|
| PROJECT ID 1060-34-84 | | | | | | | | | |
| N.113TH STREET | 32+07TA | | 36+15TA | RT | 408 | | | | |
| N.112TH STREET | 29+58TB | | 36+09TB | LT | 651 | | | | |
| W. CENTER STREET | 18+71CE | | 21+45CE | RT | 120 | | | | |
| W. CENTER STREET | 18+47CE | | 21+47CE | LT | 110 | | | | |
| H.417/USH.45 | 462+38NS | | 464+20NS | RT | 182 | | | | |
| H.417/USH.45 | 462+66NS | | 464+36NS | LT | 170 | | | | |
| UNDISTRIBUTED | | | | | -- | | | 300 | 1500 |
| CONTRACT TOTAL | | | | | | 1,641 | 4 | 300 | 1500 |

CATEGORY 1000 UNLESS OTHERWISE NOTED

Addendum No. 01
 ID 1060-34-84 &
 ID 1060-35-85
 Revised Sheet 195
 November 30, 2015

STORM SEWER PIPE REMOVALS

| ROADWAY | STATION | OFFSET | TO | STATION | OFFSET | 204.0245.0001* 204.0245.0002* 204.0245.0003* | |
|------------------------|----------|--------|----|----------|--------|--|---------------------------------|
| | | | | | | REMOVING STORM SEWER 12-INCH LF | REMOVING STORM SEWER 15-INCH LF |
| IH 41 CENTER STREET | 462NS+42 | 0' LT | -- | 462NS+60 | 1' LT | 18 | --- |
| | 21CE+31 | 24' RT | -- | 21CE+65 | 8' RT | --- | 38 |
| | 21CE+65 | 26' LT | -- | 21CE+65 | 8' RT | 33 | --- |
| 112TH STREET | 35TB+14 | 13' RT | -- | 35TB+45 | 13' RT | --- | 30 |
| | 35TB+41 | 12' LT | -- | 35TB+45 | 13' RT | --- | 25 |
| | 35TB+41 | 13' LT | -- | 36TB+07 | 8' LT | --- | 66 |
| | 36TB+07 | 8' LT | -- | 36TB+49 | 9' LT | --- | 42 |
| TOTAL | | | | | | 51 | 93 |

STORM SEWER STRUCTURE REMOVALS

| ROADWAY | STATION | OFFSET | 204.0210* 204.0220* | |
|------------------------|----------|---------|------------------------|----------------------|
| | | | REMOVING MANHOLES EACH | REMOVING INLETS EACH |
| IH 41 CENTER STREET | 462NS+42 | 0' LT | --- | 1 |
| | 21CE+31 | 24' RT | --- | 1 |
| | 21CE+65 | 8' RT | 1 | --- |
| | 21CE+65 | 26' LT | --- | 1 |
| 112TH STREET | 21CE+98 | 232' LT | --- | 1 |
| | 22CE+79 | 29' LT | --- | 1 |
| | 35TB+14 | 13' RT | --- | 1 |
| | 35TB+41 | 13' LT | --- | 1 |
| TOTALS | | | 2 | 8 |

1

*ADDITIONAL QUANTITIES LISTED ELSEWHERE IN PLAN

ALL ITEMS CATEGORY 1000

Addendum No. 01
 ID 1060-34-84 &
 ID 1060-35-85
 Revised Sheet 196
 November 30, 2015

PIPE CONNECTION TO EXISTING STRUCTURE

| ROADWAY | STATION | OFFSET | STRUCTURE | EACH |
|----------------------|---------|--------|--|------|
| CENTER STREET | | | | |
| | 23CE+06 | 24' RT | SPV, 0060.8005 PIPE CONNECTION TO EXISTING STRUCTURE | 1 |
| TOTAL | | | | 1 |

COVER PLATES LEFT IN PLACE

| ROADWAY | EID | STRUCTURE | STATION | OFFSET | FUTURE CASTING | FT | EACH |
|--------------|--------|-----------|---------|--------|----------------|----|------|
| IH 41 | | | | | | | |
| | N1152 | 455NS+88 | 94' RT | MS-2 | 0.00' | | 1 |
| | N1204 | 457NS+28 | 79' RT | J-S | 1.07' | | 1 |
| | N1199A | 457NS+37 | 84' RT | 27-M | 1.00' | | 1 |
| | N1178 | 457NS+65 | 84' LT | V | 1.17' | | 1 |
| | N1198A | 458NS+12 | 84' RT | V | 1.17' | | 1 |
| | N1196 | 459NS+28 | 79' RT | J-S | 1.07' | | 1 |
| | N1151A | 459NS+39 | 85' RT | 27-M | 1.00' | | 1 |
| | N1185 | 459NS+29 | 85' LT | V | 1.17' | | 1 |
| | N1150A | 460NS+42 | 86' RT | V | 1.17' | | 1 |
| | N1131 | 460NS+43 | 86' LT | V | 1.17' | | 1 |
| | N1184 | 461NS+65 | 81' RT | J-S | 1.07' | | 1 |
| | N1109A | 461NS+65 | 86' RT | V | 1.17' | | 1 |
| | N1107A | 461NS+75 | 90' RT | MS-1 | 0.00' | | 1 |
| | N1108A | 461NS+75 | 86' RT | V | 1.17' | | 1 |
| | N1136E | 462NS+00 | 6' LT | V | 1.17' | | 1 |
| | N1121 | 462NS+50 | 90' LT | MS-1 | 0.00' | | 1 |
| | N1123 | 462NS+50 | 86' LT | V | 1.17' | | 1 |
| | N1099 | 462NS+50 | 81' RT | J-S | 1.07' | | 1 |
| | N1102A | 462NS+60 | 86' RT | V | 1.17' | | 1 |
| | N1101A | 463NS+10 | 86' RT | V | 1.17' | | 1 |
| | N1105 | 463NS+30 | 96' RT | MS-2 | 0.00' | | 1 |
| | N1119 | 463NS+50 | 86' LT | V | 1.17' | | 1 |
| TOTAL | | | | | | | 22 |

ADJUSTING DRAINAGE STRUCTURES

| LOCATION | STATION | OFFSET | EXISTING RIM ELEVATION | TO | PROPOSED RIM ELEVATION | ADJUSTING MANHOLE COVERS | 611.8110 ADJUSTING MANHOLE INLET COVERS |
|------------------------|---------|---------|------------------------|----|------------------------|--------------------------|---|
| CENTER STREET | | | | | | | |
| | 21CE+98 | 339' LT | 742.41 | -- | 741.68 | --- | 1 |
| | 23CE+08 | 26' RT | 755.03 | -- | 755.83 | --- | 1 |
| | 23CE+08 | 7' RT | 755.80 | -- | 756.56 | --- | --- |
| | 23CE+08 | 49' RT | 755.68 | -- | 756.66 | 1 | --- |
| | 24CE+09 | 7' RT | 752.56 | -- | 752.80 | 1 | --- |
| UNDISTRIBUTED** | | | | | | 5 | 7 |
| TOTALS | | | | | | 8 | 9 |

* ADDITIONAL QUANTITIES LISTED ELSEWHERE IN PLAN.
 ** UN-DISTRIBUTED ADJUSTING MANHOLE OR INLET COVERS ARE TO BE USED FOR DRAINAGE STRUCTURES CONSTRUCTED UNDER THE CITY OF WALUWATOSA'S LOCAL STORM SEWER PROJECT.

SEALING PIPES

| ROADWAY | STATION | OFFSET | RPE END | RPE ID | RPE NOTES: |
|--------------|----------|--------|------------|--------|------------------------|
| IH 41 | | | | | |
| | 455NS+33 | 79' RT | DOWNSTREAM | P1205 | 1 INSTALL MARKER BOARD |
| | 455NS+32 | 81' RT | DOWNSTREAM | P1153 | 1 INSTALL MARKER BOARD |
| | 459NS+28 | 72' RT | UPSTREAM | P1194B | 1 INSTALL MARKER BOARD |
| | 461NS+55 | 68' RT | UPSTREAM | P1147 | 1 INSTALL MARKER BOARD |
| | 461NS+58 | 9' LT | DOWNSTREAM | P136F | 1 |
| | 462NS+50 | 74' RT | UPSTREAM | P1088A | 1 INSTALL MARKER BOARD |
| | 463NS+23 | 78' RT | UPSTREAM | P1082A | 1 INSTALL MARKER BOARD |
| | 463NS+50 | 91' LT | UPSTREAM | P1118 | 1 INSTALL MARKER BOARD |
| | 463NS+59 | 84' LT | UPSTREAM | P1116 | 1 INSTALL MARKER BOARD |
| TOTAL | | | | | 9 |

CONCRETE COLLARS FOR PIPE

| ROADWAY | STATION | OFFSET | CONCRETE COLLARS FOR PIPE |
|--------------|----------|---------|---------------------------|
| IH 41 | | | |
| | 461NS+55 | 69' LT | 1 |
| | 461NS+59 | 71' LT | 1 |
| | 462NS+61 | 1' LT | 1 |
| | 21CE+68 | 7' RT | 1 |
| | 21CE+98 | 234' LT | 1 |
| | 22CE+81 | 27' LT | 1 |
| TOTAL | | | 6 |

ALL ITEMS CATEGORY 1000

Addendum No. 01
 ID 1060-34-84 &
 ID 1060-35-85
 Revised Sheet 199
 November 30, 2015

STORM SEWER STRUCTURES

STORM SEWER PIPES

| ROADWAY | STRUCTURE NO. | STATION | OFFSET (FT) | LOCATION | RIM OR FLOW ELEV | STRUCTURE TYPE | INLET/MANHOLE COVERS TYPE | DEPTH (FT) | STRUCTURE COMMENTS ² | PIPE ID | FROM STR | TO STR | INLET ELEV | DISCH ELEV | SLOPE ^A % | PIPE LENGTH ^B (FT) | PLAN LENGTH ^C (FT) | PIPE CLASS | PIPE SIZE (INCH) | PIPE COMMENTS ² |
|---------------|---------------|--------------|-------------|----------|------------------|------------------------|---------------------------|------------|---------------------------------|---------|----------|--------|------------|------------|----------------------|-------------------------------|-------------------------------|------------|------------------|----------------------------|
| 112TH STREET | N554 | 35TB+13.69 | 15.0 | RT | 757.07 | INLETS 4-FT DIAMETER | H | 4.98 | IN | P555 | N554 | N557 | 752.49 | 752.27 | 1.00 | 22 | 26 | III | 15 | IN |
| 112TH STREET | N557 | 35TB+13.73 | 15.0 | LT | 757.20 | INLETS 4-FT DIAMETER | H | 4.93 | IN | P556 | N557 | N560 | 752.27 | 752.04 | 1.00 | 23 | 27 | III | 15 | IN |
| 112TH STREET | N558 | 35TB+44.32 | 15.0 | RT | 757.94 | INLETS 4-FT DIAMETER | H | 5.88 | IN | P559 | N558 | N560 | 752.26 | 752.04 | 1.00 | 22 | 26 | III | 15 | IN |
| 112TH STREET | N560 | 35TB+40.57 | 15.0 | LT | 757.92 | INLETS 4-FT DIAMETER | H | 6.13 | IN | P561 | N560 | N570 | 751.79 | 750.75 | 1.00 | 104 | 109 | III | 18 | IN |
| CENTER STREET | N564 | 21CE+36.70 | 26.0 | LT | 762.57 | INLETS 4-FT DIAMETER | H | 4.57 | IN | P565 | N564 | N570 | 758.00 | 757.63 | 1.00 | 37 | 42 | III | 12 | IN |
| CENTER STREET | N568 | 21CE+30.42 | 26.0 | RT | 762.80 | INLETS 4-FT DIAMETER | H | 4.84 | IN | P569 | N568 | N570 | 757.96 | 757.63 | 1.00 | 33 | 38 | III | 12 | IN |
| CENTER STREET | N570 | 21CE+64.84 | 7.4 | RT | 761.99 | MANHOLES 6-FT DIAMETER | J-SPECIAL | 12.24 | IN | PE571 | N570 | --- | 749.75 | --- | --- | --- | --- | --- | 30 | EXIST PIPE INTERPOL ELEV |
| CENTER STREET | N572 | 22CE+79.47 | 28.4 | LT | 757.07 | INLETS 2x3-FT | H | 4.92 | IN | PE573 | N572 | --- | 752.15 | --- | --- | --- | --- | --- | 12 | EXIST PIPE INTERPOL ELEV |
| CENTER STREET | N574 | 22CE+91.40 | 64.6 | RT | 753.90 | INLETS MEDIAN 1 GRATE | MS | 1.77 | OUT | P575 | N574 | N576 | 752.13 | 751.94 | 0.50 | 37 | 41 | III | 15 | OUT |
| CENTER STREET | N576 | 22CE+91.40 | 26.0 | RT | 756.49 | INLETS 4-FT DIAMETER | H | 4.55 | IN | P577 | N576 | NE579 | 751.94 | 751.88 | 0.50 | 12 | 16 | III | 15 | IN |
| --- | --- | --- | --- | --- | --- | --- | --- | --- | --- | PE578 | --- | NE579 | --- | 750.16 | --- | --- | --- | --- | 15 | EXIST PIPE INTERPOL ELEV |
| CENTER STREET | NE579 | 23CE+07.88 | 26.0 | RT | 755.83 | --- | --- | --- | SEE ADJUSTING STRUCTURES TABLE | PE580 | NE579 | --- | 750.16 | --- | --- | --- | --- | --- | 15 | EXIST PIPE INTERPOL ELEV |
| CENTER STREET | N590 | 22CE+69.29 | 174.4 | LT | 743.38 | INLETS 3-FT DIAMETER | R-SPECIAL | 3.51 | IN | P591 | N590 | N592 | 739.87 | 739.72 | 1.00 | 15 | 18 | III | 12 | IN |
| CENTER STREET | N592 | 22CE+57.26 | 195.5 | LT | 742.86 | INLETS 3-FT DIAMETER | R-SPECIAL | 3.14 | IN | P593 | N592 | N594 | 739.72 | 739.13 | 1.00 | 59 | 62 | III | 12 | IN |
| CENTER STREET | N594 | 22CE+30.00 | 250.0 | LT | 741.86 | INLETS 4-FT DIAMETER | X | 2.73 | IN | P595 | N594 | N596 | 739.13 | 738.80 | 1.00 | 33 | 37 | III | 12 | IN |
| CENTER STREET | N596 | 21CE+97.84 | 232.3 | LT | 743.35 | MANHOLES 4-FT DIAMETER | J-SPECIAL | 4.55 | IN | PE597 | N596 | --- | 738.80 | --- | --- | --- | --- | --- | 8 | EXIST PIPE INTERPOL ELEV |
| H 41 | N990 | 462 NS+59.33 | 3.2 | LT | 742.51 | INLETS 4-FT DIAMETER | V | 3.63 | IN | PE991 | N990 | --- | 738.88 | --- | --- | --- | --- | --- | 12 | EXIST PIPE INTERPOL ELEV |

¹ DEPTH = RIM OR FLOW ELEV - LOWEST PIPE INVERT ELEVATION

² IN = PIPE OR STORM STRUCTURE WILL BE WITHIN PROPOSED OR FUTURE TRAVELED WAY.
 OUT = PIPE OR STORM STRUCTURE WILL BE OUTSIDE THE PROPOSED OR FUTURE TRAVELED WAY.
 WALL = BACKFILL SLURRY PIPE OR STORM STRUCTURE UP TO PROPOSED SUBGRADE

^A SLOPE CALCULATED BASED ON PIPE LENGTH. PIPE LENGTH REPRESENTS LENGTH OF PIPE MEASURED FROM INSIDE FACE OF STRUCTURE TO INSIDE FACE OF STRUCTURE

^B PIPE LENGTH SHOWN FOR SLOPE CALCULATION ONLY. NOT INTENDED FOR PAY QUANTITY.

^C PLAN LENGTH SHOWN FOR PAY QUANTITY.

STORM SEWER STRUCTURES

STORM SEWER PIPES

| ROADWAY | STRUCTURE NO. | STATION | OFFSET (FT) | LOCATION | RM OR FLOW ELEV | STRUCTURE TYPE | INLET/MANHOLE COVERS | DEPTH (FT) | STRUCTURE COMMENTS ² | PPE ID | FROM STR | TO STR | INLET ELEV | DISCH ELEV | SLOPE ¹ % | PIPE LENGTH ³ (FT) | PLAN LENGTH ⁴ (FT) | PIPE CLASS | PIPE SIZE (INCH) | PIPE COMMENTS ⁵ |
|---------|---------------|--------------|-------------|----------|-----------------|------------------------|----------------------|------------|--|--------|----------|--------|------------|------------|----------------------|-------------------------------|-------------------------------|------------|------------------|----------------------------|
| H 41 | N1099 | 462 NS+49.83 | 80.5 | RT | 743.02 | MANHOLES 9-FT SPECIAL | --- | 12.75 | WALL & COVER PLATE LEFT IN PLACE - FUTURE J-S COVER IN PAVEMENT | P1089A | BULKHEAD | N1099 | 730.49 | 730.27 | 0.30 | 72 | 77 | HE-III | 48x76 | WALL |
| H 41 | N1101A | 463 NS+10.03 | 86.0 | RT | 743.27 | MANHOLES 5-FT DIAMETER | --- | 6.46 | WALL & COVER PLATE LEFT IN PLACE - FUTURE V COVER AT BARRIER | P1101B | N1101A | N1102A | 732.30 | 732.28 | 0.50 | 3 | 7 | II | 24 | WALL |
| H 41 | N1102A | 462 NS+60.49 | 86.0 | RT | 743.04 | INLETS 4-FT DIAMETER | --- | 6.71 | WALL & COVER PLATE LEFT IN PLACE - FUTURE V COVER AT BARRIER | P1102B | N1102A | N1099 | 730.27 | 730.00 | 0.30 | 90 | 99 | HE-III | 48x76 | WALL |
| H 41 | N1105 | 463 NS+29.99 | 96.0 | RT | 741.30 | INLETS MEDIAN 2 GRATE | --- | 4.30 | WALL & COVER PLATE LEFT IN PLACE - FUTURE MS-2 COVER OUTSIDE PAVEMENT | P1106 | N1105 | N1101A | 737.00 | 736.61 | 1.00 | 20 | 24 | II | 24 | WALL |
| H 41 | N1107A | 461 NS+75.00 | 90.0 | RT | 742.62 | INLETS MEDIAN 1 GRATE | --- | 5.45 | WALL & COVER PLATE LEFT IN PLACE - FUTURE MS-1 COVER OUTSIDE PAVEMENT | P1107B | N1107A | N1108A | 737.17 | 737.16 | 0.50 | 3 | 6 | II | 18 | WALL |
| H 41 | N1108A | 461 NS+75.00 | 86.0 | RT | 742.74 | INLETS 4-FT DIAMETER | --- | 6.08 | WALL & COVER PLATE LEFT IN PLACE - FUTURE V COVER AT BARRIER | P1108B | N1108A | N1108A | 736.66 | 736.63 | 0.50 | 6 | 10 | II | 24 | WALL |
| H 41 | N1109A | 461 NS+65.23 | 86.0 | RT | 742.76 | INLETS 4-FT DIAMETER | --- | 6.13 | WALL & COVER PLATE LEFT IN PLACE - FUTURE V COVER AT BARRIER | P1109B | N1109A | N1194 | 736.63 | 736.61 | 0.50 | 4 | 11 | II | 24 | WALL |
| H 41 | N1119 | 463 NS+50.18 | 86.0 | LT | 740.97 | MANHOLES 5-FT DIAMETER | --- | 4.90 | CONNECT UNDERDRAIN FROM WALL R-40-577 WALL & COVER PLATE LEFT IN PLACE - FUTURE V COVER AT BARRIER | P1118 | BULKHEAD | N1119 | 737.17 | 736.07 | 22.00 | 5 | 8 | II | 24 | OUT |
| H 41 | N1121 | 462 NS+49.79 | 90.2 | LT | 739.98 | INLETS MEDIAN 1 GRATE | --- | 3.67 | WALL & COVER PLATE LEFT IN PLACE - FUTURE MS-1 COVER OUTSIDE PAVEMENT | P1122 | N1121 | N1123 | 736.07 | 736.80 | 0.30 | 90 | 95 | IV | 24 | WALL |
| H 41 | N1123 | 462 NS+49.83 | 86.0 | LT | 740.21 | MANHOLES 5-FT DIAMETER | --- | 4.41 | WALL & COVER PLATE LEFT IN PLACE - FUTURE V COVER AT BARRIER | P1124 | N1123 | N1135 | 736.31 | 736.30 | 0.30 | 3 | 7 | III | 18 | WALL |
| H 41 | N1131 | 460 NS+42.56 | 85.7 | LT | 743.66 | INLETS 4-FT DIAMETER | --- | 4.84 | WALL & COVER PLATE LEFT IN PLACE - FUTURE V COVER AT BARRIER | P1132 | N1131 | N1135 | 735.80 | 735.55 | 0.30 | 84 | 90 | IV | 24 | WALL |

Addendum No. 01
ID 1060-34-84 &
ID 1060-35-85
Revised Sheet 200
November 30, 2015

1

¹ DEPTH = RM OR FLOW ELEV - LOWEST PIPE INVERT ELEVATION
² IN = PIPE OR STORM STRUCTURE WILL BE WITHIN PROPOSED OR FUTURE TRAVELED WAY.
 OUT = PIPE OR STORM STRUCTURE WILL BE OUTSIDE THE PROPOSED OR FUTURE TRAVELED WAY.
 WALL = BACKFILL SLURRY PIPE OR STORM STRUCTURE UP TO PROPOSED SUBGRADE
³ SLOPE CALCULATED BASED ON PIPE LENGTH. PIPE LENGTH REPRESENTS LENGTH OF PIPE MEASURED FROM INSIDE FACE OF STRUCTURE TO INSIDE FACE OF STRUCTURE
⁴ PIPE LENGTH SHOWN FOR SLOPE CALCULATION ONLY. ⁵ PLAN LENGTH SHOWN FOR QUANTITY.
 NOT INTENDED FOR PAY QUANTITY.

STORM SEWER PIPES

STORM SEWER STRUCTURES

| ROADWAY | STRUCTURE NO. | STATION | OFFSET (FT) | LOCATION | RIM OR FLOW ELEV | STRUCTURE TYPE | INLET/MANHOLE COVERS | DEPTH (FT) | STRUCTURE COMMENTS ² | PIPE ID | FROM STR | TO STR | INLET ELEV | DSCH ELEV | SLOPE ^A % | PIPE LENGTH ^B (FT) | PLAN LENGTH ^C (FT) | PIPE CLASS | PIPE SIZE (INCH) | PIPE COMMENTS ² |
|---------|---------------|--------------|-------------|----------|------------------|------------------------|----------------------|------------|---|---------|----------|----------|------------|-----------|----------------------|-------------------------------|-------------------------------|------------|------------------|----------------------------|
| IH 41 | N1135 | 461 NS+65.45 | 86.0 | LT | 741.02 | MANHOLES 6-FT DIAMETER | V | 5.97 | WALL | PE1136A | N1135 | N1136B | 735.05 | 735.01 | 0.50 | 8 | 11 | III | 30 | WALL |
| IH 41 | N1136C | 461 NS+65.36 | 72.7 | LT | 742.44 | MANHOLES 6-FT DIAMETER | X | 5.63 | WALL | PE1136B | N1136C | N1136C | 737.11 | 737.11 | --- | --- | --- | --- | 24 | EXIST PIPE INTERPOL ELEV |
| IH 41 | N1136E | 462 NS+60.00 | 6.0 | LT | 744.52 | INLETS 4-FT DIAMETER | --- | 6.25 | COVER PLATE LEFT IN PLACE - FUTURE V COVER AT BARRIER | PE1136D | N1136E | N1136E | 736.61 | --- | --- | --- | --- | --- | 30 | EXIST PIPE INTERPOL ELEV |
| IH 41 | N1150A | 460 NS+42.15 | 85.7 | RT | 744.01 | INLETS 4-FT DIAMETER | --- | 6.58 | WALL & COVER PLATE LEFT IN PLACE - FUTURE V COVER AT BARRIER | P1147 | BULKHEAD | N1194 | 732.20 | 732.17 | 0.50 | 8 | 12 | III | 30 | WALL |
| IH 41 | N1151A | 459 NS+38.55 | 85.0 | RT | 746.11 | INLETS 4-FT DIAMETER | --- | 9.68 | WALL & COVER PLATE LEFT IN PLACE - FUTURE 27-M COVER AT BARRIER | P1150B | N1150A | N1151A | 737.43 | 736.43 | 1.00 | 100 | 104 | III | 24 | WALL |
| IH 41 | N1152 | 455 NS+68.03 | 94.0 | RT | 752.50 | INLETS MEDIAN 2 GRATE | --- | 5.72 | WALL & COVER PLATE LEFT IN PLACE - FUTURE MS-2 COVER OUTSIDE PAVEMENT | P1151B | N1151A | N1196 | 736.43 | 736.39 | 1.00 | 4 | 11 | III | 24 | WALL |
| IH 41 | N1176 | 457 NS+64.68 | 94.1 | LT | 748.00 | INLETS MEDIAN 2 GRATE | MS | 3.90 | WALL & COVER PLATE LEFT IN PLACE - FUTURE MS-2 COVER OUTSIDE PAVEMENT | P1153 | N1152 | BULKHEAD | 746.78 | 746.23 | 1.00 | 55 | 62 | III | 18 | WALL |
| IH 41 | N1178 | 457 NS+64.69 | 84.0 | LT | 750.11 | MANHOLES 5-FT DIAMETER | --- | 6.18 | WALL & COVER PLATE LEFT IN PLACE - FUTURE V COVER AT BARRIER | P1177 | N1176 | N1178 | 744.10 | 743.93 | 1.90 | 9 | 13 | III | 24 | WALL |
| IH 41 | N1185 | 459 NS+28.60 | 84.9 | LT | 746.56 | INLETS 4-FT DIAMETER | --- | 5.68 | WALL & COVER PLATE LEFT IN PLACE - FUTURE V COVER AT BARRIER | P1183 | N1178 | N1185 | 743.33 | 740.90 | 1.90 | 159 | 164 | III | 24 | WALL |
| IH 41 | N1194 | 461 NS+65.45 | 80.5 | RT | 742.84 | MANHOLES 9-FT SPECIAL | --- | 12.84 | WALL & COVER PLATE LEFT IN PLACE - FUTURE J-S COVER IN PAVEMENT | P1186 | N1185 | N1131 | 740.90 | 738.82 | 1.90 | 110 | 114 | III | 24 | WALL |
| IH 41 | N1196 | 459 NS+28.43 | 79.4 | RT | 746.48 | MANHOLES 9-FT SPECIAL | --- | 17.14 | WALL & COVER PLATE LEFT IN PLACE - FUTURE J-S COVER IN PAVEMENT | P1195 | N1194 | N1196 | 730.00 | 729.94 | 0.30 | 221 | 230 | HE-III | 48x76 | WALL |
| IH 41 | N1198A | 458 NS+11.88 | 84.1 | RT | 749.10 | INLETS 4-FT DIAMETER | --- | 6.43 | WALL & COVER PLATE LEFT IN PLACE - FUTURE V COVER AT BARRIER | P1194B | BULKHEAD | N1196 | 736.65 | 736.60 | 2.00 | 3 | 7 | III | 30 | WALL |
| IH 41 | N1199A | 457 NS+37.14 | 84.0 | RT | 750.87 | INLETS 4-FT DIAMETER | --- | 8.55 | WALL & COVER PLATE LEFT IN PLACE - FUTURE 27-M COVER AT BARRIER | P1197 | N1196 | N1204 | 729.34 | 728.67 | 0.35 | 191 | 200 | HE-IV | 48x76 | WALL |
| IH 41 | N1204 | 457 NS+28.25 | 78.5 | RT | 751.21 | MANHOLES 9-FT SPECIAL | --- | 22.54 | WALL & COVER PLATE LEFT IN PLACE - FUTURE J-S COVER IN PAVEMENT | P1198B | N1198A | N1199A | 742.67 | 742.32 | 0.50 | 71 | 75 | III | 24 | WALL |
| IH 41 | N1205 | 457 NS+28.25 | 78.5 | RT | 751.21 | MANHOLES 9-FT SPECIAL | --- | 22.54 | WALL & COVER PLATE LEFT IN PLACE - FUTURE J-S COVER IN PAVEMENT | P1199B | N1199A | N1204 | 742.32 | 742.30 | 0.50 | 3 | 10 | III | 24 | WALL |
| IH 41 | N1204 | 457 NS+28.25 | 78.5 | RT | 751.21 | MANHOLES 9-FT SPECIAL | --- | 22.54 | WALL & COVER PLATE LEFT IN PLACE - FUTURE J-S COVER IN PAVEMENT | P1205 | N1204 | BULKHEAD | 728.67 | 728.00 | 0.35 | 191 | 200 | HE-IV | 48x76 | WALL |

¹ DEPTH = RIM OR FLOW ELEV - LOWEST PIPE INVERT ELEVATION
² IN = PIPE OR STORM STRUCTURE WILL BE WITHIN PROPOSED OR FUTURE TRAVELED WAY.
 OUT = PIPE OR STORM STRUCTURE WILL BE OUTSIDE THE PROPOSED OR FUTURE TRAVELED WAY.
 WALL = BACKFILL SLURRY PIPE OR STORM STRUCTURE UP TO PROPOSED SUBGRADE
^A SLOPE CALCULATED BASED ON PIPE LENGTH. PIPE LENGTH REPRESENTS LENGTH OF PIPE MEASURED FROM INSIDE FACE OF STRUCTURE TO INSIDE FACE OF STRUCTURE
^B PIPE LENGTH SHOWN FOR SLOPE CALCULATION ONLY.
^C PLAN LENGTH SHOWN FOR PAY QUANTITY.
 NOT INTENDED FOR PAY QUANTITY.

| STORM SEWER STRUCTURE SUMMARY | | | | | | | | | | | | | | | | | | | | | | | | | | | | | |
|--|---|---|---|---|---|--|---|--|----|--------------------|---|---------------------------|---|----------------------------------|---|-------------------------------|---|---------------------------|---|--------------------------|---|--------------------------|---|--------------------------|---|-------------------------------|---|----------------------------|---|
| 611.2004 MANHOLES 4-FT DIAMETER EACH | 1 | 611.2006* MANHOLES 6-FT DIAMETER EACH | 2 | 611.2008* MANHOLES 8-FT DIAMETER EACH | 1 | 611.3003 INLETS 3-FT DIAMETER EACH | 2 | 611.3004 INLETS 4-FT DIAMETER EACH | 19 | 611.3230 INLETS | 1 | 611.3801 INLETS | 3 | 611.3802 INLETS * MANHOLES | 4 | 611.0535 MANHOLE COVERS | 2 | 611.0624 INLET COVERS | 8 | 611.0642 INLET COVERS | 3 | 611.0654 INLET COVERS | 2 | 611.0663 INLET COVERS | 2 | SPV.0060.8006 INLET COVERS | 2 | TYPE R- SPECIAL EACH | 2 |
| 4-FT DIAMETER EACH | 1 | 5-FT DIAMETER EACH | 4 | 6-FT DIAMETER EACH | 2 | 3-FT DIAMETER EACH | 2 | 4-FT DIAMETER EACH | 19 | 2x3-FT EACH | 1 | MEDIAN 1 GRATE EACH | 3 | MEDIAN 2 GRATE EACH | 3 | 9-FT SPECIAL EACH | 4 | TYPE J SPECIAL EACH | 2 | TYPE H EACH | 8 | TYPE MS EACH | 3 | TYPE V EACH | 2 | TYPE X EACH | 2 | TYPE R- SPECIAL EACH | 2 |

1

| STORM SEWER PIPE SUMMARY | | | | | | | | | | | | | | | | | |
|--|-----|--|-----|--|-----|--|-----|--|----|--|-----|--|-----|--|-----|--|-----|
| 608.0312* STORM SEWER PIPE REINFORCED CONCRETE CLASS III 12-INCH LF | 197 | 608.0315* STORM SEWER PIPE REINFORCED CONCRETE CLASS III 15-INCH LF | 136 | 608.0318* STORM SEWER PIPE REINFORCED CONCRETE CLASS III 18-INCH LF | 184 | 608.0324 STORM SEWER PIPE REINFORCED CONCRETE CLASS II 24-INCH LF | 769 | 608.0330 STORM SEWER PIPE REINFORCED CONCRETE CLASS II 30-INCH LF | 30 | 608.0424 STORM SEWER PIPE REINFORCED CONCRETE CLASS IV 24-INCH LF | 193 | 610.0148 STORM SEWER PIPE REINFORCED CONCRETE HORIZONTAL ELLIPTICAL CLASS HE-IV 48X76-INCH LF | 406 | 610.0148 STORM SEWER PIPE REINFORCED CONCRETE HORIZONTAL ELLIPTICAL CLASS HE-IV 48X76-INCH LF | 406 | SPV.0090.8010 STORM SEWER PIPE REINFORCED CONCRETE HORIZONTAL ELLIPTICAL CLASS HE-IV 48X76-INCH LF | 400 |


1

Addendum No. 01
 ID 1060-34-84 &
 ID 1060-35-85
 Revised Sheet 202
 November 30, 2015



* ADDITIONAL QUANTITIES LISTED ELSEWHERE IN PLAN

*TOP SLAB OPENING FOR INLET COVERS TYPE R- SPECIAL SHALL BE 1'-7"X2'-6"
 ALL ITEMS CATEGORY 1000



Addendum No. 01
 ID 1060-34-84 &
 ID 1060-35-85
 Revised Sheet 229
 November 30, 2015

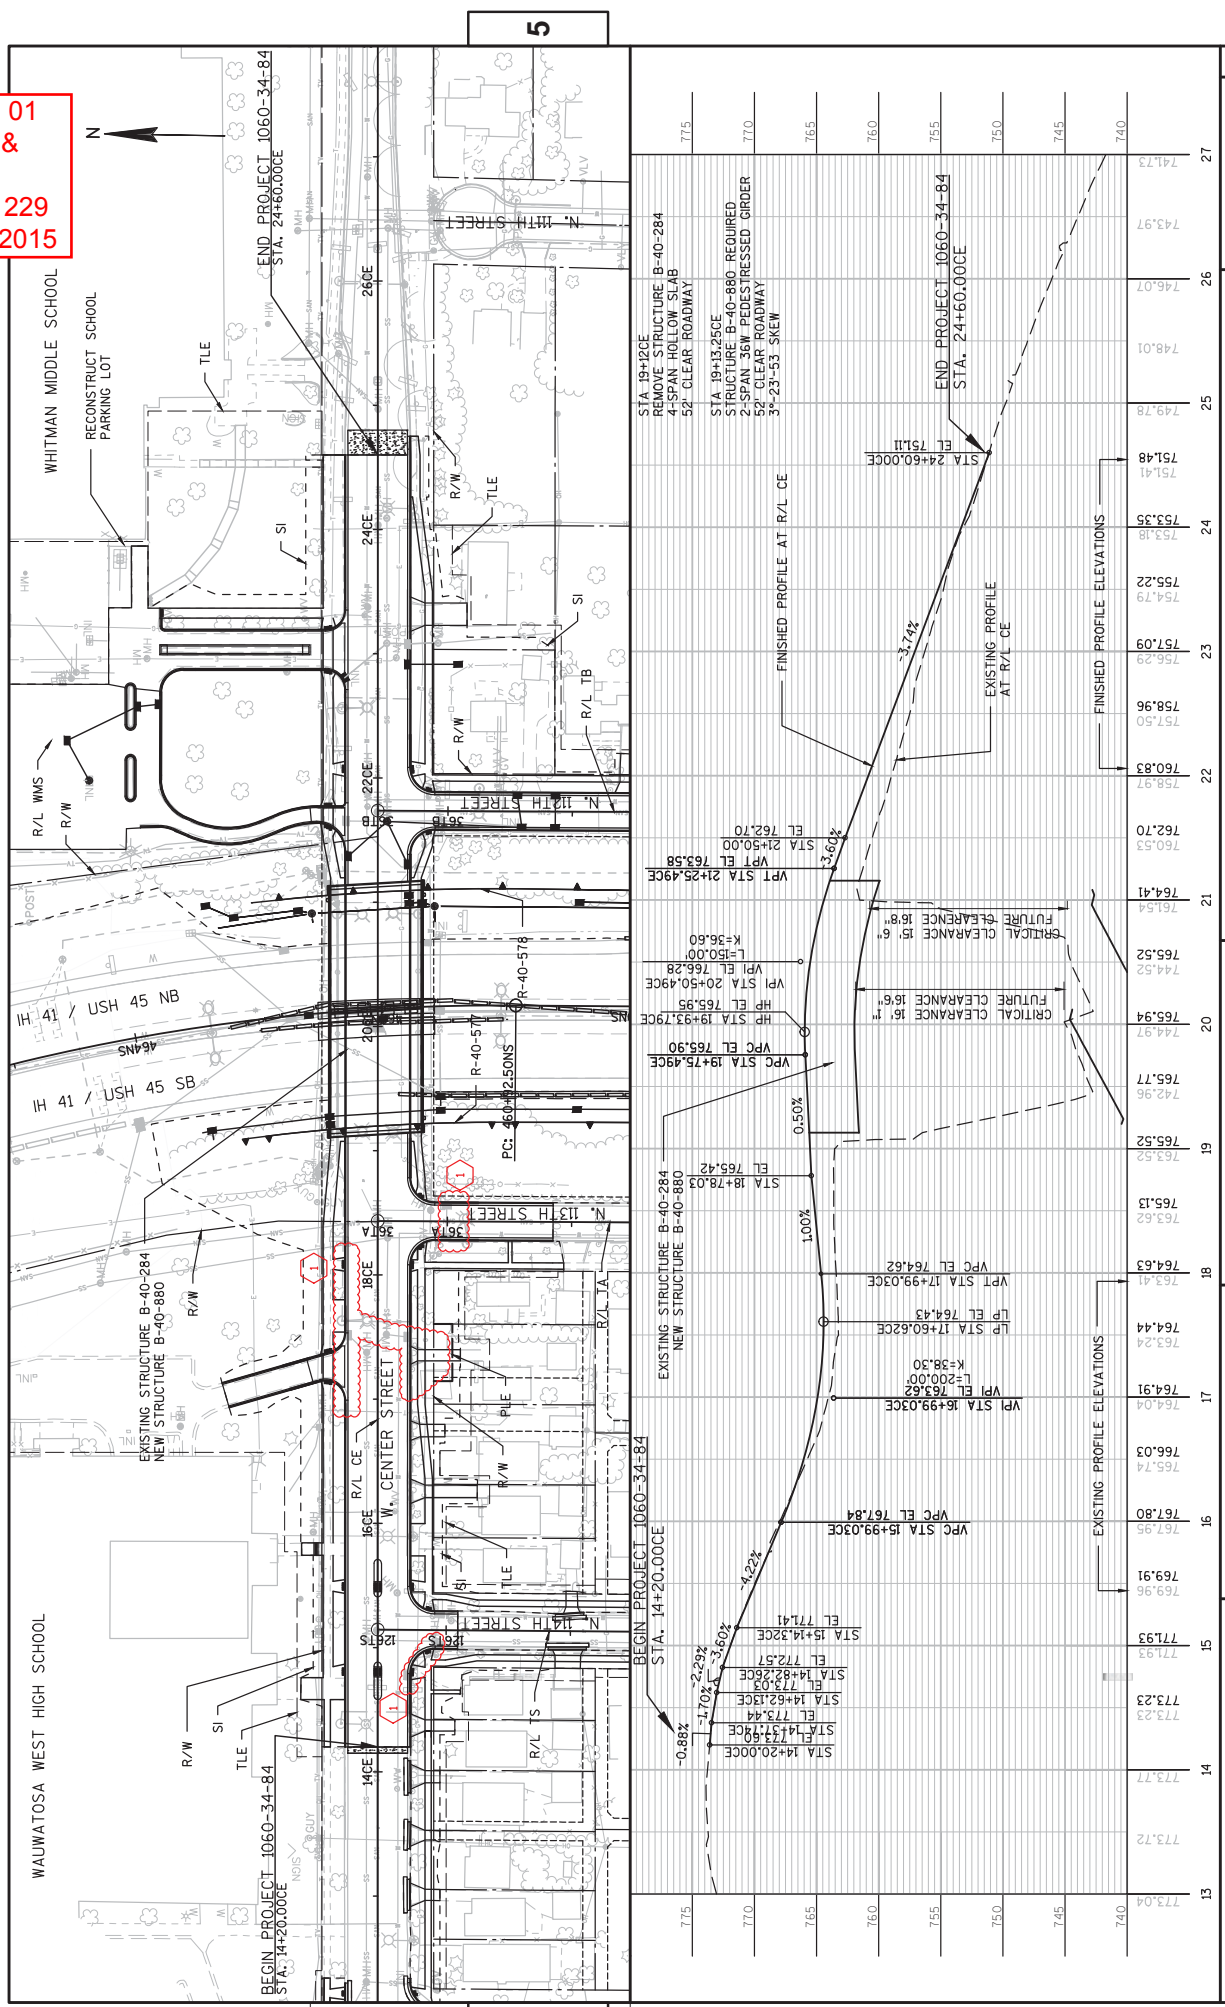

| STATION | ELEVATION | DESCRIPTION |
|---------|-----------|----------------------------|
| 13+00 | 773.04 | EXISTING PROFILE AT R/L CE |
| 13+25 | 773.12 | EXISTING PROFILE AT R/L CE |
| 14+00 | 773.77 | EXISTING PROFILE AT R/L CE |
| 14+20 | 773.23 | EXISTING PROFILE AT R/L CE |
| 14+30 | 773.03 | EXISTING PROFILE AT R/L CE |
| 14+40 | 773.44 | EXISTING PROFILE AT R/L CE |
| 14+50 | 771.93 | EXISTING PROFILE AT R/L CE |
| 14+60 | 771.93 | EXISTING PROFILE AT R/L CE |
| 14+70 | 771.41 | EXISTING PROFILE AT R/L CE |
| 14+80 | 771.41 | EXISTING PROFILE AT R/L CE |
| 14+90 | 771.41 | EXISTING PROFILE AT R/L CE |
| 15+00 | 771.93 | EXISTING PROFILE AT R/L CE |
| 15+10 | 772.51 | EXISTING PROFILE AT R/L CE |
| 15+20 | 772.51 | EXISTING PROFILE AT R/L CE |
| 15+30 | 773.03 | EXISTING PROFILE AT R/L CE |
| 15+40 | 773.03 | EXISTING PROFILE AT R/L CE |
| 15+50 | 773.44 | EXISTING PROFILE AT R/L CE |
| 15+60 | 773.44 | EXISTING PROFILE AT R/L CE |
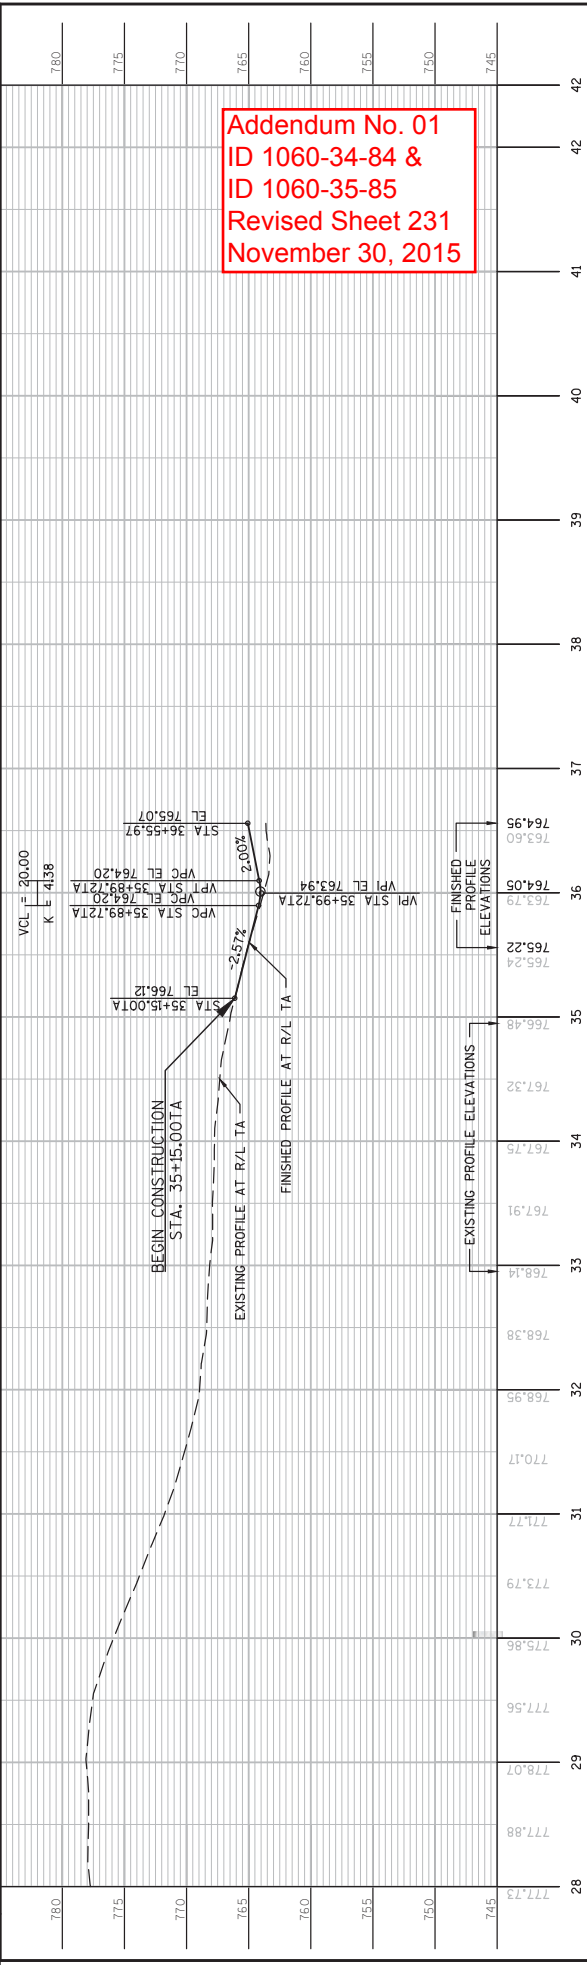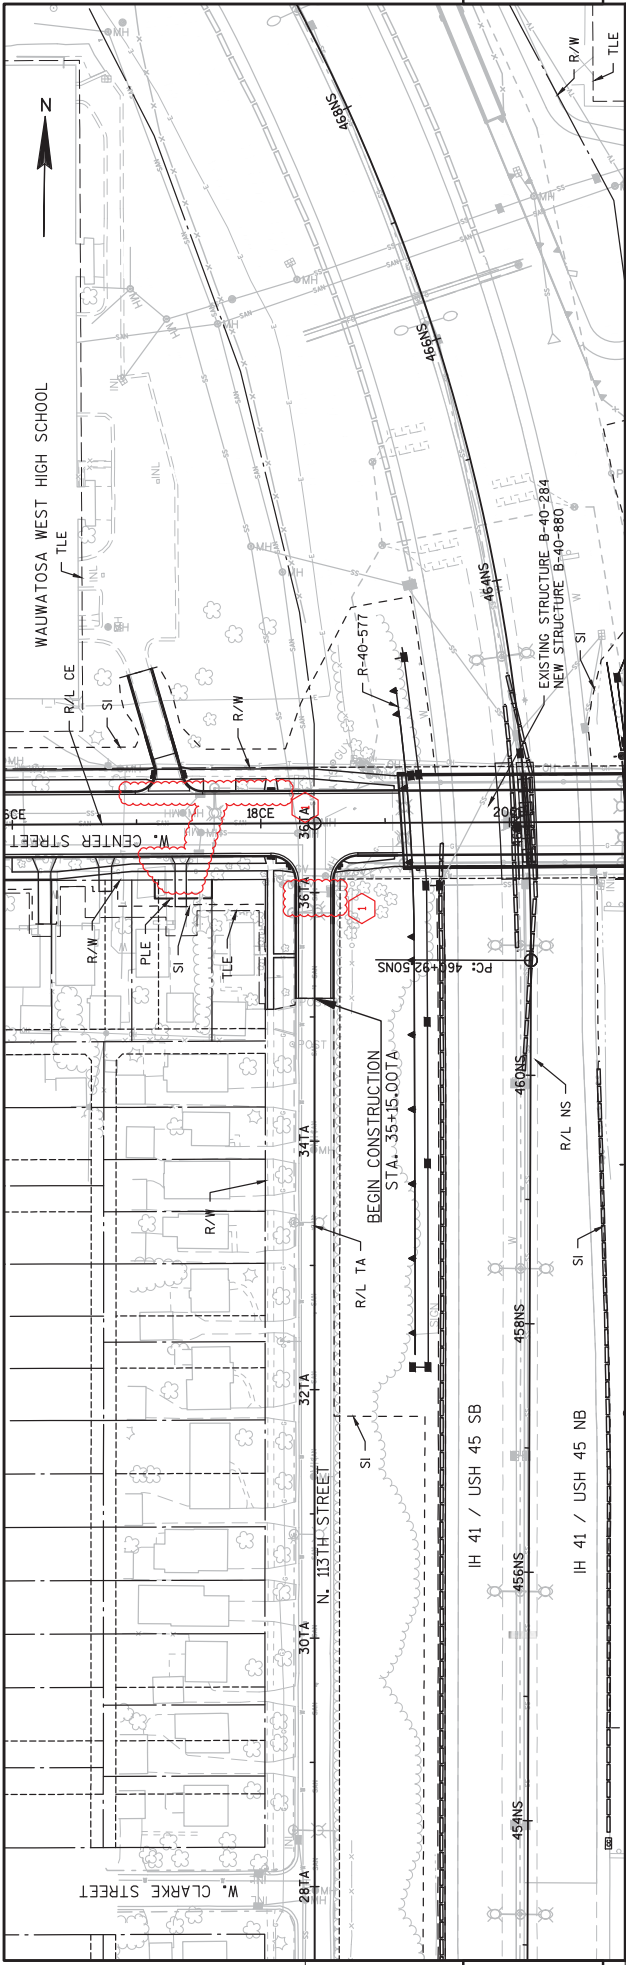

Addendum No. 01
 ID 1060-34-84 &
 ID 1060-35-85
 Revised Sheet 231
 November 30, 2015


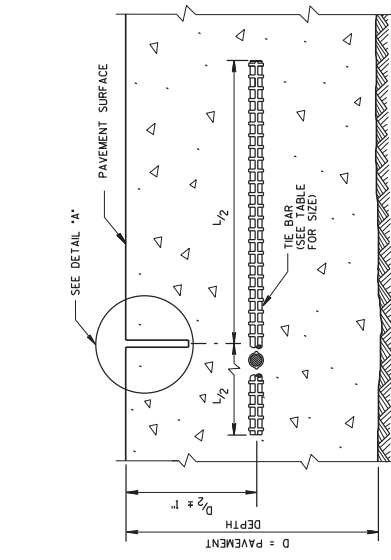
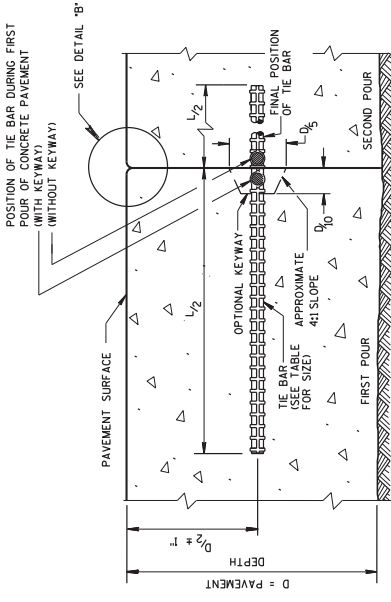


GENERAL NOTES

- DO NOT SEAL OR FILL LONGITUDINAL JOINTS.
- CREATE A LONGITUDINAL JOINT FOR PAVEMENT WIDTHS GREATER THAN 15 FEET.
- CORRELATE LONGITUDINAL JOINTS WITH LANE LINES WHEN POSSIBLE.
- ① ANCHOR TIE BARS INTO DRILLED HOLES WITH AN EPOXY.
- ② PAVEMENT THAT WAS IN PLACE PRIOR TO THE CONTRACT.

CONSTRUCTION JOINT


SAWED JOINT

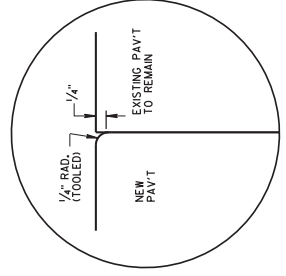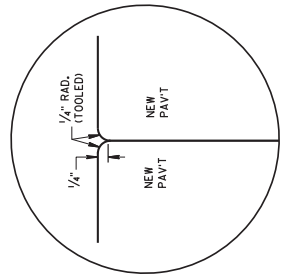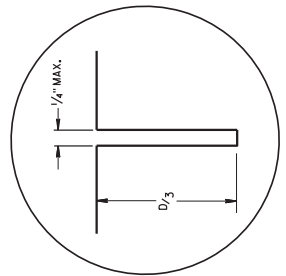

DETAIL "A"

DETAIL "B"

DETAIL "C"

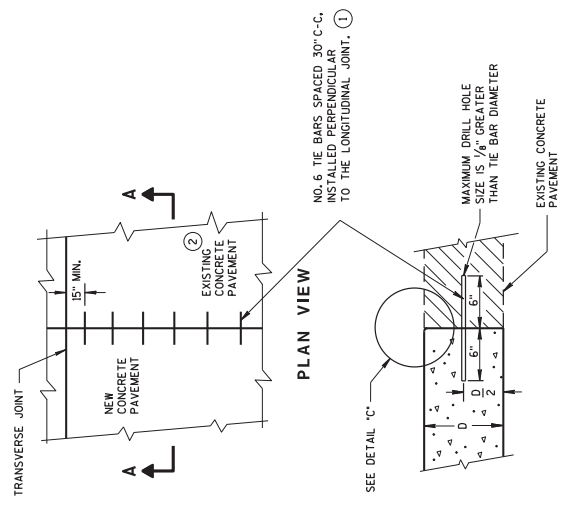


NO. 6 TIE BARS SPACED 30" C-C, TO BE FILLED WITH EPOXY ADHESIVE TO THE LONGITUDINAL JOINT. ①

| TIE BAR TABLE | | | |
|--------------------|--------------|--------------------|----------------------|
| PAVEMENT DEPTH (D) | TIE BAR SIZE | TIE BAR LENGTH (L) | MAX. TIE BAR SPACING |
| < 10 1/2" | NO. 4 | 30" | 36" |
| > 10 1/2" | NO. 5 | 36" | 36" |
| | NO. 4 | 30" | 24" ** |

* SUBSTITUTE BENT BARS AT LONGITUDINAL JOINTS WHEN EQUIPMENT LIMITATIONS DURING CONSTRUCTION WARRANT (e.g. AUXILIARY LANES OR TURN LANES)

** CONFORM TO 15" MINIMUM SPACING FROM TRANSVERSE JOINTS; SPACING BETWEEN TIE BARS WILL BE 30" AT TRANSVERSE JOINTS.

**SECTION A-A
LONGITUDINAL CONSTRUCTION JOINT
TIE BARS ANCHORED
INTO EXISTING PAVEMENT**

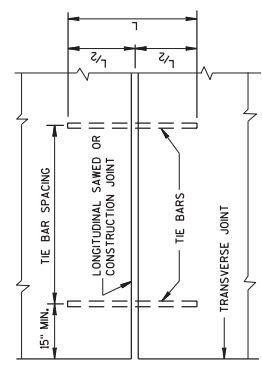

PLAN VIEW
SHOWING LOCATION OF TIE BARS

Addendum No. 01
ID 1060-34-84 &
ID 1060-35-85
Added Sheet 264A
November 30, 2015

**CONCRETE PAVEMENT
LONGITUDINAL JOINTS AND TIES**

STATE OF WISCONSIN
DEPARTMENT OF TRANSPORTATION

APPROVED _____
DATE June, 2005
P.W.M.A.

_____/s/ Peter Kamp, P.E.
PAVEMENT SUPERVISOR

TOTAL ESTIMATED QUANTITIES

| BID NUMBER | BID ITEMS | QUANTITY | UNIT |
|--------------|--|----------|------|
| 206.3000 | EXCAVATION FOR STRUCTURES RETAINING WALL R-40-577 | 465 | LS |
| 513.2001 | RAILING PIPE R-40-577 | 9 | LF |
| 516.0500 | RUBBERED MEMBRANE WATERPROOFING | 575 | SY |
| 612.0406 | PIPE UNDERDRAIN WRAPPED 6-INCH | 7,670 | SF |
| SPV0165-4005 | WALL CONCRETE PANEL MECHANICALLY STABILIZED EARTH LRFD/OMP | | |
| | NON-BID ITEMS | | |
| | EXPANDED POLYSTYRENE | 1" | SIZE |
| | PREFORMED JOINT FILLER | 3/4" | SIZE |
| | NON-BITUMINOUS JOINT SEALER | | |
| | NAME PLATE | | |
| | ALL ITEMS ARE CATEGORY 3000 | | |

GENERAL NOTES

- DRAWINGS SHALL NOT BE SCALED.
- BEVEL ALL EXPOSED EDGES OF CONCRETE 1/4" UNLESS NOTED OTHERWISE.
- BAR STEEL REINFORCEMENT SHALL HAVE 2" CLEAR COVER UNLESS OTHERWISE SHOWN OR NOTED.
- ALL BAR STEEL REINFORCEMENT IN CONCRETE COPING IS TO BE EPOXY COATED.
- STABILIZED EARTH LRFD/OMP IS BASED ON A WALL HEIGHT MEASURED FROM THE TOP OF THE WALL TO THE TOP OF THE LEVELING PAD. THE TOP OF LEVELING PAD IS BASED ON THE 1" BELIEVED FINISH GRADE. AREAS CONSTRUCTED OUTSIDE THESE LIMITS WILL NOT BE MEASURED FOR PAYMENT.
- THE QUANTITY OF CONCRETE, MASONRY & REINFORCING STEEL FOR THE MECHANICALLY STABILIZED EARTH LRFD/OMP IS THE ITEM "WALL CONCRETE PANEL MECHANICALLY STABILIZED EARTH LRFD/OMP".
- THE UPPER LIMITS OF EXCAVATION FOR EXCAVATION FOR STRUCTURES RETAINING WALL R-40-577 SHALL BE THE EXISTING GROUND LINE.
- THE CONTRACTOR MUST COORDINATE THE CONSTRUCTION OF WALL R-40-577 WITH THE CONSTRUCTION OF BRIDGE #1-98.
- OVER EXCAVATE 6" BELOW THE LEVELING PAD AND REINFORCEMENT ZONE ALONG WITH GRANULAR BACKFILL WORK SHALL BE INCIDENTAL TO THE BID ITEM "WALL CONCRETE PANEL MECHANICALLY STABILIZED EARTH LRFD/OMP".
- THE COST OF FURNISHING AND PLACING (USE BACKFILL WITHIN THE REINFORCED SOIL ZONE IS TO BE INCLUDED IN THE BID ITEM "WALL CONCRETE PANEL MECHANICALLY STABILIZED EARTH LRFD/OMP".
- EXPANSION/CONTRACT JOINT CALLOUTS ARE FOR INFORMATIONAL USE ONLY. IT IS THE RESPONSIBILITY OF THE CONTRACTOR TO DETERMINE THE SHEET FOR DETAILS.
- THE QUANTITIES AND REINFORCEMENT DETAILS ARE BASED ON AN ASSUMED CONCRETE WALL PANEL THICKNESS OF 7/8" FOR PANEL THICKNESSES DIFFERENT THAN 7/8" INCHES. THE CONTRACTOR SHALL VERIFY REINFORCEMENT BAR DETAILS AND QUANTITIES AND WILL BE RESPONSIBLE FOR ANY QUANTITY VARIATIONS.
- THE COST OF FURNISHING AND PLACING THE UNREINFORCED CONCRETE, THE BID ITEM "WALL CONCRETE PANEL MECHANICALLY STABILIZED EARTH LRFD/OMP", SHALL BE INCLUDED IN THE BID ITEM "WALL CONCRETE PANEL MECHANICALLY STABILIZED EARTH LRFD/OMP".
- THE CONTRACTOR SHALL PROVIDE COMPLETE DESIGN PLANS, DETAILS, AND CONSTRUCTION DETAILS FOR THE RETAINING WALL.
- MANUFACTURER SHALL PROVIDE TECHNICAL ASSISTANCE TO THE CONTRACTOR TO VERIFY THE CONSTRUCTION OF THESE ITEMS SHALL BE INCLUDED IN THE BID ITEM "WALL CONCRETE PANEL MECHANICALLY STABILIZED EARTH LRFD/OMP".
- PLANS, ELEVATIONS, AND DETAILS SHOWN ON THESE DRAWINGS ARE INTENDED TO INDICATE WALL LOCATIONS, LENGTHS, HEIGHTS, AND DETAILS COMMON TO THE WALL SYSTEM SELECTED. THE CONTRACTOR SHALL VERIFY THAT THE WALL SYSTEM SELECTED WILL CONFORM TO THE REQUIRED ALIGNMENTS AND DETAILS.
- THE MAXIMUM VALUE OF THE ANGLE OF INTERNAL FRICTION OF THE WALL BACKFILL MATERIAL REINFORCED ZONE SHALL BE ASSUMED TO BE 30 DEGREES WITHOUT CERTIFIED TEST VALUES.
- ALL STATIONS AND ELEVATIONS ARE IN FEET. ELEVATIONS ARE REFERENCED TO THE NAVD 88 DATUM.
- EXISTING STRUCTURE B-40-284 IS NOT SHOWN IN THESE PLANS. THE REMOVAL OF THIS STRUCTURE IS INCLUDED IN A LUMP SUM PAY ITEM AS PART OF THE B-40-880 BRIDGE QUANTITIES.
- THESE PLANS ARE FOR A PRECAST CONCRETE PANEL MECHANICALLY STABILIZED EARTH REINFORCING WALL.
- THE VOLUME OF EARTHWORK REQUIRED TO INSTALL THE UNREINFORCED CONCRETE IS INCLUDED IN THE BID ITEM "WALL CONCRETE PANEL MECHANICALLY STABILIZED EARTH LRFD/OMP".
- PROVIDE A SACK RUBBED FINISH IN ACCORDANCE TO STANDARD SPECIFICATION 502.3.7.5 AND AS MODIFIED HERE ON ALL EXPOSED CONCRETE SURFACES WHERE CONCRETE STAINING WILL BE APPLIED IN A FUTURE CONTRACT. THE MORTAR SHALL CONTAIN ONE PART PORTLAND CEMENT TO TWO PARTS SAND. THE FINISH SHALL BE IN ACCORDANCE TO MANUFACTURER'S RECOMMENDATIONS; 1K-225 BY TK PRODUCTS, ACRH 60 BY THORO PRODUCTS, OR ACRH 60 SET BY MASTER BUILDERS. THIS WORK IS INCIDENTAL TO THE BID ITEM "WALL CONCRETE PANEL MECHANICALLY STABILIZED EARTH LRFD/OMP".
- THE UTILITY INFORMATION SHOWN ON THESE DRAWINGS CONCERNING TYPE AND LOCATION OF UTILITIES IS FOR INFORMATIONAL USE ONLY. THE CONTRACTOR SHALL VERIFY THE LOCATION OF UNDERGROUND UTILITIES AS NECESSARY TO AVOID DAMAGE.
- UTILITIES LABELED PROPOSED MAY BE INSTALLED PRIOR TO CONSTRUCTION.
- ONLY WALL CONCRETE PANEL USE WALL SYSTEMS THAT USE STRIP TYPE SOIL REINFORCEMENT THAT ARE WINGED AT THE PANEL CONNECTION CAN BE USED FOR THE PROJECT.

SOIL PARAMETERS

| SOIL DESCRIPTION | FRICTION ANGLE (DEGREES) | COHESION (PSF) | UNIT WEIGHT (PCF) |
|---|--------------------------|----------------|-------------------|
| GRANULAR BACKFILL WITHIN THE WALL IN THE REINFORCING ZONE | 30 | 0 | 120 |
| FILL BEHIND AND BELOW THE REINFORCING ZONE | 31 | 0 | 120 |
| SILT, GRAY, TRACE SAND AND GRAVEL (ELEVATION 743.5FT - 738.4FT) | 0 | 4,500 | 135 |
| SAND, GRAY, FINE TO MEDIUM (ELEVATION 741.4FT - 737.4FT) | 36 | 0 | 135 |
| SILT, GRAY, TRACE SAND, TRACE CLAY (ELEVATION 737.4FT - 723.4FT) | 0 | 2,500 | 125 |
| SILT, GRAY, TRACE SAND, TRACE CLAY (ELEVATION 723.4FT - 716.4FT) | 0 | 4,500 | 135 |
| SILT, GRAY, TRACE CLAY, TRACE SAND, TRACE GRAVEL (ELEVATION 743.5FT - 738.4FT) | 0 | 4,500 | 135 |
| CLAY, GRAY, TRACE SAND, TRACE GRAVEL (ELEVATION 738.4FT - 735.6FT) | 32 | 0 | 120 |
| CLAY, GRAY, LITTLE SILT, TRACE SAND, TRACE GRAVEL (ELEVATION 732.4FT - 710.4FT) | 0 | 3,000 | 128 |
| CLAY, GRAY, LITTLE SILT, TRACE SAND, TRACE GRAVEL (ELEVATION 710.4FT - 703.4FT) | 0 | 4,500 | 135 |
| CLAY, GRAY, TRACE GRAVEL (ELEVATION 736.6FT - 733.6FT) | 0 | 3,000 | 125 |
| CLAY, GRAY, TRACE GRAVEL (ELEVATION 733.6FT - 726.6FT) | 0 | 2,500 | 120 |
| CLAY, GRAY, TRACE SAND, TRACE GRAVEL (ELEVATION 726.6FT - 717.6FT) | 0 | 2,000 | 120 |
| CLAY AND SILT, GRAY, TRACE SAND AND GRAVEL (ELEVATION 717.6FT - 705.6FT) | 0 | 4,500 | 135 |
| CLAY, GRAY, TRACE SAND (ELEVATION 705.6FT - 700.6FT) | 0 | 2,000 | 120 |
| SILT, GRAY, SOME SAND, TRACE GRAVEL (ELEVATION 700.6FT AND BELOW) | 0 | 25,000 | 135 |

WALL EXTERNAL STABILITY EVALUATION


| DIMENSIONS | CAPACITY TO DEMAND RATIO (CDR) ⁴ | |
|---|---|----------|
| | SLIDING | ROTATION |
| WALL HEIGHT (FEET) ¹ | 10.2 | 13.2 |
| EXPOSED WALL HEIGHT (FEET) | 8.7 | 11.7 |
| LENGTH OF REINFORCEMENT (FEET) ³ | 8.0 | 9.2 |
| LENGTH OF REINFORCING / WALL HEIGHT | N.A. | 0.70 |
| WALL STATION | 1H+00.0 | 1H+00.0 |
| BORING USED | B-7 | B-6 |
| SLIDING (CDR _{req} > 1.0) | 1.4 | 1.3 |
| ECCENTRICITY (CDR _{req} > 1.0) | 1.5 | 1.2 |
| GLOBAL STABILITY (CDR _{req} > 1.0) | N.A. | N.A. |
| BEARING RESISTANCE (CDR _{req} > 1.0) | 2.4 | 1.8 |
| REQUIRED BEARING RESISTANCE (PSF) | 6,000 | 7,000 |

- THE WALL HEIGHT INCLUDES AN EMBEDMENT OF 1.5 FEET.
- THE WALL STABILITY EVALUATION INCLUDED A SURCHARGE LOAD THAT WAS EQUAL TO THE WEIGHT OF THE SOIL BEHIND THE ABUTMENT.
- THE LENGTH OF REINFORCEMENT IS THE MINIMUM REQUIRED LENGTH AT THAT LOCATION.
- CRS REQUIREMENTS AND LOAD AND RESISTANCE FACTORS ARE PRESENTED IN CH. 14 OF THE BRIDGE MANUAL.
- NA NOT APPLICABLE. GLOBAL SLOPE STABILITY WAS EVALUATED AT THE CRITICAL WALL LOCATION.

PROFILE GRADE LINE FOR CENTER STREET



PROFILE GRADE LINE IH 41 SB

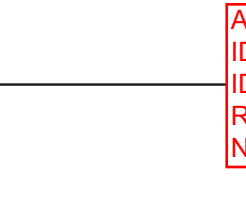

QUANTITIES & SOIL INFORMATION

| | | |
|-------------------------------|----------|----------|
| STRUCTURES DESIGN SECTION | DATE | REVISION |
| STRUCTURE R-40-577 | 11/30/15 | BY: MJC |
| QUANTITIES & SOIL INFORMATION | | BY: MJC |

STATE OF WISCONSIN
DEPARTMENT OF TRANSPORTATION
STRUCTURES DESIGN SECTION

11/30/15

William C. Decker

SHEET 2

399

SOIL PARAMETERS

| SOIL DESCRIPTION | FRICION ANGLE (DEGREES) | COHESION (PSF) | UNIT WEIGHT (PCF) |
|---|-------------------------|----------------|-------------------|
| CANULAR BACKFILL WITHIN THE WALL IN THE REINFORCING ZONE | 30 | 0 | 120 |
| EARTH BEHIND AND BELOW THE REINFORCING ZONE | 31 | 0 | 120 |
| B-2, II=00 | | | |
| CLAY, GRAY, TRACE GRAVEL (ELEVATION 740.8FT - 732.5FT) | 0 | 2,500 | 125 |
| SAND, GRAY, SOME SILT (ELEVATION 730.5FT - 720.8FT) | 36 | 0 | 130 |
| SAND, GRAY, SOME SILT (ELEVATION 728.5FT - 715.5FT) | 30 | 0 | 115 |
| SAND, GRAY, SOME SILT (ELEVATION 708.5FT - 715.5FT) | 0 | 2,500 | 125 |
| CLAY, GRAY, TRACE SAND, TRACE GRAVEL (ELEVATION 711.5FT - 710.0FT) | 0 | 2,000 | 120 |
| SILT, GRAY, TRACE SAND (ELEVATION 710.0FT - 702.5FT) | 33 | 0 | 125 |
| CLAY, GRAY (ELEVATION 702.5FT - 692.5FT) | 0 | 3,000 | 125 |
| CLAY AND GRAVEL, GRAY, SOME SILT (ELEVATION 692.5FT AND BELOW) | 0 | 25,000 | 135 |
| B-3, II=00 | | | |
| CLAY, GRAY, TRACE GRAVEL (ELEVATION 740.7FT - 730.4FT) | 0 | 2,500 | 125 |
| SAND, GRAY FINE, LITTLE SILT (ELEVATION 730.4FT - 726.4FT) | 36 | 0 | 130 |
| SAND, GRAY FINE, LITTLE SILT (ELEVATION 726.4FT - 722.4FT) | 30 | 0 | 115 |
| SILT, GRAY, LITTLE SAND, TRACE CLAY (ELEVATION 722.4FT - 719.4FT) | 0 | 2,500 | 125 |
| B-4, II=00 | | | |
| SAND, BROWN FINE TO MEDIUM (ELEVATION 745.0FT - 730.4FT) | 32 | 0 | 120 |
| CLAY, GRAY, LITTLE SILT, TRACE SAND (ELEVATION 736.4FT - 730.4FT) | 0 | 3,500 | 130 |
| SILT, GRAY, SOME SAND (ELEVATION 730.4FT - 724.4FT) | 33 | 0 | 125 |
| SAND, GRAY, SOME SILT (ELEVATION 724.4FT - 717.4FT) | 36 | 0 | 135 |
| B-5, II=00 | | | |
| CLAY, BROWN, LITTLE SILT, TRACE SAND AND GRAVEL (ELEVATION 742.5FT - 742.2FT) | 0 | 3,000 | 130 |
| SAND, GRAY, SOME SAND (ELEVATION 742.2FT - 740.7FT) | 34 | 0 | 130 |
| SILT, GRAY, SOME SAND (ELEVATION 740.7FT - 735.7FT) | 36 | 0 | 135 |

WALL EXTERNAL STABILITY EVALUATION

| DIMENSIONS | | | | | | | | | | |
|---|---------|---------|---------|---------|---------|---------|--|--|--|--|
| WALL HEIGHT (FEET) ¹ | 23.5 | 15.2 | 23.4 | 18.8 | 11.5 | 5.8 | | | | |
| EXPOSED WALL HEIGHT (FEET) | 22.0 | 13.7 | 21.9 | 17.3 | 10.0 | 4.3 | | | | |
| LENGTH OF REINFORCEMENT (FEET) ³ | 16.4 | 16.0 | 16.4 | 13.2 | 8.0 | 8.0 | | | | |
| LENGTH OF REINFORCING WALL HEIGHT | 0.70 | 1.05 | 0.70 | 0.70 | 0.70 | NA | | | | |
| WALL STATION (WS) | 10+62.8 | 11+00.0 | 11+38.2 | 12+31.6 | 14+00.0 | 16+00.0 | | | | |
| BORING USED | B-2 | B-2 | B-3 | B-3 | B-4 | B-5 | | | | |
| CAPACITY TO DEMAND RATIO (CDR) ⁴ | | | | | | | | | | |
| SLIDING (CDR _{sliding} > 1.0) | 1.4 | 1.0 | 1.4 | 1.4 | 1.3 | 1.9 | | | | |
| ECCENTRICITY (CDR _{eccentricity} > 1.0) | 1.3 | 1.2 | 1.3 | 1.3 | 1.2 | 4.5 | | | | |
| GLOBAL STABILITY (CDR _{global} > 1.0) | NA | 2.1 | NA | NA | NA | NA | | | | |
| BEARING RESISTANCE (CDR _{bearing} > 1.0) | 1.1 | 1.1 | 1.1 | 1.1 | 2.0 | 4.3 | | | | |
| REQUIRED BEARING RESISTANCE (PSF) | 6,000 | 6,000 | 6,000 | 6,000 | 6,000 | 6,000 | | | | |

1. THE WALL HEIGHT INCLUDES AN EMBEDMENT OF 1.5 FEET.
2. THE WALL STABILITY EVALUATION INCLUDED A SURCHARGE LOAD THAT WAS EQUAL TO THE WEIGHT OF THE SOIL BEHIND THE ABUTMENT.
3. THE LENGTH OF REINFORCEMENT IS THE MINIMUM REQUIRED LENGTH AT THAT LOCATION.
4. CDR REQUIREMENTS AND LOAD AND RESISTANCE FACTORS ARE PRESENTED IN CH. 14 OF THE BRIDGE MANUAL.
5. NA NOT APPLICABLE. GLOBAL SLOPE STABILITY WAS EVALUATED AT THE CRITICAL WALL LOCATION.


TOTAL ESTIMATED QUANTITIES

| BID ITEM NUMBER | BID ITEMS | QUANTITY | UNIT |
|-----------------|--|----------|------|
| 206.3000 | EXCAVATION FOR STRUCTURES RETAINING WALL R-40-578 | 1 | LS |
| 513.2001 | RAILING PIPE R-40-578 | 634 | LF |
| 516.0500 | RUBBERIZED MEMBRANE WATERPROOFING | 12 | SY |
| 612.0406 | PIPE UNDERDRAIN WRAPPED 6-INCH | 735 | LF |
| SPV.065-4005 | WALL CONCRETE PANEL MECHANICALLY STABILIZED EARTH LRFD/OMP | 8,090 | SF |
| NON-BID ITEMS | | | |
| | EXPANDED POLYSTYRENE | 1" | SIZE |
| | PREFORMED JOINT FILLER | 3/4" | SIZE |
| | NON-BLINDING JOINT SEALER | | |
| | NAME PLATE | | |

ALL ITEMS ARE CATEGORY 3100

GENERAL NOTES

- DRAWINGS SHALL NOT BE SCALED.
- BEVEL ALL EXPOSED EDGES OF CONCRETE 3/4" UNLESS NOTED OTHERWISE.
- BAR STEEL REINFORCEMENT SHALL HAVE 2" CLEAR COVER UNLESS OTHERWISE SHOWN OR NOTED.
- ALL BAR STEEL REINFORCEMENT IN CONCRETE COPING IS TO BE EPOXY COATED.
- THE PLAN QUANTITY FOR THE ITEM WALL CONCRETE PANEL MECHANICALLY STABILIZED EARTH LRFD/OMP IS TO BE MEASURED ALONG THE TOP OF THE WALL TO THE TOP OF THE LEVELING PAD. THE TOP OF LEVELING PAD IS ASSUMED TO BE 1'-6" BELOW FINISHED GRADE. ALL AREAS CONSTRUCTED OUTSIDE THESE LIMITS WILL NOT BE MEASURED FOR PAYMENT.
- THE QUANTITY OF CONCRETE MASONRY & REINFORCING STEEL FOR THE CAST-IN-PLACE COPING IS PAID FOR UNDER THE ITEM "WALL CONCRETE PANEL MECHANICALLY STABILIZED EARTH LRFD/OMP".
- THE UPPER LIMITS OF EXCAVATION FOR EXCAVATION FOR STRUCTURES RETAINING WALL R-40-578 SHALL BE THE EXISTING GROUND LINE.
- THE CONTRACTOR MUST COORDINATE THE CONSTRUCTION OF WALL R-40-578 WITH THE CONSTRUCTION OF THE WEST ABUTMENT OF BRIDGE B-40-580.
- OVER EXCAVATE 6" BELOW THE LEVELING PAD AND REINFORCEMENT ZONE ALONG THE LENGTH OF WALL TO REMOVE ANY UNSUITABLE MATERIAL, BOCHFILL, REMOVAL OF EXISTING CONCRETE PANEL MECHANICALLY STABILIZED EARTH LRFD/OMP. BID ITEM WALL CONCRETE PANEL MECHANICALLY STABILIZED EARTH LRFD/OMP. THE COST OF REMOVING AND DISPOSING OF EXISTING WALL CONCRETE PANEL MECHANICALLY STABILIZED EARTH LRFD/OMP SHALL BE THE RESPONSIBILITY OF THE CONTRACTOR. THE LOCATION OF EXPANSION/CONTRACT JOINTS, SEE "COPING DETAILS" SHEET FOR DETAILS. THE QUANTITIES AND REINFORCEMENT DETAILS ARE BASED ON ASSUMED CONCRETE WALL PANEL THICKNESS OF 7 1/2". FOR PANEL THICKNESSES DIFFERENT FROM 7 1/2", THE CONTRACTOR SHALL VERIFY THAT THE WALL SYSTEM AND QUANTITIES AND WILL BE RESPONSIBLE FOR ANY QUANTITY VARIATIONS.
- THE COST OF TURNING AND PLACING THE UNREINFORCED CONCRETE LEVELING PAD SHALL BE THE RESPONSIBILITY OF THE CONTRACTOR.
- ALL OF THE RETAINING WALL'S STATIONING AND OFFSETS ARE GIVEN AT THE FRONT FACE OF WALL PANELS.
- THE CONTRACTOR SHALL PROVIDE COMPLETE DESIGN DETAILS IN ACCORDANCE WITH THE SPECIAL PROVISIONS. THE RETAINING WALL MANUFACTURER SHALL PROVIDE TECHNICAL ASSISTANCE TO THE CONTRACTOR DURING CONSTRUCTION. THE COST OF MECHANICALLY STABILIZED EARTH LRFD/OMP IN THE BID ITEM WALL CONCRETE PANEL MECHANICALLY STABILIZED EARTH LRFD/OMP.
- PLANS, ELEVATIONS, AND DETAILS SHOWN ON THESE DRAWINGS ARE INTENDED TO INDICATE WALL LOCATIONS, LENGTHS, HEIGHTS, AND DETAILS COMMON TO THE WALL SYSTEM SELECTED. THE CONTRACTOR SHALL VERIFY THAT THE WALL SYSTEM SELECTED WILL CONFORM TO THE REQUIRED ALIGNMENTS AND DETAILS.
- THE MAXIMUM VALUE OF THE ANGLE OF INTERNAL FRICTION OF THE WALL BACKFILL MATERIAL IN THE REINFORCED ZONE SHALL BE ASSUMED TO BE 30 DEGREES WITHOUT CERTIFIED TEST VALUES.
- ALL STATIONS AND ELEVATIONS ARE IN FEET. ELEVATIONS ARE REFERENCED TO THE NAVD 88 DATUM.
- EXISTING STRUCTURE B-40-284 IS NOT SHOWN IN THESE PLANS. THE REMOVAL OF THIS STRUCTURE IS INCLUDED IN A LUMP SUM PAY ITEM AS PART OF THE B-40-880 BRIDGE QUANTITIES.
- THESE PLANS ARE FOR A PRECAST CONCRETE PANEL MECHANICALLY STABILIZED EARTH (MSE) RETAINING WALL.
- THE VOLUME OF EARTHWORK REQUIRED TO INSTALL THE UNREINFORCED CONCRETE LEVELING PAD SHALL BE MEASURED AS THE VOLUME OF THE UNREINFORCED CONCRETE LEVELING PAD. THE VOLUME OF EARTHWORK REQUIRED TO INSTALL THE PRECAST CONCRETE PANEL MECHANICALLY STABILIZED EARTH LRFD/OMP.
- PROVIDE A SACK RUBBED FINISH IN ACCORDANCE TO STANDARD SPECIFICATION 602.3.7.5 AND AS MODIFIED HERE ON ALL EXPOSED CONCRETE SURFACES WHERE CONCRETE STAINING WILL BE APPLIED IN A FUTURE CONTRACT. THE MORTAR SHALL CONTAIN ONE PART PORTLAND CEMENT TO THREE PARTS SAND. THE FINISH SHALL BE IN ACCORDANCE TO MANUFACTURERS' RECOMMENDATIONS: TK-225 BY TK PRODUCTS, ACHRO 60 BY THORO PRODUCTS, OR ACHRO SET BY MASTER BUILDERS. THIS WORK IS INCIDENTAL TO THE BID ITEM WALL CONCRETE PANEL MECHANICALLY STABILIZED EARTH LRFD/OMP.
- THE UTILITY INFORMATION SHOWN ON THESE DRAWINGS CONCERNING TYPE AND LOCATION OF UNDERGROUND UTILITIES IS NOT GUARANTEED TO BE ACCURATE OR COMPLETE. THE CONTRACTOR SHALL VERIFY THE TYPE AND LOCATION OF UNDERGROUND UTILITIES AS NECESSARY TO AVOID DAMAGE.
- UTILITIES LABELED PROPOSED MAY BE INSTALLED PRIOR TO CONSTRUCTION.
- ONLY WALL CONCRETE PANEL MSE WALL SYSTEMS THAT USE STRIP TYPE SOIL NAIL REINFORCEMENT THAT ARE LISTED AT THE PANEL CONNECTION CAN BE USED FOR THE PROJECT.

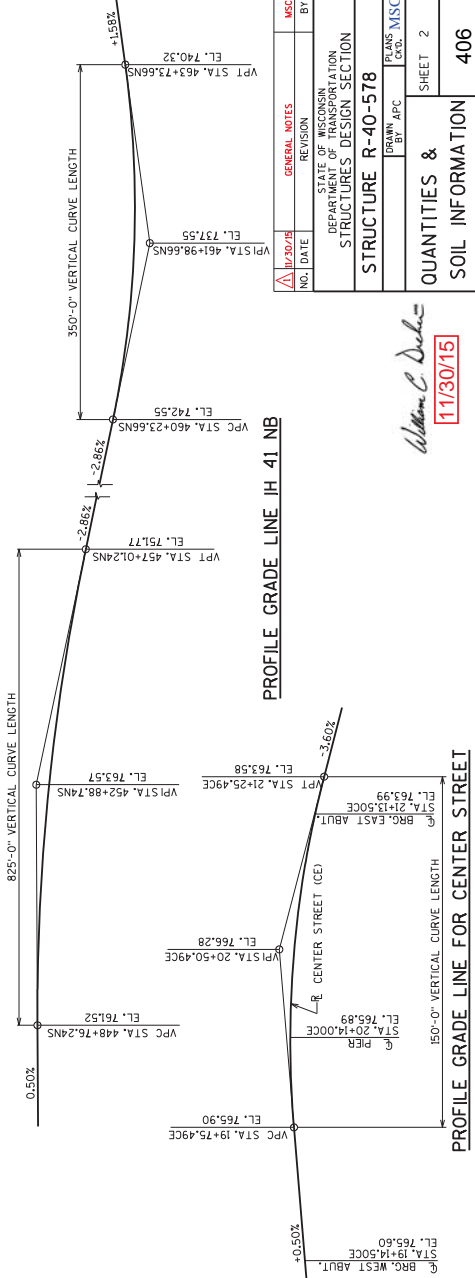

11/30/15
William C. Decker

QUANTITIES & SOIL INFORMATION

STRUCTURE R-40-578

STATE OF WISCONSIN
DEPARTMENT OF TRANSPORTATION
STRUCTURES DESIGN SECTION

NO. DATE REVISION BY
11/30/15 GENERAL NOTES MSC

BY

DESIGNED BY
DRAWN BY
CHECKED BY
PERMITS BY

PERMITS BY
DATE

SHEET 2

406

Addendum No. 01
ID 1060-34-84 &
ID 1060-35-85
Revised Sheet 406
November 30, 2015

SCHEDULE OF ITEMS

REVISED:

CONTRACT:
20151208010

PROJECT(S):
1060-34-84
1060-35-85

FEDERAL ID(S):
N/A
N/A

CONTRACTOR : _____

| LINE NO | ITEM DESCRIPTION | APPROX. QUANTITY AND UNITS | UNIT PRICE | | BID AMOUNT | |
|---------|------------------|----------------------------|------------|-----|------------|-----|
| | | | DOLLARS | CTS | DOLLARS | CTS |

SECTION 0001 ROADWAY ITEMS

| | | | | | | |
|------|--|------|-----------|------|---|---|
| 0010 | 108.4400 CPM Progress Schedule 0001. 1060-34-84 | EACH | 1.000 | . | . | . |
| 0020 | 201.0105 Clearing | STA | 27.000 | . | . | . |
| 0030 | 201.0120 Clearing | ID | 681.000 | . | . | . |
| 0040 | 201.0205 Grubbing | STA | 26.000 | . | . | . |
| 0050 | 201.0220 Grubbing | ID | 681.000 | . | . | . |
| 0060 | 203.0200 Removing Old Structure (station) 0001. 20+14 | LUMP | | LUMP | | . |
| 0070 | 203.0210.S Abatement of Asbestos Containing Material (structure) 0001. B-40-284 | LUMP | | LUMP | | . |
| 0080 | 204.0100 Removing Pavement | SY | 8,216.000 | . | . | . |
| 0090 | 204.0120 Removing Asphaltic Surface Milling | SY | 476.000 | . | . | . |

SCHEDULE OF ITEMS

REVISED:

CONTRACT:
20151208010PROJECT(S):
1060-34-84
1060-35-85FEDERAL ID(S):
N/A
N/A

CONTRACTOR : _____

| LINE NO | ITEM DESCRIPTION | APPROX. QUANTITY AND UNITS | UNIT PRICE | | BID AMOUNT | |
|------------|--|----------------------------------|------------|-----|------------|-----|
| | | | DOLLARS | CTS | DOLLARS | CTS |
| 0100 | 204.0130 Removing Curb | 852.000 LF | . | | . | |
| 0110 | 204.0150 Removing Curb & Gutter | 2,025.000 LF | . | | . | |
| 0120 | 204.0155 Removing Concrete Sidewalk | 1,347.000 SY | . | | . | |
| 0130 | 204.0157 Removing Concrete Barrier | 400.000 LF | . | | . | |
| 0140 | 204.0165 Removing Guardrail | 170.000 LF | . | | . | |
| 0150 | 204.0170 Removing Fence | 1,767.000 LF | . | | . | |
| 0160 | 204.0195 Removing Concrete Bases | 3.000 EACH | . | | . | |
| 0170 | 204.0210 Removing Manholes | 2.000 EACH | . | | . | |
| 0180 | 204.0220 Removing Inlets | 8.000 EACH | . | | . | |
| 0190 | 204.0245 Removing Storm Sewer (size) 0001. (12-INCH) | 51.000 LF | . | | . | |

SCHEDULE OF ITEMS

REVISED:

CONTRACT:
20151208010PROJECT(S):
1060-34-84
1060-35-85FEDERAL ID(S):
N/A
N/A

CONTRACTOR : _____

| LINE NO | ITEM DESCRIPTION | APPROX. QUANTITY AND UNITS | UNIT PRICE | | BID AMOUNT | |
|------------|--|----------------------------------|------------|-----|------------|-----|
| | | | DOLLARS | CTS | DOLLARS | CTS |
| 0200 | 204.0245 Removing Storm Sewer (size) 0002. (15-INCH) | 93.000 LF | . | | . | |
| 0210 | 204.0245 Removing Storm Sewer (size) 0003. (18-INCH) | 108.000 LF | . | | . | |
| 0220 | 204.0280 Sealing Pipes | 9.000 EACH | . | | . | |
| 0230 | 204.9105.S Removing (item description) 0001. CRASH CUSHION | LUMP | LUMP | | . | |
| 0240 | 205.0100 Excavation Common **p** | 20,425.000 CY | . | | . | |
| 0250 | 206.1000 Excavation for Structures Bridges (structure) 0001. B-40-880 | LUMP | LUMP | | . | |
| 0260 | 206.3000 Excavation for Structures Retaining Walls (structure) 0001. R-40-577 | LUMP | LUMP | | . | |
| 0270 | 206.3000 Excavation for Structures Retaining Walls (structure) 0002. R-40-578 | LUMP | LUMP | | . | |
| 0280 | 210.0100 Backfill Structure | 533.000 CY | . | | . | |
| 0290 | 213.0100 Finishing Roadway (project) 0001. 1060-34-84 | 1.000 EACH | . | | . | |

SCHEDULE OF ITEMS

REVISED:

CONTRACT:
20151208010PROJECT(S):
1060-34-84
1060-35-85FEDERAL ID(S):
N/A
N/A

CONTRACTOR : _____

| LINE NO | ITEM DESCRIPTION | APPROX. QUANTITY AND UNITS | UNIT PRICE | | BID AMOUNT | |
|------------|---|----------------------------------|------------|-----|------------|-----|
| | | | DOLLARS | CTS | DOLLARS | CTS |
| 0300 | 213.0100 Finishing Roadway (project) 0002. 1060-35-85 | 1.000 EACH | . | | . | |
| 0310 | 305.0120 Base Aggregate Dense 1 1/4-Inch | 9,036.000 TON | . | | . | |
| 0320 | 312.0110 Select Crushed Material | 4,621.000 TON | . | | . | |
| 0330 | 415.0070 Concrete Pavement 7-Inch | 363.000 SY | . | | . | |
| 0340 | 415.0090 Concrete Pavement 9-Inch | 141.000 SY | . | | . | |
| 0350 | 416.0270 Concrete Driveway HES 7-Inch | 1,742.000 SY | . | | . | |
| 0360 | 416.0610 Drilled Tie Bars | 276.000 EACH | . | | . | |
| 0370 | 455.0105 Asphaltic Material PG58-28 | 134.000 TON | . | | . | |
| 0380 | 455.0120 Asphaltic Material PG64-28 | 10.000 TON | . | | . | |
| 0390 | 455.0140 Asphaltic Material PG64-28P | 3.000 TON | . | | . | |
| 0400 | 455.0605 Tack Coat | 500.000 GAL | . | | . | |

SCHEDULE OF ITEMS

REVISED:

CONTRACT:
20151208010PROJECT(S):
1060-34-84
1060-35-85FEDERAL ID(S):
N/A
N/A

CONTRACTOR : _____

| LINE NO | ITEM DESCRIPTION | APPROX. QUANTITY AND UNITS | UNIT PRICE | | BID AMOUNT | |
|------------|--|----------------------------------|------------|-----|------------|-----|
| | | | DOLLARS | CTS | DOLLARS | CTS |
| 0410 | 460.1101 HMA Pavement Type E-1 | 2,431.000 TON | . | | . | |
| 0420 | 460.1110 HMA Pavement Type E-10 | 211.000 TON | . | | . | |
| 0430 | 460.2000 Incentive Density HMA Pavement | 1,700.000 DOL | 1.00000 | | 1700.00 | |
| 0440 | 465.0105 Asphaltic Surface | 207.000 TON | . | | . | |
| 0450 | 465.0120 Asphaltic Surface Driveways and Field Entrances | 10.000 TON | . | | . | |
| 0460 | 502.0100 Concrete Masonry Bridges **p** | 236.000 CY | . | | . | |
| 0470 | 502.3200 Protective Surface Treatment **p** | 1,657.000 SY | . | | . | |
| 0480 | 502.3210 Pigmented Surface Sealer **p** | 43.000 SY | . | | . | |
| 0490 | 503.0137 Prestressed Girder Type I 36W-Inch **p** | 2,397.000 LF | . | | . | |
| 0500 | 505.0400 Bar Steel Reinforcement HS Structures | 11,320.000 LB | . | | . | |

SCHEDULE OF ITEMS

REVISED:

CONTRACT:
20151208010PROJECT(S):
1060-34-84
1060-35-85FEDERAL ID(S):
N/A
N/A

CONTRACTOR : _____

| LINE NO | ITEM DESCRIPTION | APPROX. QUANTITY AND UNITS | UNIT PRICE | | BID AMOUNT | |
|------------|--|----------------------------------|------------|-----|------------|-----|
| | | | DOLLARS | CTS | DOLLARS | CTS |
| 0510 | 505.0600 Bar Steel Reinforcement HS Coated Structures | 157,360.000 LB | . | | . | |
| 0520 | 506.2605 Bearing Pads Elastomeric Non-Laminated | 48.000 EACH | . | | . | |
| 0530 | 506.4000 Steel Diaphragms (structure) 0001. B-40-880 | 44.000 EACH | . | | . | |
| 0540 | 511.1200 Temporary Shoring (structure) 0001. B-40-880 | 1,665.000 SF | . | | . | |
| 0550 | 511.1300 Temporary Shoring (location) 8001. 455NS+12 TO 463NS+36 | 23,311.000 SF | . | | . | |
| 0560 | 511.1300 Temporary Shoring (location) 8002. 461NS+45 TO 461NS+76 | 272.000 SF | . | | . | |
| 0570 | 513.2001 Railing Pipe (structure) 0001. R-40-577 | 465.000 LF | . | | . | |
| 0580 | 513.2001 Railing Pipe (structure) 0002. R-40-578 | 634.000 LF | . | | . | |
| 0590 | 516.0500 Rubberized Membrane Waterproofing | 53.000 SY | . | | . | |
| 0600 | 520.8000 Concrete Collars for Pipe | 6.000 EACH | . | | . | |
| 0610 | 550.0500 Pile Points | 44.000 EACH | . | | . | |

SCHEDULE OF ITEMS

REVISED:

CONTRACT:
20151208010PROJECT(S):
1060-34-84
1060-35-85FEDERAL ID(S):
N/A
N/A

CONTRACTOR : _____

| LINE NO | ITEM DESCRIPTION | APPROX. QUANTITY AND UNITS | UNIT PRICE | | BID AMOUNT | |
|------------|--|----------------------------------|------------|-----|------------|-----|
| | | | DOLLARS | CTS | DOLLARS | CTS |
| 0620 | 550.1100 Piling Steel HP 10-Inch X 42 Lb | 1,250.000 LF | . | | . | |
| 0630 | 550.1120 Piling Steel HP 12-Inch X 53 Lb | 960.000 LF | . | | . | |
| 0640 | 601.0205 Concrete Gutter 24-Inch | 208.000 LF | . | | . | |
| 0650 | 601.0319 Concrete Curb & Gutter 19-Inch | 1,533.000 LF | . | | . | |
| 0660 | 601.0331 Concrete Curb & Gutter 31-Inch | 3,487.000 LF | . | | . | |
| 0670 | 601.0407 Concrete Curb & Gutter 18-Inch Type D | 133.000 LF | . | | . | |
| 0680 | 601.0409 Concrete Curb & Gutter 30-Inch Type A | 16.000 LF | . | | . | |
| 0690 | 601.0411 Concrete Curb & Gutter 30-Inch Type D | 131.000 LF | . | | . | |
| 0700 | 602.0410 Concrete Sidewalk 5-Inch | 29,363.000 SF | . | | . | |
| 0710 | 602.0505 Curb Ramp Detectable Warning Field Yellow | 539.000 SF | . | | . | |
| 0720 | 602.1500 Concrete Steps | 52.000 SF | . | | . | |

SCHEDULE OF ITEMS

REVISED:

CONTRACT:
20151208010PROJECT(S):
1060-34-84
1060-35-85FEDERAL ID(S):
N/A
N/A

CONTRACTOR : _____

| LINE NO | ITEM DESCRIPTION | APPROX. QUANTITY AND UNITS | UNIT PRICE | | BID AMOUNT | |
|------------|---|----------------------------------|------------|-----|------------|-----|
| | | | DOLLARS | CTS | DOLLARS | CTS |
| 0730 | 602.2400 Concrete Safety Islands | 346.000 SF | . | | . | |
| 0740 | 603.8000 Concrete Barrier Temporary Precast Delivered | 6,666.000 LF | . | | . | |
| 0750 | 603.8125 Concrete Barrier Temporary Precast Installed | 9,167.000 LF | . | | . | |
| 0760 | 604.0400 Slope Paving Concrete | 57.000 SY | . | | . | |
| 0770 | 608.0312 Storm Sewer Pipe Reinforced Concrete Class III 12-Inch | 197.000 LF | . | | . | |
| 0780 | 608.0315 Storm Sewer Pipe Reinforced Concrete Class III 15-Inch | 136.000 LF | . | | . | |
| 0790 | 608.0318 Storm Sewer Pipe Reinforced Concrete Class III 18-Inch | 184.000 LF | . | | . | |
| 0800 | 608.0324 Storm Sewer Pipe Reinforced Concrete Class III 24-Inch | 769.000 LF | . | | . | |
| 0810 | 608.0330 Storm Sewer Pipe Reinforced Concrete Class III 30-Inch | 30.000 LF | . | | . | |
| 0820 | 608.0424 Storm Sewer Pipe Reinforced Concrete Class IV 24-Inch | 193.000 LF | . | | . | |

SCHEDULE OF ITEMS

REVISED:

CONTRACT:
20151208010PROJECT(S):
1060-34-84
1060-35-85FEDERAL ID(S):
N/A
N/A

CONTRACTOR : _____

| LINE NO | ITEM DESCRIPTION | APPROX. QUANTITY AND UNITS | UNIT PRICE | | BID AMOUNT | |
|------------|--|----------------------------------|------------|-----|------------|-----|
| | | | DOLLARS | CTS | DOLLARS | CTS |
| 0830 | 610.0148 Storm Sewer Pipe Reinforced Concrete Horizontal Elliptical Class HE-III 48x76-Inch | 406.000 LF | . | | . | |
| 0850 | 611.0535 Manhole Covers Type J-Special | 2.000 EACH | . | | . | |
| 0860 | 611.0624 Inlet Covers Type H | 8.000 EACH | . | | . | |
| 0870 | 611.0642 Inlet Covers Type MS | 3.000 EACH | . | | . | |
| 0880 | 611.0654 Inlet Covers Type V | 2.000 EACH | . | | . | |
| 0890 | 611.0663 Inlet Covers Type X | 2.000 EACH | . | | . | |
| 0900 | 611.2004 Manholes 4-FT Diameter | 1.000 EACH | . | | . | |
| 0910 | 611.2005 Manholes 5-FT Diameter | 4.000 EACH | . | | . | |
| 0920 | 611.2006 Manholes 6-FT Diameter | 2.000 EACH | . | | . | |
| 0930 | 611.2008 Manholes 8-FT Diameter | 1.000 EACH | . | | . | |

SCHEDULE OF ITEMS

REVISED:

CONTRACT:
20151208010PROJECT(S):
1060-34-84
1060-35-85FEDERAL ID(S):
N/A
N/A

CONTRACTOR : _____

| LINE NO | ITEM DESCRIPTION | APPROX. QUANTITY AND UNITS | UNIT PRICE | | BID AMOUNT | |
|------------|---|----------------------------------|------------|-----|------------|-----|
| | | | DOLLARS | CTS | DOLLARS | CTS |
| 0940 | 611.3003 Inlets 3-FT Diameter | 2.000 EACH | . | | . | |
| 0950 | 611.3004 Inlets 4-FT Diameter | 19.000 EACH | . | | . | |
| 0960 | 611.3230 Inlets 2x3-FT | 1.000 EACH | . | | . | |
| 0970 | 611.3901 Inlets Median 1 Grate | 3.000 EACH | . | | . | |
| 0980 | 611.3902 Inlets Median 2 Grate | 3.000 EACH | . | | . | |
| 0990 | 611.8110 Adjusting Manhole Covers | 3.000 EACH | . | | . | |
| 1000 | 611.8115 Adjusting Inlet Covers | 7.000 EACH | . | | . | |
| 1010 | 612.0406 Pipe Underdrain Wrapped 6-Inch | 1,310.000 LF | . | | . | |
| 1020 | 614.0805 Crash Cushions Permanent Low Maintenance | 1.000 EACH | . | | . | |
| 1030 | 614.0905 Crash Cushions Temporary | 5.000 EACH | . | | . | |
| 1040 | 616.0206 Fence Chain Link 6-FT | 1,641.000 LF | . | | . | |

SCHEDULE OF ITEMS

REVISED:

CONTRACT:
20151208010PROJECT(S):
1060-34-84
1060-35-85FEDERAL ID(S):
N/A
N/A

CONTRACTOR : _____

| LINE NO | ITEM DESCRIPTION | APPROX. QUANTITY AND UNITS | UNIT PRICE | | BID AMOUNT | |
|------------|--|----------------------------------|------------|-----|------------|-----|
| | | | DOLLARS | CTS | DOLLARS | CTS |
| 1060 | 616.0406 Fence Chain Link Salvaged 6-FT | 400.000 LF | . | | . | |
| 1070 | 616.0700.S Fence Safety | 300.000 LF | . | | . | |
| 1080 | 619.1000 Mobilization | 1.000 EACH | . | | . | |
| 1090 | 620.0300 Concrete Median Sloped Nose | 25.000 SF | . | | . | |
| 1100 | 623.0200 Dust Control Surface Treatment | 12,840.000 SY | . | | . | |
| 1110 | 624.0100 Water | 192.000 MGAL | . | | . | |
| 1120 | 628.1504 Silt Fence | 361.000 LF | . | | . | |
| 1130 | 628.1520 Silt Fence Maintenance | 361.000 LF | . | | . | |
| 1140 | 628.1905 Mobilizations Erosion Control | 7.000 EACH | . | | . | |
| 1150 | 628.1910 Mobilizations Emergency Erosion Control | 4.000 EACH | . | | . | |
| 1160 | 628.2004 Erosion Mat Class I Type B | 17,111.000 SY | . | | . | |

SCHEDULE OF ITEMS

REVISED:

CONTRACT:
20151208010PROJECT(S):
1060-34-84
1060-35-85FEDERAL ID(S):
N/A
N/A

CONTRACTOR : _____

| LINE NO | ITEM DESCRIPTION | APPROX. QUANTITY AND UNITS | UNIT PRICE | | BID AMOUNT | |
|------------|--|----------------------------------|------------|-----|------------|-----|
| | | | DOLLARS | CTS | DOLLARS | CTS |
| 1170 | 628.2008 Erosion Mat Urban Class I Type B | 1,389.000 SY | . | | . | |
| 1180 | 628.6505 Soil Stabilizer Type A | 1.000 ACRE | . | | . | |
| 1190 | 628.7005 Inlet Protection Type A | 20.000 EACH | . | | . | |
| 1200 | 628.7015 Inlet Protection Type C | 21.000 EACH | . | | . | |
| 1210 | 628.7020 Inlet Protection Type D | 89.000 EACH | . | | . | |
| 1220 | 628.7560 Tracking Pads | 7.000 EACH | . | | . | |
| 1230 | 629.0205 Fertilizer Type A | 3.700 CWT | . | | . | |
| 1240 | 629.0210 Fertilizer Type B | 3.300 CWT | . | | . | |
| 1250 | 630.0130 Seeding Mixture No. 30 | 333.000 LB | . | | . | |
| 1260 | 630.0140 Seeding Mixture No. 40 | 186.000 LB | . | | . | |
| 1270 | 630.0200 Seeding Temporary | 777.000 LB | . | | . | |

SCHEDULE OF ITEMS

REVISED:

CONTRACT:
20151208010PROJECT(S):
1060-34-84
1060-35-85FEDERAL ID(S):
N/A
N/A

CONTRACTOR : _____

| LINE NO | ITEM DESCRIPTION | APPROX. QUANTITY AND UNITS | UNIT PRICE | | BID AMOUNT | |
|------------|---|----------------------------------|------------|-----|------------|-----|
| | | | DOLLARS | CTS | DOLLARS | CTS |
| 1280 | 631.0300 Sod Water | 187.000 MGAL | . | | . | |
| 1290 | 631.1000 Sod Lawn | 10,430.000 SY | . | | . | |
| 1300 | 632.0101 Trees (species) (size) (root) 0001. GINKGO - MALE ONLY 2 1/2 INCH CAL B&B | 5.000 EACH | . | | . | |
| 1310 | 632.0101 Trees (species) (size) (root) 0002. LONDON PLANE 2 1/2 INCH CAL B&B | 5.000 EACH | . | | . | |
| 1320 | 632.0101 Trees (species) (size) (root) 0003. TURKISH FILBERT 2 1/2 INCH CAL B&B | 5.000 EACH | . | | . | |
| 1330 | 632.9101 Landscape Planting Surveillance and Care Cycles | 20.000 EACH | . | | . | |
| 1340 | 634.0618 Posts Wood 4x6-Inch X 18-FT | 6.000 EACH | . | | . | |
| 1350 | 634.0622 Posts Wood 4x6-Inch X 22-FT | 12.000 EACH | . | | . | |
| 1360 | 634.0816 Posts Tubular Steel 2x2-Inch X 16-FT | 59.000 EACH | . | | . | |
| 1370 | 635.0200 Sign Supports Structural Steel HS | 2,600.000 LB | . | | . | |

SCHEDULE OF ITEMS

REVISED:

CONTRACT:
20151208010PROJECT(S):
1060-34-84
1060-35-85FEDERAL ID(S):
N/A
N/A

CONTRACTOR : _____

| LINE NO | ITEM DESCRIPTION | APPROX. QUANTITY AND UNITS | UNIT PRICE | | BID AMOUNT | |
|------------|---|----------------------------------|------------|-----|------------|-----|
| | | | DOLLARS | CTS | DOLLARS | CTS |
| 1380 | 636.0100 Sign Supports Concrete Masonry | 4.400 CY | . | | . | |
| 1390 | 636.0500 Sign Supports Steel Reinforcement | 264.000 LB | . | | . | |
| 1400 | 637.2210 Signs Type II Reflective H | 337.530 SF | . | | . | |
| 1410 | 637.2230 Signs Type II Reflective F | 158.750 SF | . | | . | |
| 1420 | 638.2101 Moving Signs Type I | 6.000 EACH | . | | . | |
| 1430 | 638.2102 Moving Signs Type II | 22.000 EACH | . | | . | |
| 1440 | 638.2602 Removing Signs Type II | 67.000 EACH | . | | . | |
| 1450 | 638.3000 Removing Small Sign Supports | 67.000 EACH | . | | . | |
| 1460 | 643.0100 Traffic Control (project) 0002. 1060-35-85 | 1.000 EACH | . | | . | |
| 1470 | 643.0200 Traffic Control Surveillance and Maintenance (project) 0001. 1060-34-84 | 200.000 DAY | . | | . | |

SCHEDULE OF ITEMS

REVISED:

CONTRACT:
20151208010PROJECT(S):
1060-34-84
1060-35-85FEDERAL ID(S):
N/A
N/A

CONTRACTOR : _____

| LINE NO | ITEM DESCRIPTION | APPROX. QUANTITY AND UNITS | UNIT PRICE | | BID AMOUNT | |
|------------|--|----------------------------------|------------|-----|------------|-----|
| | | | DOLLARS | CTS | DOLLARS | CTS |
| 1480 | 643.0300 Traffic Control Drums | 18,447.000 DAY | . | | . | |
| 1490 | 643.0420 Traffic Control Barricades Type III | 7,354.000 DAY | . | | . | |
| 1500 | 643.0705 Traffic Control Warning Lights Type A | 14,708.000 DAY | . | | . | |
| 1510 | 643.0715 Traffic Control Warning Lights Type C | 5,063.000 DAY | . | | . | |
| 1520 | 643.0800 Traffic Control Arrow Boards | 63.000 DAY | . | | . | |
| 1530 | 643.0900 Traffic Control Signs | 24,256.000 DAY | . | | . | |
| 1540 | 643.0920 Traffic Control Covering Signs Type II | 72.000 EACH | . | | . | |
| 1550 | 643.1050 Traffic Control Signs PCMS | 516.000 DAY | . | | . | |
| 1560 | 643.1055.S Truck or Trailer Mounted Attenuator | 60.000 DAY | . | | . | |
| 1570 | 643.2000 Traffic Control Detour (project) 0001. 1060-34-84 | 1.000 EACH | . | | . | |
| 1580 | 643.3000 Traffic Control Detour Signs | 23,356.000 DAY | . | | . | |

SCHEDULE OF ITEMS

REVISED:

CONTRACT:
20151208010PROJECT(S):
1060-34-84
1060-35-85FEDERAL ID(S):
N/A
N/A

CONTRACTOR : _____

| LINE NO | ITEM DESCRIPTION | APPROX. QUANTITY AND UNITS | UNIT PRICE | | BID AMOUNT | |
|------------|--|----------------------------------|------------|-----|------------|-----|
| | | | DOLLARS | CTS | DOLLARS | CTS |
| 1590 | 644.1410.S Temporary Pedestrian Surface Asphalt | 296.000 SF | . | | . | |
| 1600 | 644.1616.S Temporary Pedestrian Safety Fence | 224.000 LF | . | | . | |
| 1610 | 646.0106 Pavement Marking Epoxy 4-Inch | 30,950.000 LF | . | | . | |
| 1620 | 646.0600 Removing Pavement Markings | 28,025.000 LF | . | | . | |
| 1630 | 646.0881.S Pavement Marking Grooved Wet Reflective Tape 4-Inch | 200.000 LF | . | | . | |
| 1640 | 646.0883.S Pavement Marking Grooved Wet Reflective Tape 8-Inch | 567.000 LF | . | | . | |
| 1650 | 647.0166 Pavement Marking Arrows Epoxy Type 2 | 1.000 EACH | . | | . | |
| 1660 | 647.0196 Pavement Marking Arrows Epoxy Type 5 | 6.000 EACH | . | | . | |
| 1670 | 647.0456 Pavement Marking Curb Epoxy | 30.000 LF | . | | . | |
| 1680 | 647.0566 Pavement Marking Stop Line Epoxy 18-Inch | 110.000 LF | . | | . | |

SCHEDULE OF ITEMS

REVISED:

CONTRACT:
20151208010PROJECT(S):
1060-34-84
1060-35-85FEDERAL ID(S):
N/A
N/A

CONTRACTOR : _____

| LINE NO | ITEM DESCRIPTION | APPROX. QUANTITY AND UNITS | UNIT PRICE | | BID AMOUNT | |
|------------|---|----------------------------------|------------|-----|------------|-----|
| | | | DOLLARS | CTS | DOLLARS | CTS |
| 1690 | 647.0606 Pavement Marking Island Nose Epoxy | 7.000 EACH | . | | . | |
| 1700 | 647.0656 Pavement Marking Parking Stall Epoxy | 2,300.000 LF | . | | . | |
| 1710 | 647.0796 Pavement Marking Crosswalk Epoxy 24-Inch | 512.000 LF | . | | . | |
| 1720 | 649.0400 Temporary Pavement Marking Removable Tape 4-Inch | 2,193.000 LF | . | | . | |
| 1730 | 649.2100 Temporary Raised Pavement Markers | 144.000 EACH | . | | . | |
| 1740 | 652.0125 Conduit Rigid Metallic 2-Inch | 24.000 LF | . | | . | |
| 1750 | 652.0210 Conduit Rigid Nonmetallic Schedule 40 1-Inch | 60.000 LF | . | | . | |
| 1760 | 652.0225 Conduit Rigid Nonmetallic Schedule 40 2-Inch | 936.000 LF | . | | . | |
| 1770 | 652.0235 Conduit Rigid Nonmetallic Schedule 40 3-Inch | 330.000 LF | . | | . | |
| 1780 | 652.0615 Conduit Special 3-Inch | 275.000 LF | . | | . | |
| 1790 | 652.0700.S Install Conduit into Existing Item | 1.000 EACH | . | | . | |

SCHEDULE OF ITEMS

REVISED:

CONTRACT:
20151208010PROJECT(S):
1060-34-84
1060-35-85FEDERAL ID(S):
N/A
N/A

CONTRACTOR : _____

| LINE NO | ITEM DESCRIPTION | APPROX. QUANTITY AND UNITS | UNIT PRICE | | BID AMOUNT | |
|------------|---|----------------------------------|------------|-----|------------|-----|
| | | | DOLLARS | CTS | DOLLARS | CTS |
| 1800 | 653.0140 Pull Boxes Steel 24x42-Inch | 2.000 EACH | . | | . | |
| 1810 | 653.0222 Junction Boxes 18x12x6-Inch | 4.000 EACH | . | | . | |
| 1820 | 653.0905 Removing Pull Boxes | 2.000 EACH | . | | . | |
| 1830 | 654.0105 Concrete Bases Type 5 | 20.000 EACH | . | | . | |
| 1840 | 655.0510 Electrical Wire Traffic Signals 12 AWG | 410.000 LF | . | | . | |
| 1850 | 655.0610 Electrical Wire Lighting 12 AWG | 3,070.000 LF | . | | . | |
| 1860 | 655.0620 Electrical Wire Lighting 8 AWG | 3,906.000 LF | . | | . | |
| 1870 | 655.0625 Electrical Wire Lighting 6 AWG | 210.000 LF | . | | . | |
| 1880 | 655.0630 Electrical Wire Lighting 4 AWG | 7,812.000 LF | . | | . | |
| 1890 | 656.0200 Electrical Service Meter Breaker Pedestal (location) 2001. MB22CE | LUMP | LUMP | | . | |

SCHEDULE OF ITEMS

REVISED:

CONTRACT:
20151208010PROJECT(S):
1060-34-84
1060-35-85FEDERAL ID(S):
N/A
N/A

CONTRACTOR : _____

| LINE NO | ITEM DESCRIPTION | APPROX. QUANTITY AND UNITS | UNIT PRICE | | BID AMOUNT | |
|------------|---|----------------------------------|------------|-----|------------|-----|
| | | | DOLLARS | CTS | DOLLARS | CTS |
| 1900 | 656.0500 Electrical Service Breaker Disconnect Box (location) 2001. CB-CCTV-40-0040 | LUMP | LUMP | | | . |
| 1910 | 657.0322 Poles Type 5-Aluminum | 16.000 EACH | | . | | . |
| 1920 | 657.0610 Luminaire Arms Single Member 4 1/2-Inch Clamp 6-FT | 26.000 EACH | | . | | . |
| 1930 | 657.6005.S Anchor Assemblies Light Poles on Structures | 4.000 EACH | | . | | . |
| 1940 | 659.1115 Luminaires Utility LED A | 7.000 EACH | | . | | . |
| 1950 | 659.1125 Luminaires Utility LED C | 20.000 EACH | | . | | . |
| 1960 | 659.1210 Luminaires Underdeck LED B | 2.000 EACH | | . | | . |
| 1970 | 670.0100 Field System Integrator 2001. FTMS | LUMP | LUMP | | | . |
| 1980 | 670.0200 ITS Documentation 2001. FTMS | LUMP | LUMP | | | . |
| 1990 | 671.0132 Conduit HDPE 3-Duct 2-Inch | 330.000 LF | | . | | . |

SCHEDULE OF ITEMS

REVISED:

CONTRACT:
20151208010PROJECT(S):
1060-34-84
1060-35-85FEDERAL ID(S):
N/A
N/A

CONTRACTOR : _____

| LINE NO | ITEM DESCRIPTION | APPROX. QUANTITY AND UNITS | UNIT PRICE | | BID AMOUNT | |
|------------|---|----------------------------------|------------|-----|------------|-----|
| | | | DOLLARS | CTS | DOLLARS | CTS |
| 2000 | 672.0280 Base Camera Pole 80-FT | 1.000 EACH | . | | . | |
| 2010 | 673.0105 Communication Vault Type 1 | 2.000 EACH | . | | . | |
| 2020 | 673.0225.S Install Pole Mounted Cabinet | 1.000 EACH | . | | . | |
| 2030 | 675.0300 Install Mounted Controller Microwave Detector Assembly | 2.000 EACH | . | | . | |
| 2040 | 675.0400.S Install Ethernet Switch | 1.000 EACH | . | | . | |
| 2050 | 677.0100 Install Camera Pole | 1.000 EACH | . | | . | |
| 2060 | 677.0200 Install Camera Assembly | 1.000 EACH | . | | . | |
| 2070 | 678.0500 Communication System Testing 2001. FTMS | LUMP | LUMP | | . | |
| 2080 | 690.0150 Sawing Asphalt | 1,225.000 LF | . | | . | |
| 2090 | 690.0250 Sawing Concrete | 1,949.000 LF | . | | . | |
| 2100 | 715.0415 Incentive Strength Concrete Pavement | 500.000 DOL | 1.00000 | | 500.00 | |

SCHEDULE OF ITEMS

REVISED:

CONTRACT:
20151208010PROJECT(S):
1060-34-84
1060-35-85FEDERAL ID(S):
N/A
N/A

CONTRACTOR : _____

| LINE NO | ITEM DESCRIPTION | APPROX. QUANTITY AND UNITS | UNIT PRICE | | BID AMOUNT | |
|------------|--|----------------------------------|------------|-----|------------|-----|
| | | | DOLLARS | CTS | DOLLARS | CTS |
| 2110 | 715.0502 Incentive Strength Concrete Structures | 1,416.000 DOL | 1.00000 | | 1416.00 | |
| 2120 | SPV.0035 Special 0001. EBS EXCAVATION | 400.000 CY | . | | . | |
| 2130 | SPV.0035 Special 0002. EBS BACKFILL | 400.000 CY | . | | . | |
| 2140 | SPV.0035 Special 4000. HPC MASONARY STRUCTURES ***p** | 669.000 CY | . | | . | |
| 2150 | SPV.0045 Special 0001. PORTABLE SPEED TRAILER | 400.000 DAY | . | | . | |
| 2160 | SPV.0060 Special 0001. CRASH CUSION TEMPORARY LEFT IN PLACE | 1.000 EACH | . | | . | |
| 2170 | SPV.0060 Special 0002. TRAFFIC CONTROL FULL FREEWAY CLOSURE | 14.000 EACH | . | | . | |
| 2180 | SPV.0060 Special 0003. TRAFFIC CONTROL CLOSE-OPEN FREEWAY ENTRANCE RAMP | 160.000 EACH | . | | . | |
| 2190 | SPV.0060 Special 0004. TRAFFIC CONTROL INTERIM FREEWAY LANE CLOSURE | 40.000 EACH | . | | . | |
| 2200 | SPV.0060 Special 0005. TRAFFIC CONTROL INTERIM FREEWAY TWO LANE CLOSURE | 120.000 EACH | . | | . | |

SCHEDULE OF ITEMS

REVISED:

CONTRACT:
20151208010PROJECT(S):
1060-34-84
1060-35-85FEDERAL ID(S):
N/A
N/A

CONTRACTOR : _____

| LINE NO | ITEM DESCRIPTION | APPROX. QUANTITY AND UNITS | UNIT PRICE | | BID AMOUNT | |
|------------|---|----------------------------------|------------|-----|------------|-----|
| | | | DOLLARS | CTS | DOLLARS | CTS |
| 2210 | SPV.0060 Special 0006. TRAFFIC CONTROL LOCAL ROAD LANE CLOSURES | 21.000 EACH | . | | . | |
| 2220 | SPV.0060 Special 1001. REMOVING LIGHTING UNITS | 26.000 EACH | . | | . | |
| 2230 | SPV.0060 Special 1002. REMOVING LUMINAIRES UNDERDECK | 2.000 EACH | . | | . | |
| 2240 | SPV.0060 Special 1003. REMOVING UNDERDECK LIGHTING | 1.000 EACH | . | | . | |
| 2250 | SPV.0060 Special 1004. LAMP DISPOSAL HID | 30.000 EACH | . | | . | |
| 2260 | SPV.0060 Special 1005. LIGHTING PULL BOXES WAUWATOSA | 8.000 EACH | . | | . | |
| 2270 | SPV.0060 Special 1006. CONCRETE BASES TYPE 5 SPECIAL | 2.000 EACH | . | | . | |
| 2280 | SPV.0060 Special 1007. POLES TYPE 5 ALUMINUM 25-FT | 9.000 EACH | . | | . | |
| 2290 | SPV.0060 Special 2012. INSTALL 5.8 GHZ ETHERNET BRIDGE | 1.000 EACH | . | | . | |
| 2300 | SPV.0060 Special 2013. GROUND ROD | 1.000 EACH | . | | . | |

SCHEDULE OF ITEMS

REVISED:

CONTRACT:
20151208010PROJECT(S):
1060-34-84
1060-35-85FEDERAL ID(S):
N/A
N/A

CONTRACTOR : _____

| LINE NO | ITEM DESCRIPTION | APPROX. QUANTITY AND UNITS | UNIT PRICE | | BID AMOUNT | |
|------------|--|----------------------------------|------------|-----|------------|-----|
| | | | DOLLARS | CTS | DOLLARS | CTS |
| 2310 | SPV.0060 Special 4001. PILE DYNAMIC ANALYZER (PDA) TESTING | EACH 6.000 | . | | . | |
| 2320 | SPV.0060 Special 4002. PILE DYN AMIC ANALYZER (PDA) RESTRIKES | EACH 6.000 | . | | . | |
| 2330 | SPV.0060 Special 4003. CASE PILE WAVE ANALY. PROGRAM (CAP WAP) EVALUATION | EACH 3.000 | . | | . | |
| 2340 | SPV.0060 Special 5010. SANITARY MANHOLE TYPE A | EACH 1.000 | . | | . | |
| 2350 | SPV.0060 Special 5020. SANITARY MANHOLE TYPE D | EACH 1.000 | . | | . | |
| 2360 | SPV.0060 Special 5030. REMOVING SANITARY MANHOLE WAUWTOSA | EACH 1.000 | . | | . | |
| 2370 | SPV.0060 Special 5040. WATER MAIN VERTICAL OFFSET | EACH 1.000 | . | | . | |
| 2380 | SPV.0060 Special 5050. ADJUSTING WATER VALVES | EACH 14.000 | . | | . | |
| 2390 | SPV.0060 Special 5060. ADJUSTING WATER MANHOLE | EACH 3.000 | . | | . | |
| 2400 | SPV.0060 Special 5070. ABANDONING WATER MANHOLE | EACH 2.000 | . | | . | |

SCHEDULE OF ITEMS

REVISED:

CONTRACT:
20151208010PROJECT(S):
1060-34-84
1060-35-85FEDERAL ID(S):
N/A
N/A

CONTRACTOR : _____

| LINE NO | ITEM DESCRIPTION | APPROX. QUANTITY AND UNITS | UNIT PRICE | | BID AMOUNT | |
|------------|--|----------------------------------|------------|-----|------------|-----|
| | | | DOLLARS | CTS | DOLLARS | CTS |
| 2410 | SPV.0060 Special 5080. ADJUSTING SANITARY MANHOLE | 1.000 EACH | . | | . | |
| 2420 | SPV.0060 Special 5090. RECONSTRUCT SANITARY MANHOLE | 2.000 EACH | . | | . | |
| 2430 | SPV.0060 Special 5100. ABANDON WATER SERVICE | 3.000 EACH | . | | . | |
| 2440 | SPV.0060 Special 5110. ABANDON SANITARY SEWER SERVICE | 3.000 EACH | . | | . | |
| 2450 | SPV.0060 Special 5120. HYDRANT ASSEMBLY RELOCATION | 2.000 EACH | . | | . | |
| 2460 | SPV.0060 Special 8005. COVER PLATES LEFT IN PLACE | 22.000 EACH | . | | . | |
| 2470 | SPV.0060 Special 8006. INLET COVERS TYPE R-SPECIAL | 2.000 EACH | . | | . | |
| 2480 | SPV.0060 Special 8012. MANHOLES 9-FT SPECIAL | 4.000 EACH | . | | . | |
| 2490 | SPV.0060 Special 8015. PIPE CONNECTION TO EXISTING STRUCTURE | 1.000 EACH | . | | . | |
| 2500 | SPV.0090 Special 0001. PAVEMENT MARKING GROOVED PREFORMED THERMOPLASTIC STOP LINE 18-INCH WHITE | 55.000 LF | . | | . | |

SCHEDULE OF ITEMS

REVISED:

CONTRACT:
20151208010PROJECT(S):
1060-34-84
1060-35-85FEDERAL ID(S):
N/A
N/A

CONTRACTOR : _____

| LINE NO | ITEM DESCRIPTION | APPROX. QUANTITY AND UNITS | UNIT PRICE | | BID AMOUNT | |
|------------|--|----------------------------------|------------|-----|------------|-----|
| | | | DOLLARS | CTS | DOLLARS | CTS |
| 2510 | SPV.0090 Special 0002. PAVEMENT MARKING GROOVED PREFORMED THERMOPLASTIC CROSSWALK 24-INCH WHITE | 766.000 LF | . | . | . | . |
| 2520 | SPV.0090 Special 0003. PAVEMENT MARKING GROOVED PREFORMED PLASTIC TAPE 4-INCH YELLOW | 2,040.000 LF | . | . | . | . |
| 2530 | SPV.0090 Special 0004. CONCRETE BARRIER TEMPORARY PRECAST DELIVERED SPECIAL | 2,263.000 LF | . | . | . | . |
| 2540 | SPV.0090 Special 0005. MAINTAIN CONCRETE BARRIER TEMPORARY PRECAST | 1,813.000 LF | . | . | . | . |
| 2550 | SPV.0090 Special 0006. GALVANIZED PIPE RAILING | 36.000 LF | . | . | . | . |
| 2560 | SPV.0090 Special 0007. PIPE UNDERDRAIN 6-INCH SPECIAL | 1,285.000 LF | . | . | . | . |
| 2570 | SPV.0090 Special 0008. FENCE TEMPORARY 6-FT | 1,500.000 LF | . | . | . | . |
| 2580 | SPV.0090 Special 1001. POLYETHYLENE DUCT 1 1/4-INCH | 3,540.000 LF | . | . | . | . |
| 2590 | SPV.0090 Special 4004. FENCE DECORATIVE BRIDGE B-40-880 | 402.000 LF | . | . | . | . |

SCHEDULE OF ITEMS

REVISED:

CONTRACT: PROJECT(S): FEDERAL ID(S):
 20151208010 1060-34-84 N/A
 1060-35-85 N/A

CONTRACTOR : _____

| LINE NO | ITEM DESCRIPTION | APPROX. QUANTITY AND UNITS | UNIT PRICE | | BID AMOUNT | |
|------------|--|----------------------------------|------------|-----|------------|-----|
| | | | DOLLARS | CTS | DOLLARS | CTS |
| 2600 | SPV.0090 Special 5010. SANITARY SEWER 12-INCH PVC | 276.000 LF | . | | . | |
| 2610 | SPV.0090 Special 5020. ABANDONING SANITARY SEWER 12-INCH | 90.000 LF | . | | . | |
| 2620 | SPV.0090 Special 5030. REMOVING SANITARY SEWER PIPE | 183.000 LF | . | | . | |
| 2630 | SPV.0090 Special 8010. SS PIPE RF CONC HORIZ ELLIP 48X76" | 400.000 LF | . | | . | |
| 2640 | SPV.0105 Special 0001. SURVEY PROJECT 1060-34-84 | LUMP | LUMP | | . | |
| 2650 | SPV.0105 Special 0002. SURVEY PROJECT 1060-35-85 | LUMP | LUMP | | . | |
| 2660 | SPV.0105 Special 0003. PAVEMENT CLEANUP PROJECT 1060-34-84 | LUMP | LUMP | | . | |
| 2670 | SPV.0105 Special 0004. PAVEMENT CLEANUP PROJECT 1060-35-85 | LUMP | LUMP | | . | |
| 2680 | SPV.0105 Special 0005. CONTROL OF WATER 1060-34-84 | LUMP | LUMP | | . | |
| 2690 | SPV.0135 Special 0001. VIBRATION MONITORING | 6.000 MON | . | | . | |
| 2700 | SPV.0165 Special 0001. MULCH SHREDDED BARK | 150.000 SF | . | | . | |

SCHEDULE OF ITEMS

REVISED:

CONTRACT:
20151208010

PROJECT(S):
1060-34-84
1060-35-85

FEDERAL ID(S):
N/A
N/A

CONTRACTOR : _____

| LINE NO | ITEM DESCRIPTION | APPROX. QUANTITY AND UNITS | UNIT PRICE | | BID AMOUNT | |
|---------|---|----------------------------|------------|-----|------------|-----|
| | | | DOLLARS | CTS | DOLLARS | CTS |
| 2710 | SPV.0165 Special 0002. SIDEWALK BRICK SALVAGED | 48.000 SF | . | | . | |
| 2720 | SPV.0165 Special 4005. WALL CONC PANEL MSE LRFD/QMP *** | 15,760.000 SF | . | | . | |
| 2730 | SPV.0180 Special 0001. TOPSOIL SPECIAL | 28,930.000 SY | . | | . | |
| 2740 | SPV.0195 Special 0001. COLD PATCH | 10.000 TON | . | | . | |
| 2750 | 616.0329 Gates Chain Link (width) 0002. 12-Ft | 4.000 EACH | . | | . | |
| | SECTION 0001 TOTAL | | | | . | |
| | TOTAL BID | | | | . | |