



Wisconsin Department of Transportation

January 8, 2016

Division of Transportation Systems Development

Bureau of Project Development
 4802 Sheboygan Avenue, Rm 601
 P O Box 7916
 Madison, WI 53707-7916

Telephone: (608) 266-1631
 Facsimile (FAX): (608) 266-8459

NOTICE TO ALL CONTRACTORS:

Proposal #23: Project 1170-00-74, WISC 2016 036
Wausau - Merrill
B-37-155, 158, 159
USH 51
Marathon County

Letting of January 12, 2016

This is Addendum No. 02, which provides for the following:

Special Provisions

Revised Special Provisions	
Article No.	Description
40	Temporary Wall Wire Faced Mechanically Stabilized Earth

Schedule of Items

Revised Bid Item Quantities					
Bid Item	Item Description	Unit	Old Quantity	Revised Quantity	Proposal Total
204.0100	Removing Pavement	SY	760	110	870
305.0120	Base Aggregate Dense 1 ¼ Inch	TON	28,500	130	28,630
455.0105	Asphaltic Material PG58-28	TON	560	10	570
455.0605	Tack Coat	GAL	3,640	80	3,720
460.1103	HMA Pavement Type E-3	TON	8,155	75	8,230
603.8000	Concrete Barrier Temporary Precast Delivered	LF	13,625	800	14,425
603.8125	Concrete Barrier Temporary Precast Installed	LF	35,695	800	36,495
614.0905	Crash Cushions Temporary	EACH	5	2	7
643.0300	Traffic Control Drums	DAYS	56,365	-8,065	48,300
643.0420	Traffic Control Barricades Type III	DAYS	4,545	-2,090	2,455
643.0705	Traffic Control Warning Lights Type A	DAYS	9,090	-60	9,030
643.0715	Traffic Control Warning Lights Type C	DAYS	5,130	-145	4,985
643.0800	Traffic Control Arrow Boards	DAYS	425	-20	405
643.0900	Traffic Control Signs	DAYS	11,360	-205	11,155
646.0600	Removing Pavement Markings	LF	9,890	-3,690	6,200
649.0400	Temporary Pavement Marking Removable Tape 4-Inch	LF	34,715	-14150	20,565
690.0250	Sawing Concrete	LF	52	225	277

Added Bid Item Quantities					
Bid Item	Item Description	Unit	Old Quantity	Revised Quantity	Proposal Total
415.0090	Concrete Pavement 9-Inch	SY	0	110	110

Plan Sheets

Revised Plan Sheets	
Plan Sheet	Plan Sheet Title (brief description of changes to sheet)
57	Traffic Control Overview 6A- changed sheet for the traffic now being on the outside lanes instead of the eastbound lanes
58	Traffic Control Stage 6A- redesigned and cadded sheet for traffic driving on the outside lanes
59	Traffic Control Overview 6B- changed sheet for the traffic now being on the inside lanes instead of the westbound lanes
60	Traffic Control Stage 6B- redesigned and cadded sheet for traffic driving on the inside lanes
71	Miscellaneous Quantities-changed removing pavement quantity
73	Miscellaneous Quantities-added concrete pavement 9-inch quantity, changed base aggregate 1 ¼ inch, asphaltic material PG58-28, tack coat, and HMA pavement type E-3 quantities
80	Miscellaneous Quantities- updated traffic control drums, traffic control barricades type III, traffic control warning lights type A, and traffic control signs quantities
81	Miscellaneous Quantities- updated traffic control drums, traffic control barricades type III, traffic control warning lights type A, traffic control arrow boards, traffic control warning lights type C, and traffic control signs quantities
82	Miscellaneous Quantities- updated removing pavement markings and temporary pavement marking removable tape 4-inch quantities
83	Miscellaneous Quantities- updated sawing concrete quantity
84	Miscellaneous Quantities- updated concrete barrier temporary precast delivered, concrete barrier temporary precast installed, and crash cushions temporary quantities
207	B-37-158 General Plan and Elevation- Revised temporary structure layout, revised list of drawings.
211	B-37-158 Temporary Structure- Revised temporary MSE wall layout, Added optional pier and pile for temporary bridge.
212	B-37-158 Subsurface Exploration- Revised temporary structure layout in subsurface exploration sheet.

Added Plan Sheets	
Plan Sheet	Plan Sheet Title (brief description of why sheet was added)
10A	Typical Section-to show typical section on CTH WW
92A	Plan- to show permanent work on CTH WW
211A	B-37-158 Sheet 5A Temporary Structure (2 of 2)- Sheet was added to provide elevation and section of temporary wire faced wall.

The responsibility for notifying potential subcontractors and suppliers of these changes remains with the prime contractor.

Sincerely,

Mike Coleman

Proposal Development Specialist
Proposal Management Section

ADDENDUM NO. 02

1170-00-74

January 8, 2016

Special Provisions

40. Temporary Wall Wire Faced Mechanically Stabilized Earth

Replace entire section titled B.2 Design Requirements with the following:

B.2 Design Requirements

It is the responsibility of the contractor to supply a design and supporting documentation as required by this special provision for review by the department to show the proposed wall design is in compliance with the design specifications. Four copies of the following shall be submitted to the engineer for review and acceptance no later than 60 days from the date of notification to proceed with the project.

The design/shop plans shall be prepared on reproducible sheets 11 inch x 17 inch, including borders. Each sheet shall have a title block in the lower right corner. The title block shall include the project identification number and structure number. Design calculations and notes shall be on 8 ½ inch x 11 inch sheets, and shall contain the project identification number, name or designation of the wall, date of preparation, initials of designer and checker, and page number at the top of the page. All plans and calculations shall be signed, sealed and dated by a professional engineer licensed in the State of Wisconsin.

The design life shall be three years, or the length of time the temporary wall will be in service, whichever is greater. The overall vertical tolerance of the wall and the horizontal alignment tolerance shall not exceed 3 inches per 10 feet.

The design of the Wire Faced MSE Walls shall be in compliance with the AASHTO LRFD Bridge Design Specifications 5th Edition 2010, (AASHTO LRFD) with latest interim specifications for Mechanically Stabilized Earth Walls, WisDOT's current Standard Specifications for Highway and Structure Construction (Standard Specifications), Chapter 14 of the WisDOT LRFD Bridge Manual and standard engineering design procedures as determined by the department. Loads, load combinations, load and resistance factors shall be as specified in AASHTO LRFD Section 11. The associated resistance factors shall be defined according to Table 11.5.6-1 LRFD.

Design and construct the walls according to the lines, grades, heights, and dimensions shown on the plans, as herein specified, and as directed by the department. If the wall is installed in front of a temporary bridge abutment or wing, it shall also be designed to resist the applied abutment/temporary bridge lateral forces. The lines, grades, heights, and dimensions shown on the plans shall be modified as required to accommodate the temporary bridge foundations, at no extra cost to the department.

Walls parallel to supporting highway traffic shall be designed for the effects of highway surcharge loading equivalent of 2 feet soil surcharge weight or 240 psf. The design shall also consider the traffic barrier impact where applicable. Walls that do not carry highway traffic shall be designed for a live load surcharge of 100 psf according to Chapter 14 of the WisDOT LRFD Bridge Manual or as stated on the plans.

A maximum value of the angle of internal friction of the wall backfill material used for design shall be assumed to be 30 degrees without a certified report of tests. If a certified report of tests yields an angle of internal friction greater than 30 degrees, the larger test value may be used for design, up to a maximum value of 36 degrees.

An external stability check at critical wall stations showing Capacity Demand Ratios (CDR) for sliding, eccentricity, factored bearing resistance, global stability, and settlement shall be performed and submitted to the engineer along with calculations. Determine loads transferred from the temporary bridge to the temporary wire faced MSE wall and include these loads in the CDR calculations.

The design of the Wire Faced MSE Walls by the contractor shall consider the internal and compound stability of the wall mass according to AASHTO LRFD 11.10.6. The internal stability shall include soil reinforcement pullout, soil reinforcement rupture, and panel-reinforcement connection failure at each soil reinforcement level. The design shall be performed using the Simplified Method or Coherent Gravity Method. Calculations for factored stresses and resistances shall be based upon assumed conditions at the end of the design life. Compound stability shall be computed for the applicable strength limits.

The minimum embedment of the Wire Faced MSE wall shall be 1 foot 6 inches, or as given on the contract plan. Frost depth shall not be considered. The wall facings shall be designed according to AASHTO 11.10.2.3. A fine metallic screen and a geotextile filter fabric shall be used at the front face of the wall to retain the fines of the soil mass.

The nominal long term design strength to be used in steel reinforcement and connector design shall consider the corrosion losses and based upon conditions at the end of the design life. The minimum length of soil reinforcement measured from the back face of the wall shall be equal to 0.7 of the wall height or as shown on the plan. In no case shall this length be less than 8 feet. The soil reinforcement shall be the same length from the bottom to the top of each wall section. All soil reinforcement layers shall be connected to facings. The soil reinforcement shall extend 3 feet beyond the theoretical failure plane in all cases. The maximum vertical spacing of soil reinforcement layers shall be 24 inches. The uppermost layer of the reinforcement shall be located between 6" and 12" below the bottom of an overlying slab, footing or top of the wall. The upper layers of the soil reinforcement shall also be checked to verify that they have sufficient tensile resistance against traffic barrier impact where applicable.

Soil reinforcement shall be fabricated or designed to avoid piling, drainage structures or other obstacles in the fill without field modifications. Cutting or altering of the basic structural section of either the strip or grid at the site is prohibited unless approved by the Structures Design Section. A minimum clearance of 3" shall be maintained between any obstruction and reinforcement unless otherwise approved. Splicing steel reinforcement is not allowed unless approved by the Structures Design Section.

Submit the following to the engineer for review: complete design calculations, explanatory notes, supporting materials, specifications, and detailed plans and shop drawings for the proposed wall system. Sample analyses and hand output shall be submitted to verify the output by the software. The design calculations and notes shall clearly indicate the Capacity to Demand Ratios (CDR) for all internal stabilities as defined in AASHTO LRFD.

The wall submittal package shall be submitted electronically to the engineer and the Structures Design Section. Submit all required information no later than 30 days prior to beginning construction of the wall. The detailed plans and shop drawings shall include all details, dimensions, quantities and cross-sections necessary to construct the walls. Sample analyses and hand calculations shall be submitted to verify the output of any software program used. The design calculations and notes shall clearly indicate the Capacity to Demand Ratios (CDR) for all internal and external stabilities as defined in AASHTO LRFD.

Replace entire section titled **B.3.1 Welded Wire Fabric** with the following:

B.3.1 General

Provide steel reinforcement that meets the following requirements:

- **Welded Wire Fabric Soil Reinforcement**

Provide shop fabricated welded wire reinforcement from cold drawn steel wire that has a yield stress of 65,000 psi and conforming to the minimum requirements of ASTM A-1064 and be welded into the finished configuration in accordance to ASTM A-1064. Replace welded wire fabric that has been damaged during handling, placing or backfilling at the direction of the engineer, at no expense to the department.

- **Steel Reinforcing Strips and Tie Strips**

As an alternate to welded wire reinforcing mesh, provide steel reinforcing strips or ladder reinforcing strips or equal, hot-rolled from bars, to the required shape and dimensions meeting the requirements of ASTM A-572 Grade 65 minimum. Tie strips shall be shop fabricated of hot-rolled steel meeting the requirements of ASTM A-1011 Grade 50.

- **Welded Wire Fabric Facing Panels**

Provide welded wire fabric that is used to fabricate the facings of the wire-faced wall that has a yield stress of 65,000 psi. All steel shall be shop fabricated of cold drawn steel wire conforming to the minimum requirements of ASTM A-1064 and be welded into the finished configuration in accordance to ASTM A-1064. Replace welded wire fabric that has been damaged during handling, placing or backfilling at the direction of the engineer, at no expense to the department.

- **Fasteners**

High strength bolts meeting the requirements of AASHTO M164 or equivalent.

- **Connector Pins and Mat Bars**

Connector pins and mat bars fabricated from cold drawn steel wire meeting the requirements of ASTM A-82.

- **Metallic Screen**

Provide a steel metallic screen. The metallic screen should have an approximate opening of ¼" and be made of 0.025" (minimum) gauge wire.

- **Geotextile Fabric**

Geotextile fabric shall be used behind the metallic screen. Use geotextile as recommended by the wall manufacturer. If none is recommended, use Type DF (schedule B) as shown in standard spec 645 or as specified on the contract plans. Deliver in a protective wrap and keep protected from ultraviolet light until incorporate into the work.

Replace entire section titled **C.1 Methods** with the following:

C.1 Excavation and Backfill

Excavation and preparation of the foundation for the MSE wall and facing leveling pad or footing shall be in accordance to standard spec 206. The volume of excavation covered is limited to the width of the reinforced mass and to the depth of the bottom of the wall unless shown or noted otherwise on the plan. At the end of each working day, provide good temporary drainage such that the backfill shall not become contaminated with run-off soil or water if it is should rain. Do not stockpile or store any materials or large equipment within 10 feet of the back of the wall.

Excavate below subgrade where unsuitable soils are encountered and backfill with suitable fill to attain external stability CDRs per AASHTO LRFD, at no cost to the department.

Place backfill materials in the areas as indicated on the plans and as detailed in this specification. Backfill lifts shall be no more than 8-inches in depth.

Conduct backfilling operations in such a manner as to prevent damage or misalignment of the wall facings, soil reinforcement, or other wall components. At no expense to the department, correct any such damage or misalignment as directed by the engineer. A field representative of the wall supplier shall be available during wall construction to provide technical assistance to the contractor and the engineer.

Place and compact the MSE backfill to the level of the next higher layer of MSE reinforcement before placing the MSE reinforcement or connecting it to the wall facing. The MSE reinforcement shall lay horizontally on top of the most recently placed and compacted layer of MSE backfill.

Do not operate tracked or wheeled equipment on the backfill within 3 feet from the back wall facing. The engineer may order the removal of any large or heavy equipment that may cause damage or misalignment of the wall facing.

Compact all backfill behind the wall as specified in standard spec 207.3.6. Compact the backfill to 95.0% of maximum dry density as determined by AASHTO T-99 (modified to compute densities to the nearest 0.1 pcf), or as modified as follows. If the gradation of the granular backfill is such that the P-200 material is less than 7% and the P-40 is less than 30%, a one-point Proctor test can be conducted in place of the 5-point Proctor. To complete this one-point test, compact the sample at a moisture content of 6%, then compute the actual (as-tested) sample moisture after completion of the test. Use Method B or D, and perform this test without removing oversize particles and without correction for coarse particles, as per AASHTO T224. The one-point as-tested moisture content represents the optimum moisture, and the measured one-point density represents the maximum wet density of the material. From these values, the maximum dry density can be computed.

Ensure adequate moisture is present in the backfill during placement and compaction to prevent segregation and to help achieve compaction.

Compaction of backfill within 3 feet of the back face of the wall should be accomplished using lightweight compaction devices. Use of heavy compaction equipment or vehicles should be avoided within 3 feet of the wall facing.

A minimum of 3 inches of backfill shall be placed over the MSE reinforcement prior to working above the reinforcement.

*Replace entire section titled **E Payment** with the following:*

E Payment

No payment is associated with the work specified in this article Temporary Wall Wire Faced Mechanically Stabilized Earth. The cost of work required by Temporary Wall Wire Faced Mechanically Stabilized Earth is included in the Temporary Structure bid items and shall include supplying a design and shop drawings; preparing the site, including all necessary excavation and disposal of materials; supplying all necessary wall components to produce a functional wall system, constructing the retaining system including drainage system; providing backfill, backfilling, compacting, performing compaction testing; covering geotextile; removing and disposing of temporary wire faced MSE wall at the end of construction, restoring the ground to original conditions; and furnishing all tools, labor, equipment, and incidentals necessary to complete the contract work. Any pay limits described in this special provision are applicable to the Temporary Structure bid item.

Schedule of Items

Attached, dated January 8, 2016, are the revised Schedule of Items Pages 1 – 15.


Plan Sheets

The following 8½ x 11-inch sheets are attached and made part of the plans for this proposal:

Revised: 57 - 60, 71, 73, 80 – 84, 207, 211, and 212.


Added: 10A, 92A, and 211A.

END OF ADDENDUM

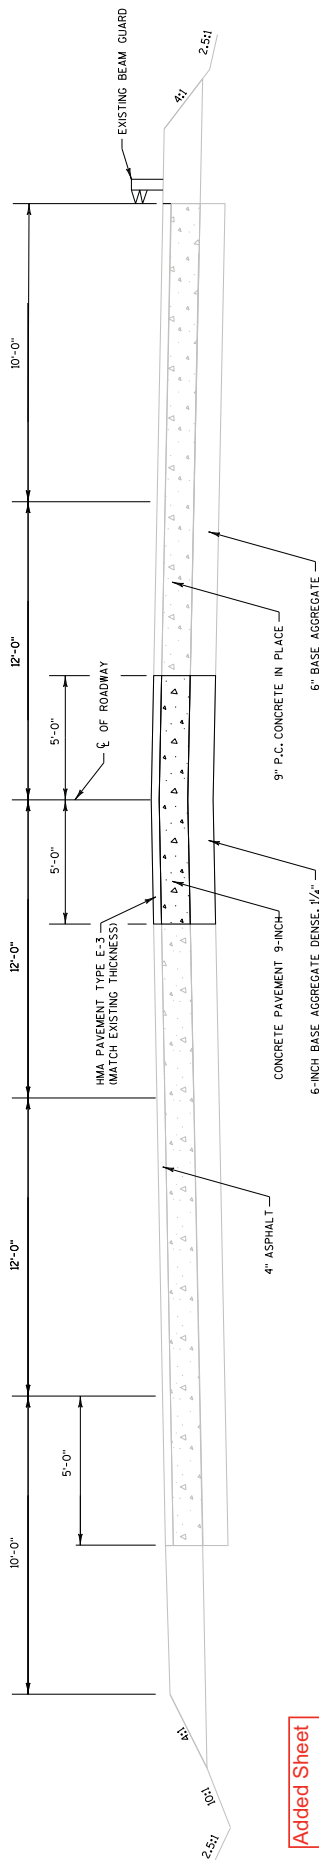


Added Sheet

Addendum No. 02
ID 1170-00-74
Added Sheet 10A
January 8, 2016

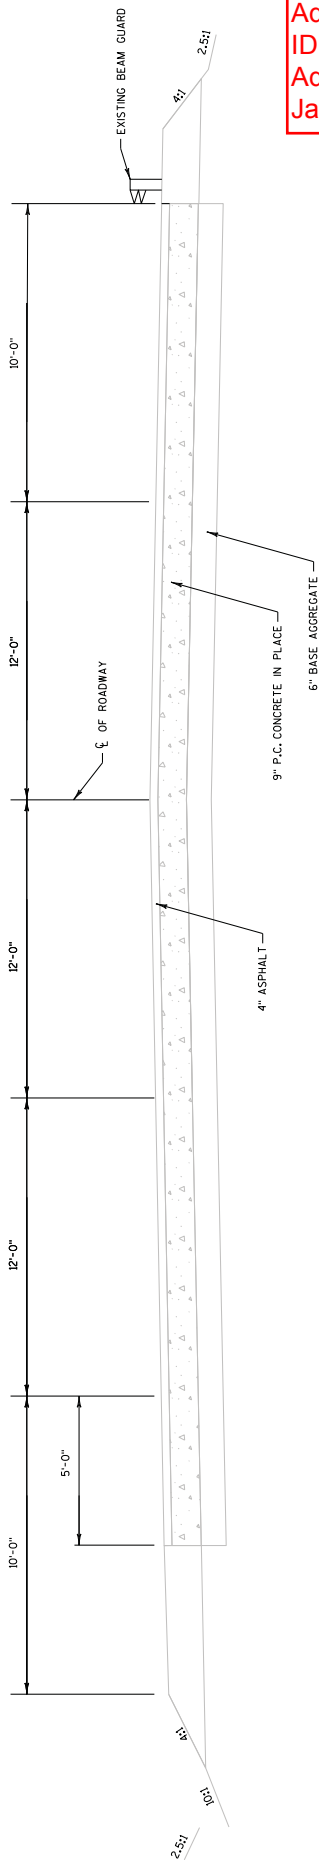




CONSTRUCTION STAGES 1-5 AND 6A (STAGING FOR OPTIONAL PIER)
 STAGES 1-5 - CONSTRUCTION: RE-DECK USH 51 NB AND SB BRIDGES
 STAGE 6A - CONSTRUCTION: PAINT USH 51 OVERPASS OVER INSIDE CTH WW LANES
 STAGE 6A - TRAFFIC: TRAFFIC SHIFTED TO OUTSIDE LANES


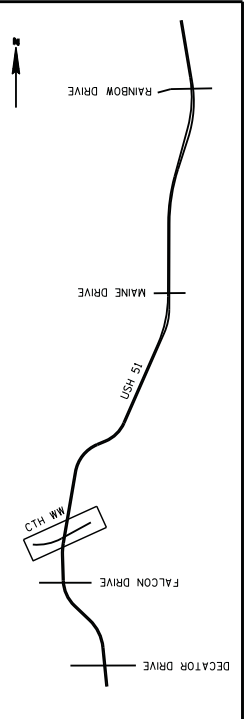


Addendum No. 02
 ID 1170-00-74
 Revised Sheet 57
 January 8, 2016

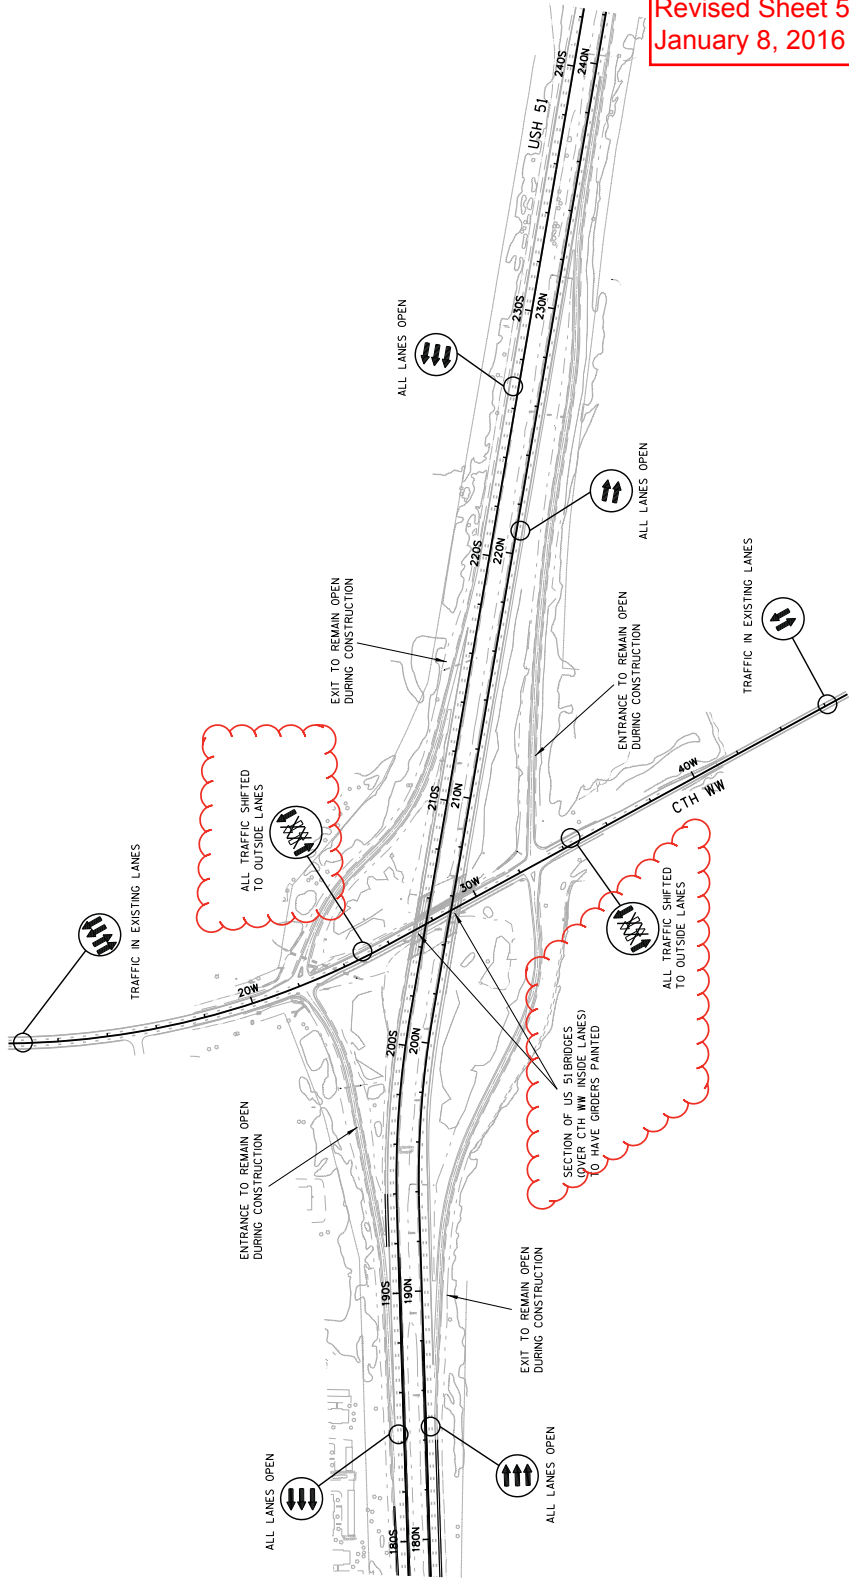

TRAFFIC CONTROL IS FOR OPTIONAL PIER OPTION ON TEMPORARY BRIDGE. IF THE OPTIONAL PIER IS CONSTRUCTED, USE THIS TRAFFIC CONTROL ON CTH WW FOR STAGES 1-5. DETAIL CAN BE USED FOR PAINTING OPERATIONS IN STAGE 6A.

Entire sheet changed

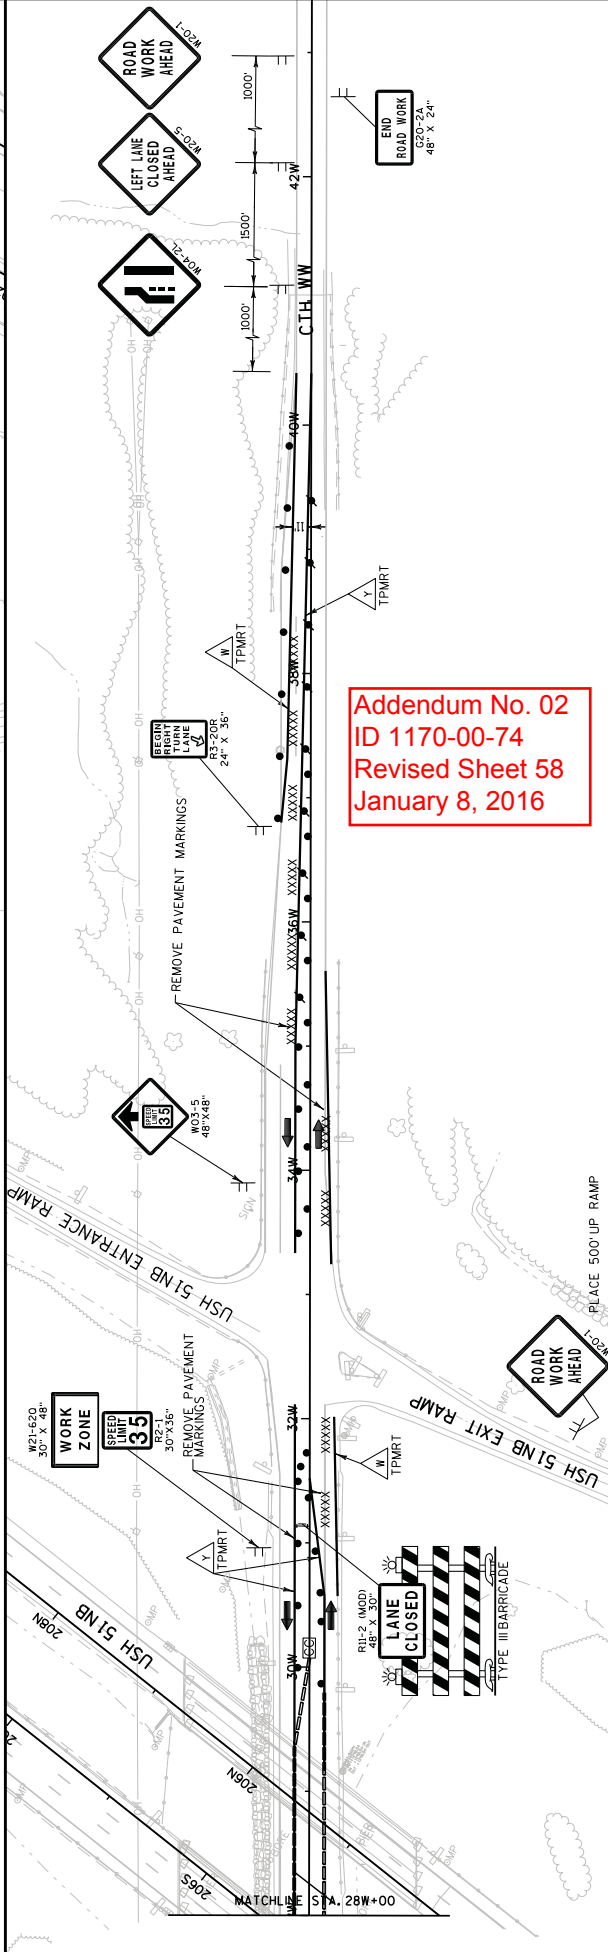
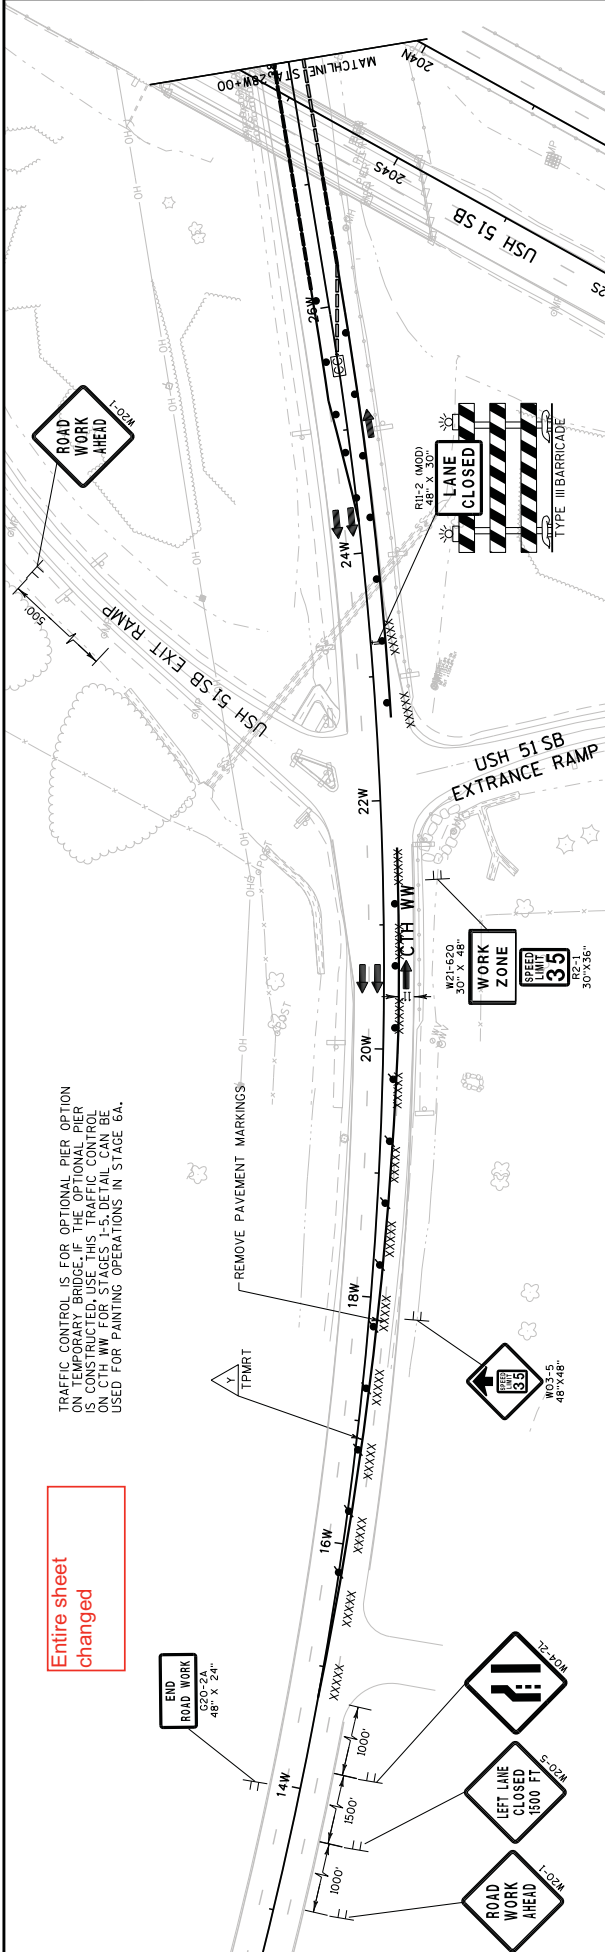



Addendum No. 02
ID 1170-00-74
Revised Sheet 58
January 8, 2016




Addendum No. 02
ID 1170-00-74
Revised Sheet 59
January 8, 2016

CONSTRUCTION STAGE 6B
STAGE 6B - CONSTRUCTION: PAINT USH 51 OVERPASS OVER OUTSIDE CTH WW LANES
STAGE 6B - TRAFFIC: TRAFFIC SHIFTED TO INSIDE LANES

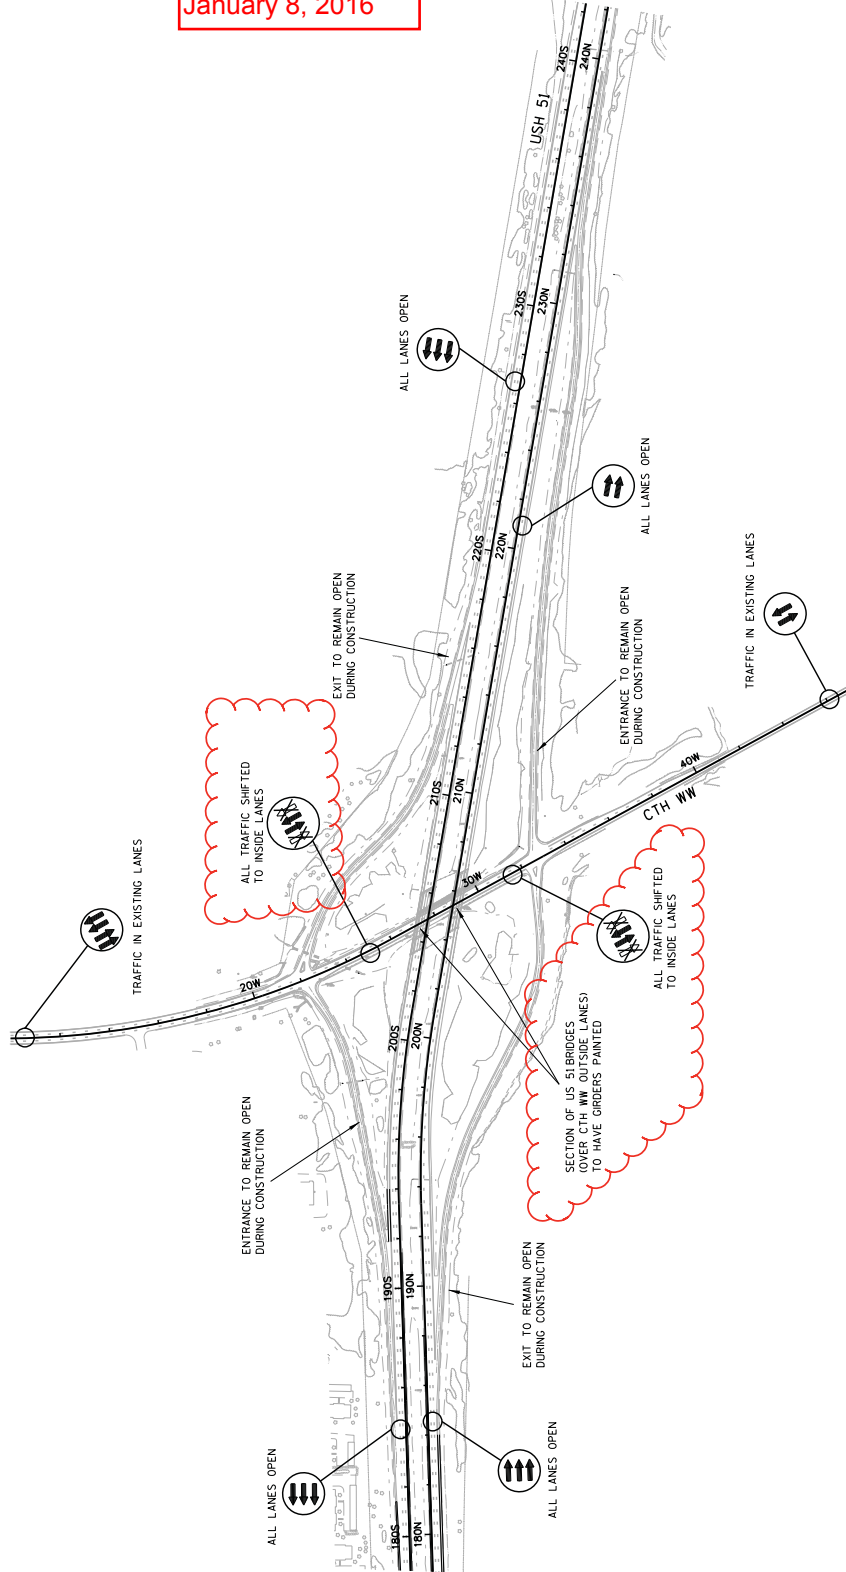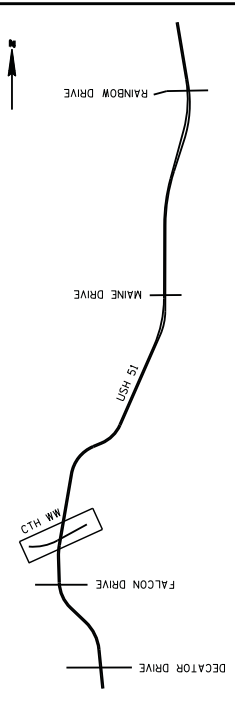

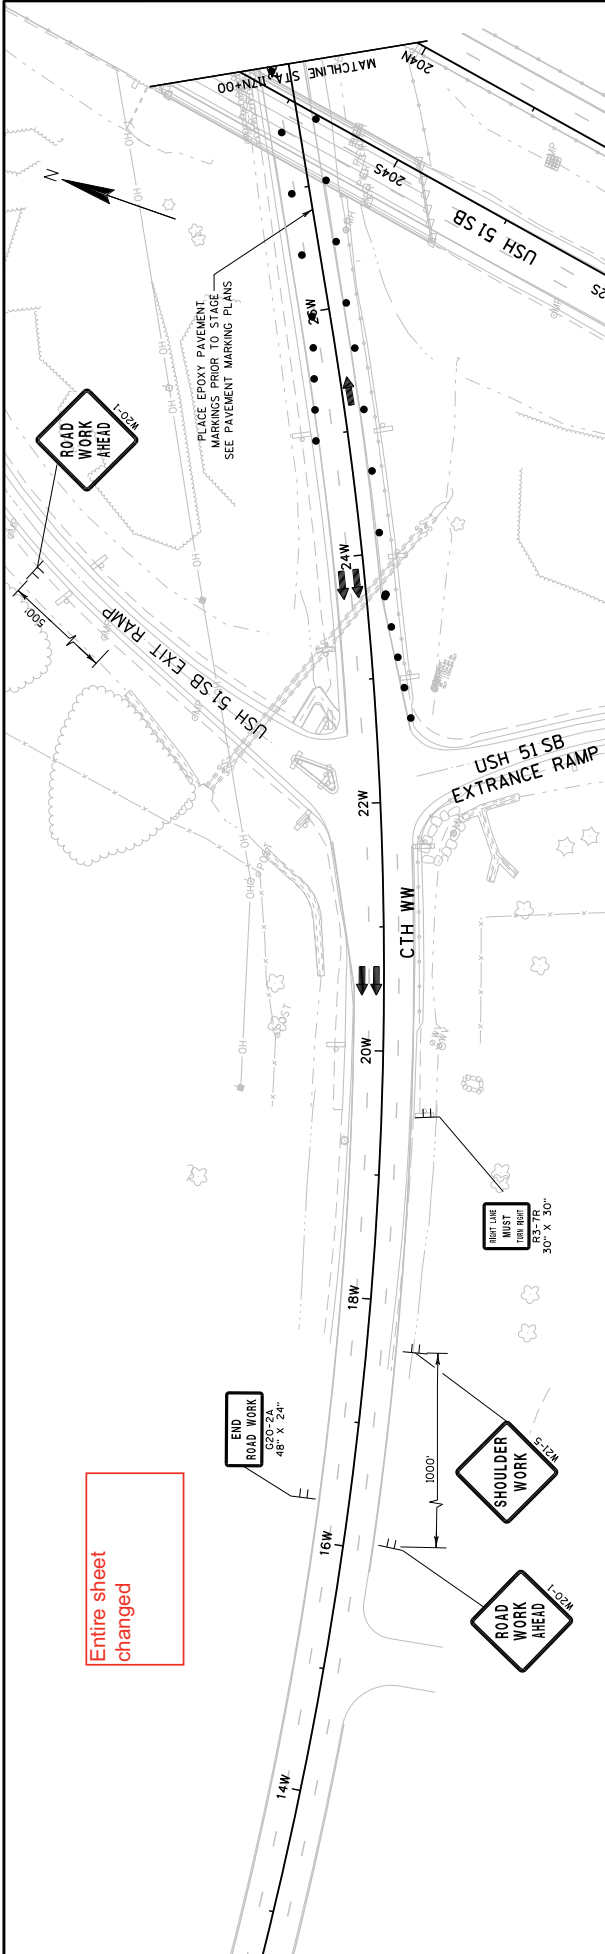

Entire sheet changed

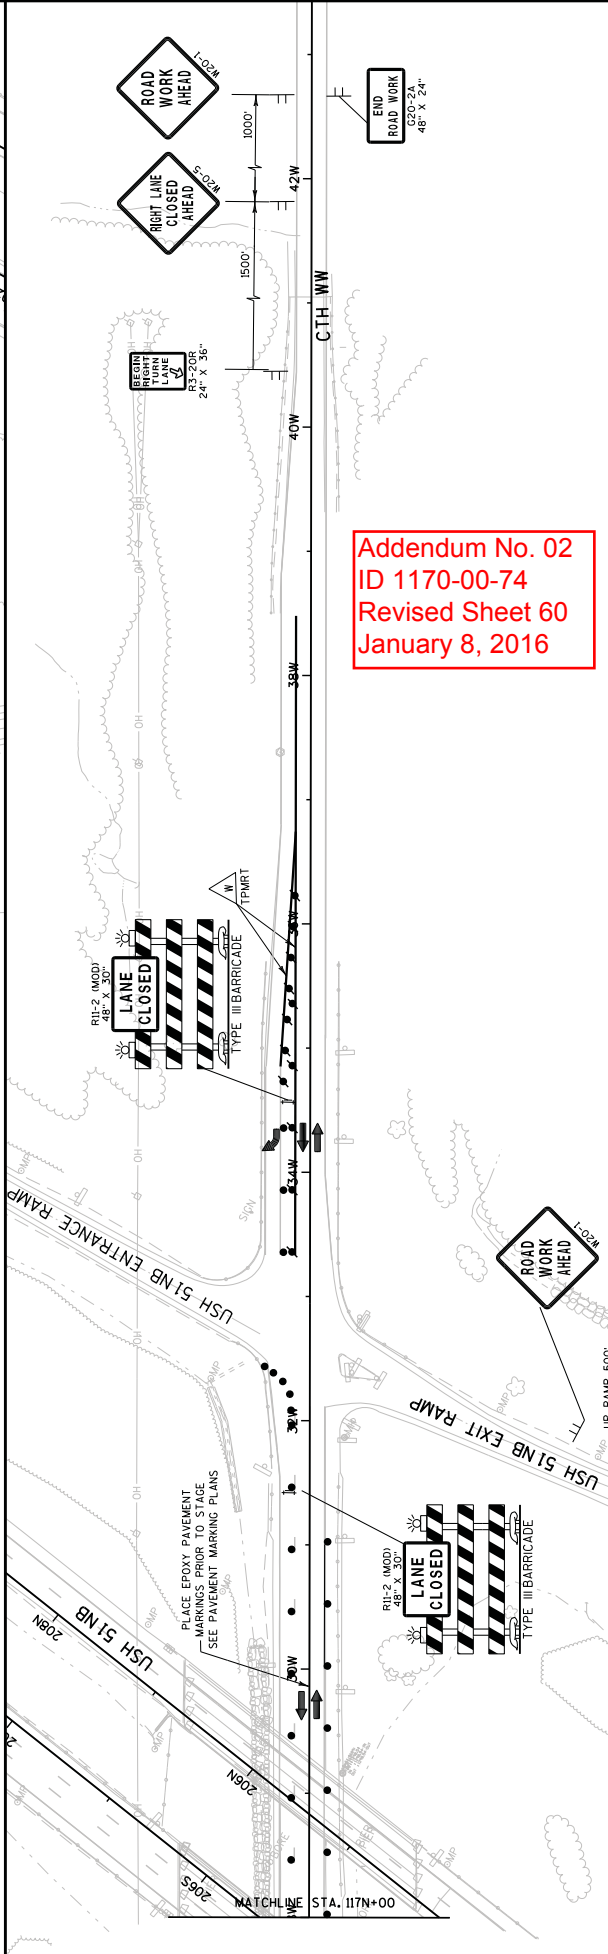

Addendum No. 02
ID 1170-00-74
Revised Sheet 60
January 8, 2016

PROJECT NO: 1170-00-74	HWY: USH 51	COUNTY: MARATHON	TRAFFIC CONTROL - STAGE 6B	SCALE, FEET 0 100 200	SHEET 60	E
FILE NAME : F:\BM1-3212 USH 51 Marathon Co Structures\roads\1170-00-04\026602-16B.74-.tc.dgn						
PLOT DATE : 07-JAN-2016 12:37						
PLOT BY : ceven						
PLOT NAME : 026602-16B.74-.tc						
PLOT SCALE : 100:1 WSDOT/CADDS SHEET 42						

REMOVING ASPHALTIC SURFACE MILLING

CATEGORY	STAGE	LOCATION	STA	TO	STA	SY
0010		USH51 & DECATOR DR				204.0120

1		103N+56	-	112N+52		1,000
1		114N+66	-	119N+00		650
2		102N+00	-	112N+52		560
2		114N+66	-	119N+00		690
3		111N+00	-	112N+52		165
3		114N+66	-	116N+29		145

USH51 & CTH WW

2		200N+63	-	203N+90		1,490
2		207N+33	-	208N+68		580
3		111N+00	-	261N+00		3,910
3		411N+00	-	551N+55		4,020
4		200S+78	-	203S+08		1,280
4		206S+70	-	210S+47		2,150
TOTAL						16,640

Addendum No. 02
ID 1170-00-74
Revised Sheet 71
January 8, 2016

REMOVING PAVEMENT

CATEGORY	STAGE	LOCATION	STA	TO	STA	LOCATION	SY
0010		USH51 & DECATOR DR					204.0100

2		111N+00	-	112N+90		LT	507
3		111N+00	-	112N+90		RT	253
1		CTH WW	27W+75	-	28W+75		110
TOTAL							870

PREPARE FOUNDATION FOR ASPHALTIC SHOULDERS

CATEGORY	STAGE	LOCATION	STA	TO	STA	SY
0010		USH51 & DECATOR DR				211.0400

1		103N+66	-	112N+90		10
2		102N+00	-	111N+00		9
TOTAL						19

CLEARING AND GRUBBING

201.0120 201.0220
CLEARING GRUBBING

CATEGORY	STAGE	LOCATION	STATION	STATION	ID	ID	
0010	1	CTH WW NB TEMP ROAD	151N+00	-	451N+00	LT	90
TOTALS							90

REMOVING GUARDRAIL

CATEGORY	STAGE	LOCATION	STA	TO	STA	LOCATION	LF
0010		USH51 & DECATOR DR					204.0185

2		111N+00	-	112N+81		LT	180
3		111N+00	-	112N+76		RT	175
TOTALS							355
2		201N+08	-	204N+13		LT	310
2		203N+98	-	204N+48		RT	50
4		206S+03	-	206S+54		LT	50
4		206S+47	-	209S+40		RT	300
TOTAL							1,065

REMOVING ASPHALTIC SURFACE BUTT JOINTS

CATEGORY	STAGE	LOCATION	SY
0010		204.0115	

REMOVING SURFACE DRAINS

CATEGORY	STAGE	LOCATION	SY
0010	1	B-37-158	204.0190
TOTAL			EACH
TOTAL			1

PROJECT NO: 1170-00-74

HWY: USH 51

COUNTY: MARATHON

MISCELLANEOUS QUANTITIES

SHEET NO: 71

CONCRETE SURFACE DRAINS

CATEGORY	STAGE	LOCATION	STA	TO	STA	LOCATION	SY	SY	SY	STAGE	ROADWAY	LOCATION	CY
0010	2	USH51 & DECA TOR DR	111N+00	-	112N+90	LT	510	5	206S+61.4	5	7.0	RT	2.9
	3		111N+00	-	112N+90	RT	250	5	206N+90	5	4.0	LT	0.8
	6A	CTHWW	27W+75	-	28W+75		110	5	207N+20	5	34.0	RT	1.1
TOTAL													5

CONCRETE PAVEMENT

CATEGORY	STAGE	LOCATION	STA	TO	STA	LOCATION	SY	SY	SY	STAGE	ROADWAY	LOCATION	CY
0010	2	USH51 & DECA TOR DR	111N+00	-	112N+90	LT	510	5	206S+61.4	5	7.0	RT	2.9
	3		111N+00	-	112N+90	RT	250	5	206N+90	5	4.0	LT	0.8
	6A	CTHWW	27W+75	-	28W+75		110	5	207N+20	5	34.0	RT	1.1
TOTAL													5

ASPHALT PAVEMENT ITEMS

CATEGORY	STAGE	LOCATION	STA	TO	STA	LOCATION	TON	TON	TON	STAGE	ROADWAY	LOCATION	TON
0010	1	USH51 & DECA TOR DR	103N+66	-	112N+52		16	60	290	60	290		--
	1		114N+65	-	119N+00		2	20	45	20	45		--
	2		102N+00	-	112N+52		9	30	180	30	180		--
	2		114N+65	-	116N+29		6	60	100	60	100		--
	2		116N+29	-	119N+00		1	10	15	10	15		--
	3		111N+00	-	112N+52		2	10	45	10	45		--
	3		114N+65	-	116N+29		4	40	75	40	75		--
TOTAL													75

MISCELLANEOUS QUANTITIES

CATEGORY	STAGE	LOCATION	STA	TO	STA	LOCATION	TON	TON	TON	STAGE	ROADWAY	LOCATION	TON
0010	1	USH51 & DECA TOR DR	111N+00	-	112N+90	LT	510	5	206S+61.4	5	7.0	RT	2.9
	2		111N+00	-	112N+90	RT	250	5	206N+90	5	4.0	LT	0.8
	6A	CTHWW	27W+75	-	28W+75		110	5	207N+20	5	34.0	RT	1.1
TOTAL													5

BASE AGGREGATE DENSE

CATEGORY	STAGE	LOCATION	STA	TO	STA	LOCATION	TON	TON	TON	STAGE	ROADWAY	LOCATION	TON
0010	1	USH51 & DECA TOR DR	114N+65	-	119N+00		15	--	--				--
	2		111N+00	-	112N+90		15	125					
	2		114N+51	-	116N+29		10	--	--				--
	2		116N+29	-	119N+00		10	--	--				--
	3		111N+00	-	112N+90		25	110					
	3		114N+51	-	116N+29		10	--	--				--
TOTAL													130

UNDISTRIBUTED

CATEGORY	STAGE	LOCATION	STA	TO	STA	LOCATION	TON	TON	TON	STAGE	ROADWAY	LOCATION	TON
0010	1	USH51 & DECA TOR DR	111N+00	-	112N+90	LT	510	5	206S+61.4	5	7.0	RT	2.9
	2		111N+00	-	112N+90	RT	250	5	206N+90	5	4.0	LT	0.8
	6A	CTHWW	27W+75	-	28W+75		110	5	207N+20	5	34.0	RT	1.1
TOTAL													5

CONCRETE PAVEMENT APPROACH SLAB

CATEGORY	STAGE	LOCATION	STA	TO	STA	LOCATION	SY	SY	SY	STAGE	ROADWAY	LOCATION	SY
0010	2	USH51	B-37-155 NB				183						
	2		B-37-158 NB				267						
	4		B-37-159 SB				392						
TOTAL													842

CONCRETE PAVEMENT APPROACH SLAB

CATEGORY	STAGE	LOCATION	STA	TO	STA	LOCATION	SY	SY	SY	STAGE	ROADWAY	LOCATION	SY
0010	2	USH51	B-37-155 NB				183						
	2		B-37-158 NB				267						
	4		B-37-159 SB				392						
TOTAL													842

Addendum No. 02
ID 1170-00-74
Revised Sheet 73
January 8, 2016

PROJECT NO: 1170-00-74	COUNTY: MARATHON	MISCELLANEOUS QUANTITIES	SHEET NO: 73
FILE NAME : F:\BM1-3212 USH 51 Marathon Co Structures\readscad\1170-00-04\030201_jmg.ppt	PLOT DATE : 1/7/2016 11:55 AM	PLOT NAME : 030201_jmg3	PLOT SCALE : 1.000000:1.000000
TOTAL		570	3,720
TOTAL		8,230	840

TRAFFIC CONTROL

CATEGORY	STAGE DURATION DAYS	LOCATION	TRAFFIC CONTROL DRUMS		TRAFFIC CONTROL BARICADES		TRAFFIC CONTROL WARNING LIGHTS		TRAFFIC CONTROL WARNING LIGHTS		TRAFFIC CONTROL ARROW BOARDS		TRAFFIC CONTROL SIGNS		TRAFFIC CONTROL SIGNS		TRAFFIC CONTROL SIGNS		SRV.0045.01	
			EACH	DAYS	EACH	DAYS	EACH	DAYS	EACH	DAYS	EACH	DAYS	EACH	DAYS	EACH	DAYS	EACH	DAYS		EACH
0010	5	STAGE 4A1 DECATOR DRIVE	35	175	--	--	--	--	1	5	6	30	16	80	1	14	1	14	1	14
	52	STAGE 4A1 CTH WW	57	2,965	--	--	--	--	1	50	--	--	6	310	--	--	--	--	--	--
		USH51 NB, Sta. 126N+00 - 126N+00	4	210	--	--	--	--	--	--	--	--	2	105	--	--	--	--	--	--
		USH51 NB, Sta. 176N+00 - 232N+00	--	--	--	--	--	--	--	--	--	--	--	--	--	--	--	--	--	--
		USH51 SB, Sta. 80S+00 - 126S+00	--	--	--	--	--	--	--	--	--	--	4	210	--	--	--	--	--	--
		USH51 SB, Sta. 126S+00 - 176S+00	78	4,065	6	310	12	625	--	--	34	1,770	7	365	1	14	1	14	1	14
		USH51 SB, Sta. 176S+00 - 243S+00	32	1,665	1	50	11	570	--	--	9	470	1	14	1	14	1	14	1	14
		CTH WW EB, Sta. 0W+00 - 67W+00	31	1,610	1	50	11	570	--	--	10	520	1	14	1	14	1	14	1	14
		CTH WW WB, Sta. 0W+00 - 67W+00																		
		STAGE 4 SUBTOTAL		10,680	410		1,765	55	1,800			2,080	1	56						56
	20	STAGE 5	10	200	--	--	--	--	1	20	--	--	6	120	--	--	1	14	1	14
		USH51 NB, Sta. 60N+00 - 126N+00	54	1,080	--	--	--	--	--	--	--	2	40	--	--	--	--	--	--	--
		USH51 NB, Sta. 176N+00 - 232N+00	4	80	--	--	--	--	--	--	--	2	40	--	--	--	--	--	--	--
		USH51 SB, Sta. 80S+00 - 126S+00	54	1,080	--	--	--	--	--	--	--	7	140	--	--	--	--	--	--	--
		USH51 SB, Sta. 126S+00 - 176S+00	10	200	--	--	--	--	1	20	--	9	180	--	--	1	14	1	14	1
		USH51 SB, Sta. 176S+00 - 243S+00	32	640	1	20	11	220	--	--	10	200	1	14	1	14	1	14	1	14
		CTH WW EB, Sta. 0W+00 - 67W+00	31	620	1	20	11	220	--	--	10	200	1	14	1	14	1	14	1	14
		CTH WW WB, Sta. 0W+00 - 67W+00																		
		STAGE 5 SUBTOTAL		3,900	40		440	40	0		720	0	56							56
	15	STAGE 6A	--	--	--	--	--	--	--	--	--	--	4	60	--	--	--	--	--	--
		USH51 NB, Sta. N+00 - N+00	32	480	1	15	165	--	--	--	4	60	1	14	1	14	1	14	1	14
		USH51 SB, Sta. S+00 - S+00	31	465	1	15	165	--	--	--	10	150	1	14	1	14	1	14	1	14
		CTH WW EB, Sta. 0W+00 - 67W+00																		
		CTH WW WB, Sta. 0W+00 - 67W+00																		
		STAGE 6A SUBTOTAL		945	30		330	0	0		405	0	28							28
	15	STAGE 6B	--	--	--	--	--	--	--	--	--	--	4	60	--	--	--	--	--	--
		USH51 NB, Sta. N+00 - N+00	20	300	--	--	--	--	--	--	--	5	75	--	--	1	14	1	14	1
		USH51 SB, Sta. S+00 - S+00	38	570	2	30	17	255	--	--	7	105	1	14	1	14	1	14	1	14
		CTH WW EB, Sta. 0W+00 - 67W+00																		
		CTH WW WB, Sta. 0W+00 - 67W+00																		
		STAGE 6B SUBTOTAL		870	30		255	0	0		300	0	28							28
		UNDISTRIBUTED	--	4,390	--	225	--	820	--	35	--	455	--	1,015	--	--	40	--	--	40
		TOTALS		48,300	2,465		9,030	405	4,985		11,155	2	460							460

Addendum No. 02
ID 1170-00-74
Revised Sheet 81
January 8, 2016

* FOR INFORMATION ONLY
** ADDITIONAL QUANTITIES LISTED ELSEWHERE
SEE SDD "LANE CLOSURE SPEEDS GREATER THAN 40MPH" FOR PLACEMENT OF TRAFFIC CONTROL DEVICES

TEMPORARY PAVEMENT MARKINGS

CATEGORY	ROADWAY	STAGE	646.0600 REMOVING PAVEMENT MARKINGS		647.0955 REMOVING MARKINGS		649.0402 TEMPORARY PAVEMENT MARKING PAINT 4-INCH YELLOW		649.0400 TEMPORARY PAVEMENT MARKING REMOVABLE TAPE 4-INCH		649.0801 TEMPORARY PAVEMENT MARKING REMOVABLE TAPE 8-INCH	
			LF	STA	EACH	LF	LF	LF	WHITE	YELLOW	WHITE	BLACK
0010	USH51	1	--		--		--		--		--	
		2	2,300		--		4,350	8,350	3,240	4,400	900	650
		3	1,700		--		--	--	1,700	3,400	425	--
		4	1,440		--		4,450	5,250	--	1,950	--	1570
		5	--		--		--	--	--	--	--	--
	CTHWW	6A	760		1		--	--	3,100	750	--	--
		6B	--		1		--	--	--	700	--	--
TOTALS			6,200		1		22,400		20,565			2,220

PAVEMENT MARKING ITEMS

CATEGORY	STAGE	LOCATION	646.0106 EPOXY 4-INCH		646.0126 EPOXY 8-INCH		646.0841.S GROOVED WET		646.0881.S GROOVED WET		647.0166 REFLECTIVE TAPE	
			YELLOW	WHITE	WHITE	WHITE	WHITE	WHITE	REFLECTIVE TAPE	REFLECTIVE TAPE	EPOXY	EPOXY
0010	3	USH 51 & DECATOR DR	2,430	2,375	--		425		575		--	--
	2	USH 51 & CTH WW	4,500	4,560	--		--		1,290		--	--
	3	178S+00 - 223S+00	4,500	4,625	--		--		1,000		--	--
	6B	CTH WW	1,430	1,300	195		--		325		2	1
		14W+52 - 21W+64	--	--	--		--		--		--	--
		19W+89 RT TURN LANE	1,910	1,950	--		--		250		--	--
		22W+57 - 32W+12	1,420	1,430	155		--		150		--	--
		33W+29 - 40W+44	32,430	350	425		3,590		2		1	
TOTALS			32,430	350	425		3,590		2		1	

TRAFFIC CONTROL ITEMS

643.0100.01			
TRAFFIC CONTROL			
ID 1170-00-74			
CATEGORY	STAGE	PROJECT	EACH
0010	1	1170-00-74	1
TOTALS			1

Addendum No. 02
ID 1170-00-74
Revised Sheet 82
January 8, 2016

TRAFFIC CONTROL DETOUR 1170-00-74

643.2000			
EACH			
CATEGORY	LOCATION		
0010	CTH WW		1
TOTALS			1

TRAFFIC CONTROL DETOUR ITEMS

CATEGORY	LOCATION	DAYS	EACH	EACH	TYPE I	TYPE II	DETOUR
0010	CTHWW						
	STAGE 1	40	1	1	74	2960	
	STAGE 5	19	1	1	74	1406	
TOTALS			2	2		4,366	

** ADDITIONAL QUANTITIES LISTED ELSEWHERE

SAWING CONCRETE

CATEGORY	STAGE	LOCATION	STA	TO	STA	LF
0010		USH 51 & DECATOR DR				690.0250
	2		111N+00	-	111N+00	30
	3		111N+00	-	111N+00	22
	1	CTHWW	27W+75	-	28W+75	225
TOTAL						277

SAWING ASPHALT

CATEGORY	STAGE	LOCATION	STA	TO	STA	LF
0010		USH 51 & DECATOR DR				690.0150
	2		116N+29	-	116N+29	28
	3		116N+29	-	116N+29	20
	1	USH 51 & CTHWW	178N+00	-	200N+00	2,250
	2		178S+00	-	200S+00	2,269
	4		200S+00	-	214S+00	403
	2		200N+00	-	214N+00	572
	2		214S+00	-	223S+00	861
	1		214N+00	-	223N+00	837
	3	USH 51 & CTHWW TEMP ROAD	26T5W+00			34
	3		41TDW+00			34
TOTAL						7,300

MGS GUARDRAIL ITEMS

CATEGORY	STAGE	LOCATION	STA	TO	STA	LOCATION	LF	LF	SPV.0090.01	
0010		USH 51 & DECATOR DR								
	1		109N+92	-	112N+75	RT	--	--	280	
	2		109N+64	-	111N+00	LT	--	--	135	
	2		111N+00	-	112N+34	LT	135	--		
	2		112N+34	-	112N+74	LT	--	39		
	3		111N+00	-	112N+30	RT	130	--		
	3		112N+30	-	112N+69	RT	--	39		
	3	USH 51 & CTHWW	201N+18	-	201N+71	LT	--	1		
	3		201N+71	-	203N+69	LT	200	--		
	3		203N+69	-	204N+08	LT	--	39		
	3		202N+06	-	204N+01	RT	--	--	195	
	3		204N+01	-	204N+40	RT	--	39		
	5		206S+12	-	206S+51	LT	--	39		
	5		206S+51	-	206S+47	LT	--	--	195	
	5		206S+52	-	206S+91	RT	--	39		
	5		206S+91	-	208S+68	RT	200	--		
	5		208S+68	-	209S+41	RT	--	1		
TOTAL							665	234	2	805


Addendum No. 02
ID 1170-00-74
Revised Sheet 83
January 8, 2016

CONCRETE BARRIER & CRASH CUSHIONS TEMPORARY

CATEGORY	STAGE	ROADWAY	STA - STA	603.8000		603.8125		614.0905		OBJECT MARKING PATTERN	CRASH TEST LEVEL	TRAFFIC DIRECTION	TRAFFIC LOCATION	CRASH CUSHION SHIELDS
				CONCRETE BARRIER DELIVERED LF	CONCRETE BARRIER PRECAST INSTALLED LF	CONCRETE BARRIER TEMPORARY PRECAST INSTALLED LF	CONCRETE BARRIER TEMPORARY CUSHIONS TEMPORARY EACH	CONCRETE BARRIER TEMPORARY CUSHIONS TEMPORARY EACH	CONCRETE BARRIER TEMPORARY CUSHIONS TEMPORARY EACH					
0010														
1	USH 51	177N+50	177N+50 - 222N+50	--	--	--	1	4	OM-3L	TL-3	UNIDIRECTIONAL	R	TEMPORARY CONC. BARRIER	
1	USH 51	177N+50	177N+50 - 222N+50	4,500	4,500	4,500	--	--	--	--	--	--	--	
1	USH 51	178S+50	178S+50 - 223S+50	4,500	4,500	4,500	--	--	--	--	--	--	--	
1	USH 51	223S+50	223S+50	--	--	--	1	4	OM-3L	TL-3	UNIDIRECTIONAL	R	TEMPORARY CONC. BARRIER	
1	CTH WWW	25W+50	25W+50	--	--	--	1	2	OM-3C	TL-3	BDIRECTIONAL	L&R	TEMPORARY CONC. BARRIER	
1	CTH WWW	30W+15	30W+15	--	--	--	1	2	OM-3C	TL-3	BDIRECTIONAL	L&R	TEMPORARY CONC. BARRIER	
1	CTH WWW	25W+00 - 31W+00	25W+00 - 31W+00	800	800	800	--	--	--	--	--	--	--	
2	USH 51	109N+50	109N+50 - 116N+00	650	620	620	--	--	--	TL-3	UNIDIRECTIONAL	L	TEMPORARY CONC. BARRIER	
2	USH 51	107N+50	107N+50 - 55TNW+50	50	4,550	4,550	1	4	OM-3R	TL-3	UNIDIRECTIONAL	L	TEMPORARY CONC. BARRIER	
2	USH 51	151TNW+65	151TNW+65 - 49TNW+50	3,400	3,400	3,400	--	--	--	--	--	--	--	
2	USH 51	151TNW+65	151TNW+65	--	--	--	1	4	OM-3C	TL3	UNIDIRECTIONAL	L&R	TEMPORARY CONC. BARRIER	
2	USH 51	182N+75	182N+75 - 188N+00	525	525	525	--	--	--	--	--	--	--	
3	USH 51	109N+50	109N+50 - 116N+00	--	650	650	--	--	--	--	--	--	--	
3	USH 51	177N+50	177N+50 - 222N+50	--	4,500	4,500	--	--	--	--	--	--	--	
4	USH 51	11TSW+50	11TSW+50 - 56TSW+60	--	4,500	4,500	--	--	--	--	--	--	--	
4	USH 51	17TSW+50	17TSW+50 - 52TSW+00	--	3,450	3,450	--	--	--	--	--	--	--	
4	USH 51	52TSW+00	52TSW+00	--	--	--	1	4	OM-3C	TL-3	UNIDIRECTIONAL	L&R	TEMPORARY CONC. BARRIER	
5	USH 51	178S+50	178S+50 - 223S+50	--	4,500	4,500	--	--	--	--	--	--	--	
TOTALS				14,425	36,495	36,495	7							

* FOR INFORMATION ONLY

Addendum No. 02
ID 1170-00-74
Revised Sheet 84
January 8, 2016

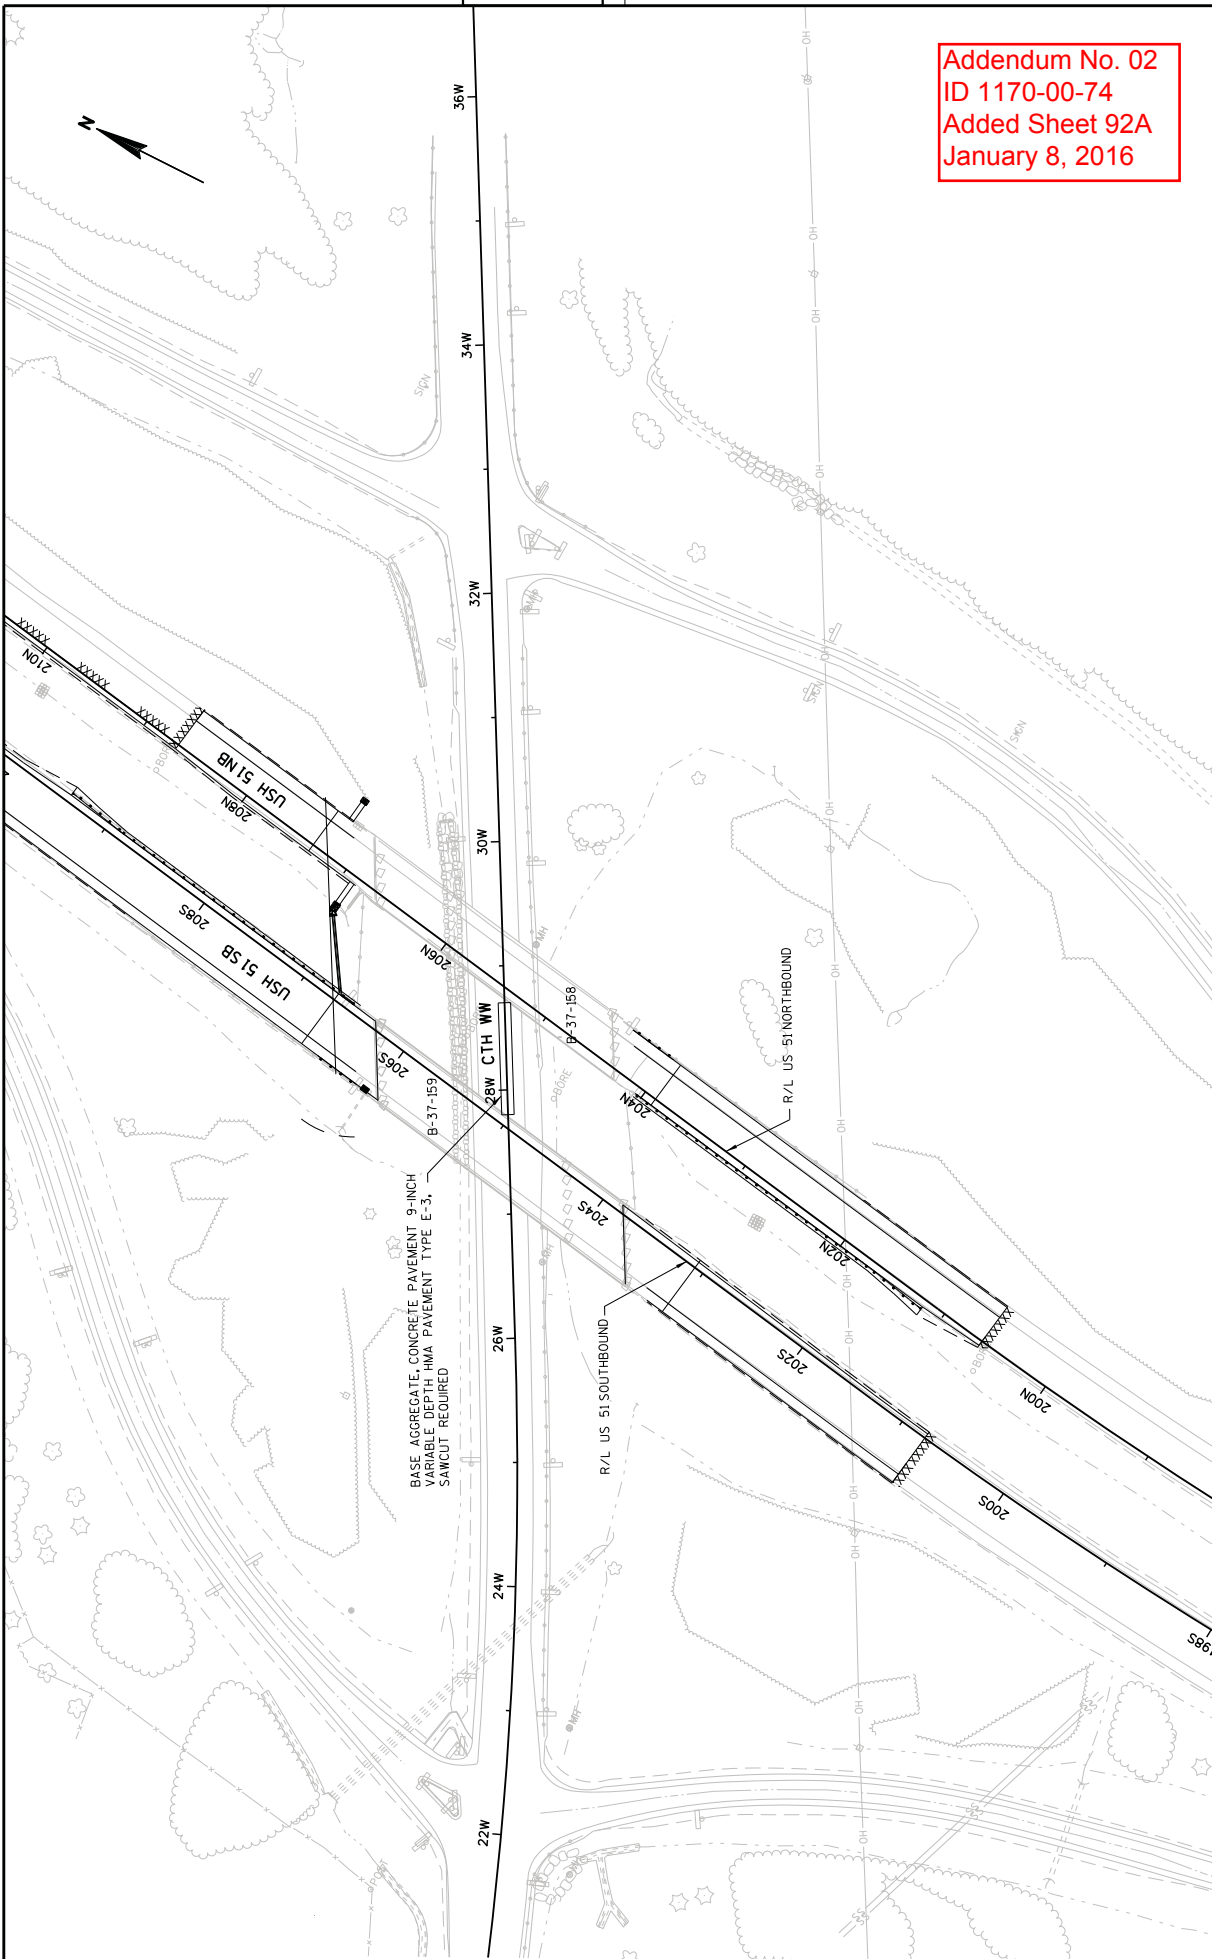

Addendum No. 02
 ID 1170-00-74
 Added Sheet 92A
 January 8, 2016

PROJECT NO: 1170-00-74	HWY: USH 51	COUNTY: MARATHON	PLAN	SHEET 92A	E
FILE NAME : F:\NM1-3212 USH 51 Marathon Co Structures\Roads\cbs\1170-00-04\050117_dp.dgn					
PLOT DATE : 07-JAN-2016 12:38					
PLOT BY : ceven					
PLOT SCALE : 100:1					
WISDOT/CADDSS SHEET 40					

STATE PROJECT NUMBER
1170-00-74

LIST OF DRAWINGS

1. GENERAL PLAN AND ELEVATION
2. TYPICAL SECTION
3. GENERAL NOTES AND QUANTITIES
4. GENERAL NOTES AND QUANTITIES
5. **TEMPORARY STRUCTURE (1 OF 2)**
- 5A. **TEMPORARY STRUCTURE (2 OF 2)**
6. SUBSURFACE EXPLORATION
7. SUPERSTRUCTURE PLAN
8. BRG. N. ABUT. DETAILS
9. BRG. S. ABUT. DETAILS
10. DECK ELEVATIONS
11. EXPANSION JOINT DETAILS (1 OF 2)
12. EXPANSION JOINT DETAILS (2 OF 2)
13. STRUCTURAL APPROACH SLAB
14. PAVING BLOCK
15. PAVING BLOCK
16. SINGLE SLOPE PARAPET 325S

FILE NAME: 1170-00-74-222 USH 51 NB Over CTH WW - 31-Structural Rev 118.dwg
DATE: 1/7/2016 12:52:18 PM
PEN TABLE: V8.STRUCTURAL_REV118



William C. Decker KAR 01/08/16


BLOOM COMPANIES, LLC
Professional Engineering Firm
10511 W. Research Drive • Milwaukee, WI 53228
Phone: (414) 771-3300 Fax: (414) 771-4499

STATE OF WISCONSIN
DEPARTMENT OF TRANSPORTATION

ACCEPTED
CHIEF STRUCTURES DESIGN ENGINEER DATE
STRUCTURE B-37-158
USH 51 NB OVER CTH WW


DESIGN SPEC: MARATHON TOWN MAINE
REHABILITATION N/A
DESIGNED BY: JRS
CHECKED BY: JRS
DRAWN BY: TB
SCALE: L.C.D. JRS/BOT
SHEET 1 OF 16
GENERAL PLAN AND ELEVATION
207

ID: 1170-00-04
SEPTEMBER 2015

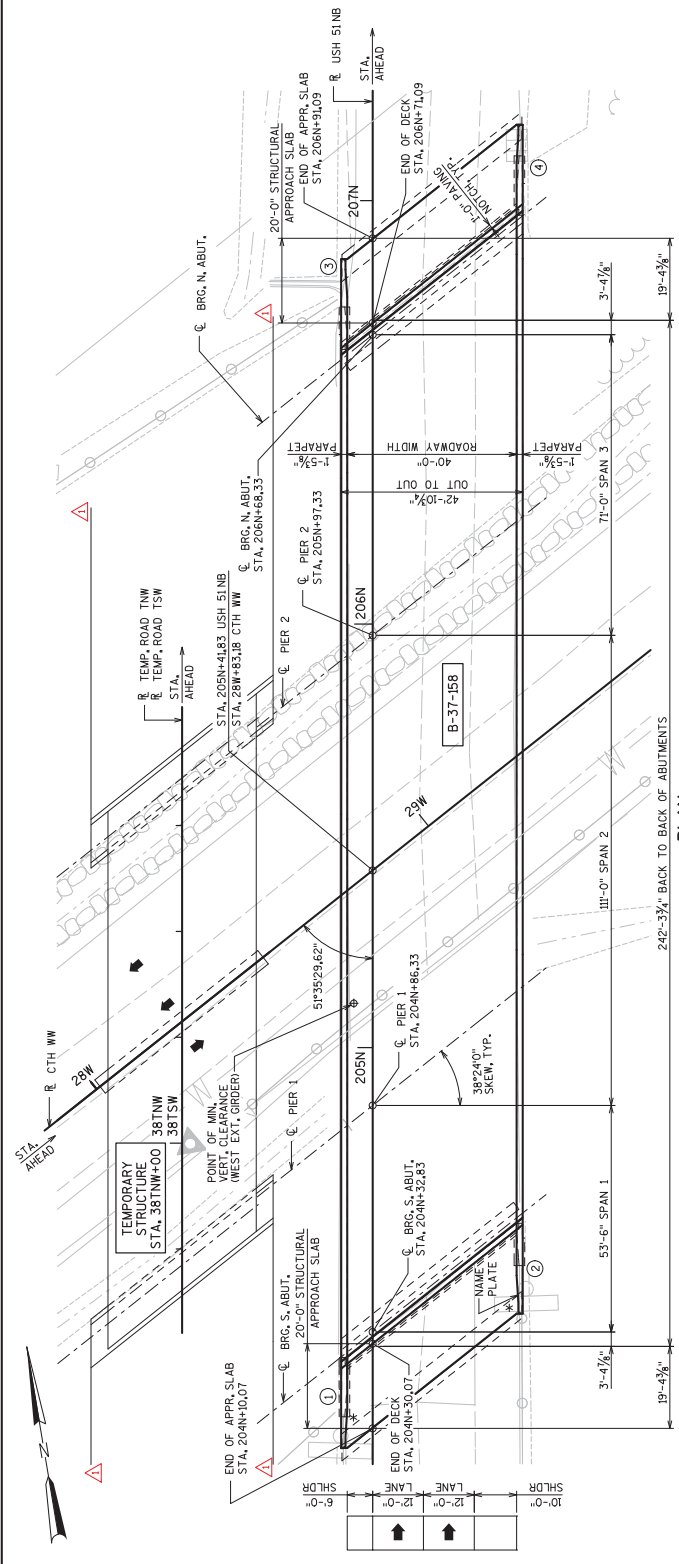

PLAN

(3 SPAN STEEL GIRDER BRIDGE)

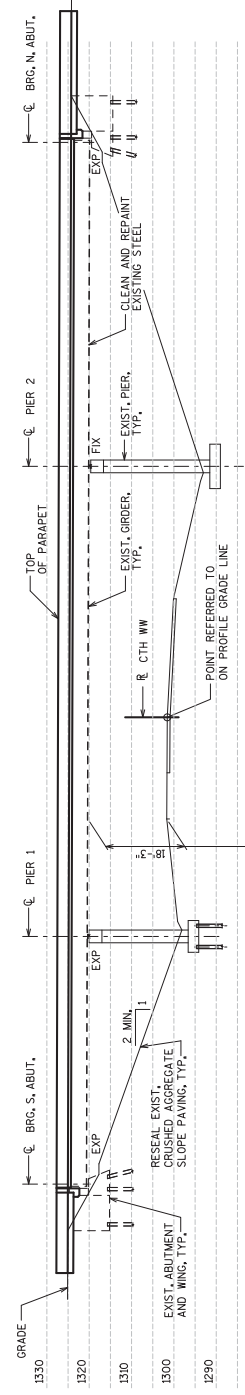

ELEVATION

(LOOKING WEST - NORMAL TO CTH WW)

LEGEND

- * PROVIDE FOR THREE BEAM GUARDRAIL ATTACHMENT
- RINGWALL NUMBER.

TRAFFIC DATA

USH 51
A.D.T. = 19,000 (2015)
A.D.T. = 24,300 (2035)
R.D.S. = 70 MPH
VEHICLE LOAD (WIS-SPV): 230 KIPS

DESIGN DATA

LIVE LOAD
DESIGN LOAD: HS-20
OPERATIONAL RANGING: HS-31
WISCONSIN STANDARD PERMIT

MATERIAL PROPERTIES

CONCRETE MASONRY fc = 4000 psi
SUPERSTRUCTURE fc = 4000 psi
APPROACH SLAB fc = 4000 psi
OTHER fc = 3500 psi
HIGH STRENGTH BAR STEEL fy = 60,000 psi
REINFORCEMENT, GRADE 60

Addendum No. 02
ID 1170-00-74
Revised Sheet 207
January 8, 2016

STRUCTURE DESIGN CONTACTS:
BUREAU OF STRUCTURES CONTACT:
WILLIAM DREHER
(608) 266-8489

CONSULTANT CONTACT:
WILLIAM DREHER
(414) 292-4599

STATE PROJECT NUMBER
1170-00-74

DESIGN DATA

DESIGN LOAD: HL93
 INVENTORY RATING FACTOR: 1.0 MIN.
 OPERATING RATING FACTOR: 1.30 MIN.
 MAXIMUM PERMITTED TRUCK WEIGHT: 100 KIPS
 VEHICLE LOAD (WES-SP-16): 180 KIPS MIN.
 DESIGN SPEED: 55 MPH

NOTES

DESIGN THE TEMPORARY STRUCTURE IN ACCORDANCE WITH ASHTO LRFD BRIDGE CONSTRUCTION SPECIFICATIONS, ARTICLE 3.5.

SUBMIT DESIGN CALCULATIONS AND SHOP DRAWINGS FOR THE TEMPORARY STRUCTURE TO BE STAMPED BY A PROFESSIONAL ENGINEER LICENSED IN THE STATE OF WISCONSIN.

THE TEMPORARY STRUCTURE SHOWN ON THE PLANS IS DESIGNED ONLY TO SUPPORT THE MINIMUM VERTICAL LOADS. THE CONTRACTOR SHALL VERIFY THE TYPE OF SOIL AT A DIFFERENT TYPE OF STRUCTURE MEETING THE GEOMETRIC REQUIREMENTS SHOWN ON THE PLANS. THE RIDING SURFACE ON THE TEMPORARY STRUCTURE SHALL BE SMOOTH AND WITHOUT JOINTS.



FOR GEOTECHNICAL INFORMATION, REFER TO EXISTING PLANS OF BRIDGE B-37-158 AND B-37-159, WHICH ARE AVAILABLE WITH THE WISCONSIN DEPARTMENT OF TRANSPORTATION, NORTH CENTRAL REGION, NEW SOIL BORINGS ARE PROVIDED ON SHEET 6 OF THIS PLAN.

THE COST OF WIRE FACED MSE WALL IS INCLUDED IN THE BID ITEM "TEMPORARY STRUCTURE STATION 381NW+00".


TEMPORARY BRIDGE IS REQUIRED TO MAINTAIN TWO LANES OF TRAFFIC WHILE BRIDGE B-37-158 AND B-37-159 ARE BEING CONSTRUCTED.

AT CONTRACTOR'S OPTION, A TEMPORARY PIER MAY BE USED TO SUPPORT THE TEMPORARY BRIDGE IF THIS OPTION IS EXERCISED, THE BID PRICE FOR TEMPORARY STRUCTURE, STATION 381NW+00 SHALL INCLUDE THE COST OF CONSTRUCTING THE PIER, INCLUDING, BUT NOT LIMITED TO, ANY PILING, EXCAVATION, AND BACKFILLING.

STATIONS AND OFFSETS OF THE FRONT FACE OF TEMPORARY WIRE FACED MSE WALL SHOWN ARE REFERENCED TO R. TNW/TSW.

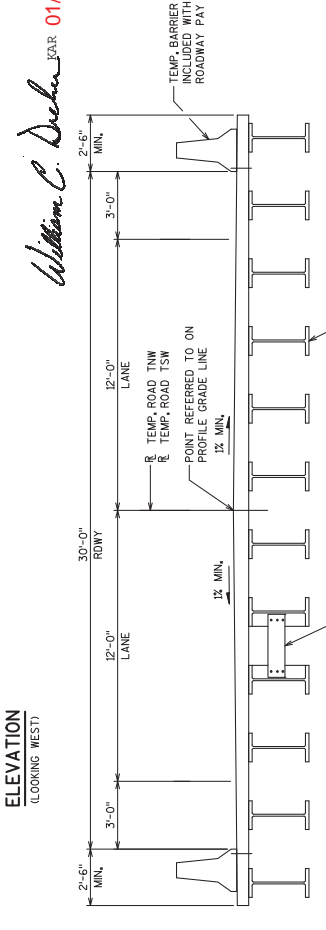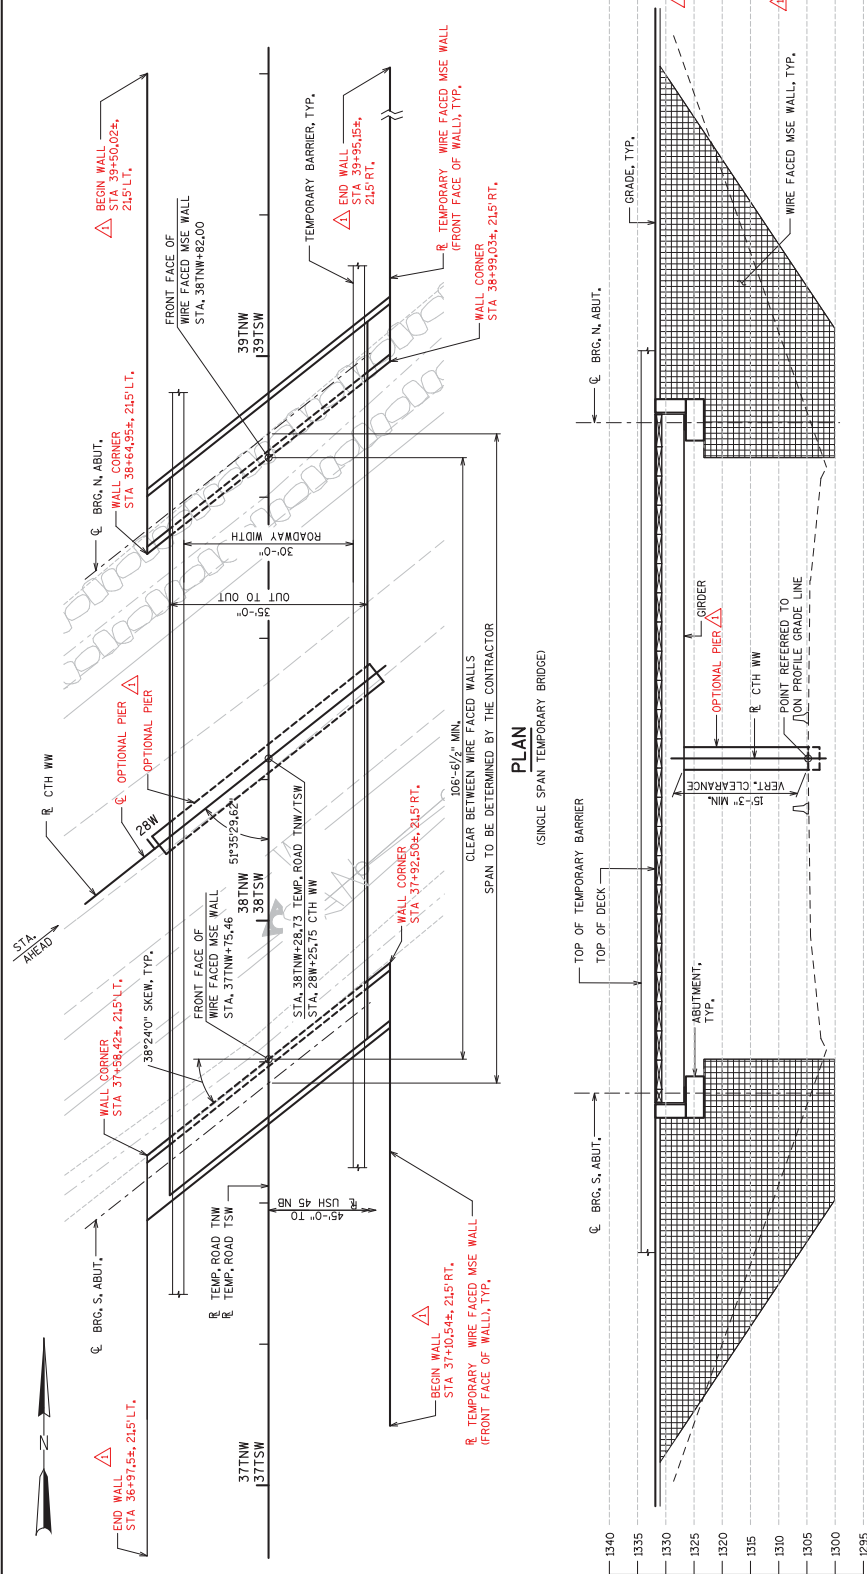

ADDENDUM NO. 02
 ID 1170-00-74
 Revised Sheet 211
 January 8, 2016

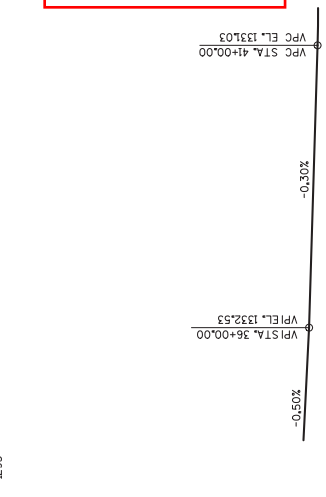

William C. Decker BAR 01/08/16

NO.	DATE	REVISION	BY
1	1/7/2016	TEMP. WIRE WALL LAYOUT ADDED	BOT

STATE OF WISCONSIN
 DEPARTMENT OF TRANSPORTATION

STRUCTURE B-37-158
 DRAWN BY: [Name]
 CHECKED BY: JRS/BOT

TEMPORARY STRUCTURE (1 OF 2)

SHEET 5 OF 16

211

Addendum No. 02
ID 1170-00-74
Added Sheet 211A
January 8, 2016


STATE PROJECT NUMBER
1170-00-74

NOTES

PLANS, ELEVATIONS, AND DETAILS SHOWN ON THESE DRAWINGS ARE INTENDED TO INDICATE WALL LOCATIONS, LENGTHS, HEIGHTS, AND BACKFILL MATERIALS. VERIFY THAT THE WALL SYSTEM SELECTED WILL CONFORM TO THE REQUIRED ALIGNMENTS AND DETAILS.

THE MAXIMUM VALUE OF THE ANGLE OF INTERNAL FRICTION OF THE WALL BACKFILL MATERIAL IN THE REINFORCED ZONE SHALL BE ASSUMED TO BE 30° WITHOUT CERTIFIED TEST VALUES.

DESIGN THE MSE WALL FOR THE LOADS TRANSFERRED BY THE TEMPORARY BRIDGE AND A LIVE LOAD SURCHARGE OF 240 FSF.

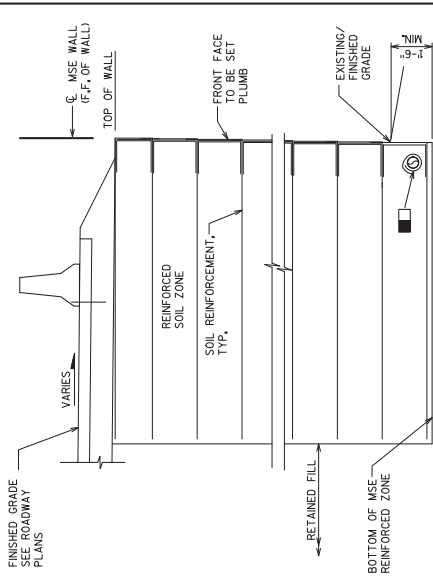

SECTION THRU TEMPORARY WIRE FACED MSE WALL
(AT TEMPORARY BRIDGE APPROACH)




NO.	DATE	REVISION	BY
1/7/2016		NEW SHEET	BOT

STATE OF WISCONSIN
DEPARTMENT OF TRANSPORTATION

STRUCTURE B-37-158
DRAWN BY: TAL
CHECKED BY: JRS/BOT

SHEET 5A OF 16
TEMPORARY STRUCTURE (2 OF 2)
211A

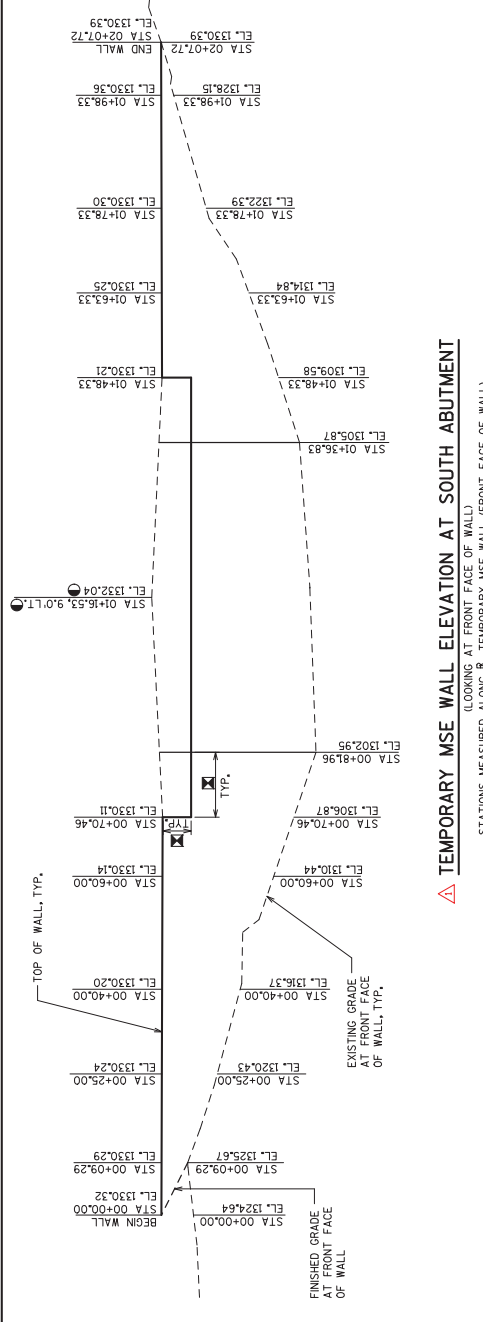


TEMPORARY MSE WALL ELEVATION AT SOUTH ABUTMENT
(LOOKING AT FRONT FACE OF WALL)

SOIL PARAMETERS- BORING 10

SOIL DESCRIPTION	BOTTOM ELEVATION (FT)	SOIL UNIT WEIGHT (PCF)	ESTIMATED COHESION (PCF)	ESTIMATED FRICTION ANGLE (DEGREES)
FILL MATERIAL: LEAN CLAY WITH MUCKY TOP SOIL	1303.1	120	IGNORE	10
FILL MATERIAL: LEAN CLAY	1300.8	130	1,000	5
FILL MATERIAL: SILTY CLAY	1297.8	126	800	15
NATIVE POORLY GRADED GRAVEL WITH SILT AND SAND	1295.3	1315	2,000	38
GRANITE	1294.5	140	0	43

SOIL PARAMETERS- BORING 11

SOIL DESCRIPTION	BOTTOM ELEVATION (FT)	SOIL UNIT WEIGHT (PCF)	ESTIMATED COHESION (PCF)	ESTIMATED FRICTION ANGLE (DEGREES)
BASE COURSE MATERIAL: SILTY SAND WITH GRAVEL	1304.6	130	0	30
NATIVE SANDY SILT	1300.8	137.4	0	31
NATIVE SANDY SILT	1300.2	138 (SATURATED)	0	31
NATIVE SILTY SAND WITH GRAVEL	1298.9	140 (SATURATED)	0	31
NATIVE SILTY GRAVEL WITH SAND	1297.4	140 (SATURATED)	0	37

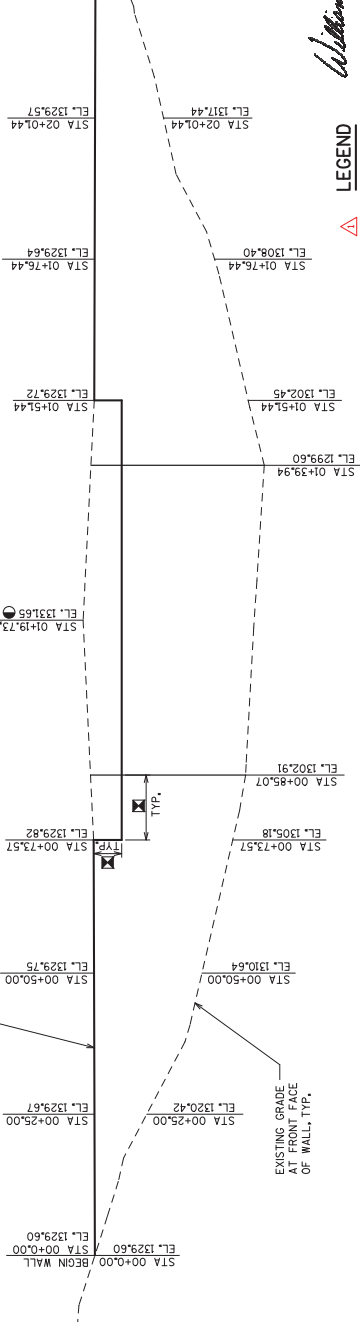

TEMPORARY MSE WALL ELEVATION AT NORTH ABUTMENT
(LOOKING AT FRONT FACE OF WALL)

LEGEND


- STATIONS AND ELEVATIONS AT PAVING BLOCK CORNER FOR A BACK TO BACK DIMENSION OF 2'-6" BETWEEN PAVING BLOCKS. MODIFY THESE VALUES FOR THE ACTUAL BACK TO BACK DIMENSION BETWEEN PAVING BLOCKS, AFTER DESIGNING THE TEMPORARY STRUCTURE.
- THESE DIMENSIONS TO BE DETERMINED BY THE CONTRACTOR AFTER DESIGNING THE TEMPORARY STRUCTURE.
- PIPE UNDERDRAIN WRAPPED 6'- INCH SLOPE 0.5% MIN. TO SUITABLE DRAINAGE.

William C. Decker, P.E. 01/08/16

NOTES

THE SUBSURFACE INFORMATION PRESENTED HEREIN IS AN ABBREVIATED VERSION OF THE INFORMATION PRESENTED IN THE GEOTECHNICAL ENGINEERING REPORT. REVIEW THE APPROPRIATE GEOTECHNICAL REPORT AND SOIL BORING LOGS FOR ADDITIONAL SUBSURFACE INFORMATION.

○ DENOTES SOIL BORING LOCATION
 SOIL BORINGS COMPLETED BY:
 SOILS AND ENGINEERING SERVICES, INC.
 SOIL BORINGS TAKEN:
 JULY 1 AND JULY 2, 2013

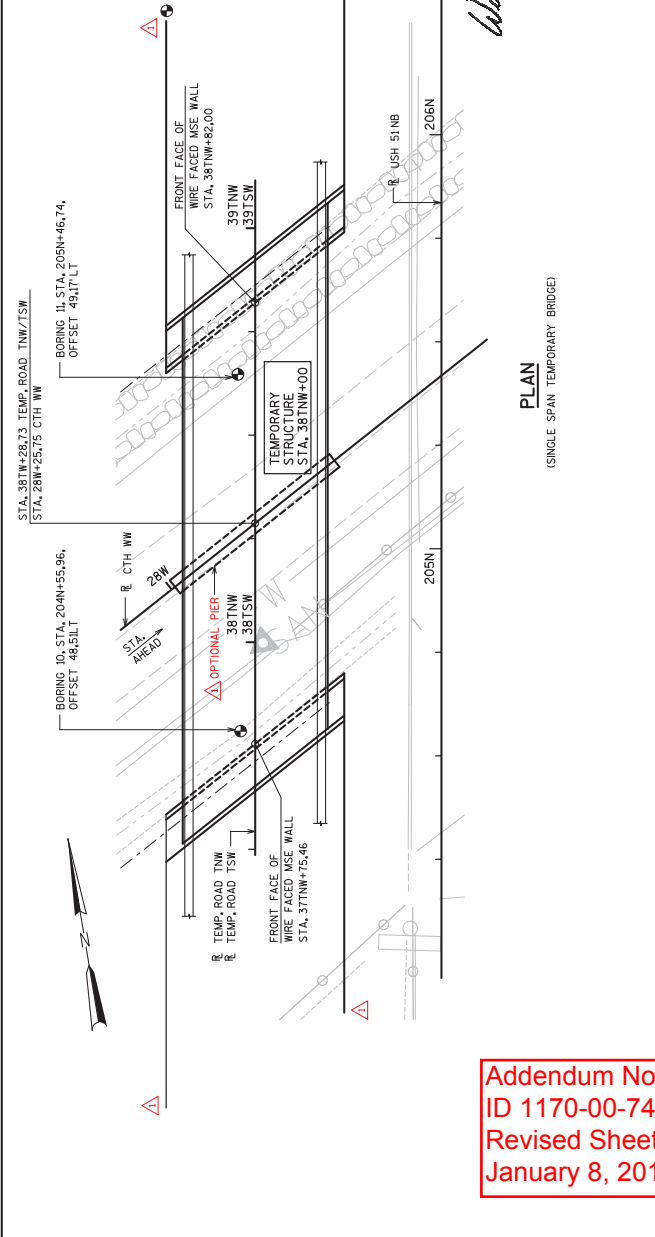


**Addendum No. 02
 ID 1170-00-74
 Revised Sheet 212
 January 8, 2016**

William C. Decker **EAR 01/08/16**

WISCONSIN PROFESSIONAL ENGINEER
 BARU D. HENGAMAKUNNEL
 E-38985
 MILWAUKEE, WI
 1-7-2-016

STATE PROJECT NUMBER 1170-00-74	ABBREVIATIONS F — FINE WS — WEATHERED M — MEDIUM SO — SOUND C — COARSE
MATERIAL SYMBOLS TOPSOIL SAND GRAVEL SANDSTONE LIMESTONE IGNEOUS ROCK	LEGEND OF PROBING PROBING NO., STA., ELEVATION 96/6 RE BLOWS FOR 6" PENETRATION PROBING TAKEN WITH FALLING 30" ON A 2" O.D. POINT.
LEGEND OF BORINGS ELEV., BORING NO., STA., UNCONFINED STRENGTH (7.7) KIP/FT. FALLING 30" WASH SAMPLE SHELBY TUBE — S.T. GROUND WATER ELEVATION NO GROUND WATER OBSERVED ABOVE THIS ELEVATION SILTY CLAY SO LIMESTONE	REFUSAL 95/6 UNLESS OTHERWISE SPECIFIED, THE BLOWS PER FOOT AT THE LOCATIONS INDICATED ARE BASED ON DRIVING A 2" O.D. X 14" I.D. SPLIT SPOON SAMPLER WITH A 140° POINT. THE POINT OF THE SPOON SAMPLER IS TO BE COUNT IS TAKEN IN UNDISTURBED SOIL IMMEDIATELY BELOW A CASED OR OPEN HOLE ELIMINATING SIDE FRICTION ON THE DRIVE PIPE. SUBSURFACE EXPLORATION FOR FOUNDATION DESIGN AND BIDDERS INFORMATION TO OBTAIN RELATIVE DATA CONCERNING THE CHARACTER OF MATERIAL IN AND UPON WHICH THE FOUNDATION MIGHT BE BUILT, BORINGS AND/OR SOUNDINGS WERE MADE AT POINTS APPROXIMATELY AS INDICATED ON THIS PLAN. THE DEPTHS OF THE SUBSURFACE EXPLORATIONS WERE LIMITED, HOWEVER, BECAUSE THE DEPTHS INVESTIGATED ARE LIMITED AND THE AREA OF THE BORINGS AND/OR SOUNDINGS IS LIMITED. THE WISCONSIN DEPARTMENT OF TRANSPORTATION DOES NOT WARRANT CONDITIONS BELOW THE DEPTHS INDICATED OR THESE INVESTIGATIONS IS NECESSARILY TYPICAL OF THE ENTIRE SITE.

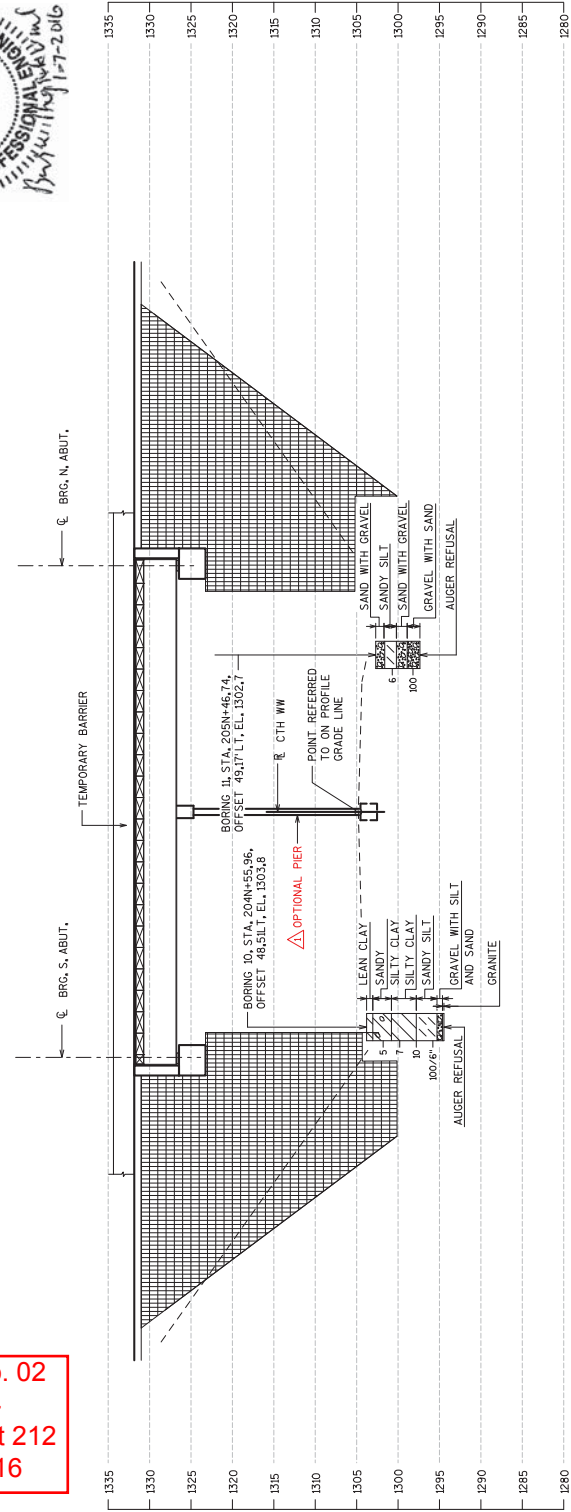

ELEVATION
(LOOKING WEST)

DATE	REVISION	BY	BDD
1/7/2016	TEMP. STRUCTURE LAYOUT REVISED		
STATE OF WISCONSIN DEPARTMENT OF TRANSPORTATION			
STRUCTURE B-37-158			
DRAWN BY	CHECKED BY	DATE	
JRS	JRS/BDD	1/7/2016	
SUBSURFACE EXPLORATION			212
SHEET 6 OF 16			

SCHEDULE OF ITEMS

REVISED:

CONTRACT:
20160112023

PROJECT(S):
1170-00-74

FEDERAL ID(S):
WISC 2016036

CONTRACTOR : _____

LINE NO	ITEM DESCRIPTION	APPROX. QUANTITY AND UNITS	UNIT PRICE		BID AMOUNT	
			DOLLARS	CTS	DOLLARS	CTS

SECTION 0001 Roadway Items

0010	201.0120 Clearing	90.000 ID
0020	201.0220 Grubbing	90.000 ID
0030	203.0200 Removing Old Structure (station) 01. 113N+60	LUMP	LUMP	.	.	.
0040	203.0200 Removing Old Structure (station) 02. 205N+50	LUMP	LUMP	.	.	.
0050	203.0200 Removing Old Structure (station) 03. 205s+00	LUMP	LUMP	.	.	.
0060	203.0225.S Debris Containment (structure) 01. B-37-155	LUMP	LUMP	.	.	.
0070	203.0225.S Debris Containment (structure) 02. B-37-158	LUMP	LUMP	.	.	.
0080	203.0225.S Debris Containment (structure) 03. B-37-159	LUMP	LUMP	.	.	.
0090	204.0100 Removing Pavement	870.000 SY
0100	204.0115 Removing Asphaltic Surface Butt Joints	51.000 SY

SCHEDULE OF ITEMS

REVISED:

CONTRACT:
20160112023PROJECT(S):
1170-00-74FEDERAL ID(S):
WISC 2016036

CONTRACTOR : _____

LINE NO	ITEM DESCRIPTION	APPROX. QUANTITY AND UNITS	UNIT PRICE		BID AMOUNT	
			DOLLARS	CTS	DOLLARS	CTS
0110	204.0120 Removing Asphaltic Surface Milling	16,640.000 SY
0120	204.0165 Removing Guardrail	1,065.000 LF
0130	204.0190 Removing Surface Drains	1.000 EACH
0140	204.0210 Removing Manholes	2.000 EACH
0150	204.0220 Removing Inlets	6.000 EACH
0160	204.0245 Removing Storm Sewer (size) 01. 12-Inch	266.800 LF
0170	204.9060.S Removing (item description) 01. Apron Endwalls	8.000 EACH
0180	205.0100 Excavation Common	37,233.000 CY
0190	205.0200 Excavation Rock	1,950.000 CY
0200	206.1000 Excavation for Structures Bridges (structure) 01. B-37-155	LUMP	LUMP	.	.	.

SCHEDULE OF ITEMS

REVISED:

CONTRACT:
20160112023PROJECT(S):
1170-00-74FEDERAL ID(S):
WISC 2016036

CONTRACTOR : _____

LINE NO	ITEM DESCRIPTION	APPROX. QUANTITY AND UNITS	UNIT PRICE		BID AMOUNT	
			DOLLARS	CTS	DOLLARS	CTS
0210	206.1000 Excavation for Structures Bridges (structure) 02. B-37-158	LUMP	LUMP			.
0220	206.1000 Excavation for Structures Bridges (structure) 03. B-37-159	LUMP	LUMP			.
0230	208.0100 Borrow	20,307.000 CY		.		.
0240	210.0100 Backfill Structure	192.000 CY		.		.
0250	211.0400 Prepare Foundation for Asphaltic Shoulders	19.000 STA		.		.
0260	213.0100 Finishing Roadway (project) 01. 1170-00-74	1.000 EACH		.		.
0270	305.0110 Base Aggregate Dense 3/4-Inch	1,405.000 TON		.		.
0280	305.0120 Base Aggregate Dense 1 1/4-Inch	28,630.000 TON		.		.
0290	415.0100 Concrete Pavement 10-Inch	760.000 SY		.		.
0300	415.0410 Concrete Pavement Approach Slab	842.000 SY		.		.

SCHEDULE OF ITEMS

REVISED:

CONTRACT:
20160112023PROJECT(S):
1170-00-74FEDERAL ID(S):
WISC 2016036

CONTRACTOR : _____

LINE NO	ITEM DESCRIPTION	APPROX. QUANTITY AND UNITS	UNIT PRICE		BID AMOUNT	
			DOLLARS	CTS	DOLLARS	CTS
0310	416.1010 Concrete Surface Drains	5.000 CY
0320	455.0105 Asphaltic Material PG58-28	570.000 TON
0330	455.0605 Tack Coat	3,720.000 GAL
0340	460.1103 HMA Pavement Type E-3	8,230.000 TON
0350	460.1110 HMA Pavement Type E-10	1,270.000 TON
0360	460.2000 Incentive Density HMA Pavement	580.000 DOL	1.00000	.	580.00	.
0370	460.4000 HMA Cold Weather Paving	840.000 TON
0380	460.4110.S Reheating HMA Pavement Longitudinal Joints	4,100.000 LF
0390	465.0400 Asphaltic Shoulder Rumble Strips	9,820.000 LF
0400	502.0100 Concrete Masonry Bridges	1,534.000 CY
0410	502.3100 Expansion Device (structure) 01. B-37-158	LUMP	LUMP	.	.	.

SCHEDULE OF ITEMS

REVISED:

CONTRACT:
20160112023PROJECT(S):
1170-00-74FEDERAL ID(S):
WISC 2016036

CONTRACTOR : _____

LINE NO	ITEM DESCRIPTION	APPROX. QUANTITY AND UNITS	UNIT PRICE		BID AMOUNT	
			DOLLARS	CTS	DOLLARS	CTS
0420	502.3100 Expansion Device (structure) 02. B-37-159	LUMP	LUMP			.
0430	502.3200 Protective Surface Treatment	87.000 SY		.		.
0440	502.3210 Pigmented Surface Sealer	621.000 SY		.		.
0450	502.5002 Masonry Anchors Type L No. 4 Bars	27.000 EACH		.		.
0460	502.5005 Masonry Anchors Type L No. 5 Bars	390.000 EACH		.		.
0470	502.6110 Masonry Anchors Type S 3/4-Inch	11.000 EACH		.		.
0480	505.0600 Bar Steel Reinforcement HS Coated Structures	325,770.000 LB		.		.
0490	505.0800.S Bar Steel Reinforcement HS Stainless Structures	4,720.000 LB		.		.
0500	505.0904 Bar Couplers No. 4	16.000 EACH		.		.
0510	505.0905 Bar Couplers No. 5	531.000 EACH		.		.
0520	505.0906 Bar Couplers No. 6	24.000 EACH		.		.

SCHEDULE OF ITEMS

REVISED:

CONTRACT:
20160112023

PROJECT(S):
1170-00-74

FEDERAL ID(S):
WISC 2016036

CONTRACTOR : _____

LINE NO	ITEM DESCRIPTION	APPROX. QUANTITY AND UNITS	UNIT PRICE		BID AMOUNT	
			DOLLARS	CTS	DOLLARS	CTS
0530	505.0908 Bar Couplers No. 8	24.000 EACH	.		.	
0540	506.4000 Steel Diaphragms (structure) 01. B-37-155	14.000 EACH	.		.	
0550	509.5100.S Polymer Overlay	3,867.000 SY	.		.	
0560	516.0500 Rubberized Membrane Waterproofing	58.000 SY	.		.	
0570	517.0900.S Preparation and Coating of Top Flanges (structure) 01. B-37-158	LUMP	LUMP		.	
0580	517.0900.S Preparation and Coating of Top Flanges (structure) 02. B-37-159	LUMP	LUMP		.	
0590	517.1800.S Structure Repainting Recycled Abrasive (structure) 01. B-37-158	LUMP	LUMP		.	
0600	517.1800.S Structure Repainting Recycled Abrasive (structure) 02. B-37-159	LUMP	LUMP		.	
0610	517.4500.S Negative Pressure Containment and Collection of Waste Materials (structure) 01. B-37-158	LUMP	LUMP		.	

SCHEDULE OF ITEMS

REVISED:

CONTRACT:
20160112023PROJECT(S):
1170-00-74FEDERAL ID(S):
WISC 2016036

CONTRACTOR : _____

LINE NO	ITEM DESCRIPTION	APPROX. QUANTITY AND UNITS	UNIT PRICE		BID AMOUNT	
			DOLLARS	CTS	DOLLARS	CTS
0620	517.4500.S Negative Pressure Containment and Collection of Waste Materials (structure) 02. B-37-159	LUMP	LUMP			.
0630	517.6001.S Portable Decontamination Facility	EACH	2.000	.		.
0640	520.8000 Concrete Collars for Pipe	EACH	1.000	.		.
0650	521.1012 Apron Endwalls for Culvert Pipe Steel 12-Inch	EACH	1.000	.		.
0660	522.0312 Culvert Pipe Reinforced Concrete Class IV 12-Inch	LF	236.800	.		.
0670	522.1012 Apron Endwalls for Culvert Pipe Reinforced Concrete 12-Inch	EACH	7.000	.		.
0680	522.1024 Apron Endwalls for Culvert Pipe Reinforced Concrete 24-Inch	EACH	1.000	.		.
0690	603.8000 Concrete Barrier Temporary Precast Delivered	LF	14,425.000	.		.
0700	603.8125 Concrete Barrier Temporary Precast Installed	LF	36,495.000	.		.
0710	604.9015.S Reseal Crushed Aggregate Slope Paving	SY	2,303.000	.		.

SCHEDULE OF ITEMS

REVISED:

CONTRACT:
20160112023PROJECT(S):
1170-00-74FEDERAL ID(S):
WISC 2016036

CONTRACTOR : _____

LINE NO	ITEM DESCRIPTION	APPROX. QUANTITY AND UNITS	UNIT PRICE		BID AMOUNT	
			DOLLARS	CTS	DOLLARS	CTS
0720	606.0200 Riprap Medium	3.000 CY	.		.	
0730	611.0600 Inlet Covers Type A	1.000 EACH	.		.	
0740	611.0642 Inlet Covers Type MS	2.000 EACH	.		.	
0750	611.2004 Manholes 4-FT Diameter	2.000 EACH	.		.	
0760	611.3220 Inlets 2x2-FT	1.000 EACH	.		.	
0770	611.3901 Inlets Median 1 Grate	2.000 EACH	.		.	
0780	611.8115 Adjusting Inlet Covers	2.000 EACH	.		.	
0790	611.8120.S Cover Plates Temporary	2.000 EACH	.		.	
0800	611.9710 Salvaged Inlet Covers	2.000 EACH	.		.	
0810	614.0150 Anchor Assemblies for Steel Plate Beam Guard	6.000 EACH	.		.	
0820	614.0905 Crash Cushions Temporary	7.000 EACH	.		.	

SCHEDULE OF ITEMS

REVISED:

CONTRACT:
20160112023PROJECT(S):
1170-00-74FEDERAL ID(S):
WISC 2016036

CONTRACTOR : _____

LINE NO	ITEM DESCRIPTION	APPROX. QUANTITY AND UNITS	UNIT PRICE		BID AMOUNT	
			DOLLARS	CTS	DOLLARS	CTS
0830	614.2300 MGS Guardrail 3	665.000				
		LF	.		.	
0840	614.2500 MGS Thrie Beam Transition	234.000				
		LF	.		.	
0850	614.2610 MGS Guardrail Terminal EAT	2.000				
		EACH	.		.	
0860	618.0100 Maintenance And Repair of Haul Roads (project) 01. 1170-00-74	1.000				
		EACH	.		.	
0870	619.1000 Mobilization	1.000				
		EACH	.		.	
0880	624.0100 Water	990.000				
		MGAL	.		.	
0890	625.0100 Topsoil	46,500.000				
		SY	.		.	
0900	627.0200 Mulching	46,500.000				
		SY	.		.	
0910	628.1504 Silt Fence	5,680.000				
		LF	.		.	
0920	628.1520 Silt Fence Maintenance	5,680.000				
		LF	.		.	
0930	628.1905 Mobilizations Erosion Control	6.000				
		EACH	.		.	

SCHEDULE OF ITEMS

REVISED:

CONTRACT:
20160112023PROJECT(S):
1170-00-74FEDERAL ID(S):
WISC 2016036

CONTRACTOR : _____

LINE NO	ITEM DESCRIPTION	APPROX. QUANTITY AND UNITS	UNIT PRICE		BID AMOUNT	
			DOLLARS	CTS	DOLLARS	CTS
0940	628.1910 Mobilizations Emergency Erosion Control	6.000 EACH	.		.	
0950	628.7005 Inlet Protection Type A	6.000 EACH	.		.	
0960	628.7504 Temporary Ditch Checks	2,890.000 LF	.		.	
0970	628.7555 Culvert Pipe Checks	55.000 EACH	.		.	
0980	628.7570 Rock Bags	15.000 EACH	.		.	
0990	629.0210 Fertilizer Type B	41.000 CWT	.		.	
1000	630.0130 Seeding Mixture No. 30	1,155.000 LB	.		.	
1010	633.0100 Delineator Posts Steel	8.000 EACH	.		.	
1020	633.0500 Delineator Reflectors	8.000 EACH	.		.	
1030	633.5200 Markers Culvert End	2.000 EACH	.		.	
1040	638.2602 Removing Signs Type II	4.000 EACH	.		.	

SCHEDULE OF ITEMS

REVISED:

CONTRACT:
20160112023PROJECT(S):
1170-00-74FEDERAL ID(S):
WISC 2016036

CONTRACTOR : _____

LINE NO	ITEM DESCRIPTION	APPROX. QUANTITY AND UNITS	UNIT PRICE		BID AMOUNT	
			DOLLARS	CTS	DOLLARS	CTS
1050	638.3000 Removing Small Sign Supports	4.000 EACH
1060	642.5001 Field Office Type B	1.000 EACH
1070	643.0100 Traffic Control (project) 01. 1170-00-74	1.000 EACH
1080	643.0300 Traffic Control Drums	48,300.000 DAY
1090	643.0420 Traffic Control Barricades Type III	2,455.000 DAY
1100	643.0500 Traffic Control Flexible Tubular Marker Posts	100.000 EACH
1110	643.0600 Traffic Control Flexible Tubular Marker Bases	100.000 EACH
1120	643.0705 Traffic Control Warning Lights Type A	9,030.000 DAY
1130	643.0715 Traffic Control Warning Lights Type C	4,985.000 DAY
1140	643.0800 Traffic Control Arrow Boards	405.000 DAY
1150	643.0900 Traffic Control Signs	11,155.000 DAY

SCHEDULE OF ITEMS

REVISED:

CONTRACT:
20160112023PROJECT(S):
1170-00-74FEDERAL ID(S):
WISC 2016036

CONTRACTOR : _____

LINE NO	ITEM DESCRIPTION	APPROX. QUANTITY AND UNITS	UNIT PRICE		BID AMOUNT	
			DOLLARS	CTS	DOLLARS	CTS
1160	643.0910 Traffic Control Covering Signs Type I	2.000 EACH
1170	643.0920 Traffic Control Covering Signs Type II	4.000 EACH
1180	643.1050 Traffic Control Signs PCMS	460.000 DAY
1190	643.2000 Traffic Control Detour (project) 01. 1170-00-74	1.000 EACH
1200	643.3000 Traffic Control Detour Signs	4,366.000 DAY
1210	645.0120 Geotextile Fabric Type HR	28.000 SY
1220	646.0106 Pavement Marking Epoxy 4-Inch	33,000.000 LF
1230	646.0126 Pavement Marking Epoxy 8-Inch	350.000 LF
1240	646.0600 Removing Pavement Markings	6,200.000 LF
1250	646.0841.S Pavement Marking Grooved Wet Reflective Contrast Tape 4-Inch	425.000 LF

SCHEDULE OF ITEMS

REVISED:

CONTRACT:
20160112023PROJECT(S):
1170-00-74FEDERAL ID(S):
WISC 2016036

CONTRACTOR : _____

LINE NO	ITEM DESCRIPTION	APPROX. QUANTITY AND UNITS	UNIT PRICE		BID AMOUNT	
			DOLLARS	CTS	DOLLARS	CTS
1260	646.0881.S Pavement Marking Grooved Wet Reflective Tape 4-Inch	3,015.000 LF
1270	647.0166 Pavement Marking Arrows Epoxy Type 2	2.000 EACH
1280	647.0356 Pavement Marking Words Epoxy	1.000 EACH
1290	647.0955 Removing Pavement Markings Arrows	1.000 EACH
1300	649.0400 Temporary Pavement Marking Removable Tape 4-Inch	20,565.000 LF
1310	649.0402 Temporary Pavement Marking Paint 4-Inch	22,400.000 LF
1320	649.0801 Temporary Pavement Marking Removable Tape 8-Inch	2,220.000 LF
1330	650.4000 Construction Staking Storm Sewer	16.000 EACH
1340	650.4500 Construction Staking Subgrade	7,143.000 LF
1350	650.5000 Construction Staking Base	11,544.000 LF

SCHEDULE OF ITEMS

REVISED:

CONTRACT:
20160112023PROJECT(S):
1170-00-74FEDERAL ID(S):
WISC 2016036

CONTRACTOR : _____

LINE NO	ITEM DESCRIPTION	APPROX. QUANTITY AND UNITS	UNIT PRICE		BID AMOUNT	
			DOLLARS	CTS	DOLLARS	CTS
1360	650.6500 Construction Staking Structure Layout (structure) 01. B-37-155	LUMP	LUMP			.
1370	650.6500 Construction Staking Structure Layout (structure) 02. B-37-158	LUMP	LUMP			.
1380	650.6500 Construction Staking Structure Layout (structure) 03. B-37-159	LUMP	LUMP			.
1390	650.7000 Construction Staking Concrete Pavement	LF	320.000	.		.
1400	650.8000 Construction Staking Resurfacing Reference	LF	1,330.000	.		.
1410	650.9910 Construction Staking Supplemental Control (project) 01. 1170-00-74	LUMP	LUMP			.
1420	650.9920 Construction Staking Slope Stakes	LF	7,143.000	.		.
1430	690.0150 Sawing Asphalt	LF	7,300.000	.		.
1440	690.0250 Sawing Concrete	LF	277.000	.		.
1450	715.0415 Incentive Strength Concrete Pavement	DOL	500.000	1.00000		500.00

SCHEDULE OF ITEMS

REVISED:

CONTRACT:
20160112023PROJECT(S):
1170-00-74FEDERAL ID(S):
WISC 2016036

CONTRACTOR : _____

LINE NO	ITEM DESCRIPTION	APPROX. QUANTITY AND UNITS	UNIT PRICE		BID AMOUNT	
			DOLLARS	CTS	DOLLARS	CTS
1460	715.0502 Incentive Strength Concrete Structures	9,204.000 DOL	1.00000		9204.00	
1470	ASP.1T0A On-the-Job Training Apprentice at \$5.00/HR	2,400.000 HRS	5.00000		12000.00	
1480	ASP.1T0G On-the-Job Training Graduate at \$5. 00/HR	2,760.000 HRS	5.00000		13800.00	
1490	SPV.0045 Special 01. Portable Changeable Message Sign (Pcms) Cellular Communications	460.000 DAY				
1500	SPV.0060 Special 01. Concrete Riser For Inlet Median	2.000 EACH				
1510	SPV.0060 Special 04. Abutment End Repair	3.000 EACH				
1520	SPV.0060 Special 05. Cleaning And Painting Bearings	44.000 EACH				
1530	SPV.0090 Special 01. Salvage and Reinstall Beamguard	805.000 LF				
1540	SPV.0105 Special 02. Temporary Structure Station 38TNW+00	LUMP	LUMP			
1550	415.0090 Concrete Pavement 9-Inch	110.000 SY				
	SECTION 0001 TOTAL					
	TOTAL BID					