



# Wisconsin Department of Transportation

June 07, 2016

## Division of Transportation Systems Development

Bureau of Project Development  
4802 Sheboygan Avenue, Rm 601  
P O Box 7916  
Madison, WI 53707-7916

Telephone: (608) 266-1631  
Facsimile (FAX): (608) 266-8459

### NOTICE TO ALL CONTRACTORS:

**Proposal #03: 1003-10-74**  
**Illinois State Line – Madison**  
**Madison Creek Road Bridge**  
**B-53-0316**  
**IH 39**  
**Rock County**

**1003-10-77**  
**Illinois State Line – Madison**  
**CTH S to STH 11**  
**IH 39**  
**Rock County**

**1003-10-82**  
**Illinois State Line – Madison**  
**Stateline Rd Bridge B-53-0325**  
**IH 39**  
**Rock County**

**1003-10-75**  
**Illinois State Line – Madison**  
**Woodman Road Bridge**  
**B-53-0319**  
**IH 39**  
**Rock County**

**1003-10-78**  
**Illinois State Line – Madison**  
**Stateline Rd to CTH S**  
**IH 39**  
**Rock County**

### Letting of June 14, 2016

This is Addendum No. 01, which provides for the following:

#### Special Provisions

Added Special Provisions	
Article No.	Description
60	Geogrid Reinforcement, Item SPV.0180.001
61	Removing Billboard Sign and Sign Structure, Item SPV.0060.006

Deleted Special Provisions	
Article No.	Description
15	Concrete Pavements
33	Aggregate Quality Testing for Concrete Pavement and HPC Structure Mixes

## Schedule of Items

Revised Bid Item Quantities					
Bid Item	Item Description	Unit	Old Quantity	Revised Quantity	Proposal Total
205.0100	Excavation Common	CY	127,401	-696	126,345
305.0110	Base Aggregate Dense 3/4-Inch	TON	5,783	1,417	7,200
305.0120	Base Aggregate Dense 1 1/4-Inch	TON	182,875	13,096	195,971
312.0110	Select Crushed Material	TON	4,395	3,710	8,105
522.0118	Culvert Pipe Reinforced Concrete Class III 18-Inch	LF	112	6	118
522.1018	Apron Endwalls for Culvert Pipe Reinforced Concrete 18-Inch	EACH	25	-1	24
624.0100	Water	MGAL	5,060	27	5,087
SPV.0035.001	Roadway Embankment	CY	264,401	-27,018	237,383

Added Bid Item Quantities					
Bid Item	Item Description	Unit	Old Quantity	Revised Quantity	Proposal Total
208.1100	Select Borrow	CY	0	53,078	53,708
SPV.0060.010	Removing Billboards	EA	0	1	1
SPV.0180.001	Geogrid Reinforcement	SY	0	15,932	15,932

## Plan Sheets

Revised Plan Sheets	
Plan Sheet	Plan Sheet Title (brief description of changes to sheet)
<b>1003-10-74</b>	
12	Construction Details: Excavation Below Sub-grade – Revised Detail
57	Miscellaneous Quantities – updated Select Borrow and Geogrid Reinforcement
58	Miscellaneous Quantities – updated Select Crushed Material
59	Miscellaneous Quantities – updated Inlet Information
<b>1003-10-75</b>	
15	Construction Details: Excavation Below Sub-grade – Revised Detail
17	Construction Details: Removals Detail – Added call-out for Removing Billboard with Station and Offset.
75	Miscellaneous Quantities, Earthwork – Revised to show EBS quantity for Woodman Road and new totals for Common Excavation and Roadway Embankment. Added Select Borrow quantity.
84	Miscellaneous Quantities, Removing Billboards – Added quantity table for removing billboards and Geo-grid Reinforcement.
162	Earth Work Data: Woodman Road – Revised to add EBS for Woodman Road.
164-175	Cross-sections: Woodman Road – Revised to show tick markers for the proposed right-of-way at the correct locations.
<b>1003-10-77</b>	
1	Title Sheet – added Exception to Centerline and changed stationing and Total Net Length of CL
12	Construction Details – Temporary Emergency Pullouts – removed text
14	Construction Details – detail for Excavation Below Subgrade change
15	Construction Details – Concrete Pavement Replacement/Repair SHES updated detail

29, 30	Erosion Control Plan – whole plan sheet changes
60 - 64	Miscellaneous Quantities – updates to quantities/whole plan sheet changes
73	Miscellaneous Quantities – added Geogrid Reinforcement table to sheet
76	Plan & Profile: CTH S On Ramp – text changes for special drawing at berm and finished profile
77	Plan & Profile: IH 39 – text changes for special drawing at berm and finished profile
206 - 214	Cross-sections – Revised to match lines at the correct locations.
225	Cross-sections – text changes at STA 356+85
<b>1003-10-78</b>	
10	Construction Details – Detail for Excavation Below Subgrade change
12	Removing Rumble Strips – Detail “A” change
34	Miscellaneous Quantities – Update Select Borrow to Earthwork and Note changes
35	Miscellaneous Quantities – Update BAD ¾-INCH & 1 1/4-INCH
42	Miscellaneous Quantities – Added Geogrid Reinforcement Table to sheet
<b>1003-10-82</b>	
12	Construction Details – Detail for Excavation Below Subgrade change
119	Miscellaneous Quantities – Update Select Borrow to Earthwork and Note changes
120	Miscellaneous Quantities – Removed Select Crushed Material from BAD spreadsheet
127	Miscellaneous Quantities – Added Geogrid Reinforcement Table to sheet

The responsibility for notifying potential subcontractors and suppliers of these changes remains with the prime contractor.

Sincerely,

*Mike Coleman*

Proposal Development Specialist  
Proposal Management Section

**ADDENDUM NO. 01**

**1003-10-74, 1003-10-75, 1003-10-77, 1003-10-78, and 1003-10-82**

**June 07, 2016**

**Special Provisions**

15. **DELETED**

33. **DELETED**

60. **Geogrid Reinforcement, Item SPV.0180.001.**

**A Description**

This special provision describes furnishing and installing geogrids for subgrade stabilization, base reinforcement, or pavement structure applications as directed by the engineer in accordance to section 645 of the standard specifications and as hereinafter provided.

**B Materials**

Provide geogrid that consists of either single or joined multiple layers of a uniform rectangular grid of bonded, formed, or fused polymer tensile strands crossing with a nominal right angle orientation. The polymer shall consist of polyester, polypropylene, polyamide, or polyethylene. The grid shall maintain dimensional stability during handling, placing, and installation. The geogrid shall be insect, rodent, mildew, and rot resistant. Minimum geogrid width shall be 6.0 feet.

Provide geogrid that complies with the following physical properties:

<b>Test</b>	<b>Method</b>	<b>Value<sup>(1)</sup></b>
Tensile Strength at 5% Strain, Both Principal Directions (lb/ft)	ASTM D 4595 <sup>(2)</sup>	450 min.
Flexural Rigidity Both Principal Directions (mg-cm)	ASTM D 1388 <sup>(3)</sup>	150,000 min.
Aperture Area (in <sup>2</sup> )	Inside Measurement <sup>(4)</sup>	5.0 max.
Aperture Dimension (in)	Inside Measurement <sup>(4)</sup>	0.5 min.

(1) All numerical values represent minimum/maximum average roll values, i.e. the average minimum test results on any roll in a lot shall meet or exceed the minimum specified value.

(2) The tensile strength (T) of a joined multi-layered geogrid shall be computed using the following equation:

$$T = n(f) t$$

where

n = the number of individual layers in the joined multi-layered geogrid,

t = the tensile strength of a single layer of geogrid as determined using testing method ASTM D4595, and

f = reduction factor based on the number of layers comprising the multi-layered system and determined by the equation  $f=1.00 - [0.04(n-1)]$

(3) Values shall be determined by Option "A" (Cantilever Test) of testing method ASTM D1388 using test specimens that are 36 inches  $\pm 0.04$  inch long. Test specimen widths for differing geogrids shall be variable and equal to 1 element plus 1/2 the aperture width on both sides of the element. An element is defined as the minimum number of parallel strands that form a distinguishable repeating pattern.

(4) Aperture Area and Aperture Dimension for joined multi-layered geogrids shall be determined based on measurement of a single layer of geogrid.

Protect the geogrid from ultraviolet radiation and from damage due to shipping and handling. Keep the geogrid dry until it is installed. The geogrid rolls shall be clearly marked to identify the material contained.

Deliver a sample of the geogrid material to the engineer at least 10 days prior to its incorporation into the work. At the same time, furnish a manufacturer's Certified Report of Test or Analysis that verifies that the geogrid delivered for use on the work meets the above requirements. Samples of geogrid for test purposes will be obtained from the job site for each 10,000 square yards or portions thereof used on the contract.

**C Construction**

Prior to placement of the geogrid, bring the indicated placement surface to the required lines, grades, and directed by the engineer. Smooth and shape the surface to eliminate any rocks, clods, roots, or other items that may cause damage to the geogrid during placement or covering.

Place the geogrid on the prepared surface at the locations and to the limits as directed by the engineer. After placement, pull the geogrid taut and secure it using pins, clips, staples, or other devices to prevent movement or displacement. Place parallel strips of geogrid with a minimum overlap of 6 inches. Lap butt joints between roll ends a minimum of 12 inches. Fasten all lapped sections together by using ties, straps, clips, or other devices to develop a secure joint that meets the approval of the engineer. No vehicles or construction equipment shall be permitted to operate directly on the geogrid.

Cover small rips, tears, or defects in the geogrid with an additional section of geogrid; secure the additional geogrid in place so that it overlaps the damaged area by at least 3 feet in all directions. Remove and replace geogrid sections with large rips, tears, defects, or other damage at the direction of the engineer. All costs to repair or replace damaged or defective geogrid shall be the responsibility of the contractor.

After placement, cover the geogrid to the indicated depth with the type of material required on the plans or in the special provisions. Placing, spreading, and compacting of this material shall comply with the applicable sections of the standard specifications or special provisions except that the initial lift of material placed on the geogrid must be at least 4 inches. Place, spread, and compact the required backfill material so that the geogrid is not displaced or damaged. The engineer may require changes in equipment and/or operations to prevent such damage or displacement.

**D Measurement**

The department will measure Geogrid Reinforcement by the square yard upon which the geogrid has been placed and accepted.

**E Payment**

The department will pay for measured quantities at the contract unit price under the following bid item:

ITEM NUMBER	DESCRIPTION	UNIT
SPV.0180.001	Geogrid Reinforcement	SY

Payment is full compensation for furnishing, transporting, and installing the geogrid; and for furnishing and installing all devices and materials necessary to join or secure the geogrid in place

**61. Removing Billboard Sign and Sign Structure, Item SPV.0060.006.**

**A Description**

This special provision describes removing existing billboards and supports in accordance with the applicable sections of standard spec 638 and as hereinafter provided.

**B Materials (Vacant)**

**C Construction**

Remove the complete billboard unit including signs, supports, footings, ladders, walkways, electrical systems and all appurtenances from the locations designated on the plans. Excavate to remove the footings two (2) feet below the existing ground surface and provide adequate backfill and compaction of the removal area to eliminate settling. Restore the surface around the location to the same condition as surrounding area and as directed by the engineer. Billboards with multiple supports and signs at the same location, but not necessarily connected, will be considered one complete unit.

The contractor shall coordinate with electric utility owner for disconnection of the power service prior to removal of the billboard and billboard supports, if applicable. The power supply shall be removed to a location that allows safe termination and burying.

**D Measurement**

The department will measure Removing Billboards as each individual complete billboard unit removed, acceptably completed.

**E Payment**

The department will pay for measured quantities at the contract unit price under the following bid item:

ITEM NUMBER	DESCRIPTION	UNIT
SPV.0060.006	Removing Billboard Sign and Sign Structure	EACH

Payment is full compensation for removing the signs, supports, footings, ladders, walkways, electrical systems and all appurtenances associated with the billboard; for removal from the project site; for backfilling any necessary areas; coordination with utilities and following utility and OSHA removal requirements. Removed items are property of the contractor.

**Schedule of Items**

Attached, dated June 07, 2016, are the revised Schedule of Items Pages 3, 4, 8, 10, 11, 15, 23, and 26.

**Plan Sheets**

The following 8½ x 11-inch sheets are attached and made part of the plans for this proposal:

1003-10-74:  
Revised: 12, 57, 58, 59


1003-10-75:  
Revised: 15, 17, 75, 84, 162, 164-175

1003-10-77:  
Revised: 1, 12, 14, 15, 29, 30, 60-64, 73, 76, 77, 206-214, 225

1003-10-78:  
10, 12, 34, 35, 42

1003-10-82:  
12, 119, 120, 127

END OF ADDENDUM

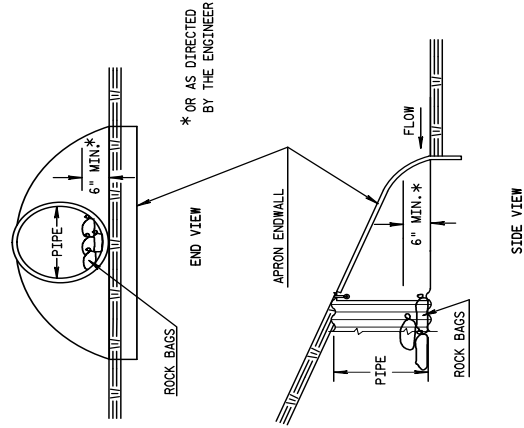


**CULVERT PIPE CHECK**

Addendum No. 01  
ID 1003-10-74  
Revised Sheet 12  
June 07, 2016

**RUNOFF COEFFICIENT TABLE**

LAND USE:	HYDROLOGIC SOIL GROUP											
	A			B			C			D		
	SLOPE RANGE (PERCENT)		SLOPE RANGE (PERCENT)	SLOPE RANGE (PERCENT)		SLOPE RANGE (PERCENT)	SLOPE RANGE (PERCENT)		SLOPE RANGE (PERCENT)	SLOPE RANGE (PERCENT)		SLOPE RANGE (PERCENT)
	0-2	2-6	6 & OVER	0-2	2-6	6 & OVER	0-2	2-6	6 & OVER	0-2	2-6	6 & OVER
ROW CROPS	.08	.16	.22	.12	.20	.27	.15	.24	.33	.19	.28	.38
	.22	.30	.38	.26	.34	.44	.30	.37	.50	.34	.41	.56
MEDIAN STRIP-TURF	.19	.20	.24	.19	.22	.26	.20	.23	.30	.20	.25	.30
	.24	.26	.30	.25	.28	.33	.26	.30	.37	.27	.32	.40
SIDE SLOPE-TURF			.25			.27			.28			.30
			.32			.34			.36			.38
PAVEMENT:												
ASPHALT	.70 - .95											
CONCRETE	.80 - .95											
BRICK	.70 - .80											
DRIVES, WALKS	.75 - .85											
ROOFS	.75 - .95											
GRAVEL ROADS, SHOULDERS	.40 - .60											

SB  
PVL

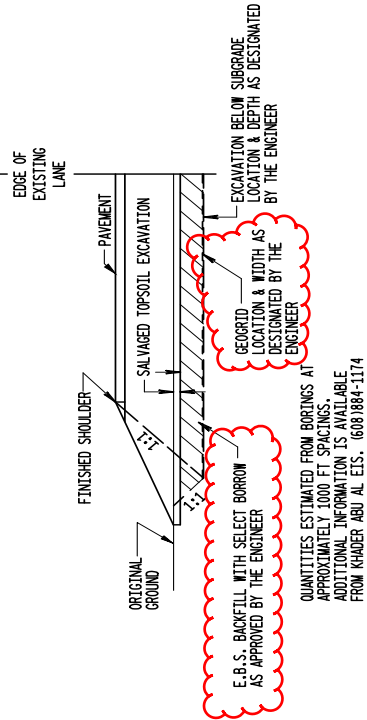

**DETAIL FOR EXCAVATION BELOW SUBGRADE**

THIS DETAIL TO BE USED FOR REMOVAL OF UNSUITABLE MATERIAL.

TOTAL PROJECT AREA = 10.448 ACRES  
TOTAL AREA EXPECTED TO BE DISTURBED BY CONSTRUCTION ACTIVITIES = 2.962 ACRES

Division	From/To Station	Location	Excavation Common (CY) (1) 205.0100		Fill (CY)	Roadway Embankment (CY) (2) SPV.0035.001	Mass Ordinate +/- (3)	Select Borrow (CY) 208.1100
			Cut (CY)	EBS (CY)				
1	3+00 'CK' - 16+09 'CK'	PHILHOWER RD & CREEK RD	422	200	46,540	46,540	-46,118	200
	18+46 'CK' - 28+00 'CK'	CREEK RD	1,478	0	6,642	6,642	-5,164	0
	11+50 'PT' - 28+50 'PT'	CREEK RD & PATRICK RD	585	181	48,659	48,659	-48,074	181
	4+80 'TC' - 26+09 'TC'	IH-39	1,365	1,200	738	738	827	1,200
Project 1003-10-74 - Division 1 Subtotal			4,050	1,581	102,579	102,579	-98,529	1,581
<b>Project 1003-10-74 Totals</b>			<b>5,631</b>	<b>1,581</b>	<b>102,579</b>	<b>102,579</b>		<b>1,581</b>

1) Excavation Common = Cut + EBS Excavation. Item number 205.0100.

2) Roadway Embankment (CY) =

3) The Mass Ordinate is calculated by division. A positive quantity indicates an excess of material within the Division and a negative quantity indicates a shortage of material within the Division. Structure Excavation is not included in this calculation.

4) Salvaged/usable pavement material is included in Cut.

5) EBS to be backfilled with Select Borrow.

**GEOGRID REINFORCEMENT**

SPV.0180.001	
GEOGRID	
LOCATION	(SY)
UNDISTRIBUTED	3,200
TOTAL	3,200

Addendum No. 01  
ID 1003-10-74  
Revised Sheet 57  
June 07, 2016

ALL ITEMS SHOWN  
CATEGORY 1000



BASE AGGREGATE DENSE

STATION	LOCATION	305.0110 BASE AGGREGATE DENSE 3/4-INCH (TON)	305.0120 BASE AGGREGATE DENSE 1 1/4-INCH (TON)	305.0130 BASE AGGREGATE DENSE 3-INCH (TON)	305.0140 BASE AGGREGATE DENSE 4-INCH (TON)
3+00'CK' - 10+38'CK'	CREEK ROAD	90	2,010	1,380	0
10+38'CK' - 12+17'CK'	CREEK ROAD INTERSECTION	10	900	540	0
12+17'CK' - 15+95'CK'	CREEK ROAD	60	1,210	820	0
18+64'CK' - 28+00'CK'	CREEK ROAD	180	3,900	2,640	0
11+50'PT - 19+22'PT	PATRICK ROAD	100	670	580	0
20+81'PT - 29+00'PT	PATRICK ROAD	100	480	470	0
372+78 - 393+44	IH 39 NB MEDIAN DRIVEWAYS	--	140	--	--
	UNDISTRIBUTED	--	--	1200	--
	CATEGORY 1000 TOTALS	613	11,650	7,630	<del>3,000</del>
	PROJECT TOTALS	613	11,650	7,630	<del>3,000</del>

~~3120000~~  
~~SELECT~~  
~~CRUSHED~~  
~~MATERIAL~~

CONCRETE PAVEMENT

STATION	LOCATION	415.0080 CONCRETE PAVEMENT 8-INCH (SY)	415.0410 CONCRETE PAVEMENT APPROACH SLAB (SY)
15+94'CK' - 16+16'CK'	L/RT	32	84
18+41'CK' - 18+65'CK'	L/RT	30	82
	TOTAL	62	166

ALL ITEMS SHOWN  
CATEGORY 1000

LOCATION	PAVEMENT DEPTH (INCHES)	465.0105 ASPHALTIC SURFACE (TON)	460.5223 HMA PAVEMENT 3 LT 58-28 S (TON)	460.5224 HMA PAVEMENT 4 LT 58-28 S (TON)	460.7223 HMA PAVEMENT 3 HT 58-28 S (TON)	460.7424 HMA PAVEMENT 4 HT 58-28 H (TON)	455.0605 TACK COAT (GAL)
CREEK RD.	4	31	690	540	--	--	270
PATRICK RD.	4	33	540	420	--	--	210
IH 39 NB MEDIAN	5	--	--	--	865	--	120
IH 39 NB - RUMBLESTRIP OVERLAY	2	--	--	--	--	55	10
IH 39 SB - RUMBLESTRIP OVERLAY	2	--	--	--	--	60	15
TOTAL		64	1,230	960	865	115	625

Addendum No. 01  
 ID 1003-10-74  
 Revised Sheet 58  
 June 07, 2016

STORM SEWER & CULVERT PIPE SUMMARY

STATION	LOCATION	522.0118 CULVERT PIPE REINFORCED CONCRETE CLASS III 18-INCH (LF)	522.0124 CULVERT PIPE REINFORCED CONCRETE CLASS III 24-INCH (LF)	522.0148 CULVERT PIPE REINFORCED CONCRETE CLASS III 48-INCH (LF)	522.0118 APRON ENDWALLS FOR CULVERT PIPE REINFORCED CONCRETE 18-INCH (EACH)	522.1024 APRON ENDWALLS FOR CULVERT PIPE REINFORCED CONCRETE 24-INCH (EACH)	522.1048 APRON ENDWALLS FOR CULVERT PIPE REINFORCED CONCRETE 48-INCH (EACH)
11+00'TC'	RT	--	--	160	--	--	2
11+00'TC'	LT	--	--	180	--	--	2
18+18'CK'	LT	--	--	--	--	--	--
23+96'CK'	LT/RT	--	64	--	--	2	--
24+42'CK'	RT	30	--	--	2	--	--
25+18'CK'	LT	24	--	--	2	--	--
27+25'PT'	RT	30	--	--	2	--	--
<b>TOTALS</b>		84	64	340	6	2	4

ALL ITEMS SHOWN  
CATEGORY 1000

Addendum No. 01  
ID 1003-10-74  
Revised Sheet 59  
June 07, 2016

STATION	LOCATION	521.1012 APRON ENDWALLS FOR CULVERT PIPE STEEL 12-INCH (EACH)	611.0654 INLET COVERS TYPE V (EACH)	611.3220 INLETS 2X2-FT (EACH)	612.0212 PIPE UNDERDRAIN UNPERFORATED 12-INCH (LF)	628.7010 INLET PROTECTION TYPE B (EACH)
18+70'CK'	LT	1	1	1	55	1
18+78'CK'	RT	1	1	1	55	1
<b>TOTALS</b>		2	2	2	110	2

628.7555  
CULVERT PIPE  
CHECKS


STATION	LOCATION	(EACH)	CONCRETE CURB & GUTTER
24+00'CK'	LT	10	601.0557 CONCRETE CURB & GUTTER 4-INCH SLOPED 36-INCH TYPE D (LF)
24+75'CK'	RT	10	
25+40'CK'	LT	10	
27+75'CK'	LT	10	
<b>TOTALS</b>		40	

INLET INFORMATION

LOCATION	RIM ELEVATION	FLOOR ELEVATION	DEPTH OF STRUCTURE
18+70'CK' 17' LT	834.09	829.76	3.00
18+78'CK' 17' RT	833.68	829.35	3.00


(1) DEPTH OF STRUCTURE =  
RIM ELEVATION MINUS THE DEPTH OF FRAME AND ADJUSTING RINGS' MINUS THE FLOOR ELEVATION  
DEPTH OF FRAME AND ADJUSTING RINGS TYPE V COVER = 1.33'  
OFFSETS TO INLETS ARE TO CENTER OF INLETS

Addendum No. 01  
 ID 1003-10-75  
 Revised Sheet 15  
 June 07, 2016

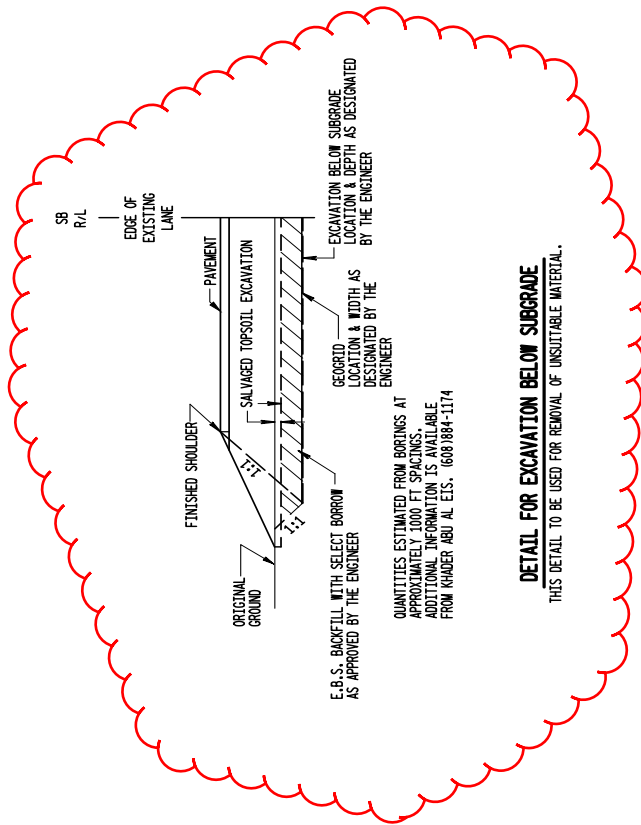



Addendum No. 01  
ID 1003-10-75  
Revised Sheet 17  
June 07, 2016

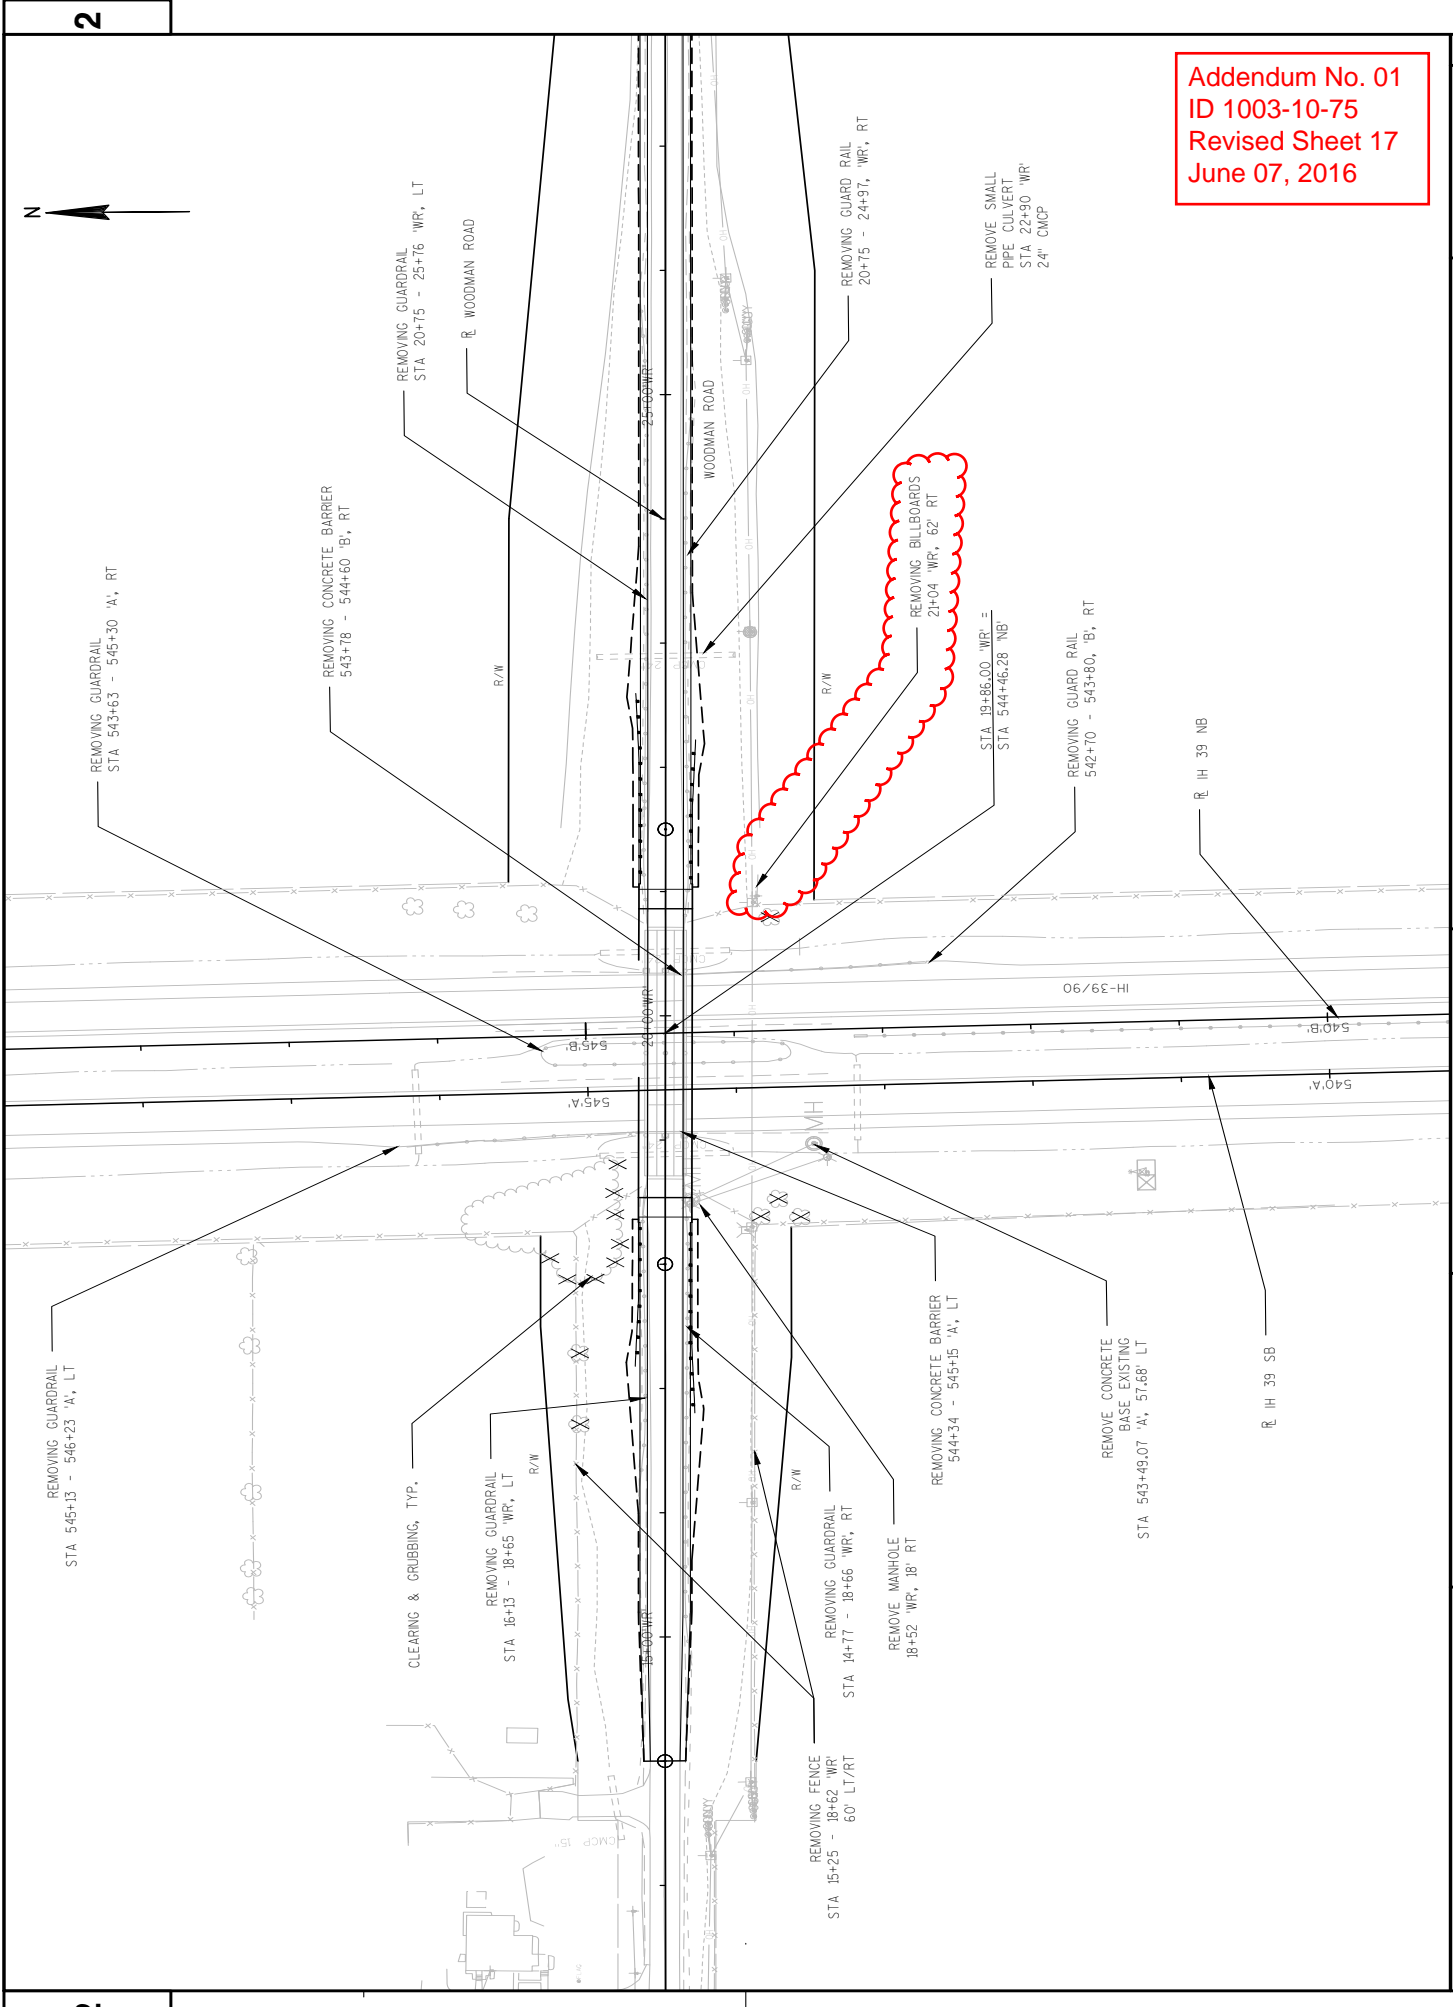

From/To Station	Location	Common Excavation (CY) (1) 205.0100			Fill (CY)	Roadway Embankment (CY) (4) SPV.0035.001	Select Borrow (CY) (3) 208.1100	Mass Ordinate +/- (5)	Comment:
		Cut (CY) (2)	EBS (CY) (3)						
14+00 - 18+36	Woodman Road	888	186	3741	3741	186	-2853		
21+05 - 34+00	Woodman Road	253	0	39040	39040	0	-38787		
		1141	186	42781	42781	186	-41640		
532+50 - 555+00	IH 39	4590	2848	864	864	2848	3726		
		4590	2848	864	864	2848	3726		
		5731	3034	43645	43645	3034			
Total Common Excavation:			8765						

- 1) Common Excavation is the sum of the Cut and EBS Excavation columns. Item number 205.0100.
- 2) Cut volume includes concrete and asphaltic surface material.
- 3) EBS Excavation to be backfilled with Select Borrow.
- 4) Roadway Embankment = Fill Depending on selections:
- 5) The Mass Ordinate + or - Qty calculated for the Division. Plus quantity indicates an excess of material within the Division. Minus indicates a shortage of material within the Division. Mass Ordinate = Cut - Fill. The Mass Ordinate is for information purposes only as Common Excavation and Roadway Embankment are not balanced for quantity purposes and does not guarantee the quality of Common Excavation, and if it can be reused onsite. All EBS is to be wasted offsite.

Addendum No. 01  
ID 1003-10-75  
Revised Sheet 75  
June 07, 2016

**SALVAGE & REINSTALL CABLE GUARD**

CATEGORY	STATION	LOCATION	SPV.0060.004		SPV.0090.001		SPV.0060.005		SPV.0090.002	
			SALVAGE TERMINAL HIGH-TENSION CABLE TL-3, GIBRALTAR	SOCKETED GIBRALTAR	SALVAGE HIGH-TENSION CABLE TL-3, GIBRALTAR	REINSTALL HIGH-TENSION CABLE TL-3, GIBRALTAR	REINSTALL HIGH-TENSION CABLE TL-3, GIBRALTAR	REINSTALL HIGH-TENSION CABLE TL-3, GIBRALTAR	REINSTALL HIGH-TENSION CABLE TL-3, GIBRALTAR	
1000	IH 39 MAINLINE									
	532+30A-537+38	RT	-	508	-	-	-	508	-	508
	537+38A	RT	1	-	1	1	-	-	-	-
	538+09B-543+18B	LT	-	509	-	-	-	509	-	509
	538+09B	LT	1	-	1	1	-	-	-	-
	543+18	LT	1	-	1	1	-	-	-	-
TOTAL			3	1017	3	3	1017			

**CPM PROGRESS SCHEDULE ITEMS**

CATEGORY	LOCATION	SPV.0060.001		SPV.0060.002	
		BASELINE CPM PROGRESS SCHEDULE EACH	CPM PROGRESS SCHEDULE EACH	CPM PROGRESS SCHEDULE UPDATES AND ACCEPTED REVISIONS EACH	CPM PROGRESS SCHEDULE UPDATES AND ACCEPTED REVISIONS EACH
1000	IH 39 MAINLINE & WOODMAN RD	0.2	0.2	0.2	0.2
TOTAL		0.2	0.2	0.2	0.2

Addendum No. 01  
ID 1003-10-75  
Revised Sheet 84  
June 07, 2016

**ACCESS GATE**

CATEGORY	STATION	LOCATION	SPV.0060.003	
			ACCESS GATE 6-FOOT EACH	ACCESS GATE 6-FOOT EACH
1000	WOODMAN RD			
	18+53.81	RT	1	1
	20+86.19	LT	1	1
TOTAL			2	2

**REMOVING BILLBOARDS**

CATEGORY	STATION	LOCATION	SPV.0060.010	
			REMOVING BILLBOARDS EACH	REMOVING BILLBOARDS EACH
1000	WOODMAN RD			
	21+04	RT	1	1
TOTAL			1	1

**SURVEY PROJECT**

SPV.0105.002	
SURVEY PROJECT 1003-10-75	
CATEGORY	LOCATION
1000	IH 39 MAINLINE & WOODMAN RD
TOTAL	
	1
	1


**GEO-GRID REINFORCEMENT**

SPV.0180.001	
GEO-GRID REINFORCEMENT	
CATEGORY	LOCATION
1000	WOODMAN RD & IH 39
TOTAL	
	2000

# EARTH WORK DATA - WOODMAN ROAD

STATION	Real Station	Distance	AREA (SF)		EBS		Incremental Vol (CY) (Unadjusted)		EBS		Cumulative Vol (CY)		Expanded Backfill	Mass Ordinate
			Cut	Fill	Cut	Fill	Cut	Fill	Cut	Fill				
14+00	1400	0	44	36	0	0	0	0	0	0	0	0	0	
14+50	1450	50	58	40	0	0	94	71	0	0	94	71	0	23
15+00	1500	50	72	54	0	0	120	88	0	0	214	159	0	56
15+50	1550	50	67	111	0	0	129	153	0	0	343	311	0	32
16+00	1600	50	64	197	0	0	121	285	0	0	464	596	0	-132
16+50	1650	50	56	300	0	0	111	460	0	0	575	1056	0	-481
17+00	1700	50	51	380	0	0	100	629	0	0	675	1685	0	-1010
17+50	1750	50	46	382	0	0	90	705	0	0	765	2390	0	-1626
18+00	1800	50	37	434	0	0	77	755	0	0	842	3145	0	-2304
18+36	1836	36	32	460	0	0	46	596	0	0	888	3592	186	-2704
21+05	2105	0	1	781	0	0	0	0	0	0	888	3592	186	-2704
21+50	2150	45	1	973	0	0	30	1103	0	0	917	4695	186	-3377
22+00	2200	50	0	1156	0	0	1	1972	0	0	918	6667	186	-5348
22+50	2250	50	0	1375	0	0	0	2344	0	0	918	9011	186	-7692
23+00	2300	50	0	1421	0	0	0	2589	0	0	918	11600	186	-10281
23+50	2350	50	0	1347	0	0	0	2563	0	0	918	14162	186	-12844
24+00	2400	50	0	1367	0	0	0	2513	0	0	918	16675	186	-15356
24+50	2450	50	0	1407	0	0	0	2568	0	0	918	19243	186	-17925
25+00	2500	50	0	1430	0	0	0	2627	0	0	918	21870	186	-20551
25+50	2550	50	0	1462	0	0	0	2678	0	0	918	24547	186	-23229
26+00	2600	50	0	1445	0	0	0	2692	0	0	918	27239	186	-25921
26+50	2650	50	0	1361	0	0	0	2599	0	0	918	29838	186	-28519
27+00	2700	50	0	1251	0	0	0	2419	0	0	918	32257	186	-30938
27+50	2750	50	0	1116	0	0	0	2192	0	0	918	34448	186	-33130
28+00	2800	50	0	959	0	0	0	1921	0	0	918	36369	186	-35051
28+50	2850	50	0	804	0	0	0	1632	0	0	918	38001	186	-36683
29+00	2900	50	0	656	0	0	0	1352	0	0	918	39353	186	-38034
29+50	2950	50	0	533	0	0	0	1101	0	0	918	40454	186	-39135
30+00	3000	50	0	382	0	0	0	847	0	0	918	41301	186	-39983
30+50	3050	50	0	260	0	0	0	595	0	0	918	41896	186	-40578
31+00	3100	50	0	158	0	0	0	388	0	0	918	42284	186	-40965
31+50	3150	50	1	77	0	0	0	218	0	0	918	42502	186	-41183
32+00	3200	50	11	23	0	0	11	93	0	0	929	42594	186	-41264
32+50	3250	50	17	7	0	0	26	28	0	0	956	42622	186	-41266
33+00	3300	50	30	1	0	0	65	7	0	0	1000	42629	186	-41229
33+50	3350	50	39	1	0	0	65	2	0	0	1064	42631	186	-41166
34+00	3400	50	43	0	0	0	77	1	0	0	1141	42632	186	-41090
Column totals											1141	42781	186	

Addendum No. 01  
 ID 1003-10-75  
 Revised Sheet 162  
 June 07, 2016

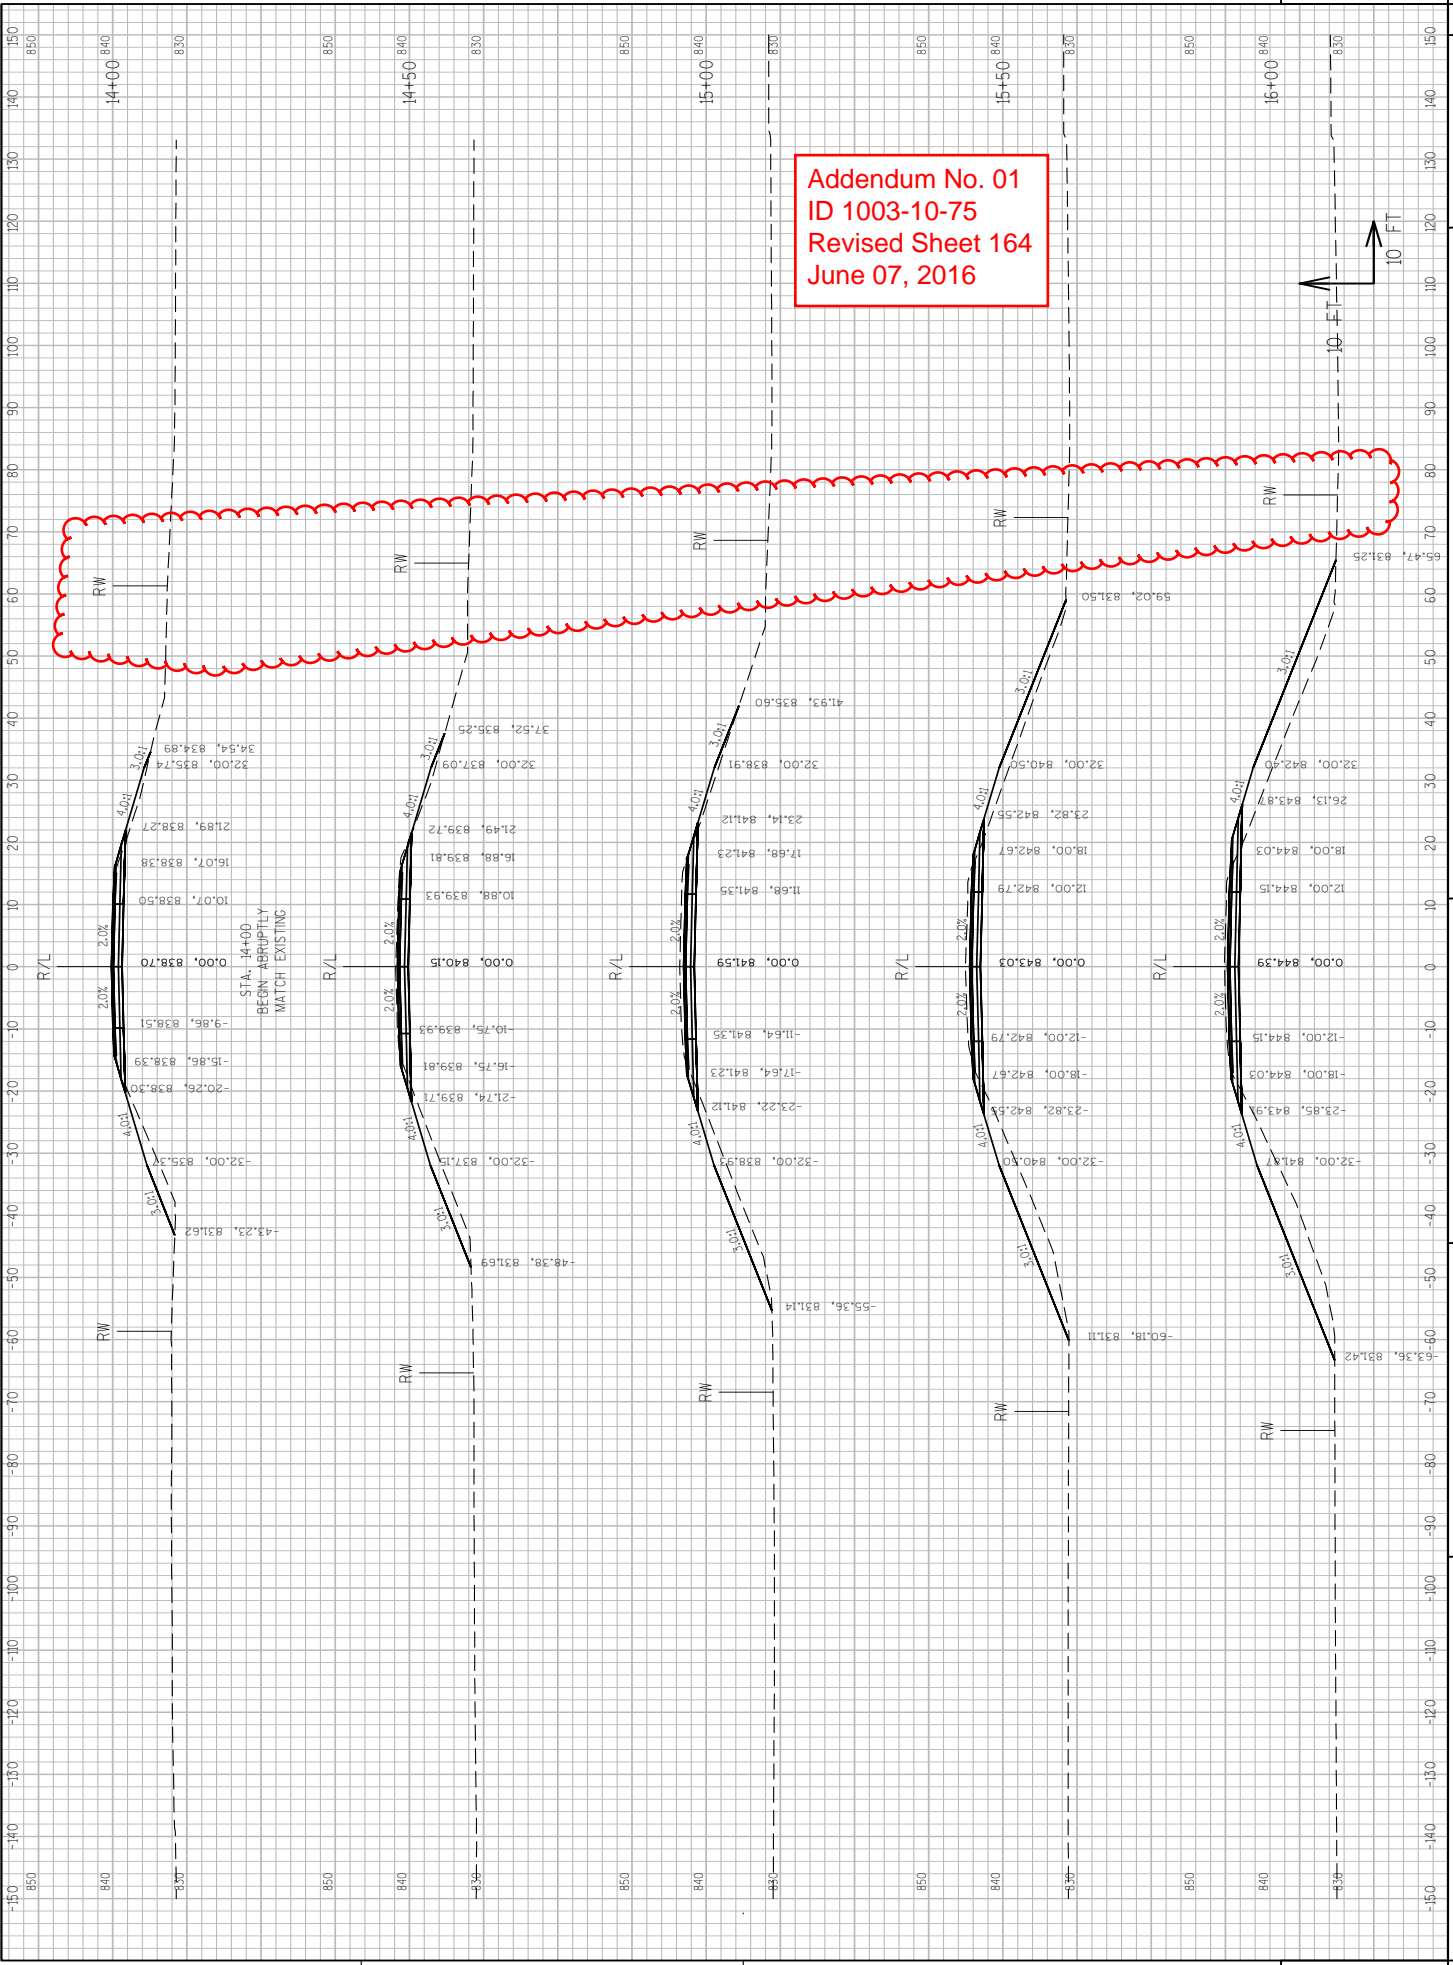


Addendum No. 01  
ID 1003-10-75  
Revised Sheet 164  
June 07, 2016




9

9



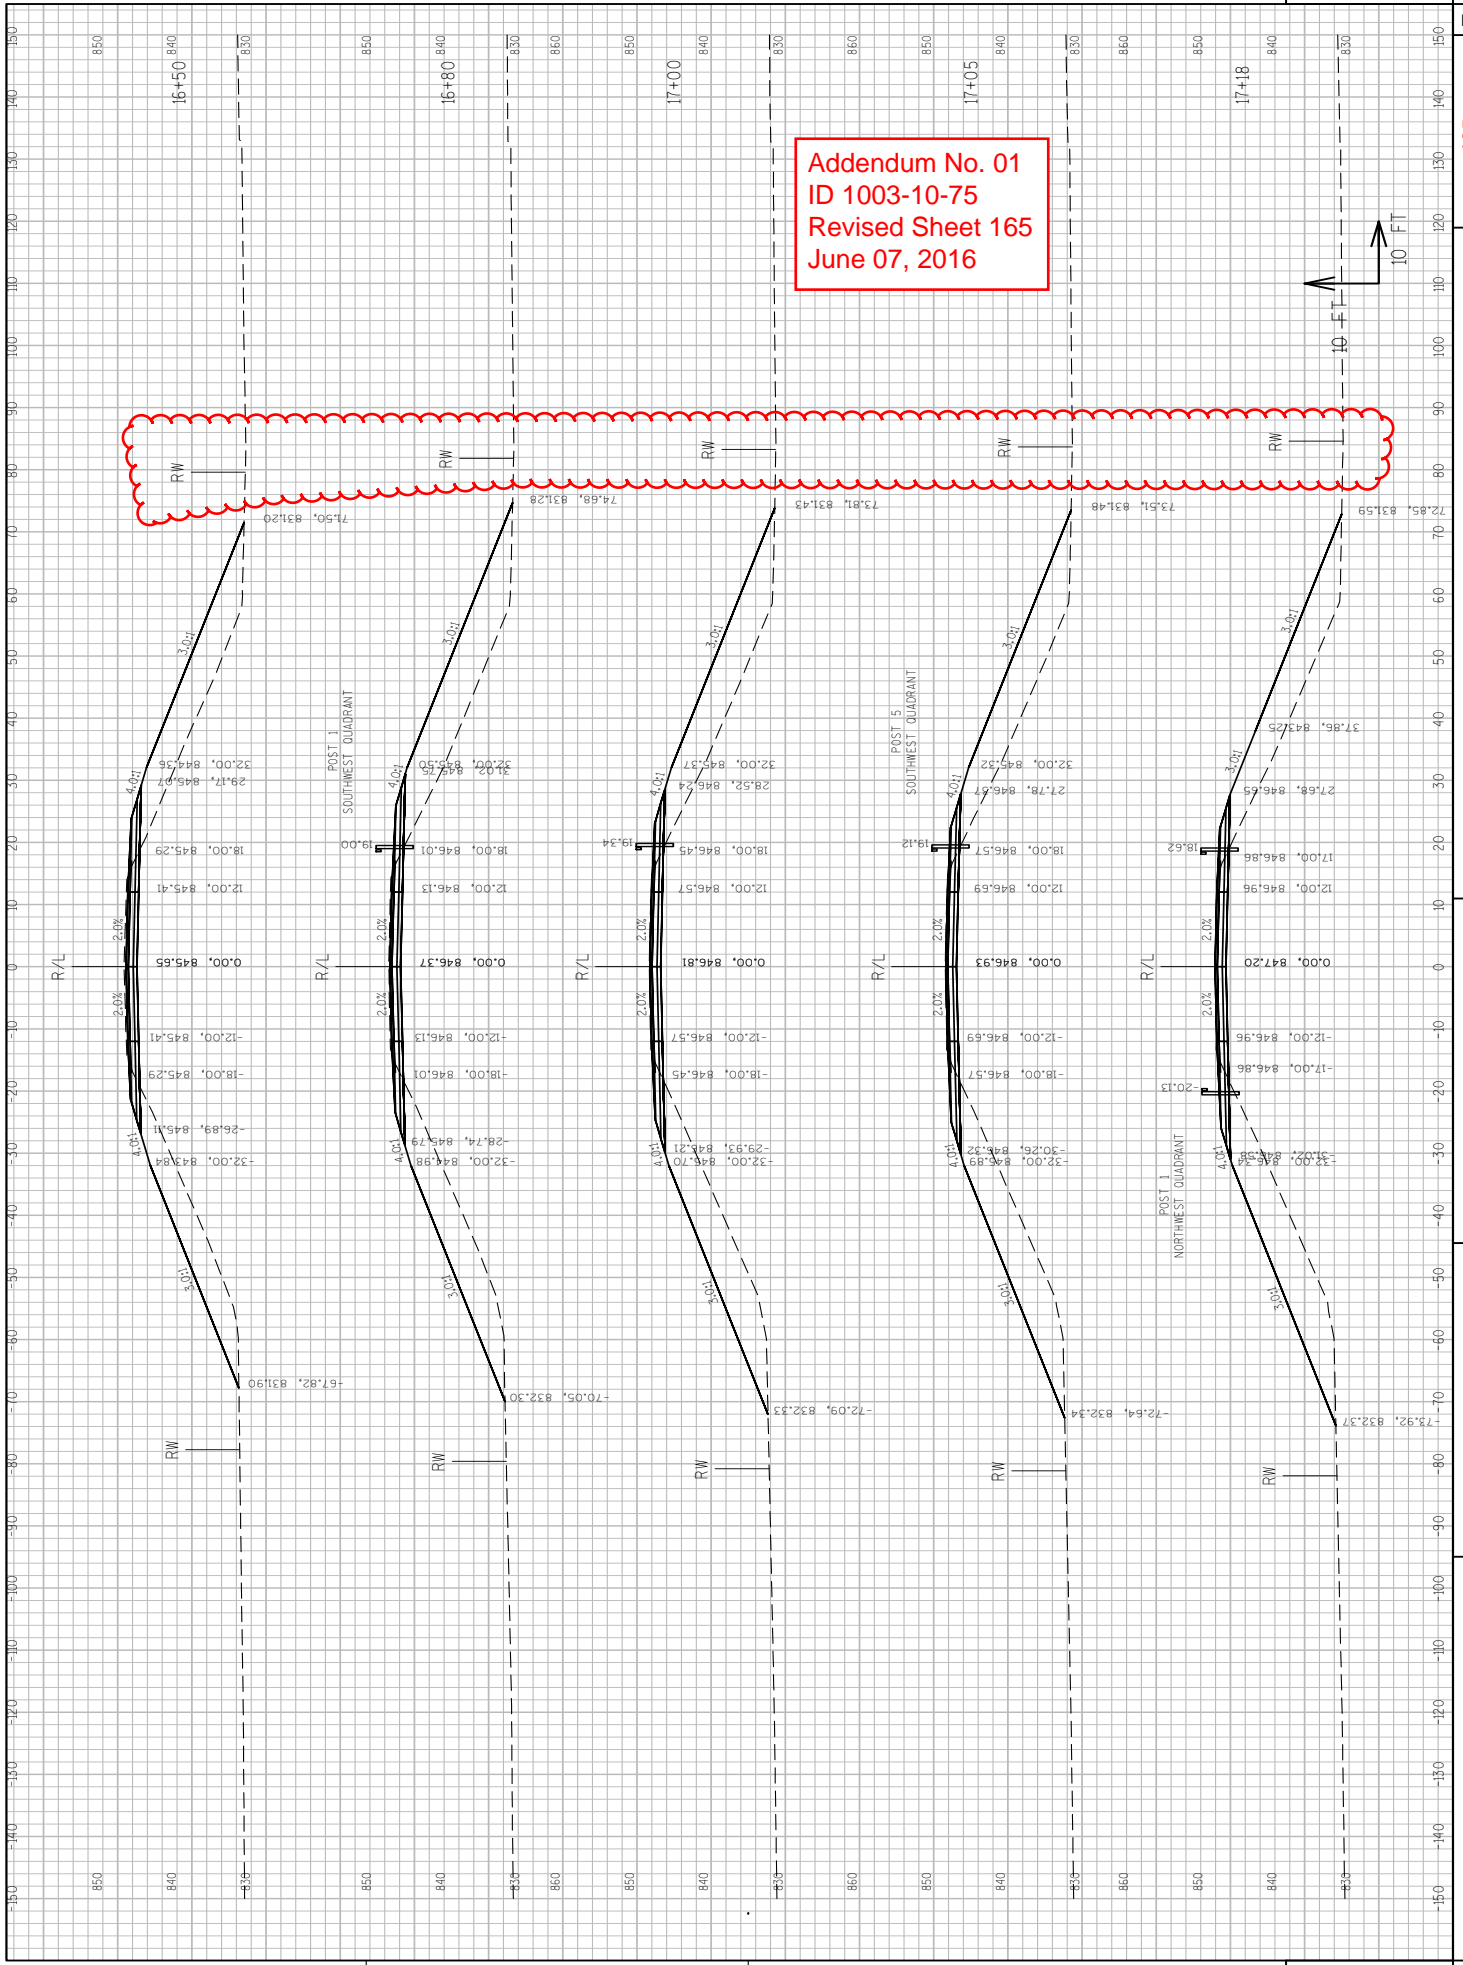


Addendum No. 01  
 ID 1003-10-75  
 Revised Sheet 165  
 June 07, 2016

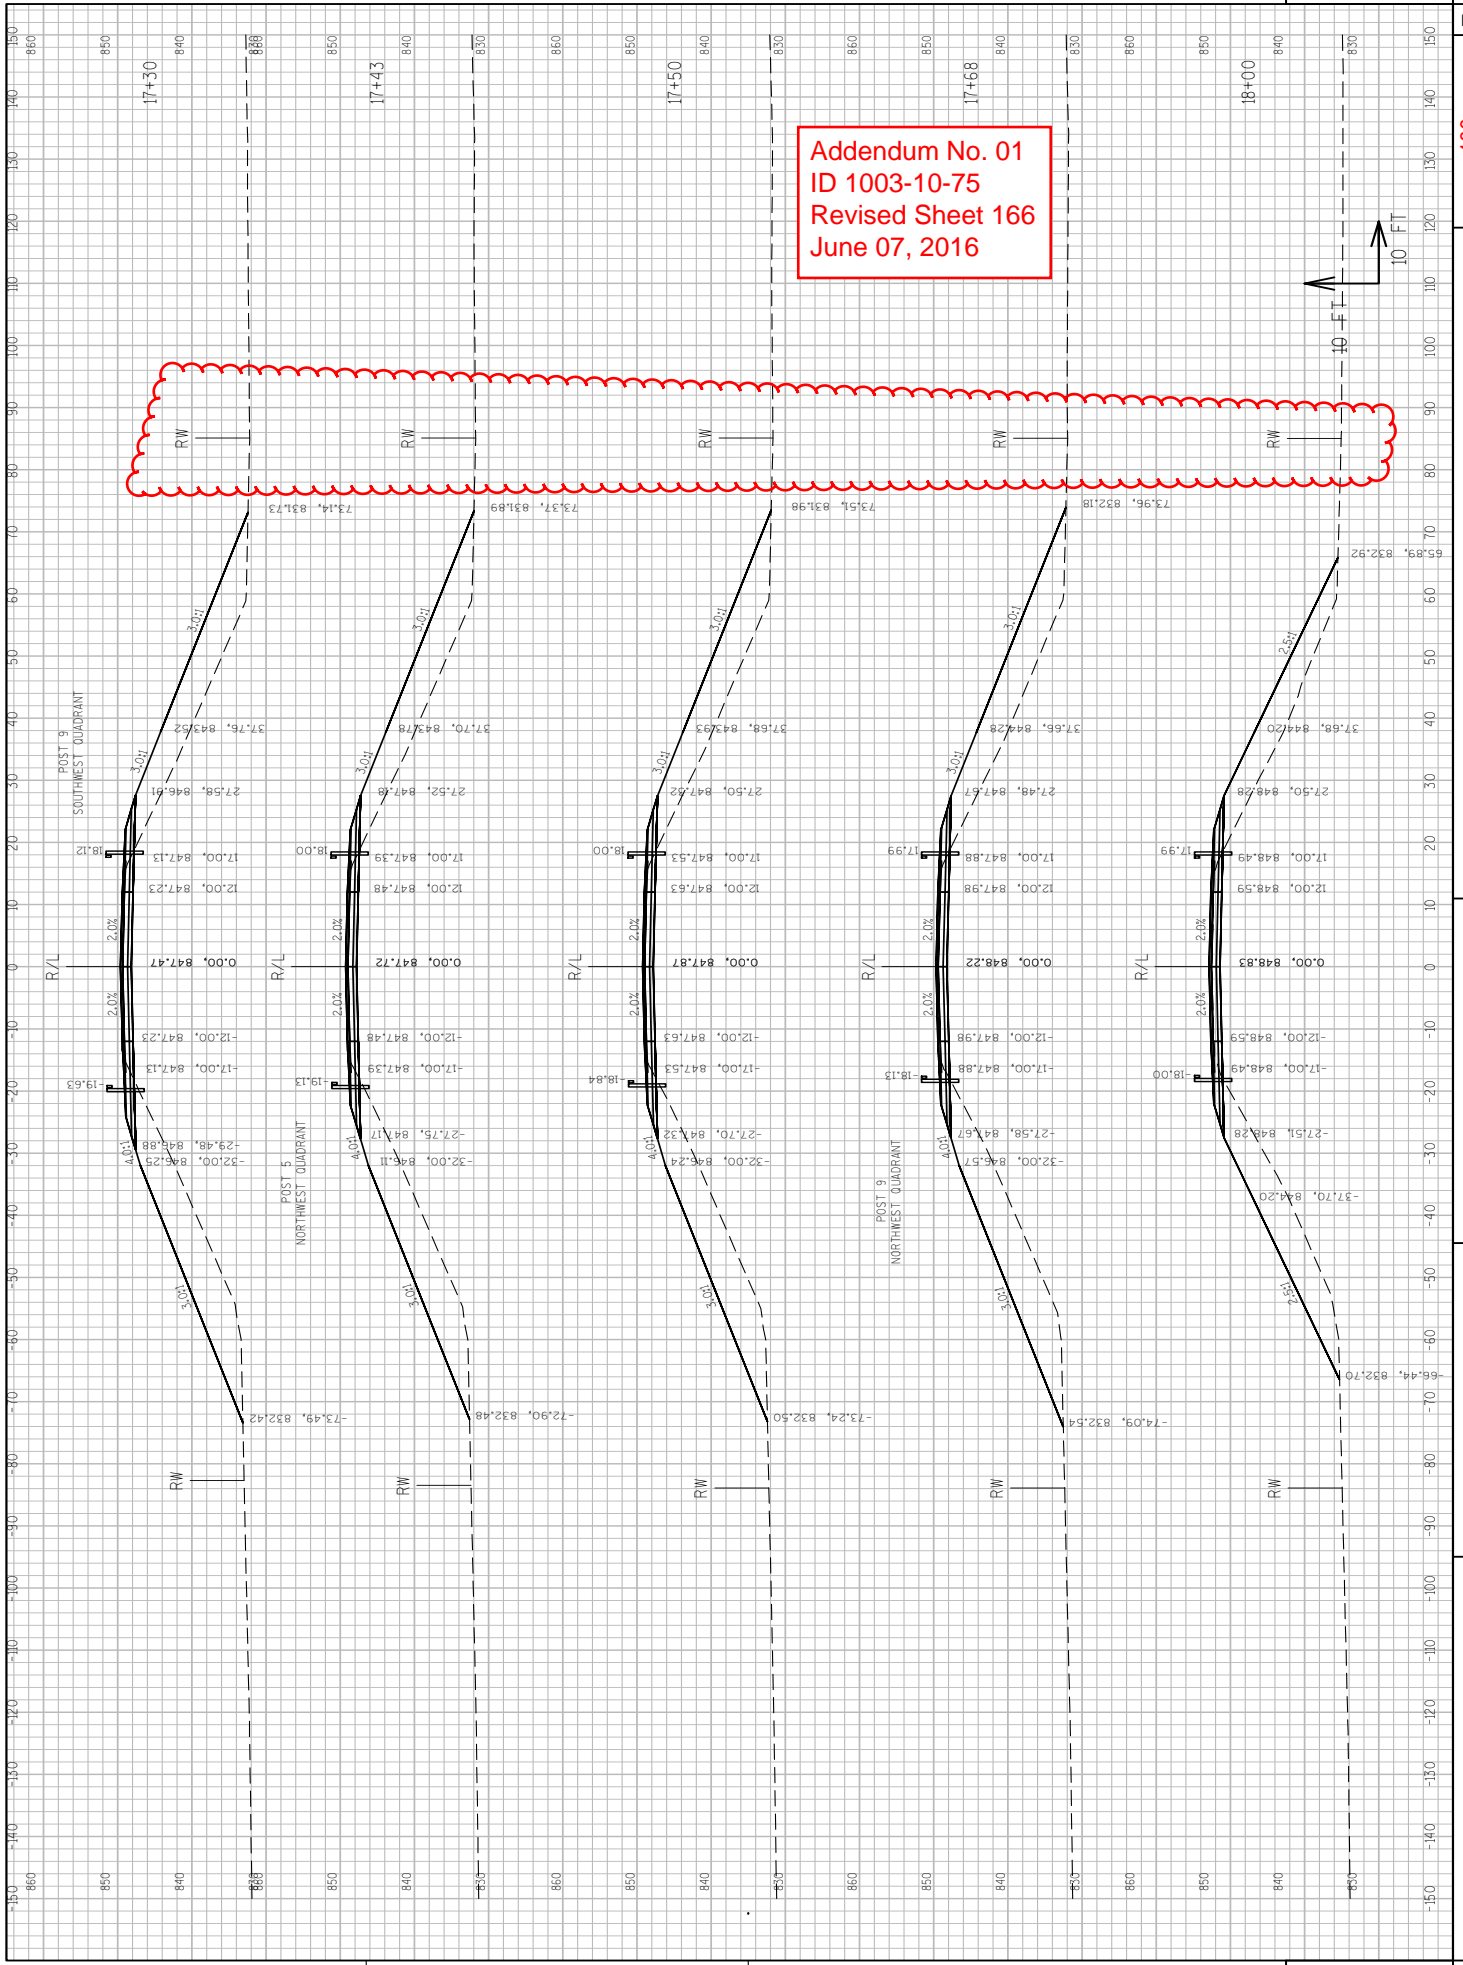


Addendum No. 01  
 ID 1003-10-75  
 Revised Sheet 166  
 June 07, 2016



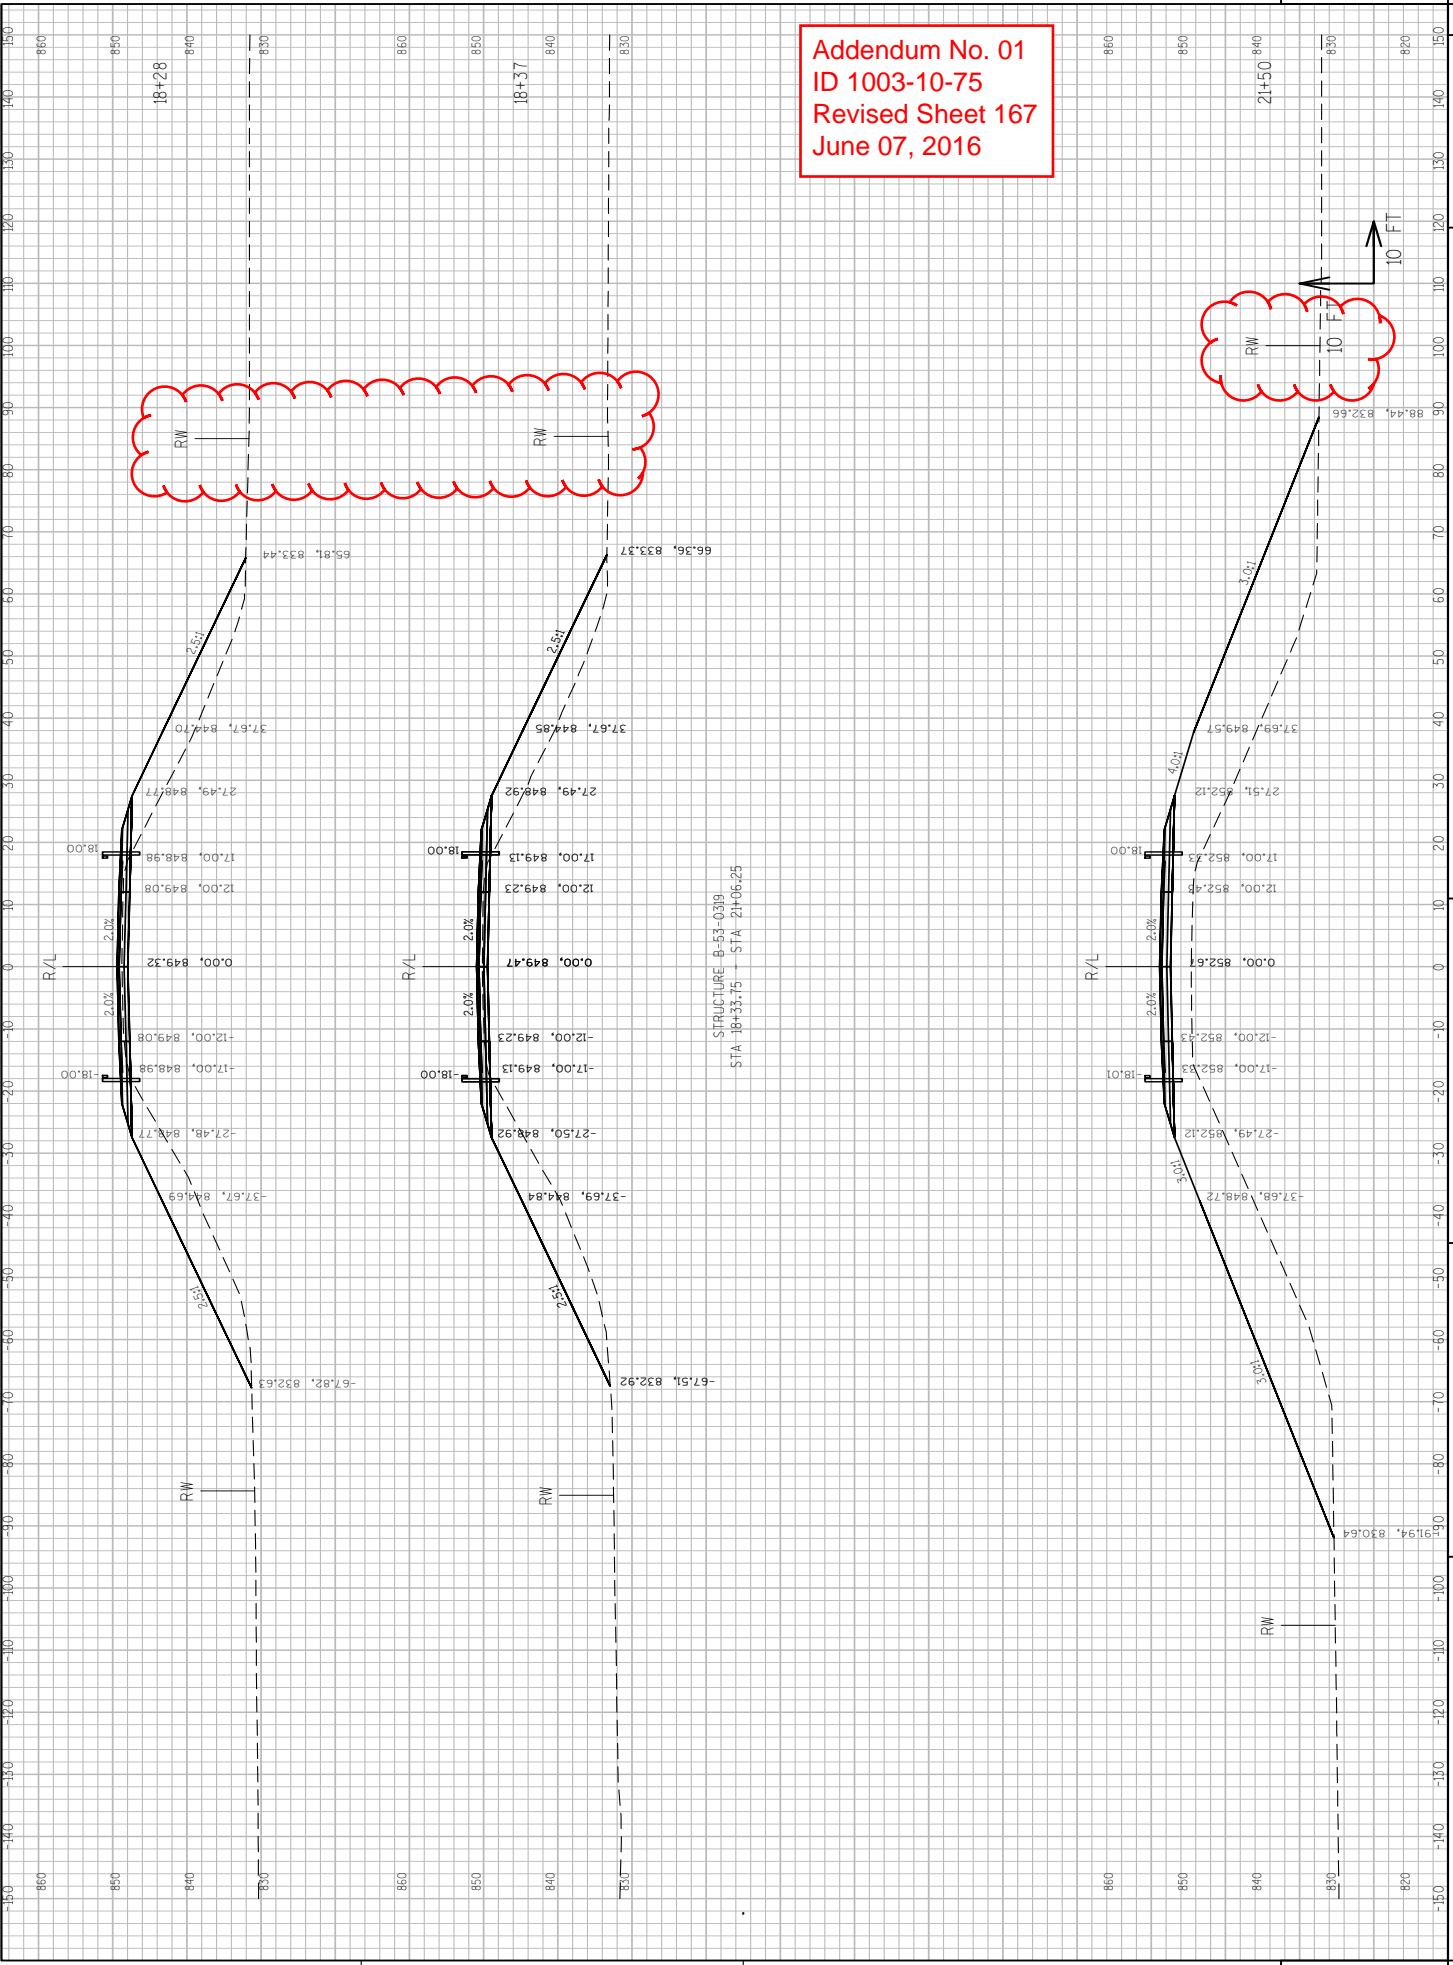

Addendum No. 01  
ID 1003-10-75  
Revised Sheet 167  
June 07, 2016

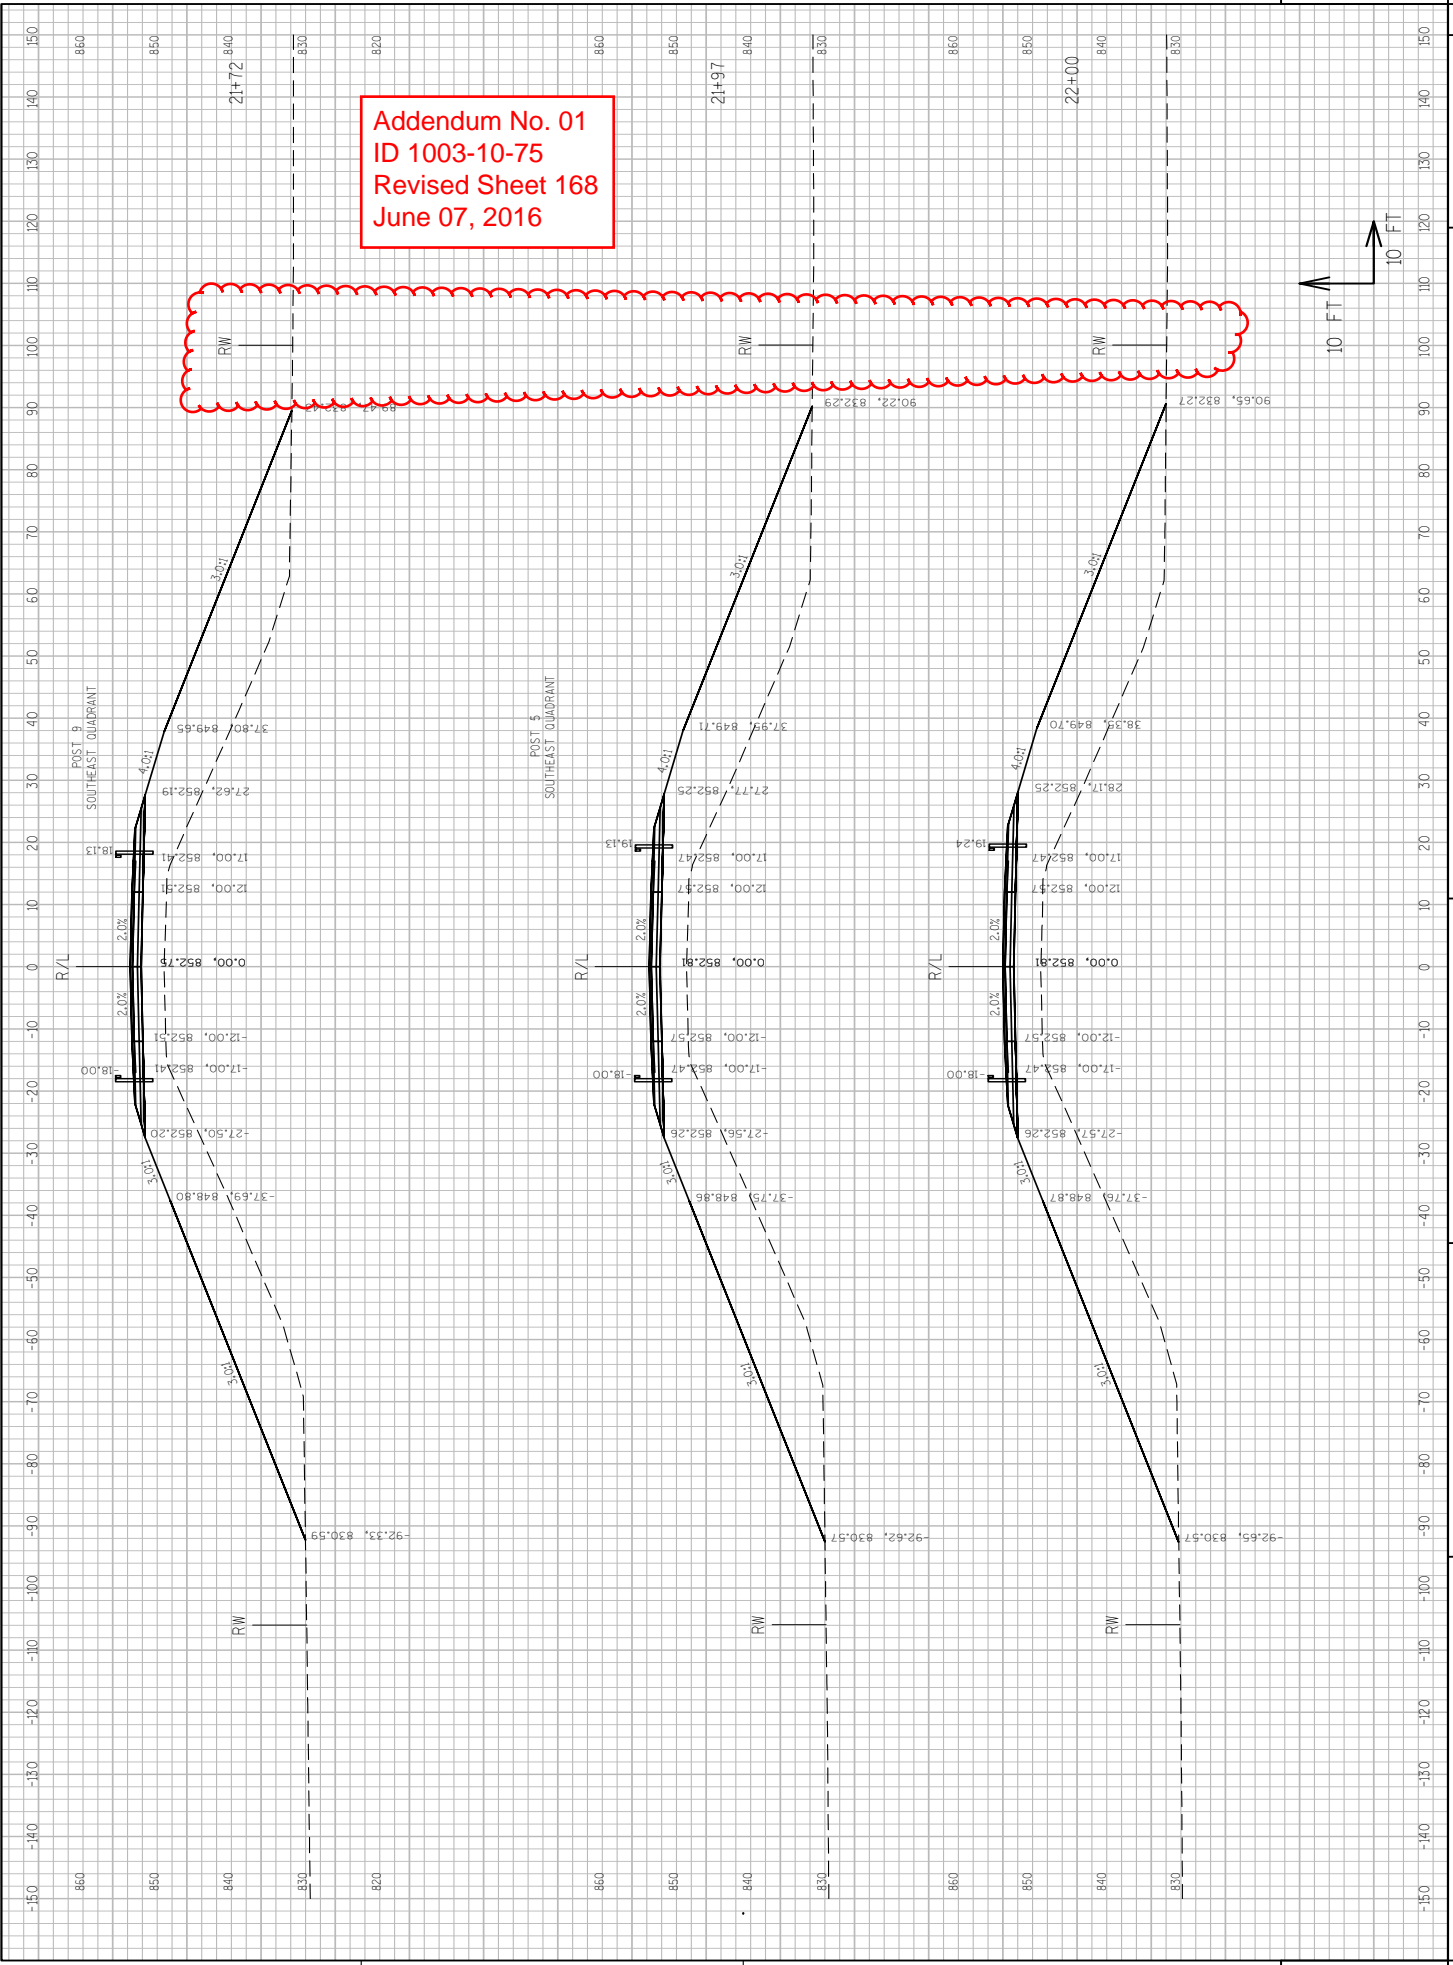

Addendum No. 01  
 ID 1003-10-75  
 Revised Sheet 168  
 June 07, 2016

9

9

PROJECT NO: 1003-10-75

HWY: IH 39


COUNTY: ROCK


CROSS SECTIONS: WOODMAN ROAD


SHEET 168

E


Addendum No. 01  
 ID 1003-10-75  
 Revised Sheet 169  
 June 07, 2016

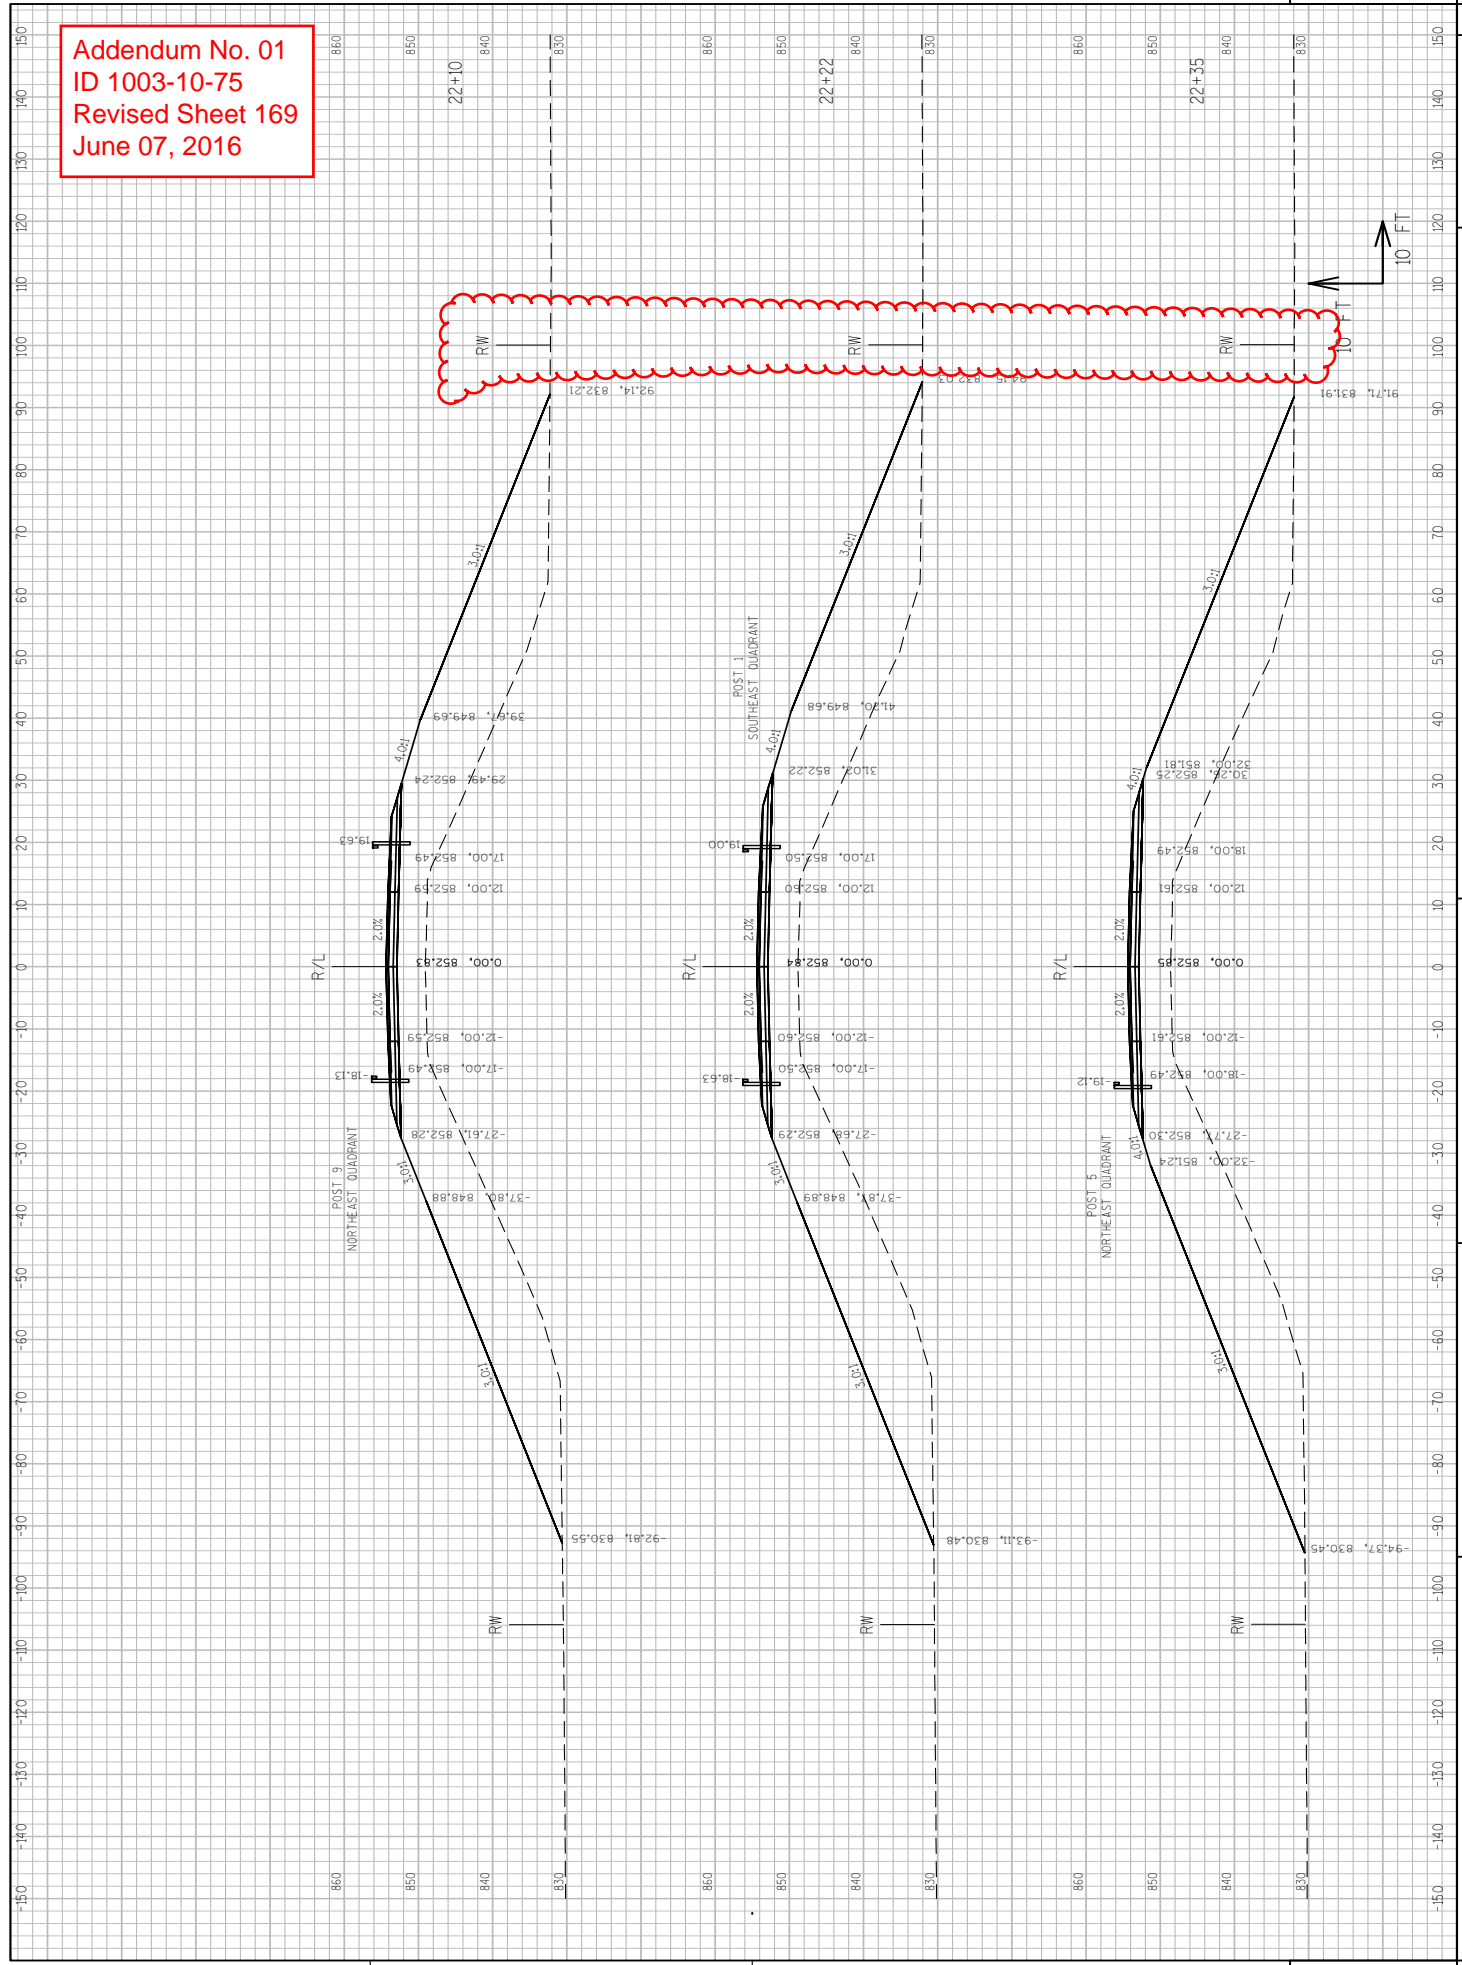

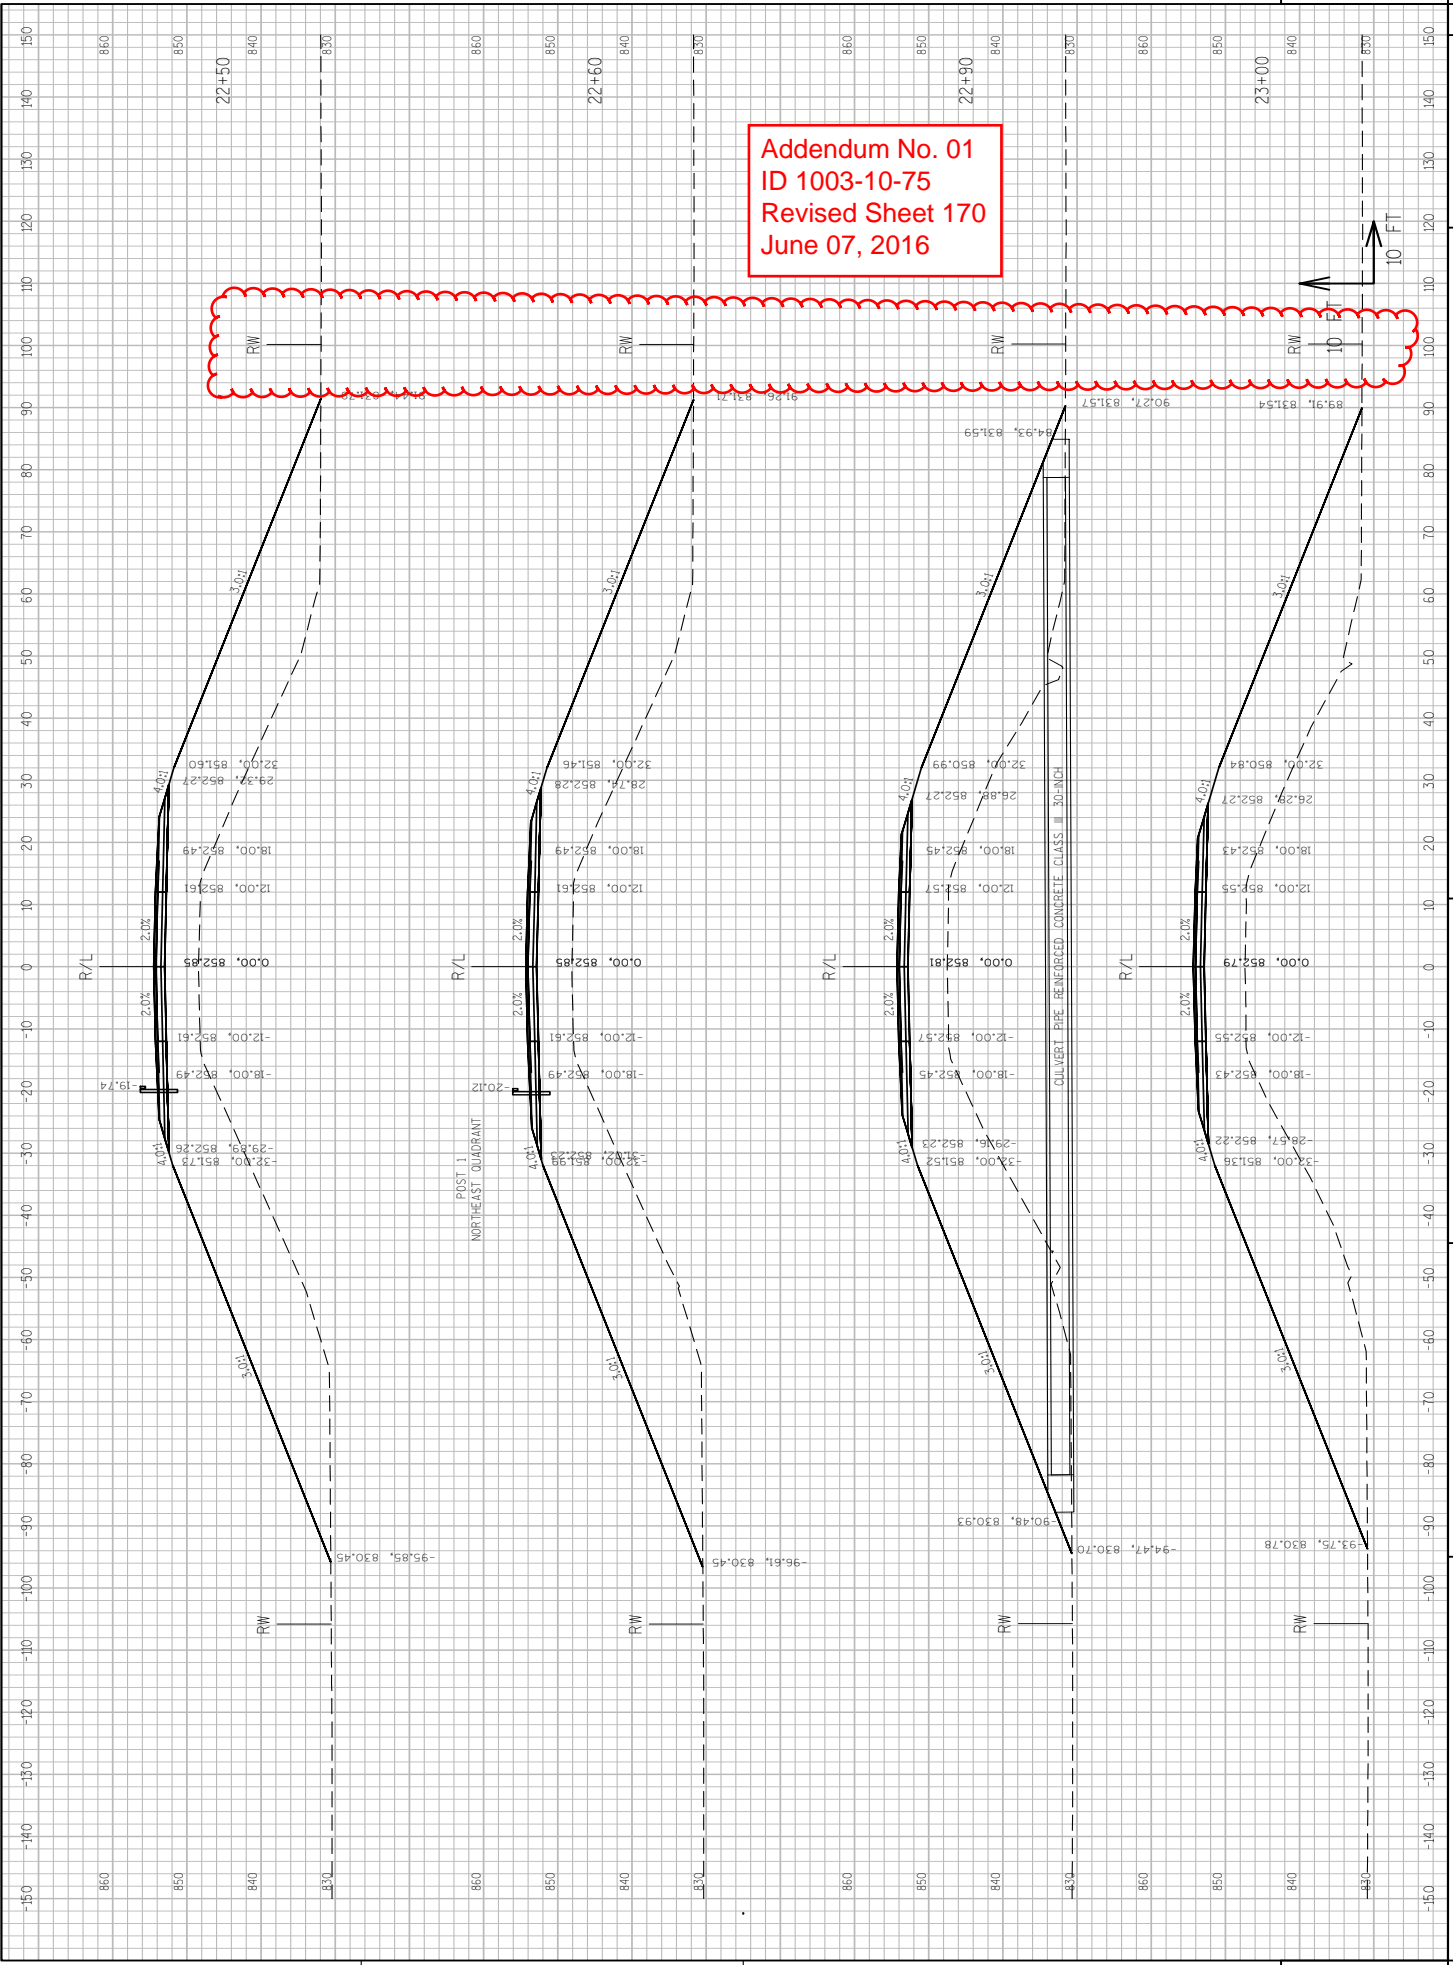

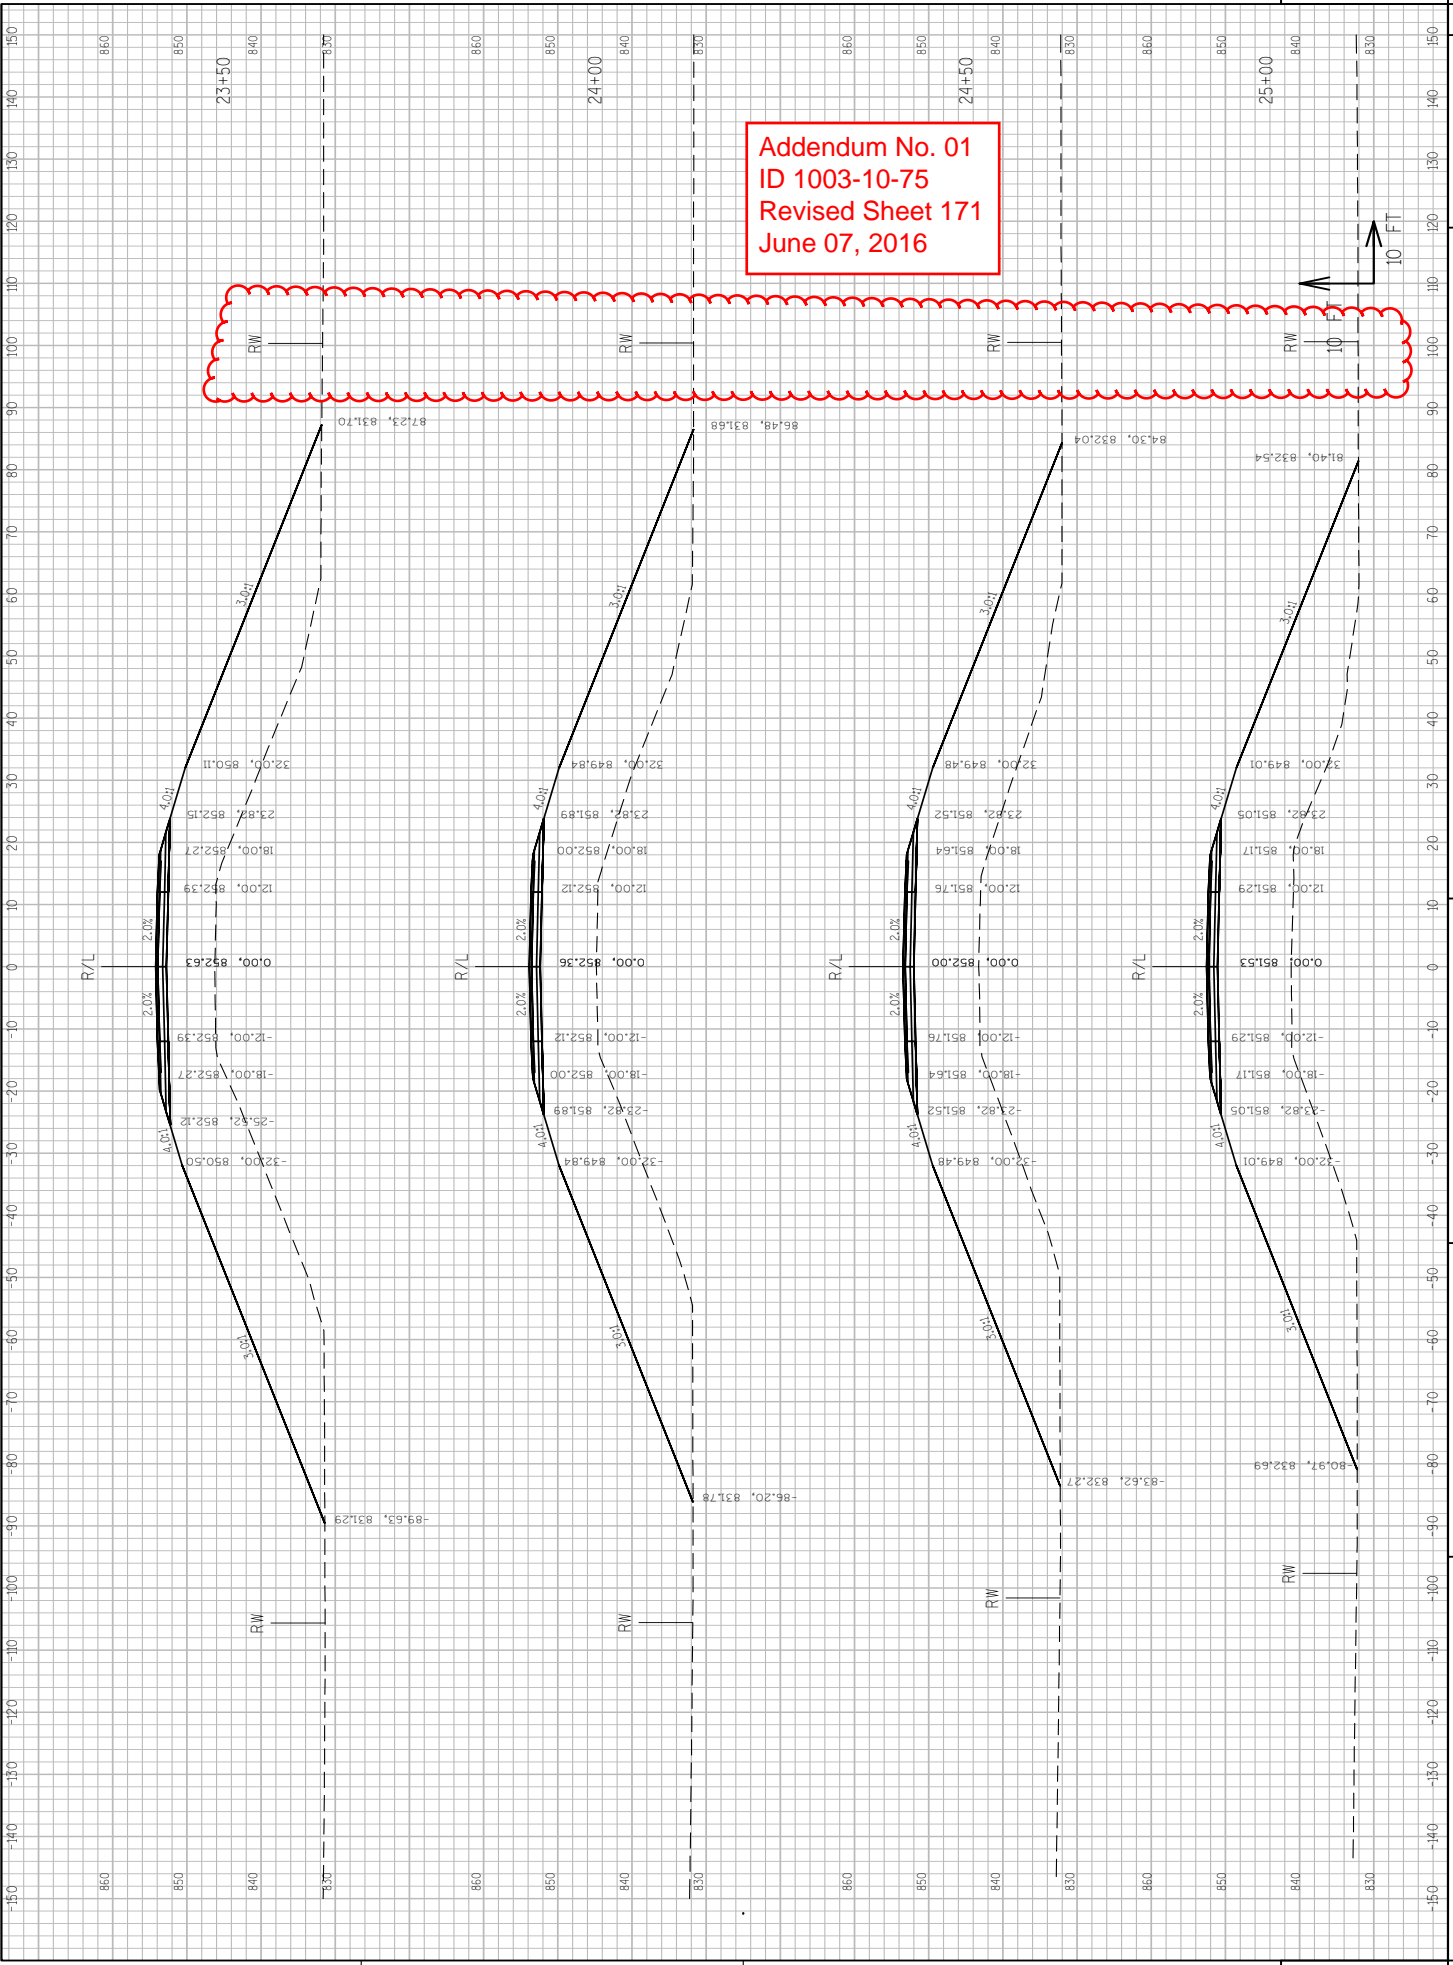



Addendum No. 01  
 ID 1003-10-75  
 Revised Sheet 171  
 June 07, 2016

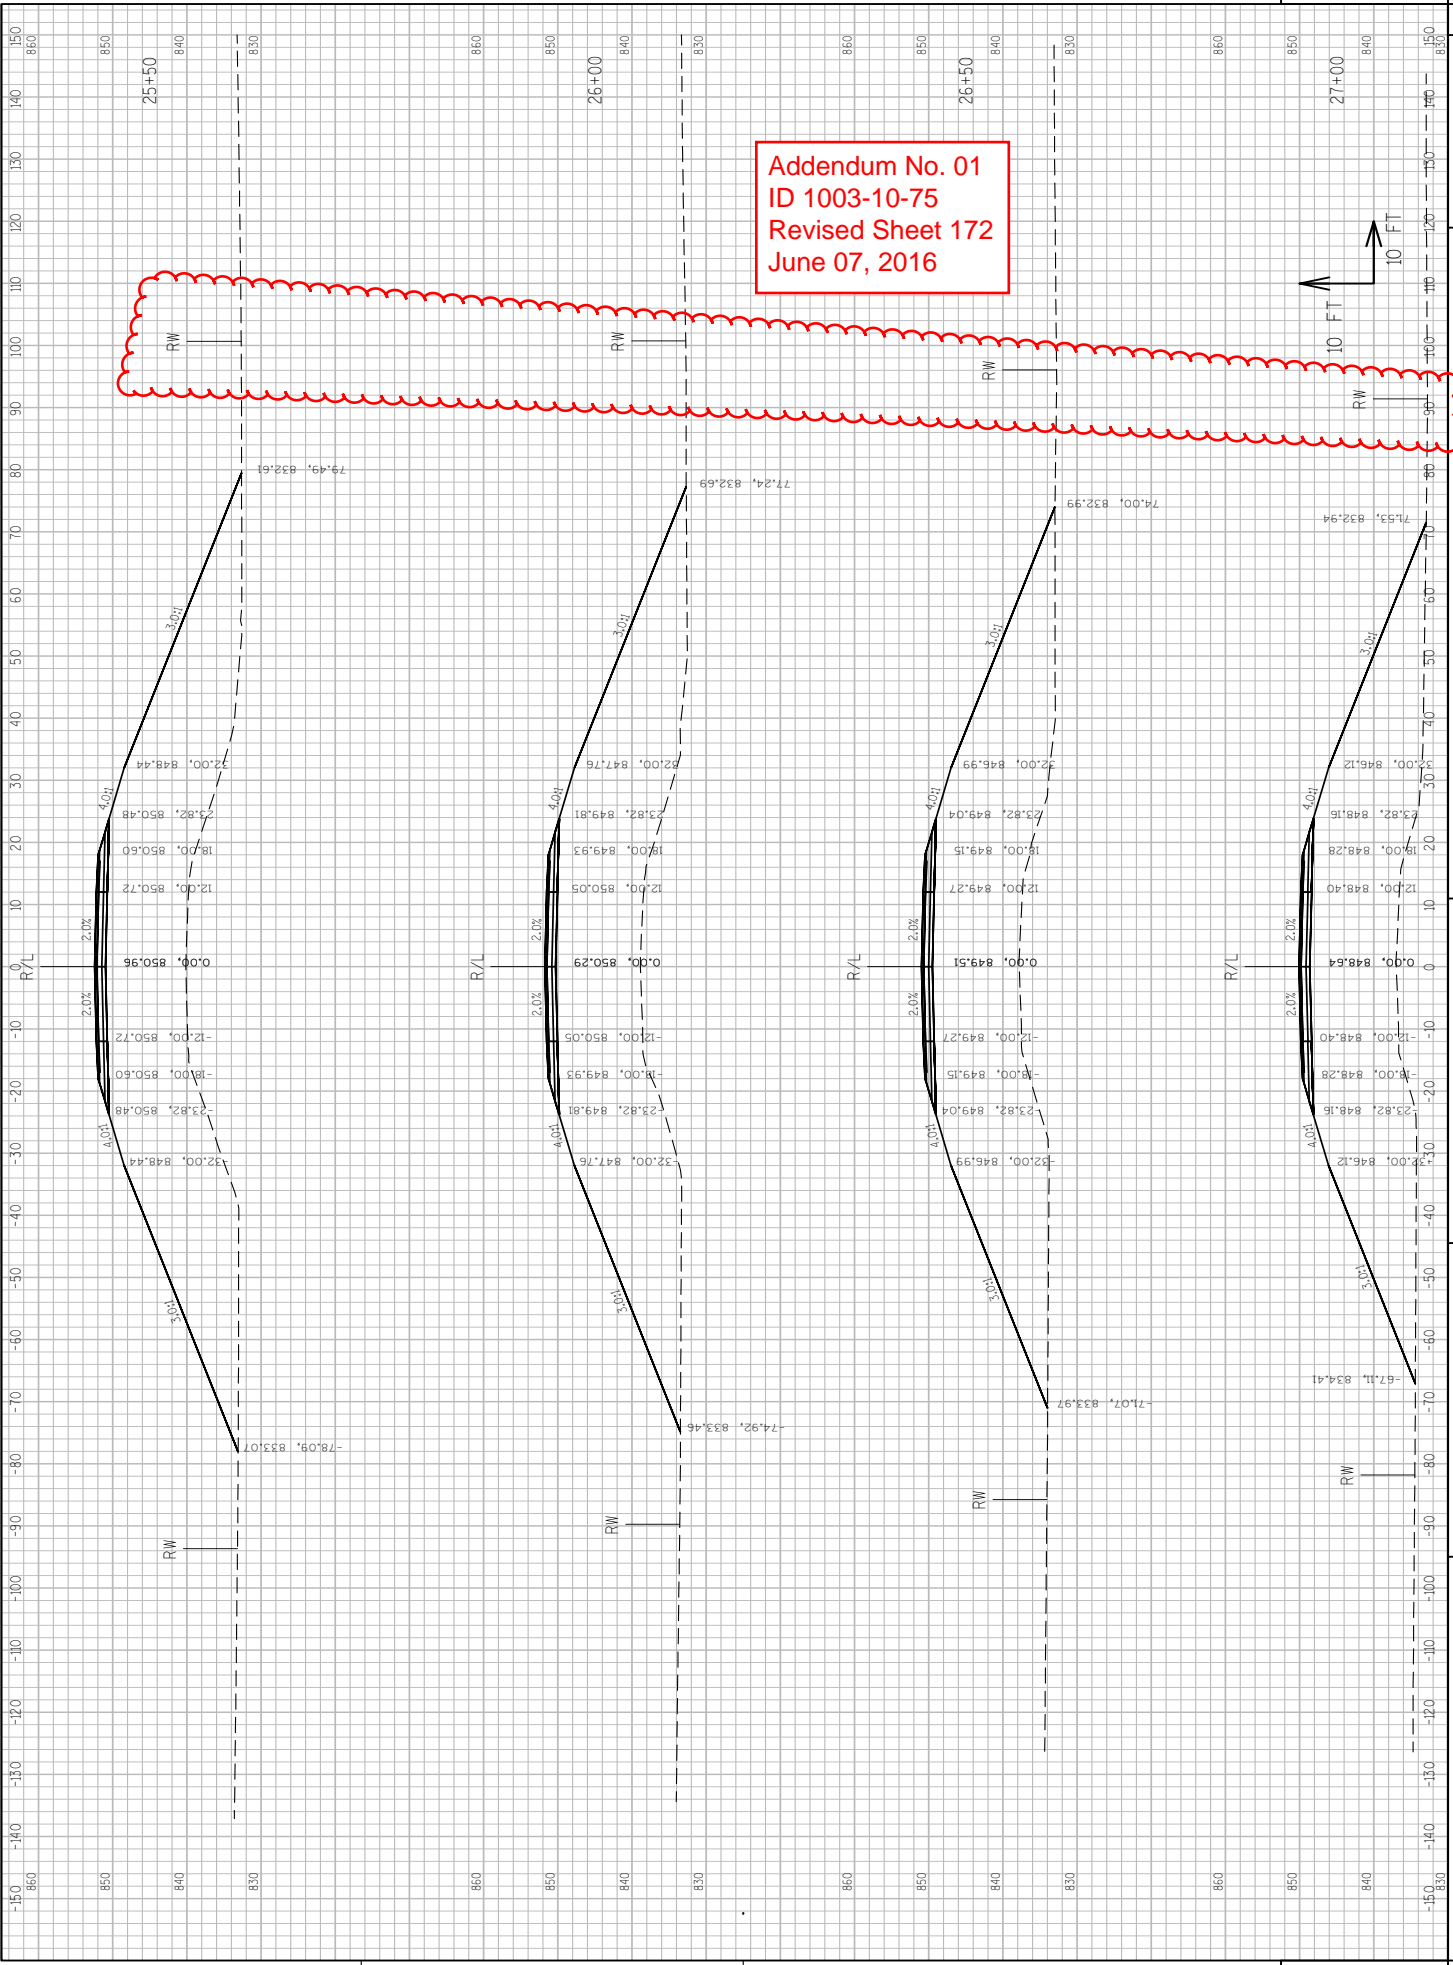


Addendum No. 01  
 ID 1003-10-75  
 Revised Sheet 172  
 June 07, 2016




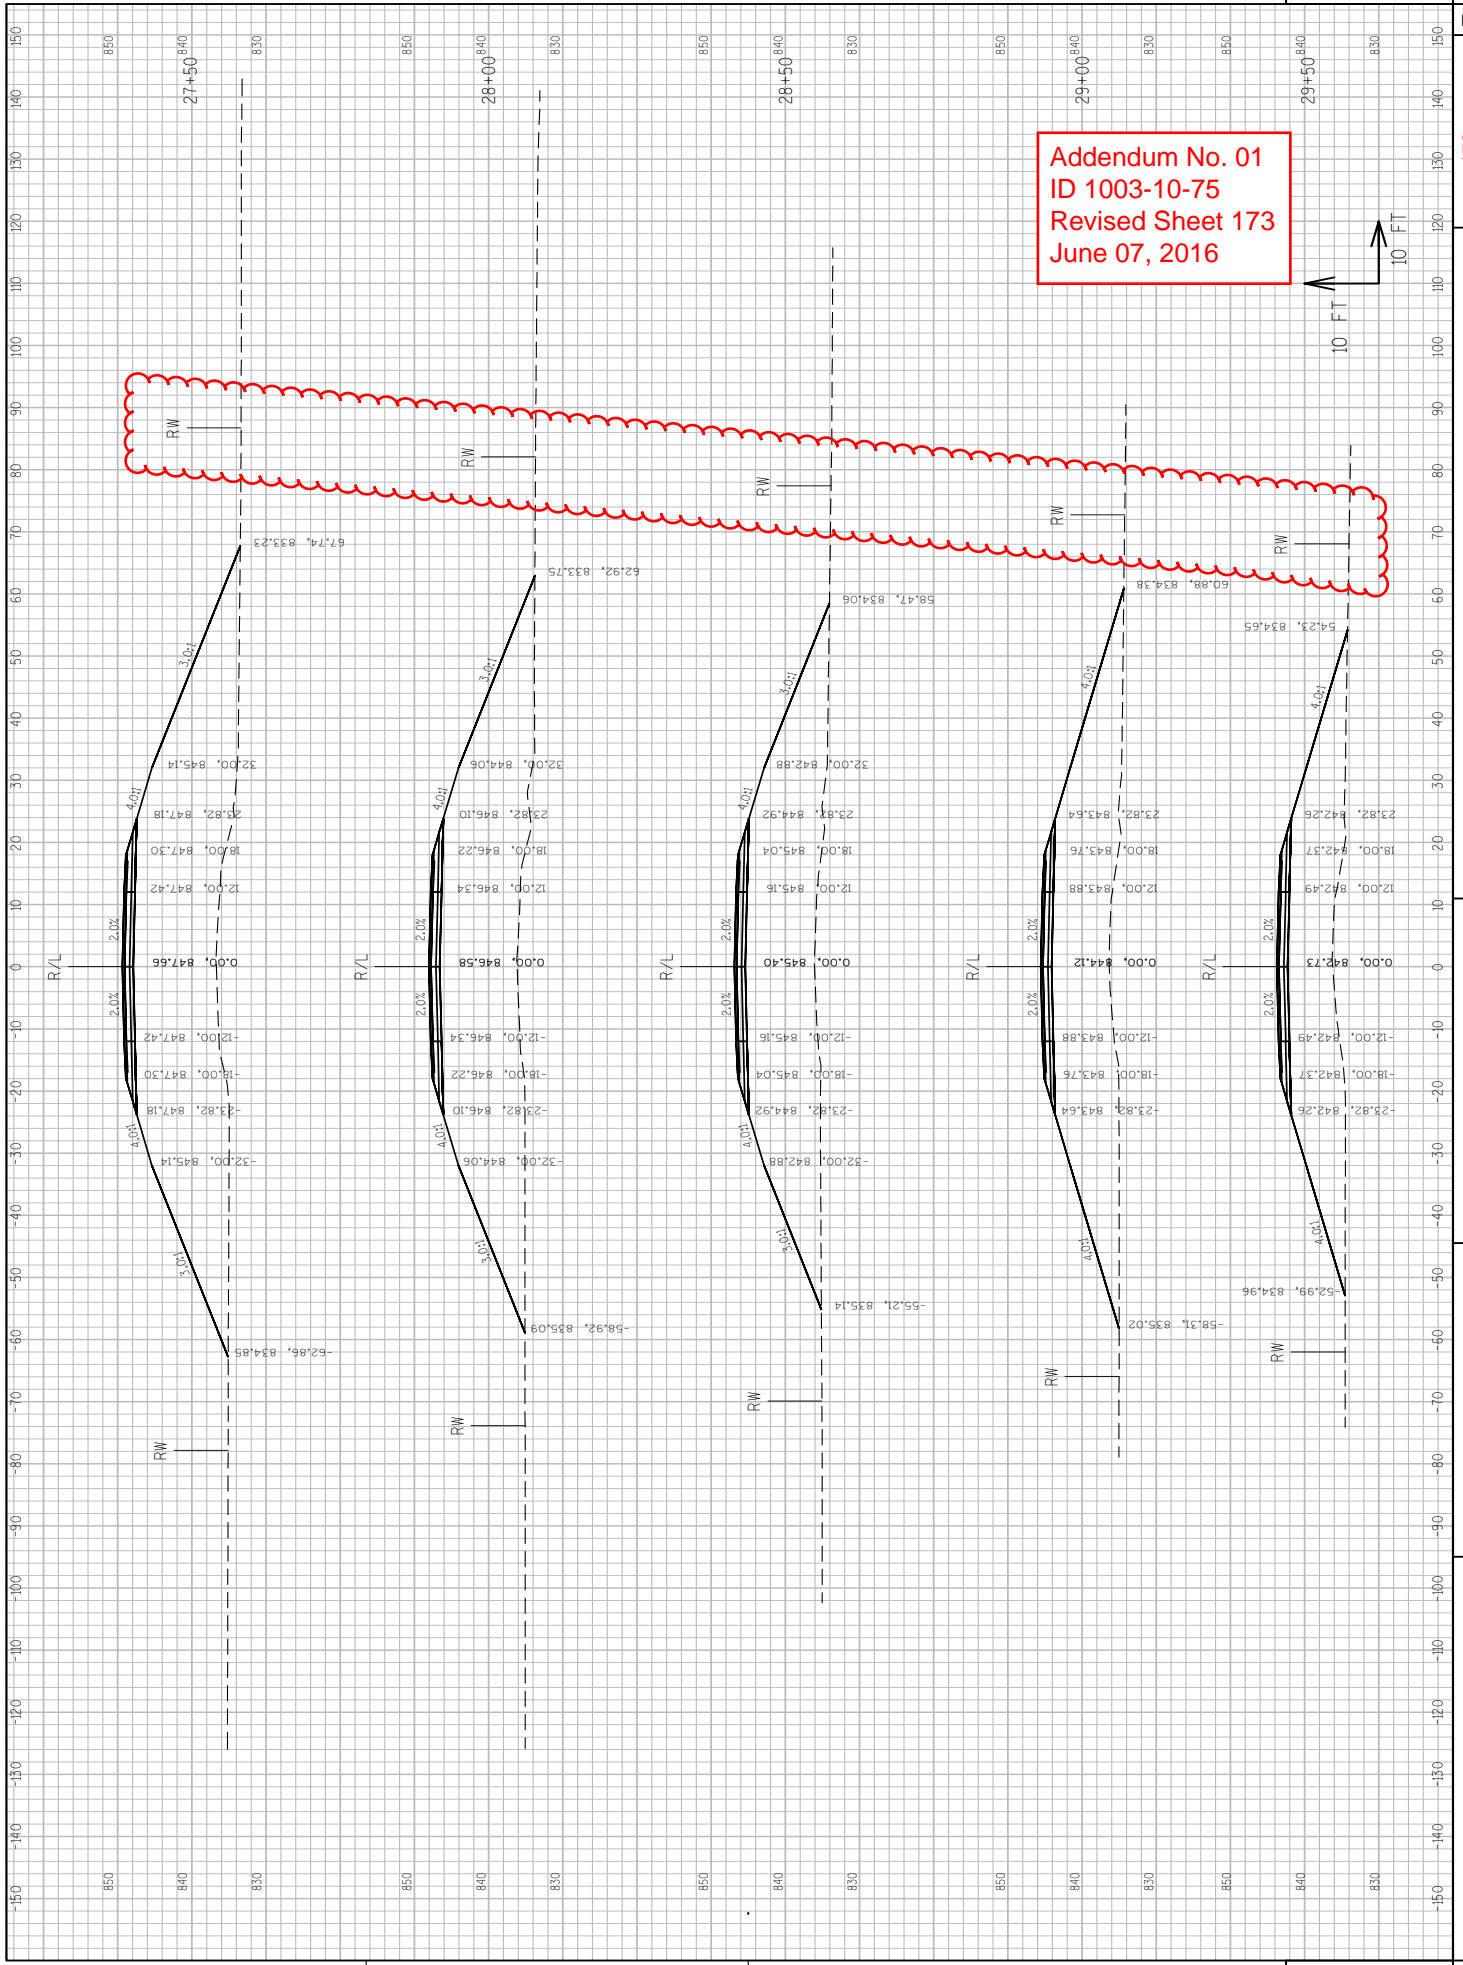

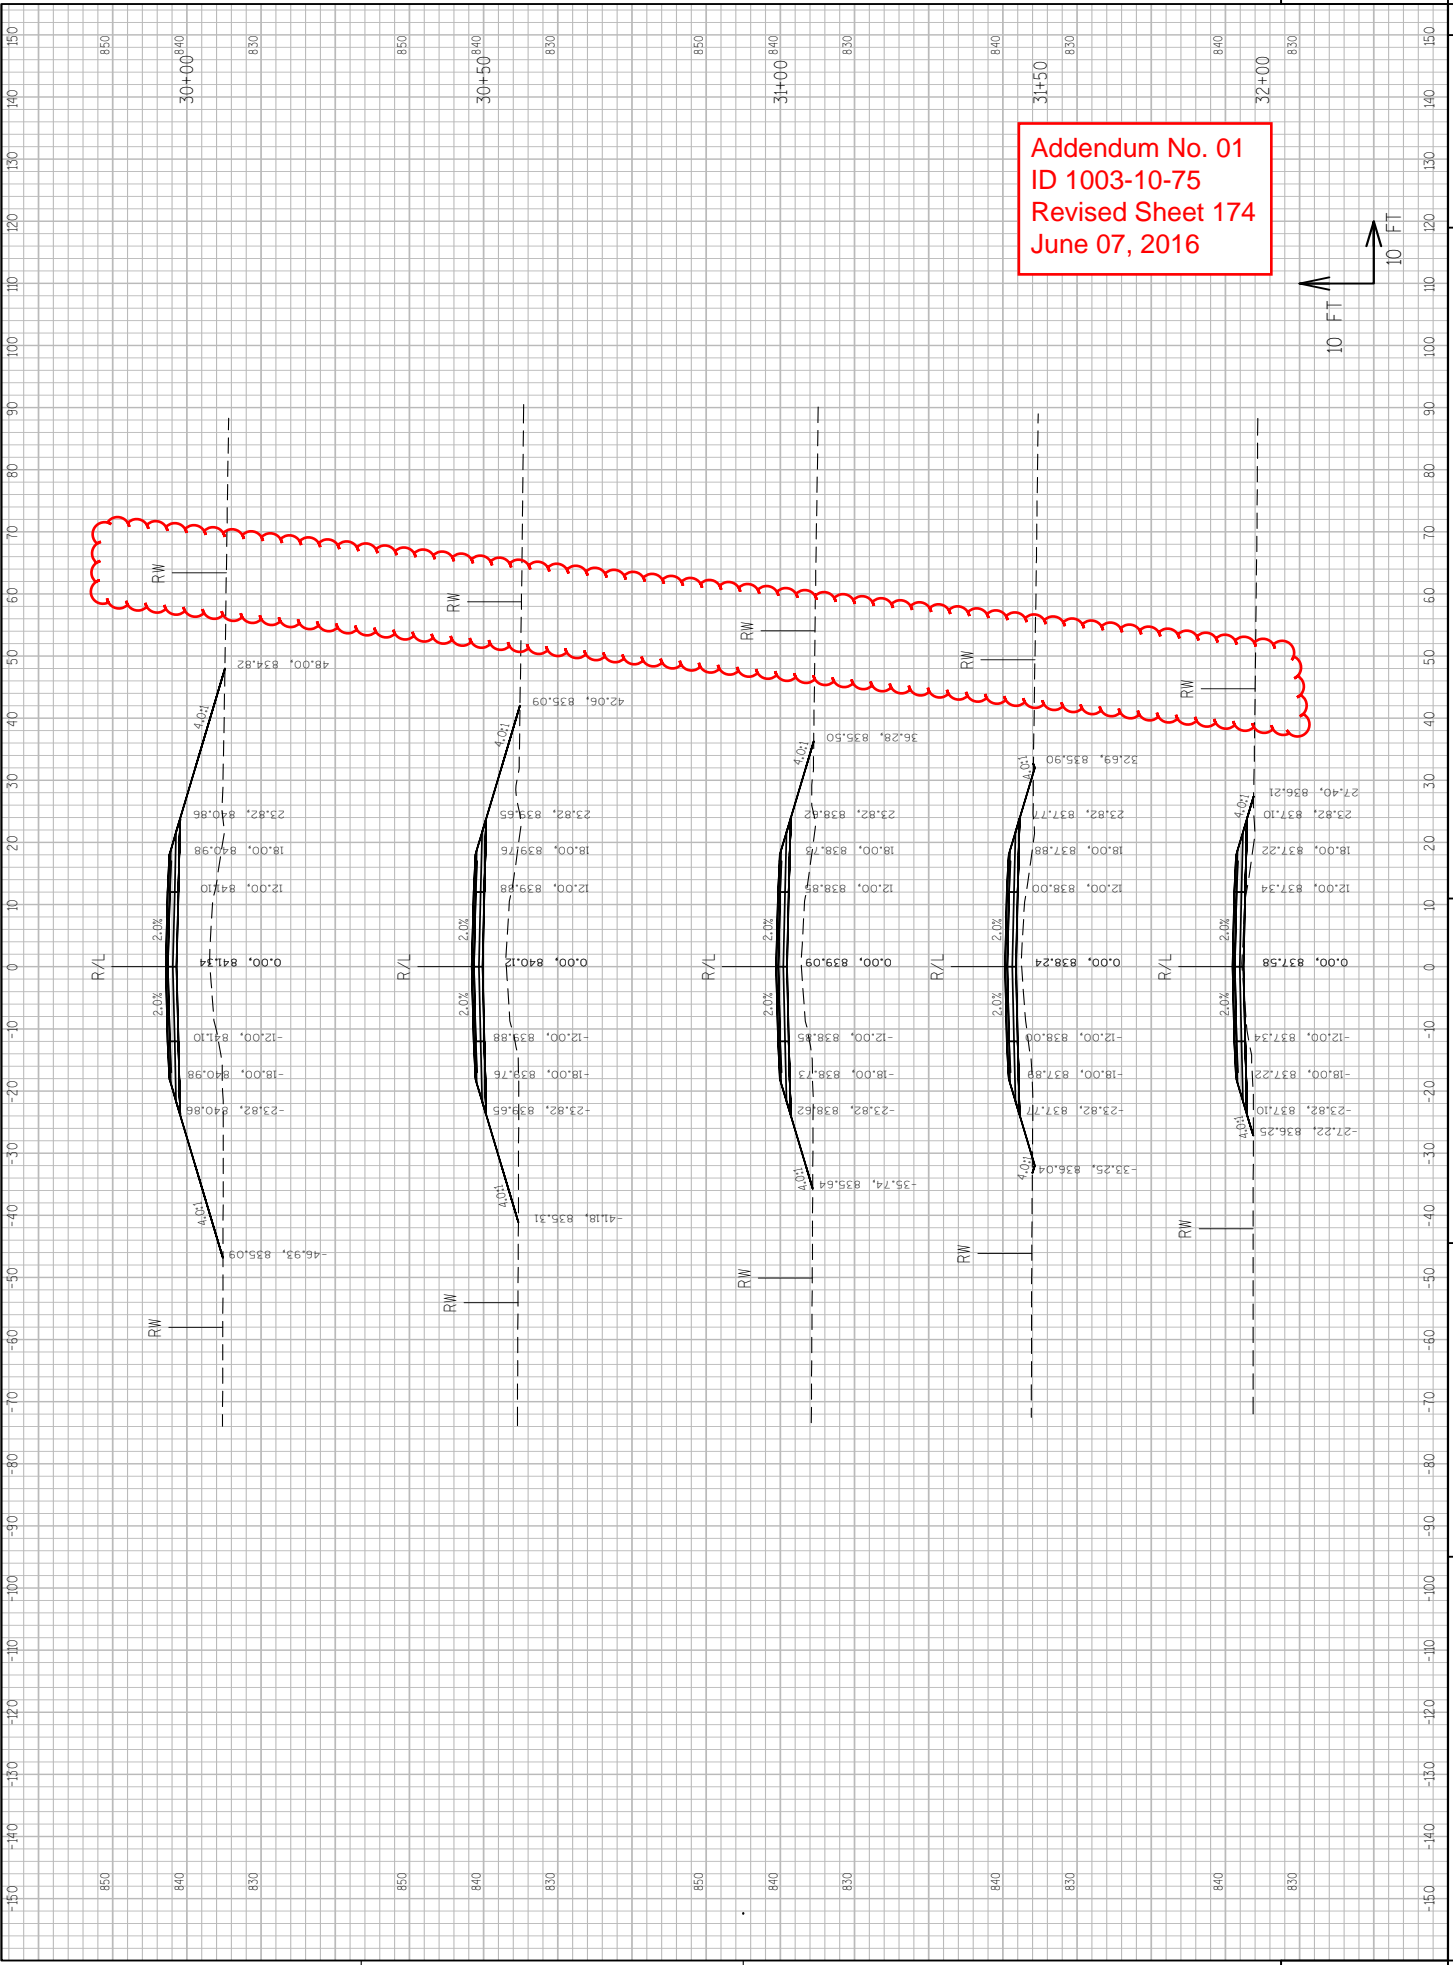


Addendum No. 01  
 ID 1003-10-75  
 Revised Sheet 174  
 June 07, 2016

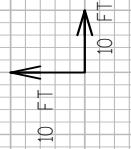

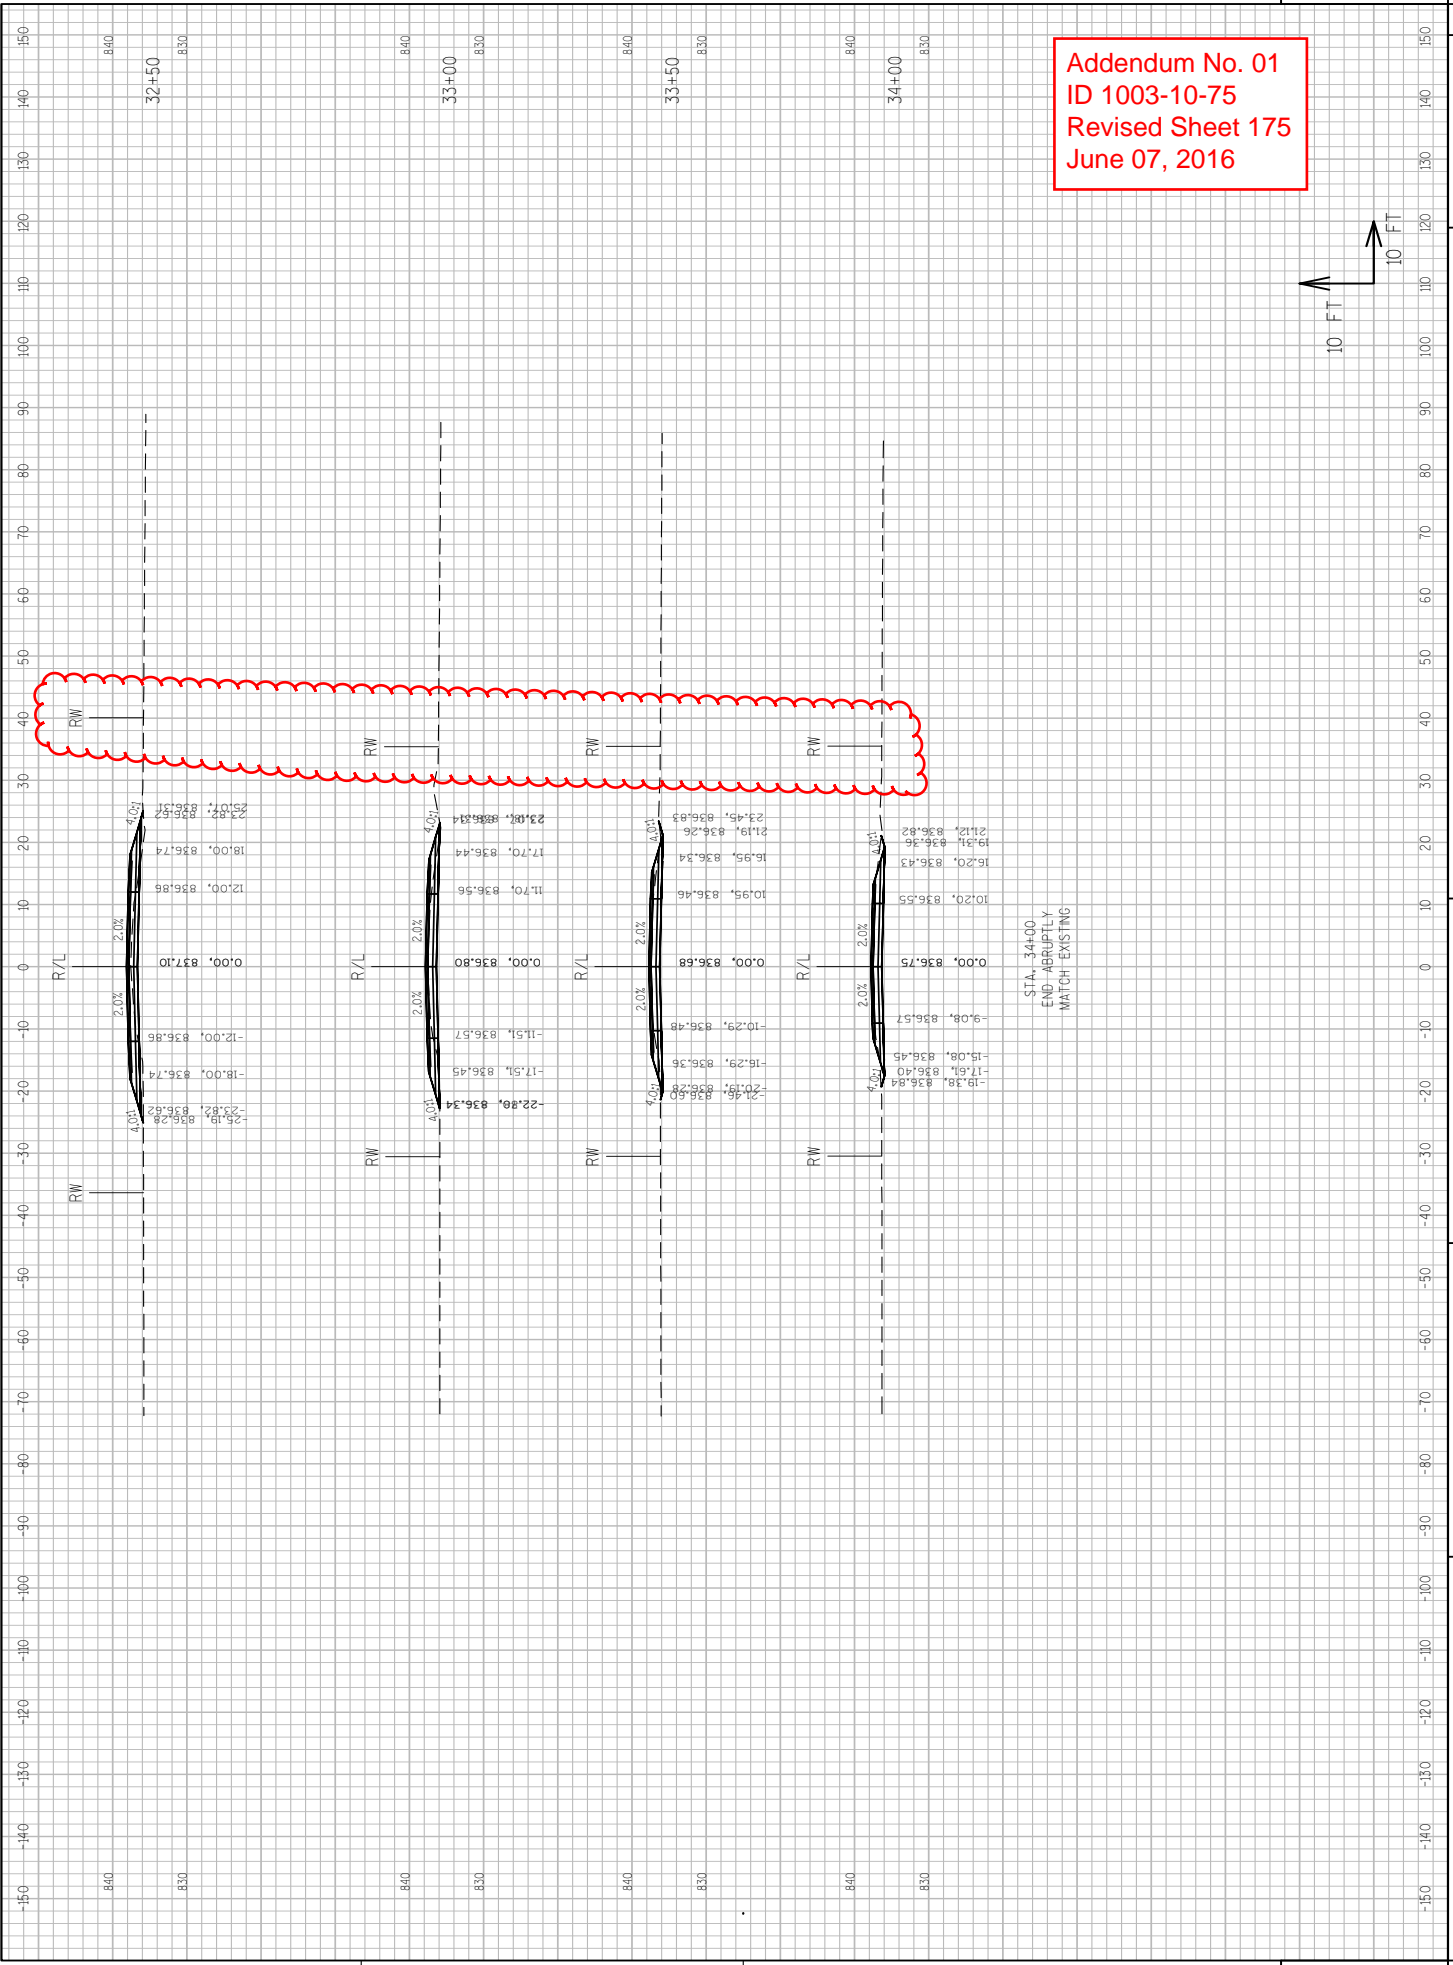

Addendum No. 01  
 ID 1003-10-75  
 Revised Sheet 175  
 June 07, 2016

STA. 34+00  
 END ABRUPTLY  
 MATCH EXISTING

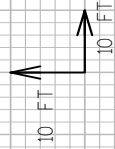

FEDERAL PROJECT	CONTRACT
STATE PROJECT	PROJECT
1003-10-77	

Addendum No. 01  
ID 1003-10-77  
Revised Sheet 1  
June 07, 2016

STATE OF WISCONSIN  
DEPARTMENT OF TRANSPORTATION  
PLAN OF PROPOSED IMPROVEMENT  
ILLINOIS STATE LINE - MADISON  
CTH S TO STH 11  
IH 39  
ROCK COUNTY

STATE PROJECT NUMBER  
**1003-10-77**

ORDER OF SHEETS

- Section No. 1 Title
- Section No. 2 Typical Sections and Details
- Section No. 3 Estimate of Quantities
- Section No. 3 Miscellaneous Quantities
- Section No. 4 Right-of-Way Sheet
- Section No. 5 Plan and Profile
- Section No. 6 Standard Detail Drawings
- Section No. 7 Sign Plates
- Section No. 8 Structure Details
- Section No. 9 Computer Earthwork Data
- Section No. 9 Cross Sections

TOTAL SHEETS \* - - -




DESIGNATION 1003-10-77

A.A.D.T. (2016)	= 52,900
A.A.D.T. (2018)	= 56,500
D.R.V. (2015)	= 5,590
T (70 MPH)	= 35.72
DESIGN SPEED	= 70 MPH
ESALS	= 7,523,700

CONVENTIONAL SYMBOLS

- PLAN
- CORPORATE LIMITS
- PROPERTY LINE
- LOT LINE
- LIMITED HIGHWAY EASEMENT
- EXISTING RIGHT OF WAY
- PROPOSED OR NEW R/W LINE
- SLOPE INTERCEPT
- REFERENCE LINE
- EXISTING CULVERT
- PROPOSED CULVERT (BOX OR PIPE)
- COMBUSTIBLE FLUIDS
- MARSH AREA
- WOODED OR SHRUB AREA
- PROFILE
- GRADE LINE
- ORIGINAL GROUND
- MARSH OR ROCK PROFILE (To be noted as such)
- SPECIAL DITCH
- GRADE ELEVATION
- CULVERT (Profile View)
- UTILITIES
- ELECTRIC
- FIBER OPTIC
- GAS
- SANITARY SEWER
- STORM SEWER
- TELEPHONE
- WATER
- UTILITY PEDESTAL
- POWER POLE
- TELEPHONE POLE

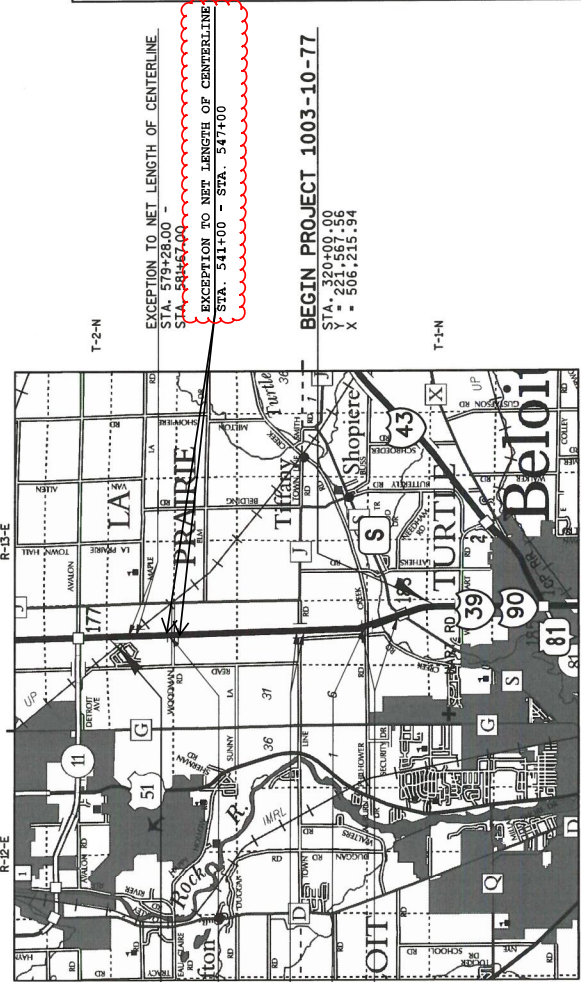

SCALE 0 1.0 MI.  
LAYOUT  
TOTAL NET LENGTH OF CENTERLINE 4.704 MI.  
4.704 MI.

ORIGINAL PLANS PREPARED BY  
**AECOM**  
AECOM, Inc., Suite 100, Middleton, WI 53662  
TEL: 608.838.8800

**PROFESSIONAL ENGINEER**  
JACK K. BARTMAN  
538845  
MADISON, WI

3/11/16 (Date) (Signature)

STATE OF WISCONSIN  
DEPARTMENT OF TRANSPORTATION

PREPARED BY  
AECOM AND COMBS & ASSOCIATES

Supervisor  
Designer  
Project Manager  
Regional Examiner  
Regional Supervisor  
C.O. Examiner


STEVE MARSHALL  
JIM BUSCHKOFF  
KIM SCHAUER

APPROVED FOR THE DEPARTMENT  
DATE: 8/7/2016 (Signature)  
KIM SCHAUER, Regional Administrator

COORDINATES ON THIS PLAN ARE REFERENCED TO THE WISCONSIN COUNTY COORDINATE SYSTEM (WCCS) ROCK COUNTY, MAD 83191. ELEVATIONS SHOWN ON THIS PLAN ARE REFERENCED TO NAV 88 (2007)

GENERAL NOTES


DETAILS OF CONSTRUCTION, MATERIALS AND WORKMANSHIP NOT SHOWN ON THIS DRAWING SHALL CONFORM TO THE PERTINENT REQUIREMENTS OF THE STANDARD SPECIFICATIONS, APPLICABLE SPECIAL PROVISIONS AND THE MANUAL ON UNIFORM TRAFFIC CONTROL DEVICES.

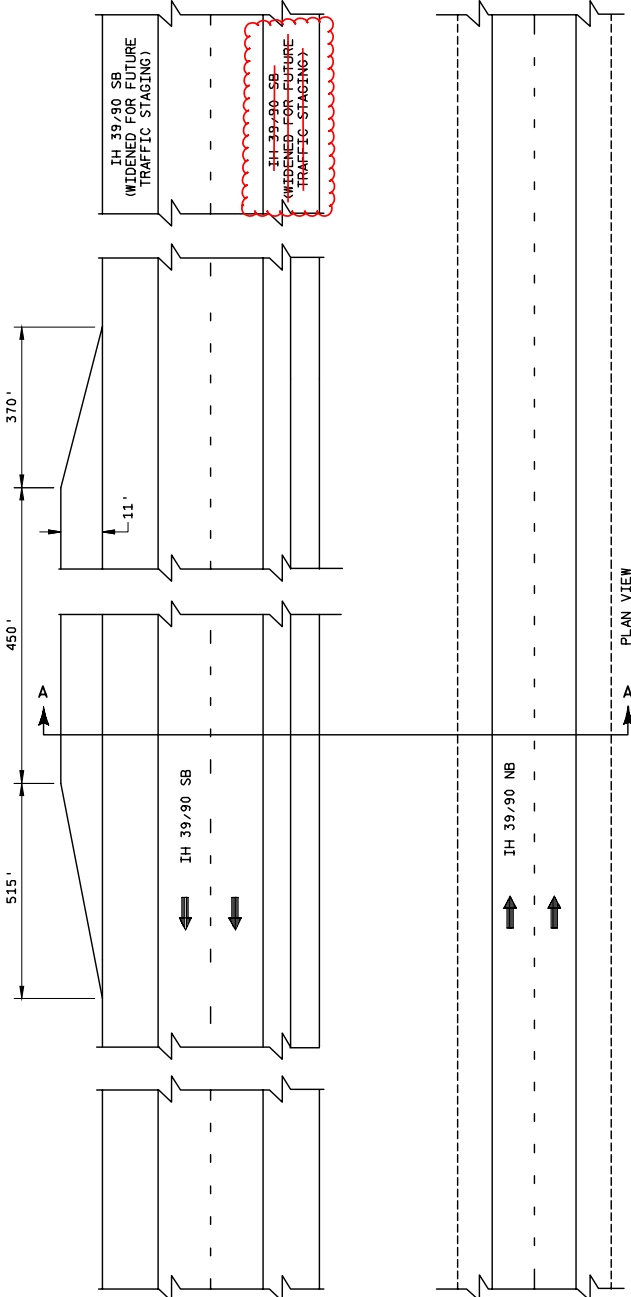

Addendum No. 01  
ID 1003-10-77  
Revised Sheet 12  
June 07, 2016

LEGEND

- ① 6.5" NEW CONSTRUCTION  
2.5" HMA PAVEMENT 4 HT 58-28 H (UPPER LAYER)  
4.0" HMA PAVEMENT 2 HT 58-28 S (LOWER LAYER)
- ② BASE AGGREGATE DENSE 3/4-INCH
- ③ 17" BASE AGGREGATE DENSE 1 1/4-INCH
- (X) SAW CUT

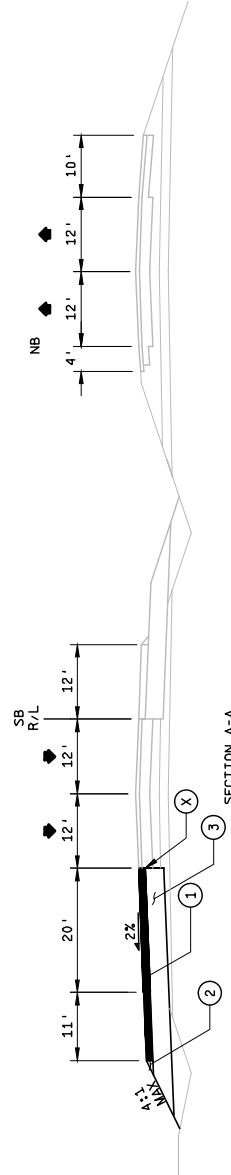

SECTION A-A

TEMPORARY EMERGENCY PULLOUTS

STA. 478+60 - STA. 491+95

PROJECT NO: 1003-10-77

HWY: IH 39

COUNTY: ROCK

PLAN: TEMPORARY EMERGENCY PULLOUTS


SHEET 12

E


RUNOFF COEFFICIENT TABLE

LAND USE:	HYDROLOGIC SOIL GROUP											
	A			B			C			D		
	SLOPE RANGE (PERCENT)	SLOPE RANGE (PERCENT)	SLOPE RANGE (PERCENT)	SLOPE RANGE (PERCENT)	SLOPE RANGE (PERCENT)	SLOPE RANGE (PERCENT)	SLOPE RANGE (PERCENT)	SLOPE RANGE (PERCENT)	SLOPE RANGE (PERCENT)	SLOPE RANGE (PERCENT)	SLOPE RANGE (PERCENT)	
	0-2	2-6	6 & OVER	0-2	2-6	6 & OVER	0-2	2-6	6 & OVER	0-2	2-6	6 & OVER
ROW CROPS	.08	.16	.22	.12	.20	.27	.15	.24	.33	.19	.28	.38
MEDIAN STRIP-	.22	.30	.38	.26	.34	.44	.30	.37	.50	.34	.41	.56
TURF	.19	.20	.24	.19	.22	.26	.20	.23	.30	.20	.25	.30
SIDE SLOPE-	.24	.26	.30	.25	.28	.33	.25	.30	.37	.27	.32	.40
TURF		.25			.27			.28			.30	
PAVEMENT:		.32			.34			.36			.38	
ASPHALT					.70			.95				
CONCRETE					.80			.95				
BRICK					.70			.80				
DRIVES, WALKS					.75			.85				
ROOFS					.75			.95				
GRAVEL ROADS, SHOULDERS					.40			.60				


TOTAL PROJECT AREA = 70.041 ACRES  
 TOTAL AREA EXPECTED TO BE DISTURBED BY CONSTRUCTION ACTIVITIES = 36.078 ACRES

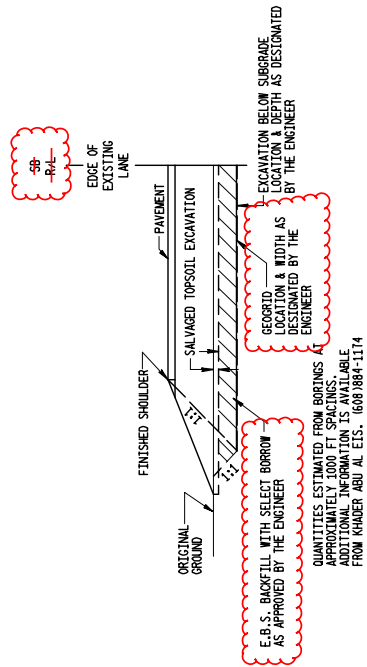

DETAIL FOR EXCAVATION BELOW SUBGRADE  
 THIS DETAIL TO BE USED FOR REMOVAL OF UNSUITABLE MATERIAL.



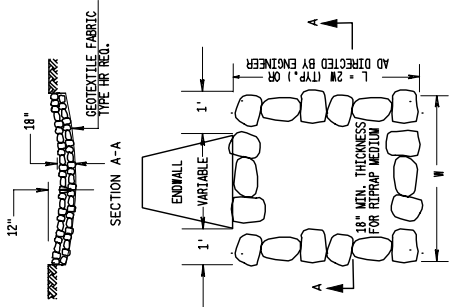


RIPRAP MEDIUM TREATMENT AT CULVERTS

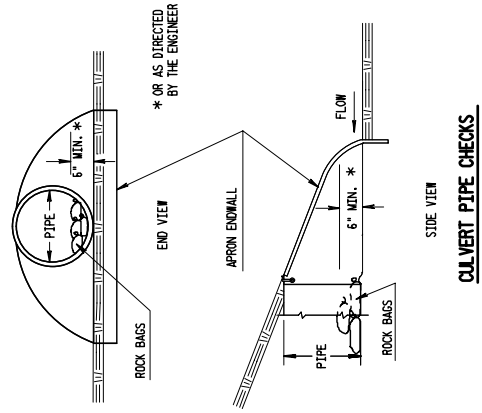


CULVERT PIPE CHECKS

Addendum No. 01  
 ID 1003-10-77  
 Revised Sheet 14  
 June 07, 2016

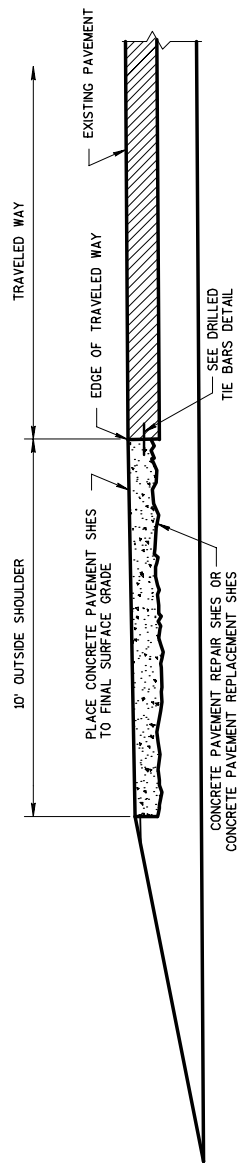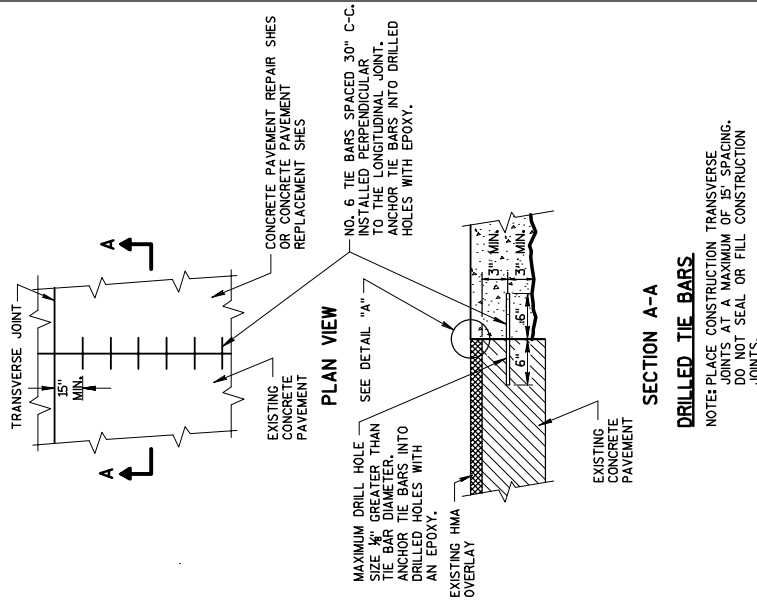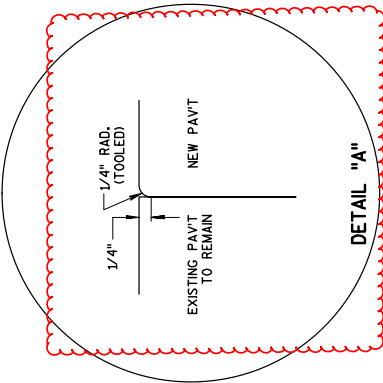

**CONCRETE PAVEMENT REPLACEMENT/REPAIR SHES**


STA. 562+31 - STA. 562+41  
 STA. 563+26 - STA. 563+66  
 STA. 566+28 - STA. 566+68  
 STA. 591+41 - STA. 591+51  
 STA. 592+35 - STA. 592+68

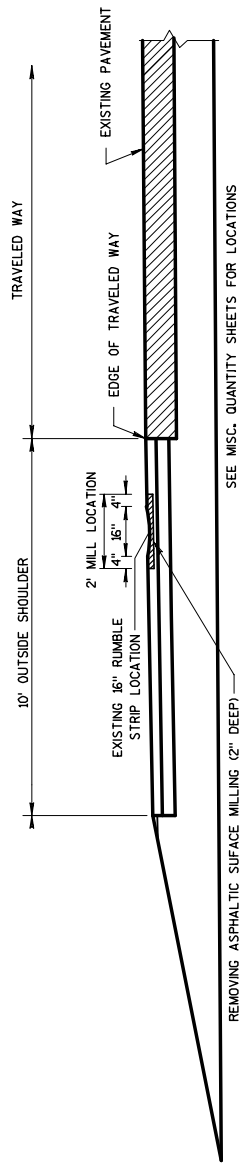

**REMOVING RUMBLE STRIPS - 2' WIDTH**


**OUTSIDE SHOULDER REHABILITATION**

Addendum No. 01  
 ID 1003-10-77  
 Revised Sheet 15  
 June 07, 2016

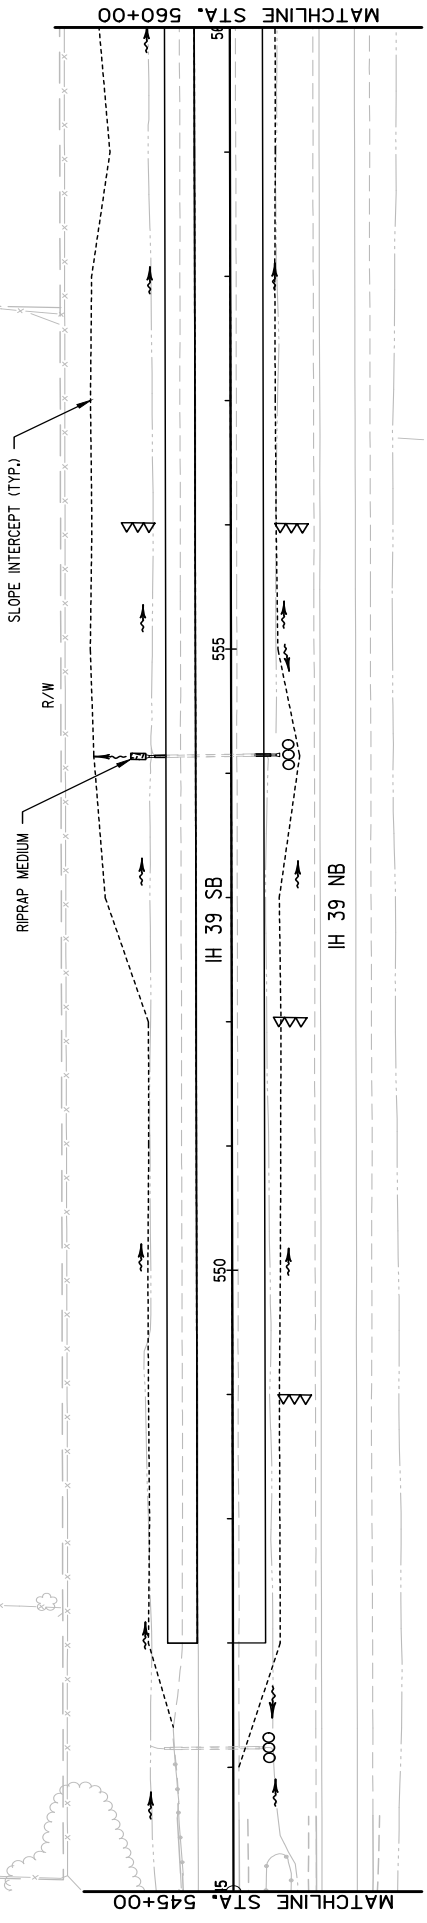

Addendum No. 01  
ID 1003-10-77  
Revised Sheet 29  
June 07, 2016


EROSION CONTROL LEGEND	
###	EROSION MAT CLASS I TYPE B
---	SILT FENCE
~	SURFACE WATER FLOW
OOO	CULVERT PIPE CHECKS
AAA	TEMPORARY DITCH CHECKS
⊠	INLET PROTECTION
⊙	TYPE A
⊙	TYPE B
⊙	TYPE D

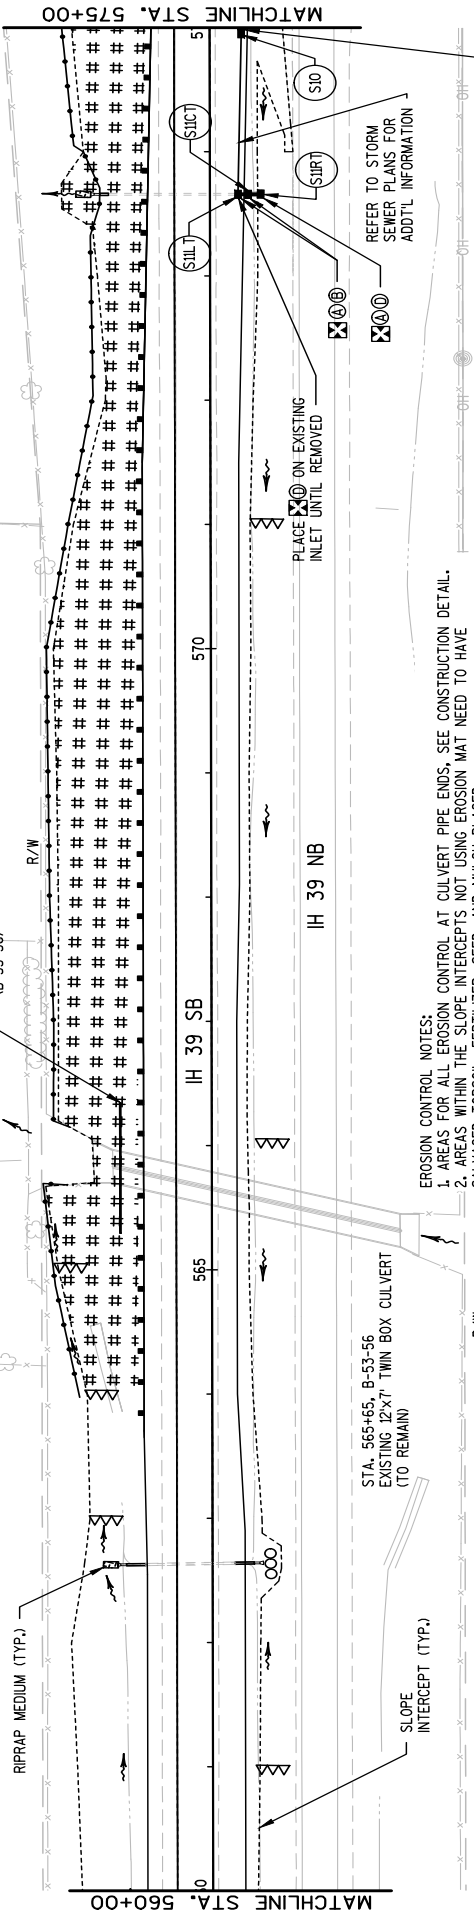

- EROSION CONTROL NOTES:**
1. AREAS FOR ALL EROSION CONTROL AT CULVERT PIPE ENDS, SEE CONSTRUCTION DETAIL.
  2. AREAS WITHIN THE SLOPE INTERCEPTS NOT USING EROSION MAT NEED TO HAVE SALVAGED TOPSOIL, FERTILIZER, SEED, AND MULCH PLACED.
  3. PLACE SILT FENCE AT LEAST 5 FEET FROM SLOPE INTERCEPT LINE WHERE APPLICABLE.
  4. WHEN INLET PROTECTION TYPE A AND TYPE D ARE INDICATED AT THE SAME LOCATION, USE TYPE A PRIOR TO SETTING THE CASTINGS AND PLACE TYPE D AFTER THE INLET CASTINGS ARE IN PLACE.
  5. WHEN INLET PROTECTION TYPE A AND TYPE B ARE INDICATED AT THE SAME LOCATION, USE TYPE A PRIOR TO SETTING THE CASTINGS AND PLACE TYPE B AFTER THE INLET CASTINGS ARE IN PLACE.



Addendum No. 01  
 ID 1003-10-77  
 Revised Sheet 30  
 June 07, 2016

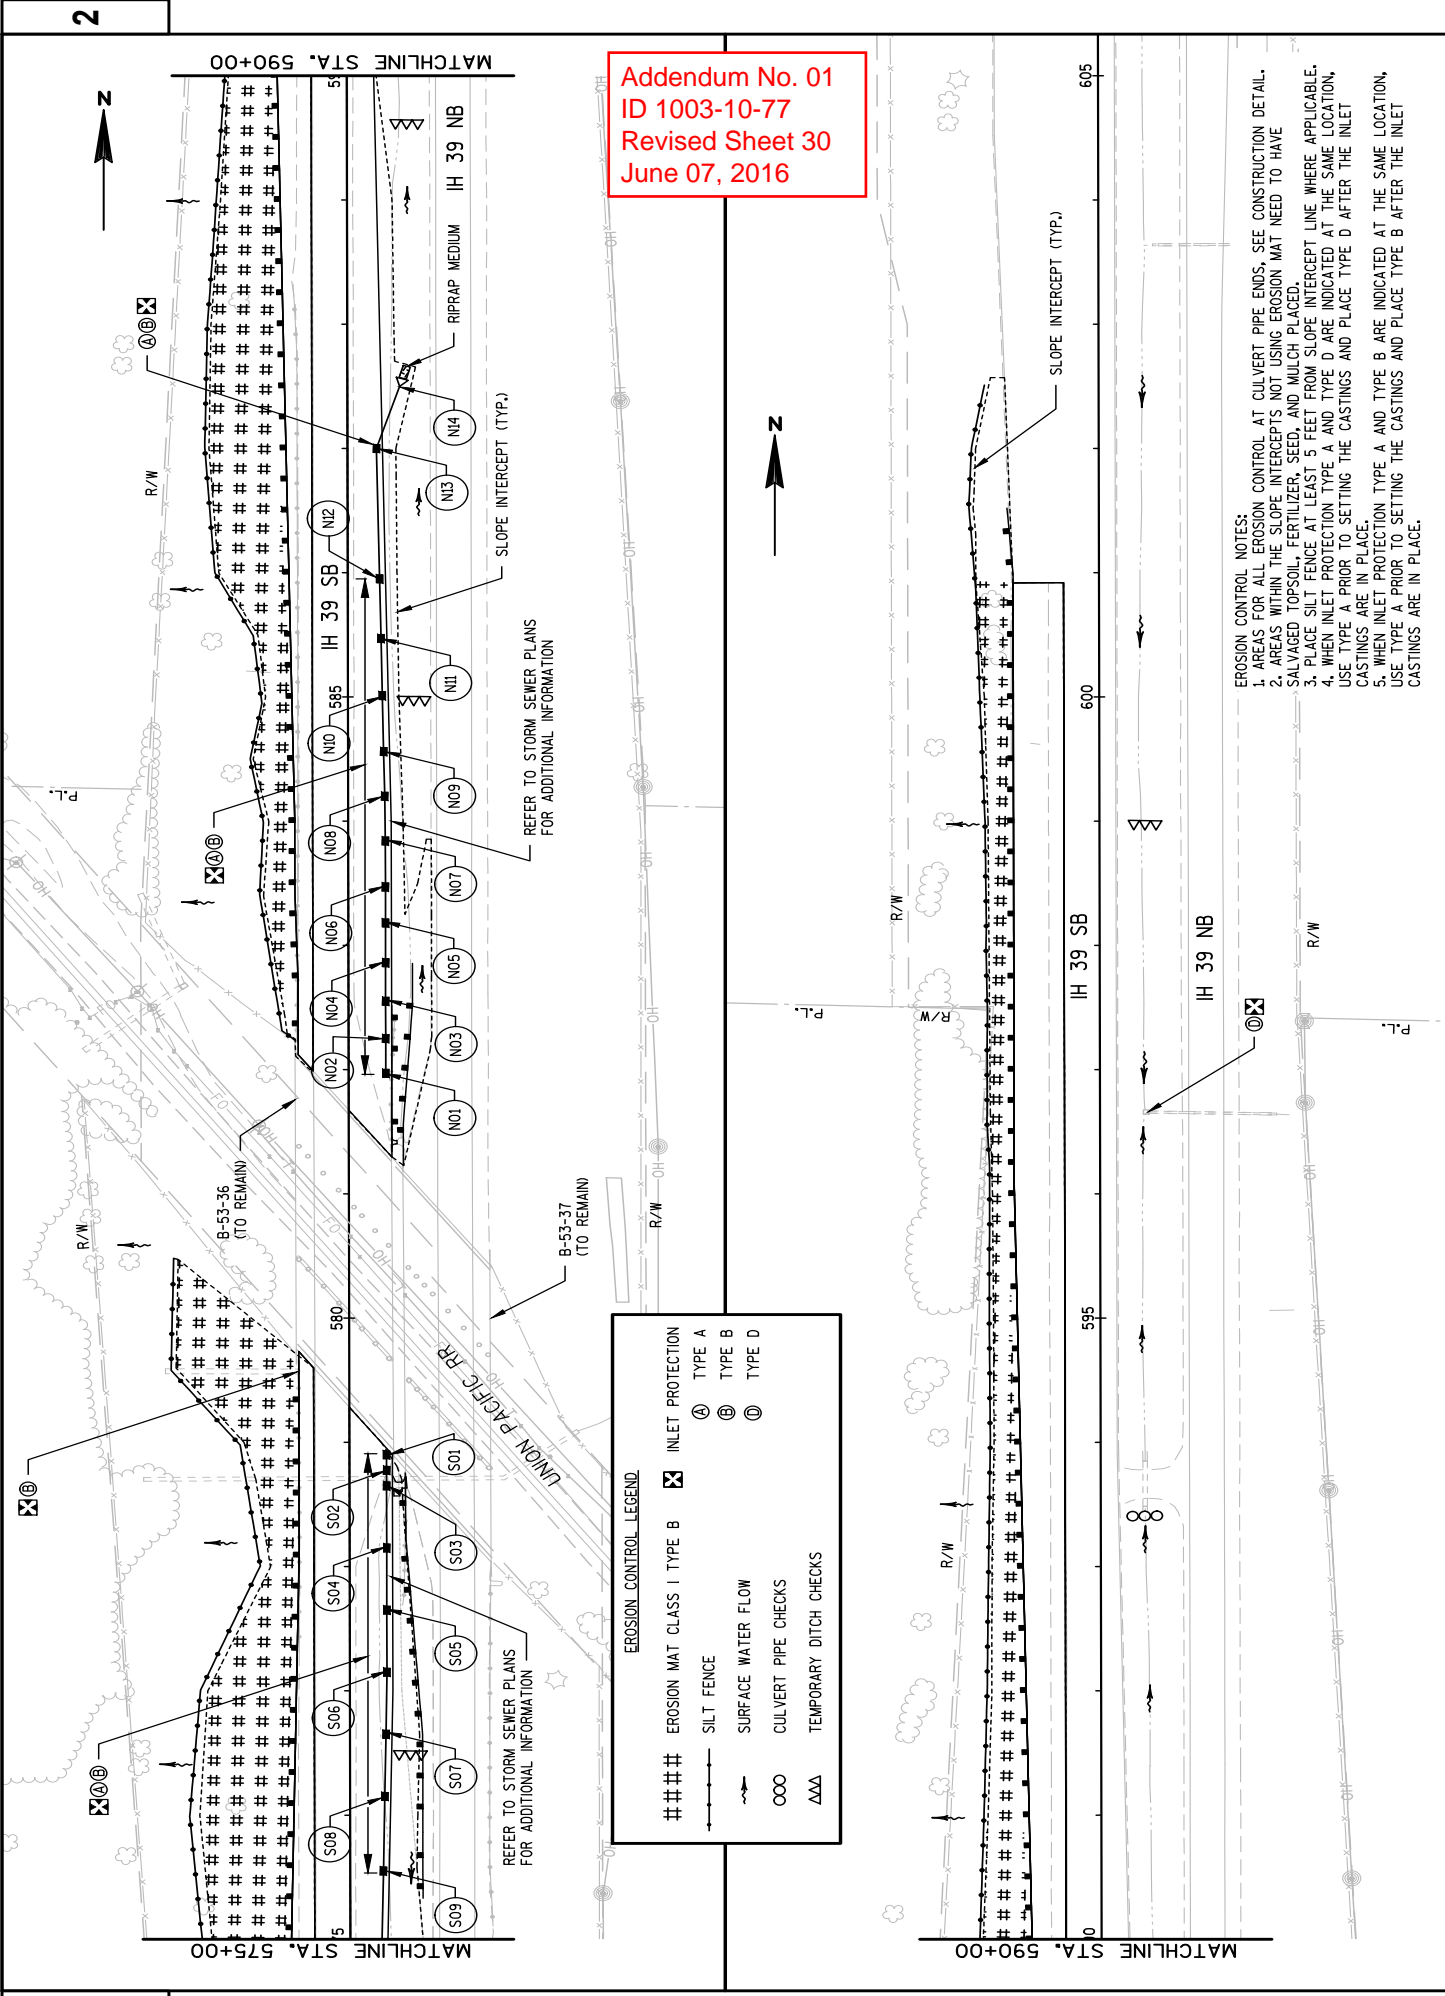

**EROSION CONTROL LEGEND**

###	EROSION MAT CLASS I	⊗	INLET PROTECTION TYPE A
---	SILT FENCE	⊙	INLET PROTECTION TYPE B
~	SURFACE WATER FLOW	⊖	INLET PROTECTION TYPE D
OOO	CULVERT PIPE CHECKS		
AAA	TEMPORARY DITCH CHECKS		

- EROSION CONTROL NOTES:**
1. AREAS FOR ALL EROSION CONTROL AT CULVERT PIPE ENDS, SEE CONSTRUCTION DETAIL.
  2. AREAS WITHIN THE SLOPE INTERCEPTS NOT USING EROSION MAT NEED TO HAVE SALVAGED TOPSOIL, FERTILIZER, SEED, AND MULCH PLACED.
  3. PLACE SILT FENCE AT LEAST 5 FEET FROM SLOPE INTERCEPT LINE WHERE APPLICABLE.
  4. WHEN INLET PROTECTION TYPE A AND TYPE D ARE INDICATED AT THE SAME LOCATION, USE TYPE A PRIOR TO SETTING THE CASTINGS AND PLACE TYPE D AFTER THE INLET CASTINGS ARE IN PLACE.
  5. WHEN INLET PROTECTION TYPE B ARE INDICATED AT THE SAME LOCATION, USE TYPE A PRIOR TO SETTING THE CASTINGS AND PLACE TYPE B AFTER THE INLET CASTINGS ARE IN PLACE.

EARTHWORK (PROJECT 1003-10-77)

Category	Division	From/To Station	Location	Excavation Common (CY) 205.0100		Fill (CY)	Roadway Embankment (CY) SPV/0035.001	Mass Ordinate +/- (5)	Select Borrow (CY) 208.1100	
				Cut (CY) (2)	EBS (CY) (3)					
1000	1	320+00 - 357+50	SB, RT	538	0	68	68	-45	0	
		379+38 - 400+00	SB, RT	206	0	496	496	-290	0	
		400+00 - 456+76	SB, RT	308	0	1,903	1,903	-1,493	0	
		537+00 - 541+50	SB, RT	0	0	66	66	-66	0	
		547+00 - 579+28	SB, RT	3,360	2,487	131	131	3,230	2,487	
		581+29 - 590+00	SB, RT	1,390	805	0	0	1,390	805	
UNDISTRIBUTED				6,192	494	2,676	2,676	3,516	494	
Project 1003-10-77 - Division 1 Subtotal				9,977	3,785	2,676	2,676	3,785	3,785	
Project 1003-10-77 - Division 1 Total										
1000	2	554+08 - 564+14	NB, LT	6	0	0	0	6	0	
		562+00 - 563+00	NB, LT	3	0	2	2	0	0	
		573+08 - 579+28	NB, LT	117	0	6	6	110	0	
		582+85 - 583+85	NB, LT	7	0	0	0	7	0	
		UNDISTRIBUTED				0	0	0	0	0
		Project 1003-10-77 - Division 2 Subtotal				132	0	8	8	124
Project 1003-10-77 - Division 2 Total										
1000	3	320+00 - 357+50	SB, LT	4,380	4,380	3,212	3,212	936	4,380	
		379+38 - 400+00	SB, LT	468	1,666	1,636	1,636	-1,169	1,666	
		400+00 - 470+00	SB, LT	3,969	4,837	4,332	4,332	-2,432	4,837	
		470+00 - 541+50	SB, LT	7,665	7,125	3,660	3,660	4,005	7,125	
		547+00 - 579+73	SB, LT	6,463	373	8,607	8,607	-2,144	373	
		582+00 - 601+02	SB, LT	2,124	186	3,537	3,537	-1,413	186	
UNDISTRIBUTED				9	2,785	9	0	2,785		
Project 1003-10-77 - Division 3 Subtotal				27,915	21,352	24,983	24,983	21,352		
Project 1003-10-77 - Division 3 Total				49,267	21,352	24,983	24,983	21,352		

Addendum No. 01  
ID 1003-10-77  
Revised Sheet 60  
June 07, 2016

EARTHWORK (PROJECT 1003-10-77) CONTINUED

Category	Division	From/To Station	Location	Excavation Common (CY) (1) 205.0100		Fill (CY)	Roadway Embankment (CY) (4) SPV.00335.001	Mass Ordinate +/- (5)	Select Borrow (CY) 208.1100
				Cut (CY) (2)	EBS (CY) (3)				
1000	4	10+53.7ZA - 18+00.7ZA	TZA LOOP RAMP	7	0	16,807	16,807	-16,800	0
		8+50.7ZB - 20+50.7ZB		243	0	936	936	-693	0
		UNDISTRIBUTED		50	0	0	0	50	0
Project 1003-10-77 - Division 4 Subtotal				300	0	17,743	17,743	-17,443	0
Project 1003-10-77 - Division 4 Total				300	0	17,743	17,743	-17,443	0
Project 1003-10-77 Totals				59,616		45,410		25,137	

Addendum No. 01  
ID 1003-10-77  
Revised Sheet 61  
June 07, 2016

- Excavation Common = Cut + EBS Excavation. Item number 205.0100.
- Cut volume includes concrete and asphaltic surface material.
- EBS Excavation to be backfilled with Select Borrow.
- Roadway Embankment (Fill)
- The Mass Ordinate is calculated by division. A positive quantity indicates an excess of material within the Division and a negative quantity indicates a shortage of material within the Division. Structure Excavation is not included in this calculation. Mass Ordinate = Cut - Fill. The Mass Ordinate is for information purposes only. Excavation and Roadway Embankment are not balanced for quantity purposes and does not guarantee the quality of Common Excavation, and if it can be reused onsite. All EBS material is to be wasted offsite.

BASE AGGREGATE DENSE

STAGE	STATION	STATION	LOCATION	211.0500 PREPARE FOUNDATION FOR BASE AGGREGATE (STA)	305.0110 BASE AGGREGATE DENSE 3/4-INCH (TON)	305.0120 BASE AGGREGATE DENSE 1 1/4-INCH (TON)	312.0110 SELECT CRUSHED MATERIAL (TON)	*624.0100 WATER (MGAL)	COMMENTS	
2	9+25'TZB'	20+94'TZB'		--	155		7355	130	CTH S CROSSOVER	
	10+60'TZA	17+75'TZA		--	--		--	17	CTH S LOOP ON RAMP	
	320+00	345+46	RT	25						
	352+11	355+20	RT	3						
	355+20	357+00	RT	2		130				
	379+38	437+31	RT	58						
	438+35	439+19	RT	1		290				
	439+19	456+74	RT	18						
	537+19	541+00	RT	4						
	546+00	578+90	IH 39 SB, RT	--	280	9500			98	
3	572+18	578+80	IH 39 NB, LT	--	290	300			6	
	581+29	590+00	IH 39 SB, RT	--	75	2880			30	
	STAGE 2 TOTAL				110	810	20330	7355		285
	320+00	336+31	LT	--	56	3,380			34	
	338+59	357+00	LT	--	58	5,495			56	
	379+38	437+31	LT	--	750	16,035			168	
	438+35	541+00	LT	--	1,149	28,760			299	
	478+60	491+95	LT	--	62	1,680			17	
	546+32	579+73	IH 39 SB, LT	--	320	8715			90	
	582+00	602+45	IH 39 SB, LT	--	230	6050			63	
STAGE 3 TOTAL				0	2615	70065	0		727	
UNDISTRIBUTED					345	9790	730		100	
PROJECT TOTAL				110	3750	99400	8105		1100	

\* ADDITIONAL QUANTITIES LISTED ELSEWHERE.

Addendum No. 01  
 ID 1003-10-77  
 Revised Sheet 62  
 June 07, 2016

TEMPORARY SHORING LEFT IN PLACE

STAGE	STATION	STATION	LOCATION	TEMPORARY SHORING LEFT IN PLACE (SF)
3	566+30	566+35	LT	715
STAGE 3 TOTAL				715
PROJECT TOTALS				715

CONCRETE PAVEMENT

STAGE	STATION	STATION	LOCATION	DRILLED TIE BARS (EACH)	CONCRETE PAVEMENT REPLACEMENT SHES (SY)	CONCRETE PAVEMENT REPAIR SHES (SY)	CONCRETE PAVEMENT SAWING CONCRETE (LF)
1	582+31	582+41	LT	--	--	12	30
1	583+26	583+66	LT	15	45	--	60
1	586+28	586+68	LT	15	45	--	60
1	591+41	591+51	LT	--	--	12	30
1	592+35	592+68	LT	12	37	--	53
UNDISTRIBUTED				10	25	5	50
STAGE 1 TOTAL				52	152	29	283
PROJECT TOTALS				52	152	29	283

HIMA PAVEMENT ITEMS

\*ADDITIONAL QUANTITIES SHOWN ELSEWHERE

STAGE	STATION	STATION	LOCATION	PAVEMENT DEPTH (INCHES)	PAVEMENT 2 HT 58-28 S (TON)	PAVEMENT 4 HT 58-28 H (TON)	TACK COAT (GAL)	ASPHALTIC FLUMES (SY)	COMMENTS
1	547+00	579+59	RUMBLE, LT	2.0	--	80	--	--	
	582+00	600+92	RUMBLE, LT	2.0	--	45	--	--	
STAGE 1 TOTAL					0	125		0	
2	320+00	345+46	RT	6.5	635	440	70	--	
	9+25 'TZB'	20+94 'TZB'		6.5	240	170	--	--	CTH S OFF RAMP
	352+11	357+00	RT	6.5	135	90	15	--	
	379+38	437+31	RT	6.5	1,635	1,105	175	--	
	438+35	456+74	RT	6.5	595	400	65	--	
	537+19	541+00	RT	6.5	95	65	10	--	
	578+65		RT	--	--	--	--	10	
	581+41		RT	--	--	--	--	3	
	547+00	579+29	RT	6.5	1,740	1,090	545	--	
	581+30	595+00	RT	6.5	535	335	165	--	
STAGE 2 TOTAL					5,610	3,695	1,045	13	
3	320+00	336+31	LT	6.5	680	470	10	--	
	338+59	357+00	LT	6.5	1,205	785	130	--	
	379+38	437+31	LT	6.5	2,860	1,875	305	--	
	438+35	541+00	LT	6.5	4,995	3,245	560	--	
	478+60	491+95	LT	6.5	255	180	25	--	EMERGENCY PULLOUT
	547+00	579+73	LT	6.5	1,560	975	490	--	
	582+00	600+92	LT	6.5	1,155	720	360	--	
STAGE 3 TOTAL					12,710	8,250	1,880	0	
PROJECT TOTALS					18,300	12,050	3,010	13	

Addendum No. 01  
ID 1003-10-77  
Revised Sheet 63  
June 07, 2016

Addendum No. 01  
ID 1003-10-77  
Revised Sheet 64  
June 07, 2016

STAGE	STATION	LOCATION	REINFORCED CONCRETE										520.8000		COMMENTS	
			522.0118 CLASS III 18-INCH (LF)	522.0318 CLASS IV 18-INCH (LF)	522.0324 CLASS IV 24-INCH (LF)	522.0348 CLASS IV 48-INCH (LF)	522.0354 CLASS IV 54-INCH (LF)	522.0518 CLASS V 18-INCH (LF)	522.1012 12-INCH (EACH)	522.1018 18-INCH (EACH)	522.1024 24-INCH (EACH)	522.1048 48-INCH (EACH)	522.1054 54-INCH (EACH)	CONCRETE COLLARS FOR PIPE (EACH)		*633.5200 MARKERS CULVERT END (EACH)
3	324+89	LT	--	--	--	23	--	--	--	--	1	--	1	1	1	
3	326+86	LT	--	--	--	--	--	--	--	--	--	--	--	--	1	1
2	326+86	RT	--	--	--	--	--	--	--	--	--	--	--	--	1	1
3	356+86	LT	15	--	--	--	--	--	--	--	--	--	--	--	1	1
2	356+86	RT	--	6	--	--	--	--	--	--	--	--	--	--	1	1
3	390+91	LT	--	--	14	--	--	--	--	1	--	--	--	--	1	1
3	401+91	LT	--	11	--	--	--	--	--	1	--	--	--	--	1	1
3	409+91	LT	--	--	15	--	--	--	--	1	--	--	--	--	1	1
3	420+93	LT	--	--	--	--	--	--	8	1	--	--	--	--	1	1
3	426+92	LT	--	--	--	--	--	--	12	1	--	--	--	--	1	1
3	426+87	LT	--	--	--	--	--	13	--	--	--	--	1	--	1	1
3	426+95	LT	--	--	--	--	--	14	--	--	--	--	1	--	1	1
3	443+91	LT	--	--	10	--	--	--	--	1	--	--	--	--	1	1
3	454+91	LT	--	15	--	--	--	--	--	1	--	--	--	--	1	1
3	467+92	LT	--	--	11	--	--	--	--	1	--	--	--	--	1	1
3	475+91	LT	--	--	12	--	--	--	--	1	--	--	--	--	1	1
3	486+91	LT	--	--	22	--	--	--	--	1	--	--	--	--	1	1
3	496+91	LT	--	--	12	--	--	--	--	1	--	--	--	--	1	1
3	504+41	LT	--	--	--	--	--	--	12	1	--	--	--	--	1	1
3	517+91	LT	--	--	8	--	--	--	--	1	--	--	--	--	1	1
3	527+91	LT	--	--	--	--	--	--	8	1	--	--	--	--	1	1
3	536+66	LT	--	--	--	--	--	--	10	1	--	--	--	--	1	1
2	554+14	RT	--	11	--	--	--	--	--	1	--	--	--	--	1	1
2	562+63	RT	--	14	--	--	--	--	--	1	--	--	--	--	1	1
3	554+14	LT	--	--	8	--	--	--	--	1	--	--	--	--	1	1
3	562+63	LT	13	--	--	--	--	--	--	1	--	--	--	--	1	1
3	573+66	LT	6	--	--	--	--	--	--	1	--	--	--	--	1	1
2	587+50	35.2' RT	--	--	--	--	--	--	--	1	--	--	--	--	1	1
2	14+25 TZA	CL	--	--	60	--	--	--	--	2	--	--	--	--	2	2
2	16+48 TZA	CL	--	--	75	--	--	--	--	1	--	--	--	--	1	1
PROJECT TOTALS			34	80	239	23	27	50	1	14	11	1	2	28	31	

UNDER CROSSOVER

6

14

\*ADDITIONAL QUANTITIES LISTED ELSEWHERE.

SNOW FENCE

LOCATION	LF	SPV.0090.008 FURNISHING	SPV.0090.009 INSTALLING	LF
STA 372+00 - STA 381+00 LT	900			900
STA 400+00 - STA 435+00 LT	3,500			3,500
STA 446+00 - STA 541+00 LT	9,500			9,500
STA 549+00 - STA 565+00 LT	1,600			1,600
STA 646+00 - STA 731+00 LT	8,500			8,500
UNDISTRIBUTED	1,000			1,000
<b>PROJECT TOTALS</b>	<b>25,000</b>			<b>24,000</b>

CONCRETE BARRIER TEMPORARY PRECAST LEFT IN PLACE

STATION	STATION	LOCATION	LF
347+15	352+15	LT	500
<b>PROJECT TOTALS</b>			<b>500</b>

Addendum No. 01  
ID 1003-10-77  
Revised Sheet 73  
June 07, 2016

GEOGRID REINFORCEMENT

LOCATION	(SY)
SPV.0180.001 GEOGRID	5372
<b>TOTALS</b>	<b>5,372</b>

PAVEMENT MARKING



STATION	STATION	LOCATION	EPOXY 4-INCH		WHITE LANE LINE 12.5' SKIP MARKINGS (LF)	*646.0600 REMOVING PAVEMENT MARKINGS (LF)
			YELLOW (LF)	WHITE (LF)		
320+00	541+00	RT	22,100	--	22,100	22,100
320+00	541+00	LT	--	22,100	--	22,100
320+00	541+00	MIDDLE	--	5,525	5,525	5,525
541+00	625+45	RT	8,445	--	--	--
541+00	625+45	LT	--	8,445	--	--
547+00	625+45	MIDDLE	--	2,113	--	--
<b>TOTAL FOR 646.0106</b>			<b>30,545</b>	<b>30,545</b>	<b>7,638</b>	<b>49,725</b>
<b>PROJECT TOTALS</b>			<b>68,728</b>			<b>49,725</b>

\*ADDITIONAL QUANTITIES LISTED ELSEWHERE.

CRASH CUSHIONS PERMANENT

STATION	LOCATION	BACK WIDTH (FT)	OBJECT MARKING PATTERN	CRASH TEST LEVEL	TRAFFIC DIRECTION	TRAFFIC LOCATION
614.0800	CRASH CUSHIONS PERMANENT	2	OM-3R	TL-3	UNIDIRECTIONAL	TEMPORARY CONCRETE BARRIER ON OUTSIDE SHOULDER
352+15	54' LT	1				
<b>PROJECT TOTALS</b>		<b>1</b>				


Addendum No. 01  
 ID 1003-10-77  
 Revised Sheet 76  
 June 07, 2016

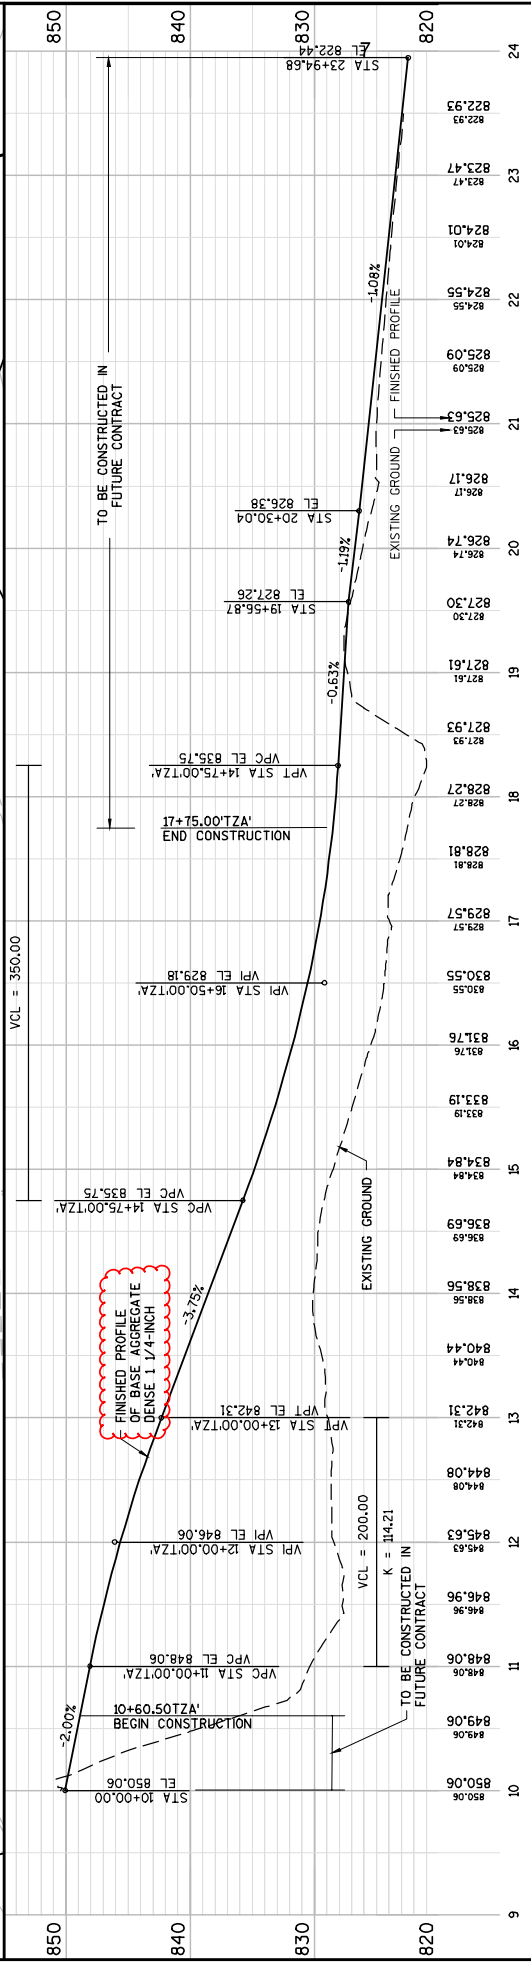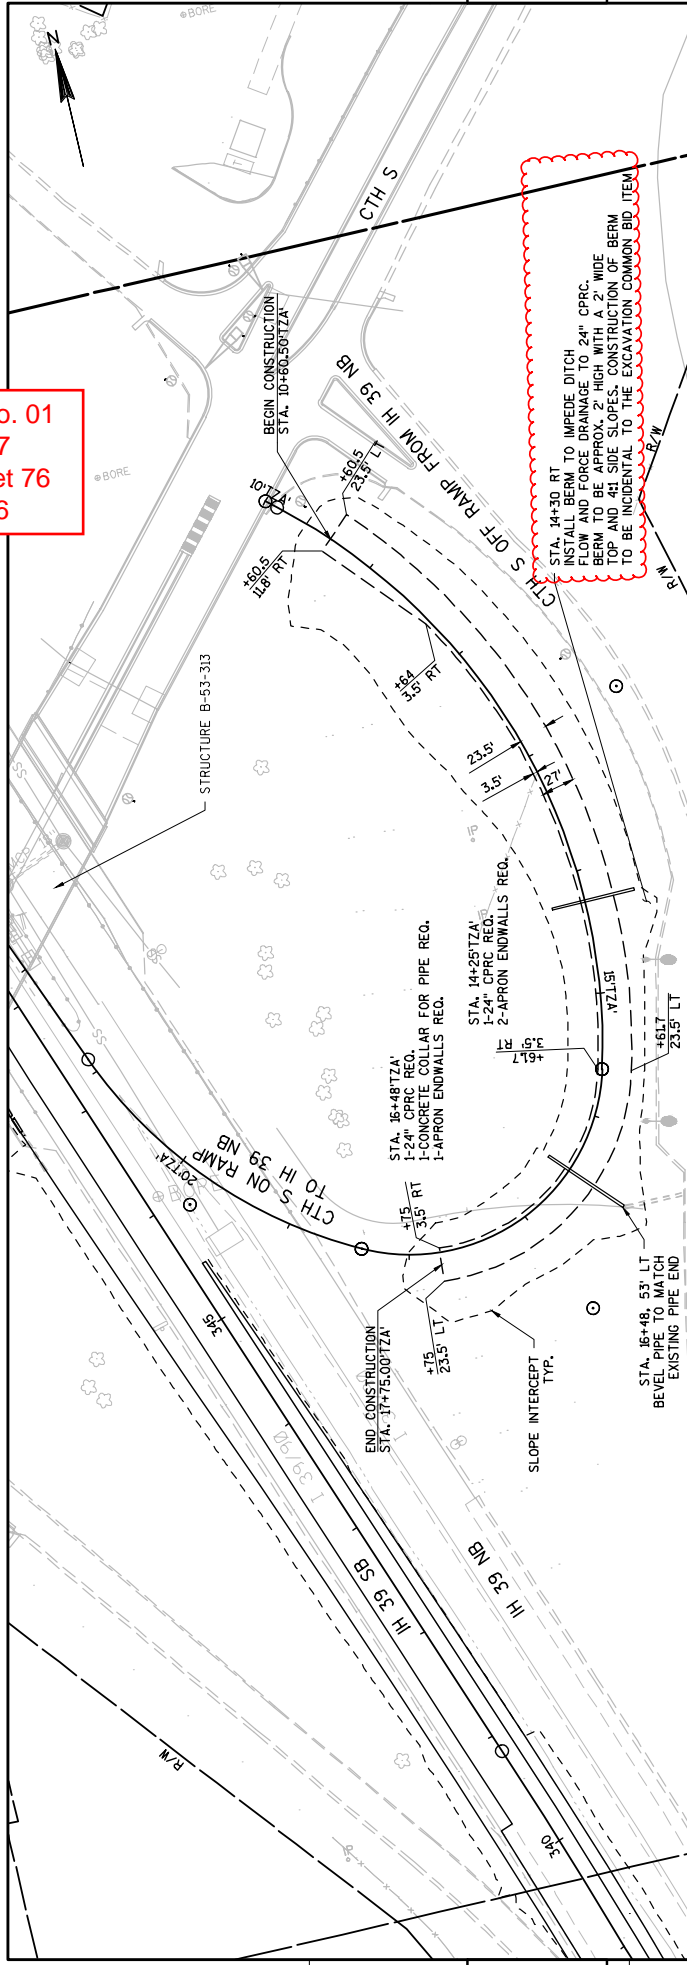


PROJECT NO: 1003-10-77	HWY: IH 39	COUNTY: ROCK	PLAN AND PROFILE: CTH S ON RAMP	SHEET 76	E
FILE NAME : L:\WORK\PROJECTS\60242681\000_CADD\001_DRAWINGS\1003-10-77_CTH S TO STH 11_TEMP\1003\050101.PP_CROSSOVERS.DWG					
PLOT DATE : 6/1/2016 10:17 AM					
PLOT BY : ARBUCKLE, ADRIAN					
PLOT SCALE : 1:100.XREF					
WISDOT/CADD SHEET 44					





Addendum No. 01  
 ID 1003-10-77  
 Revised Sheet 77  
 June 07, 2016

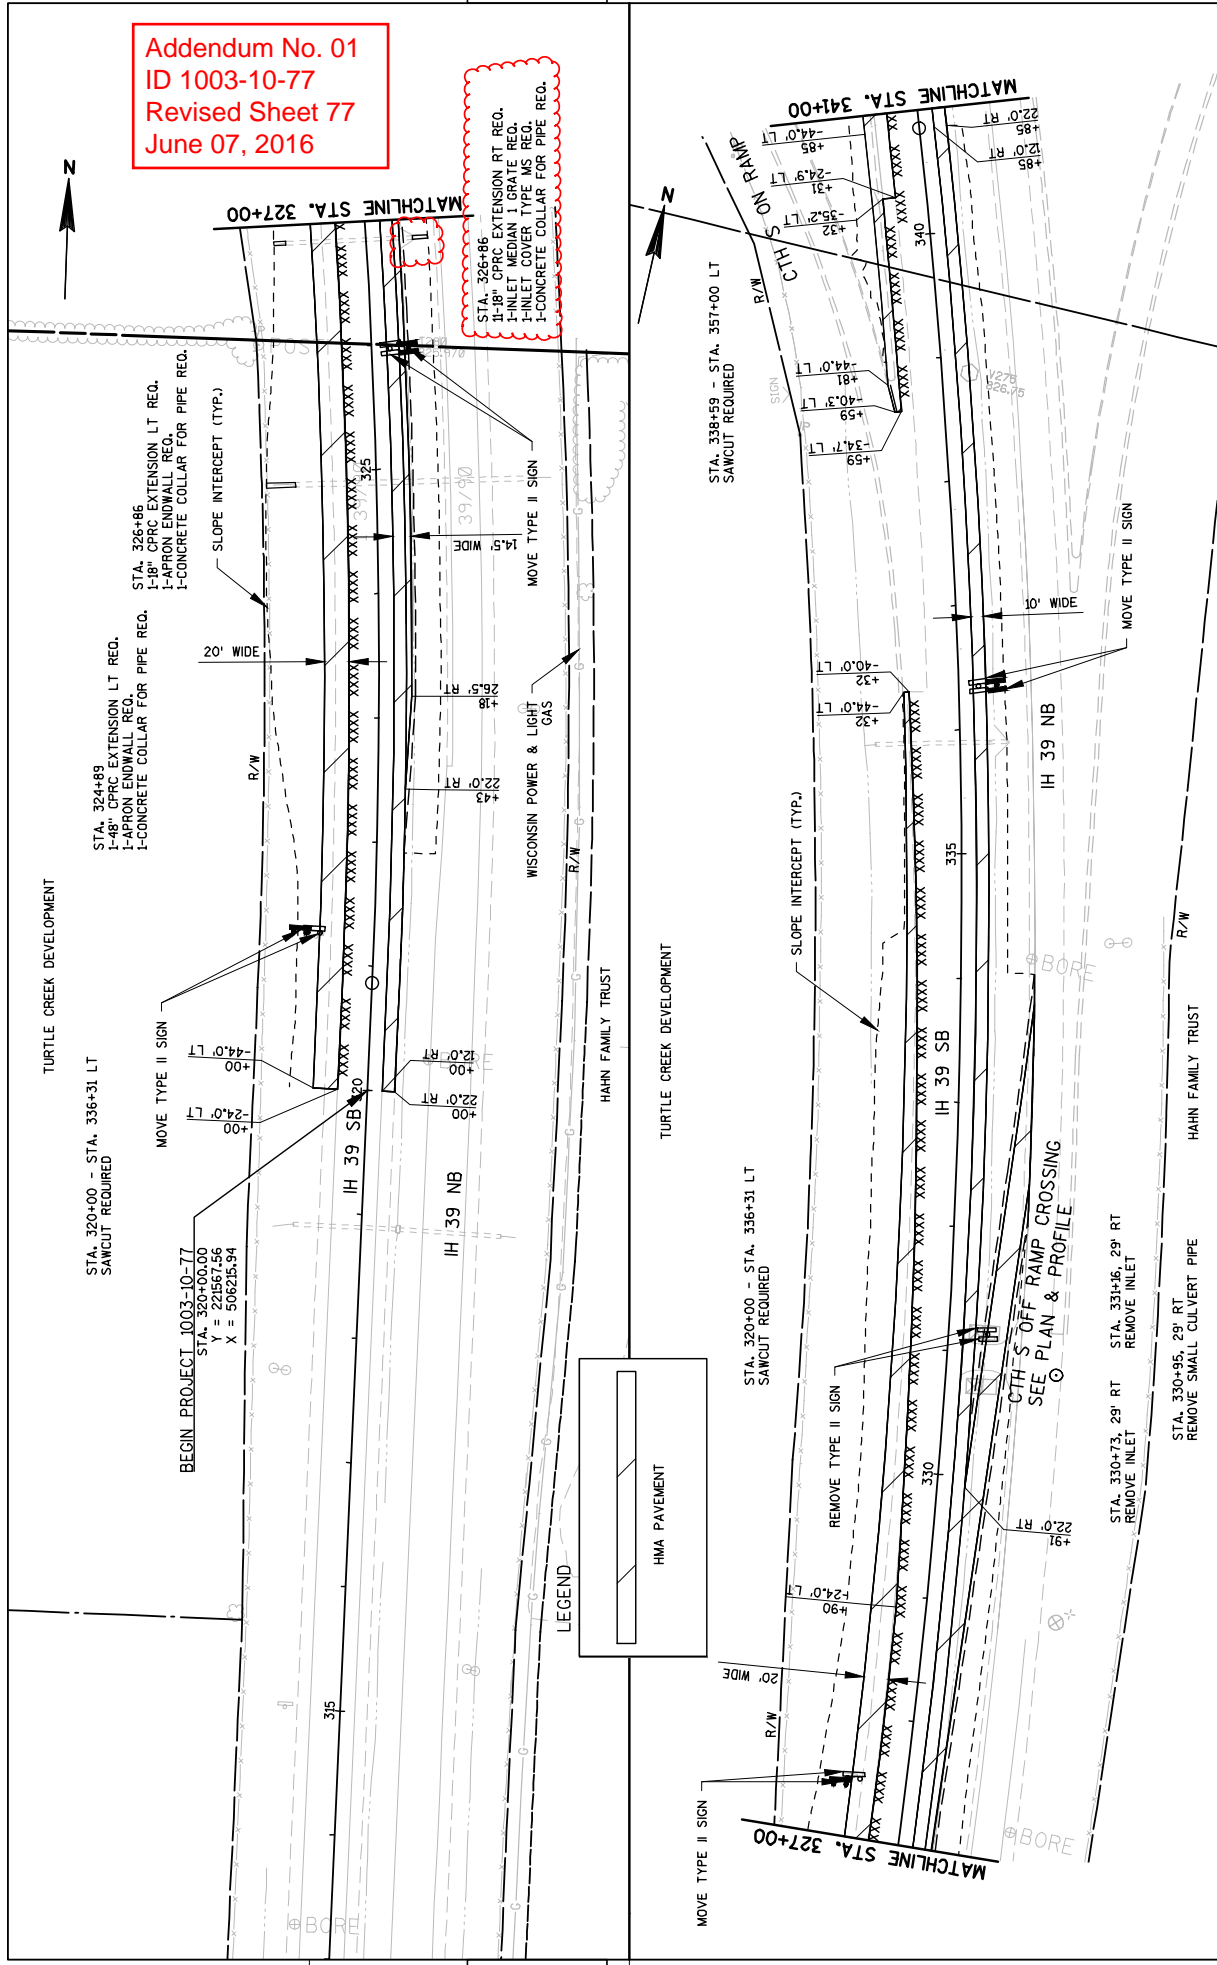


PROJECT NO: 1003-10-77	HWY: IH 39	COUNTY: ROCK	PLAN: TEMPORARY WIDENING	SHEET 77	E
FILE NAME : L:\WORK\PROJECTS\60242681\000_CADD\001_DRAWINGS\1003-10-77_CTH S TO STH 11_TEMP\1003\050201_P1.TX.DWG			PLOT DATE : 6/3/2016 1:58 PM		
PLOT BY : ARBUCKLE, ADRIAN			PLOT NAME : *****		
PLOT SCALE : *****			WISDOT/CADD SHEET 44		

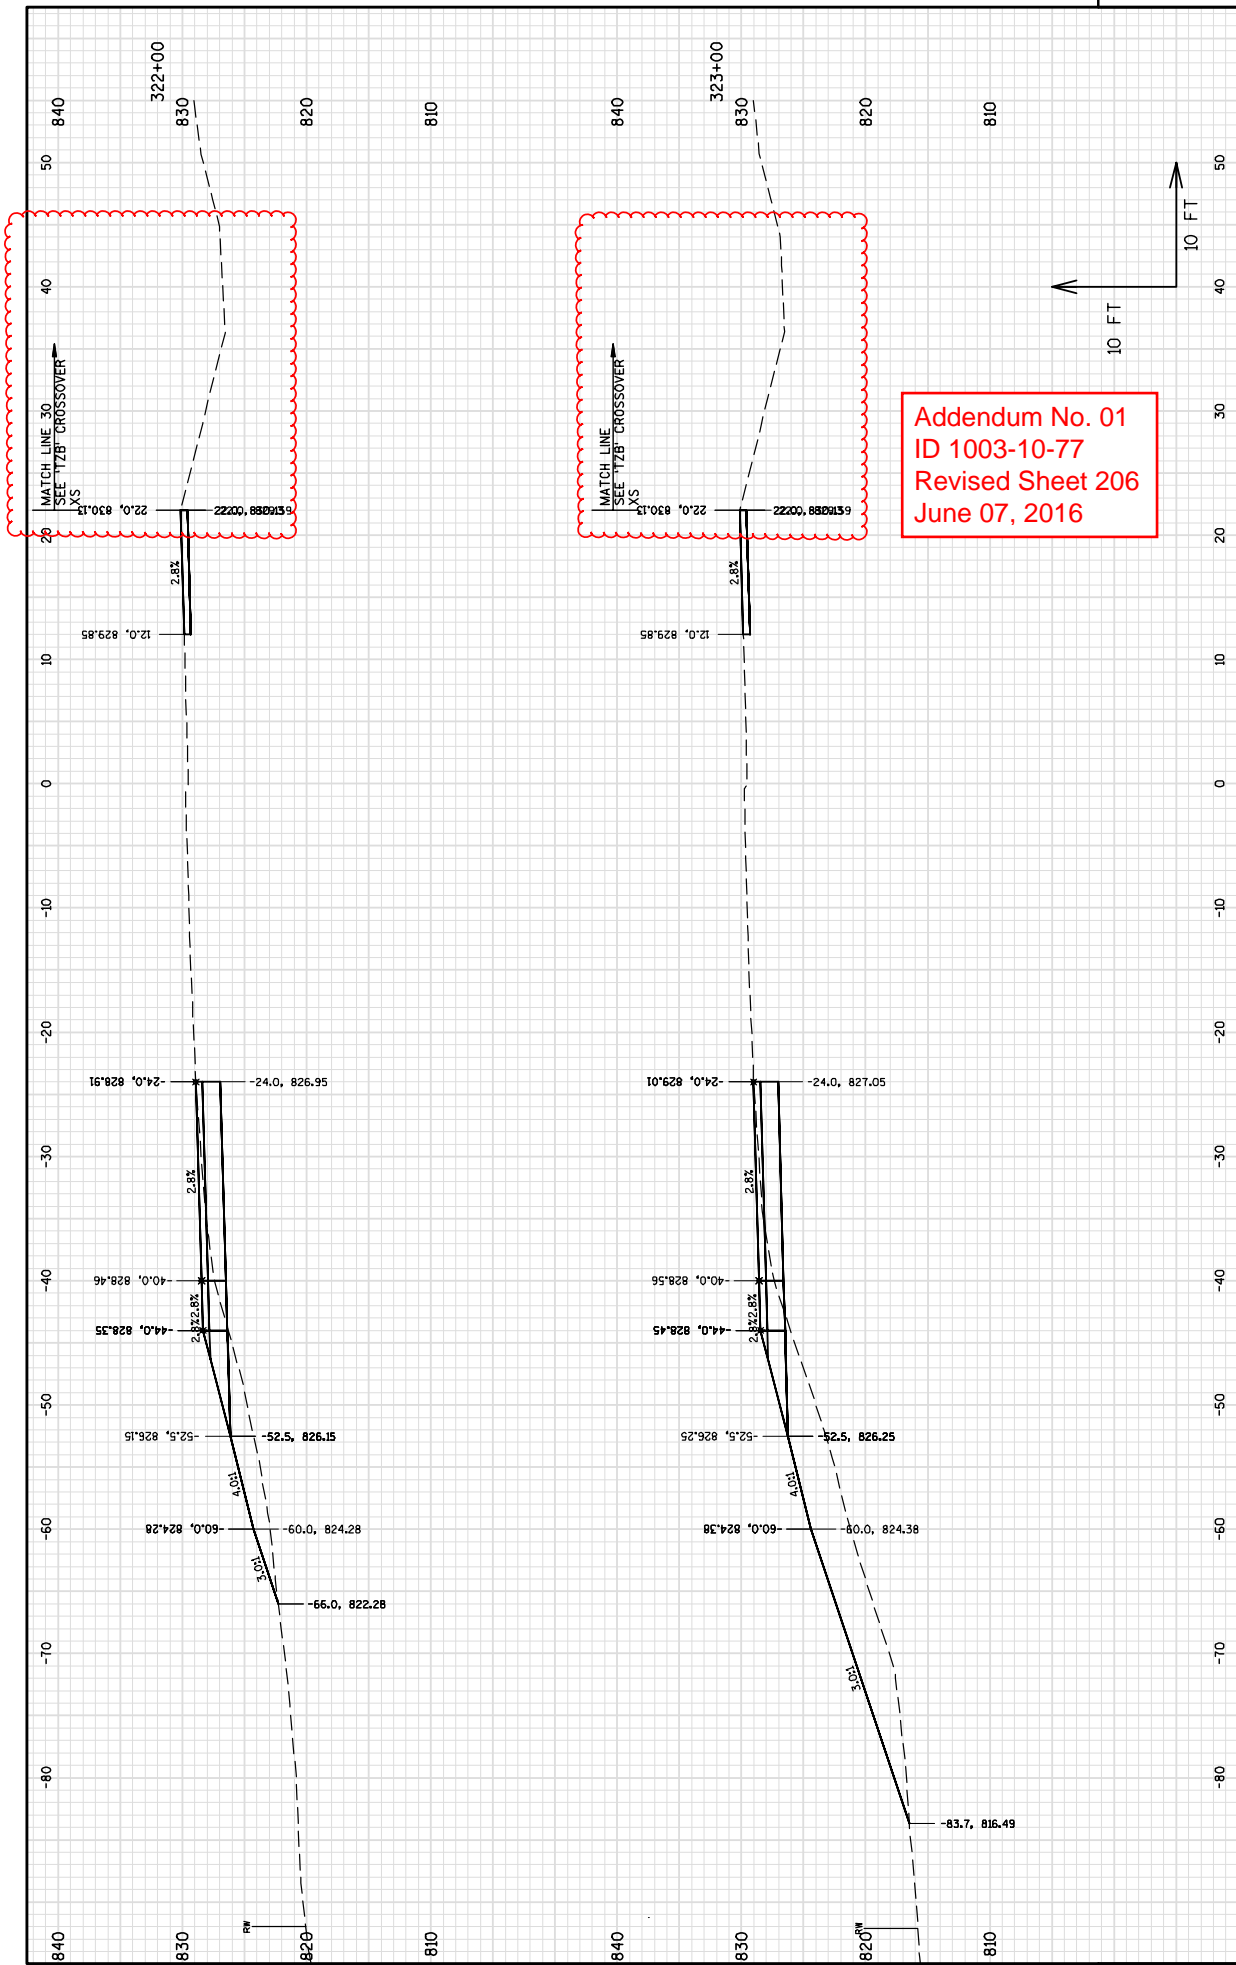


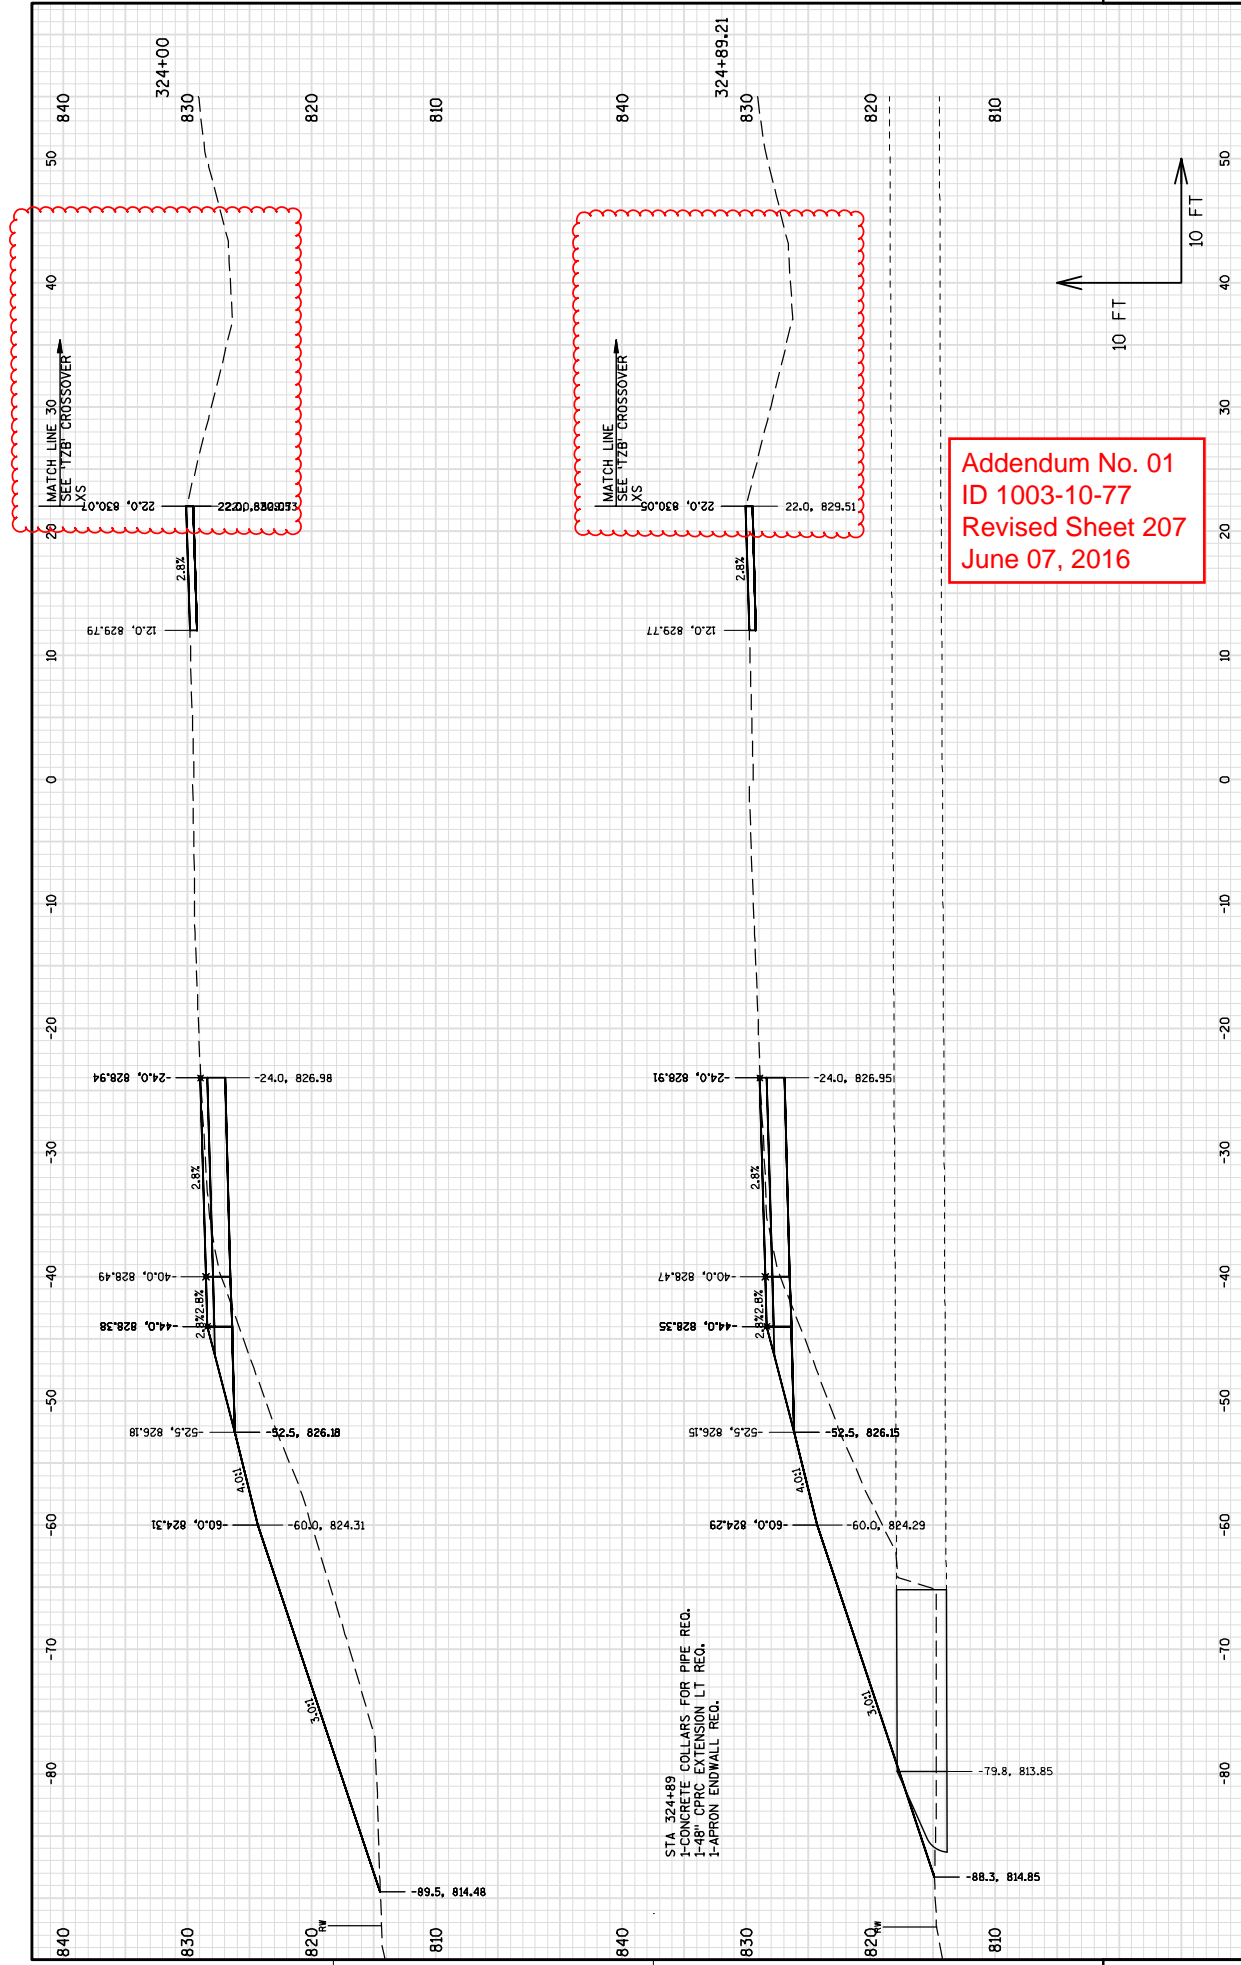

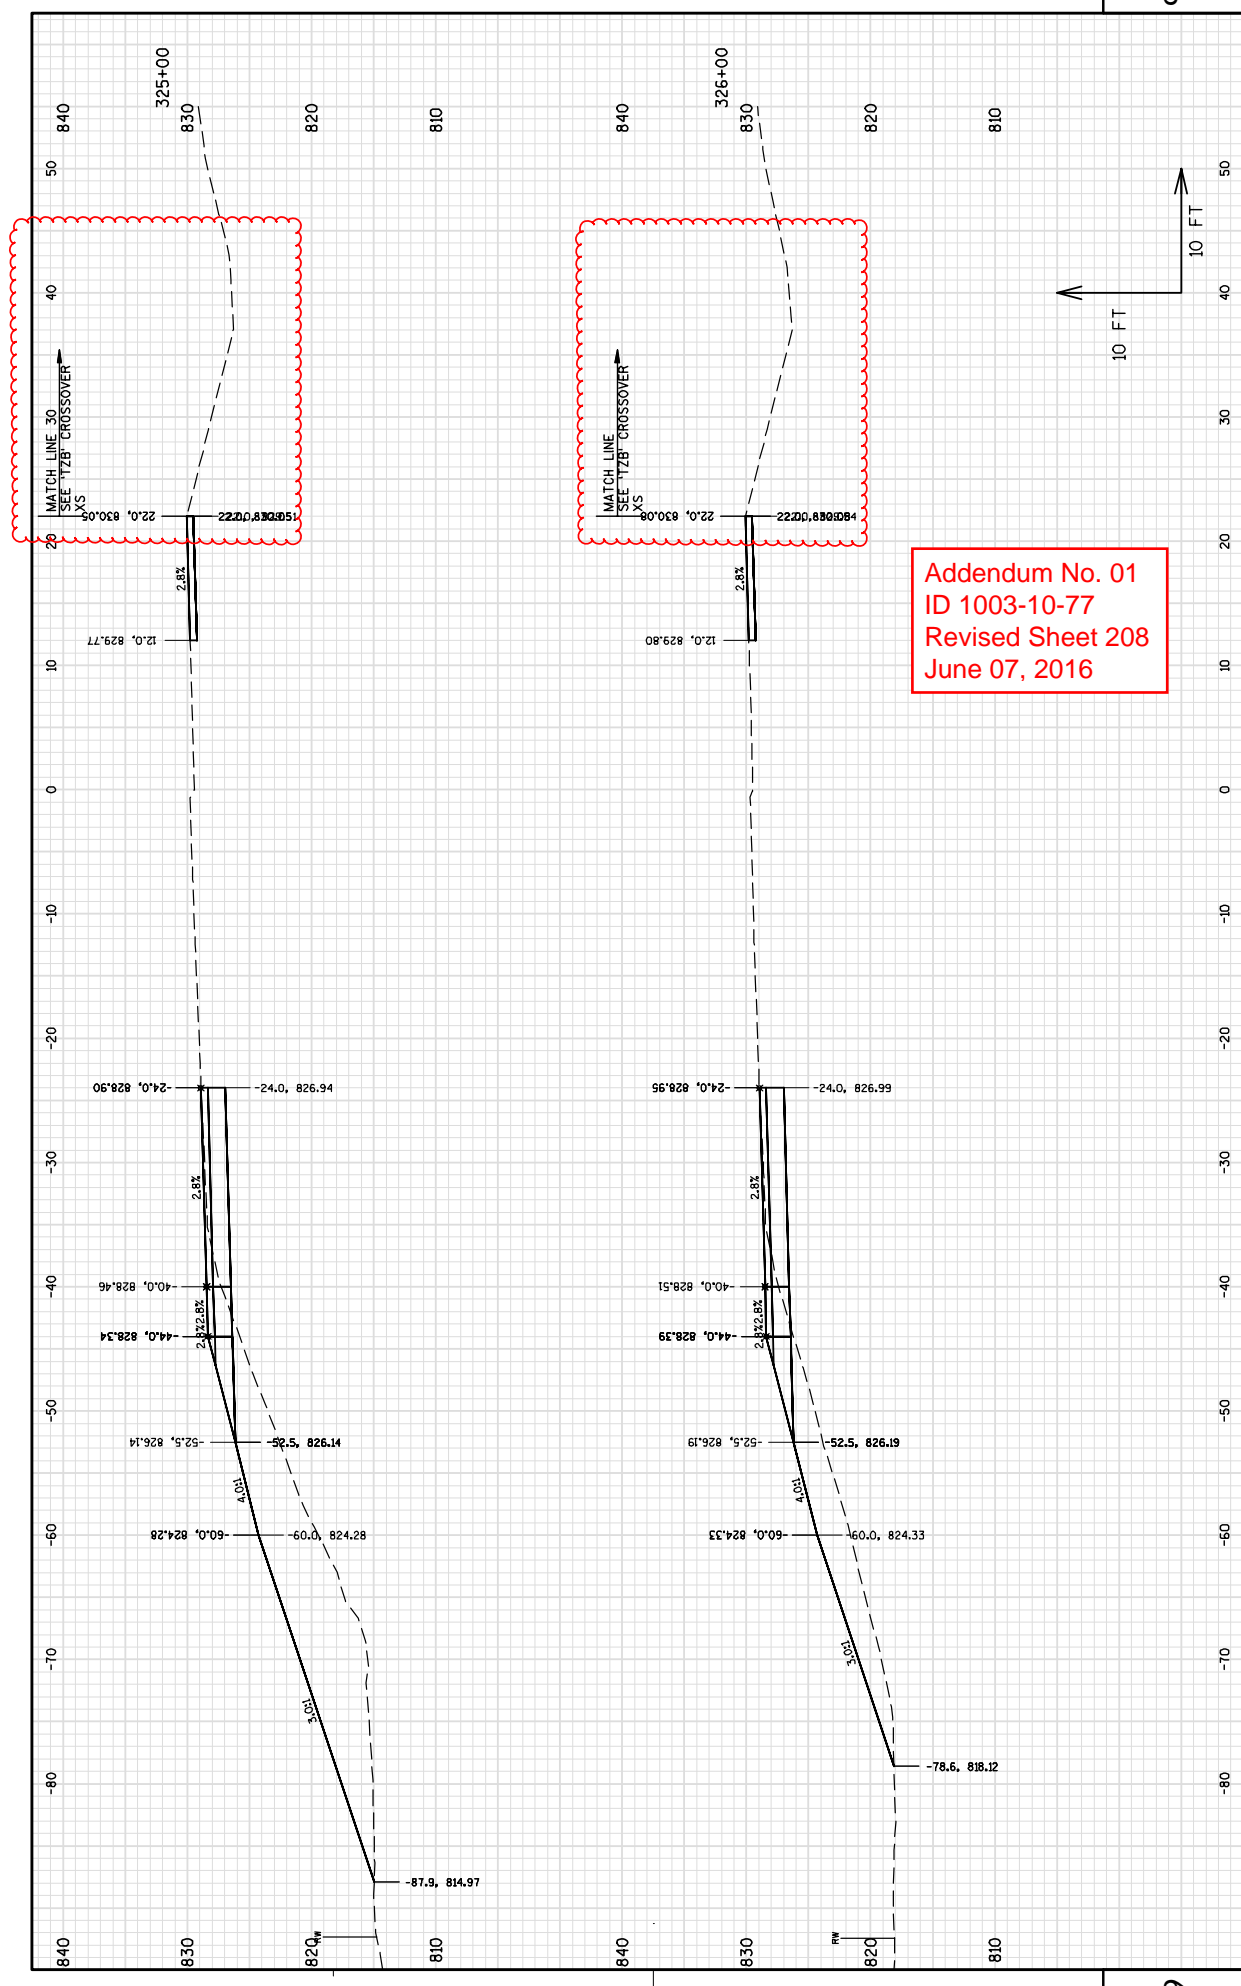


Addendum No. 01  
 ID 1003-10-77  
 Revised Sheet 208  
 June 07, 2016

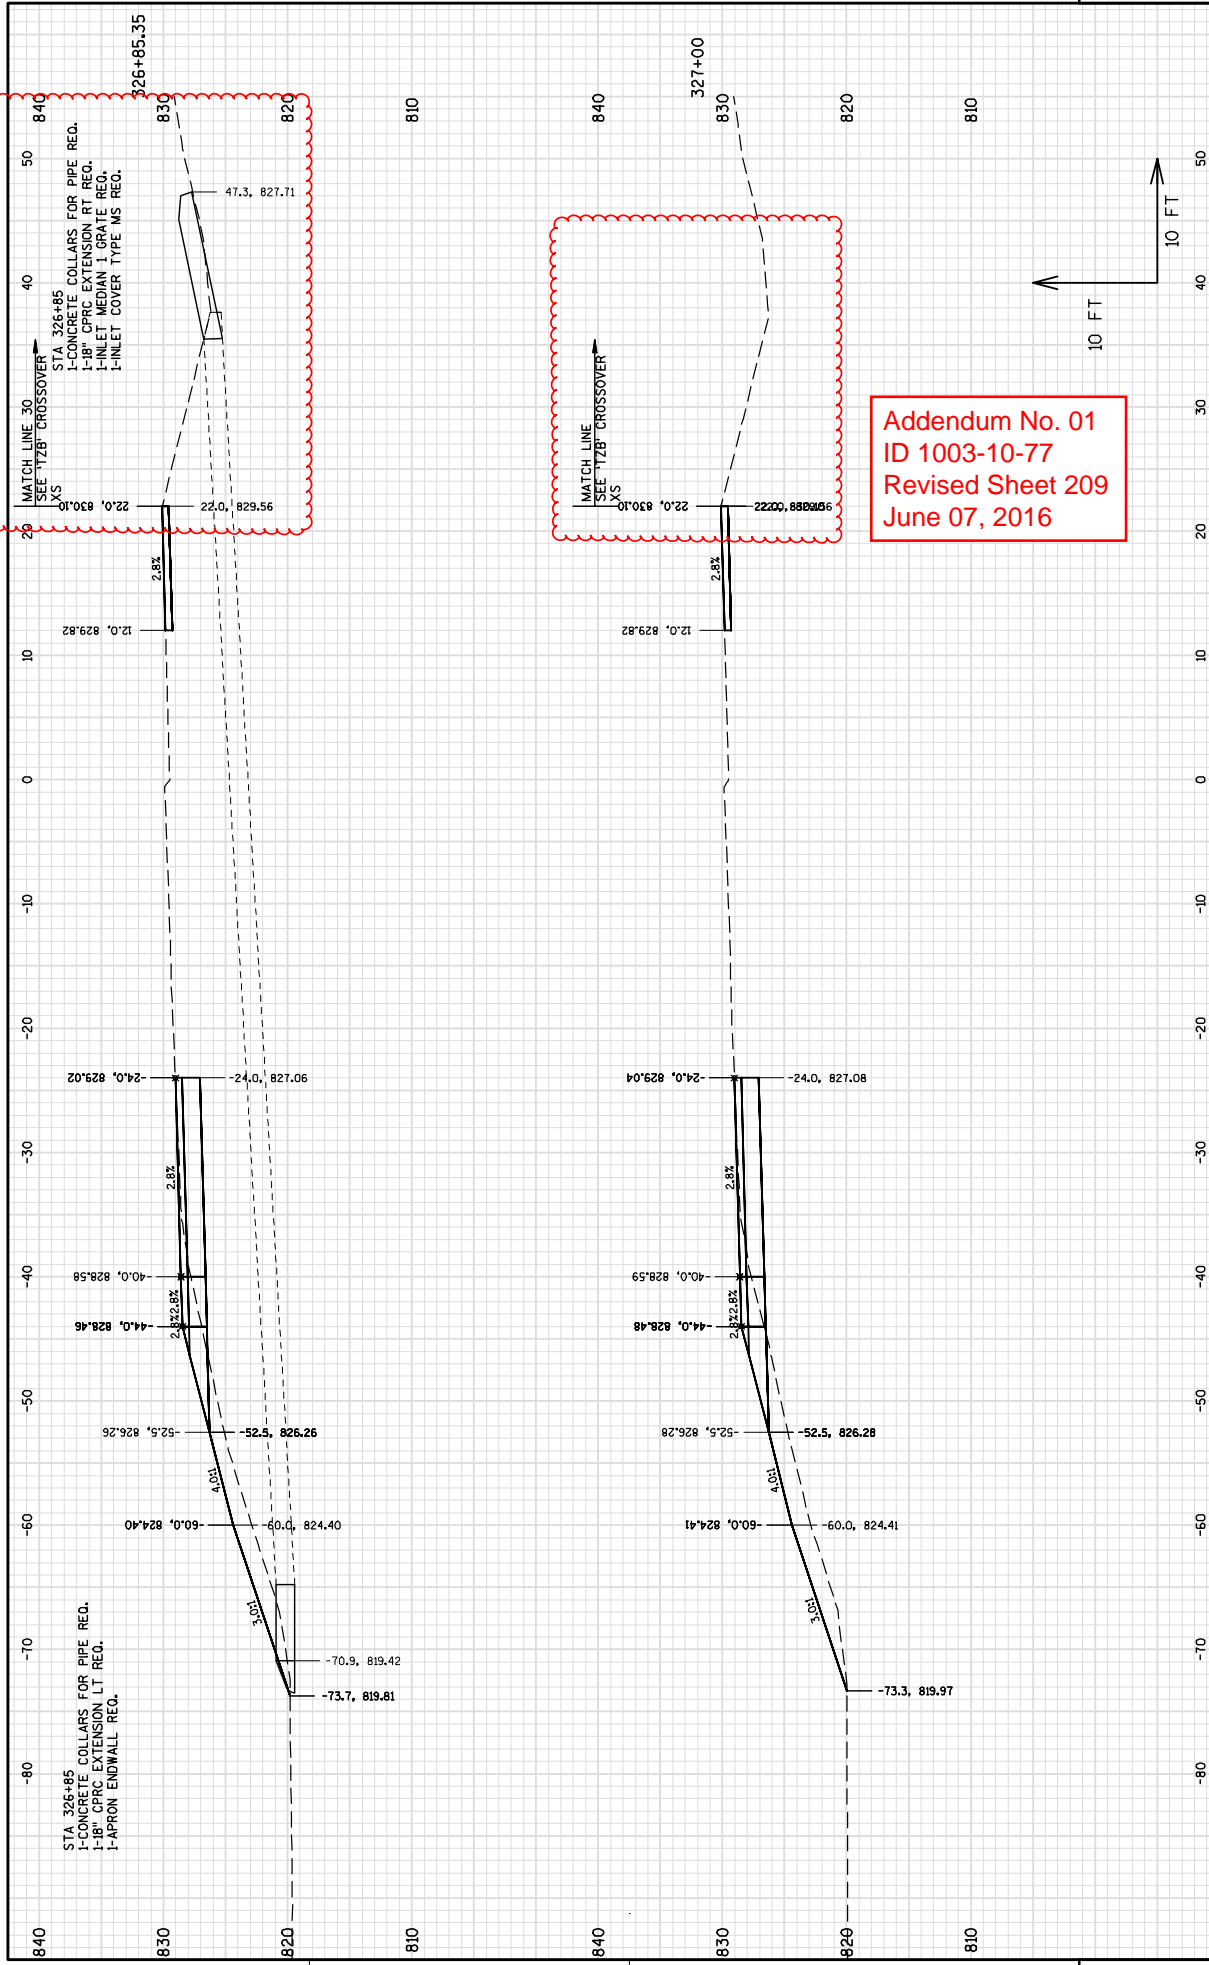


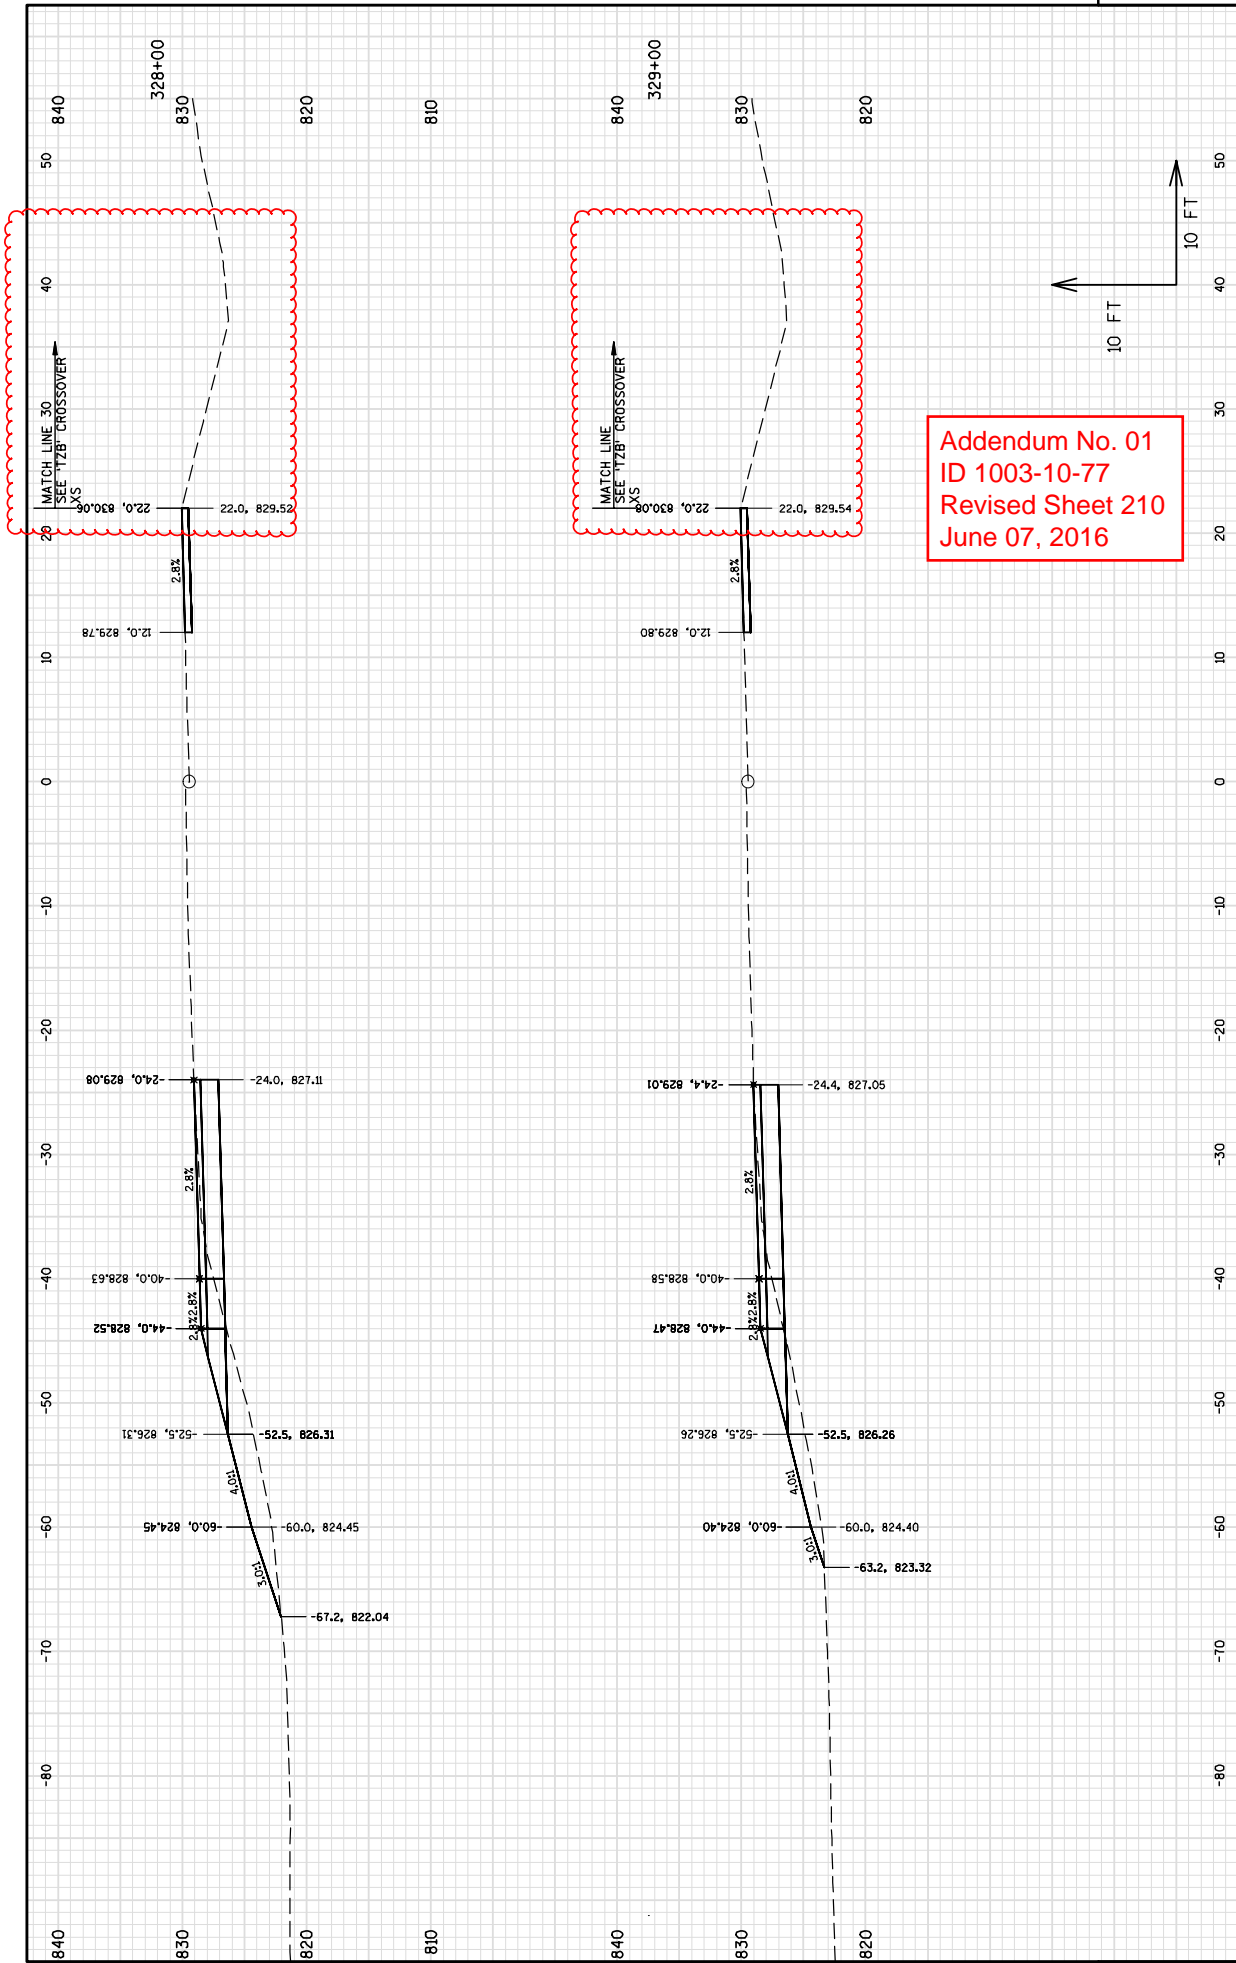

Addendum No. 01  
 ID 1003-10-77  
 Revised Sheet 210  
 June 07, 2016


Addendum No. 01  
ID 1003-10-77  
Revised Sheet 211  
June 07, 2016

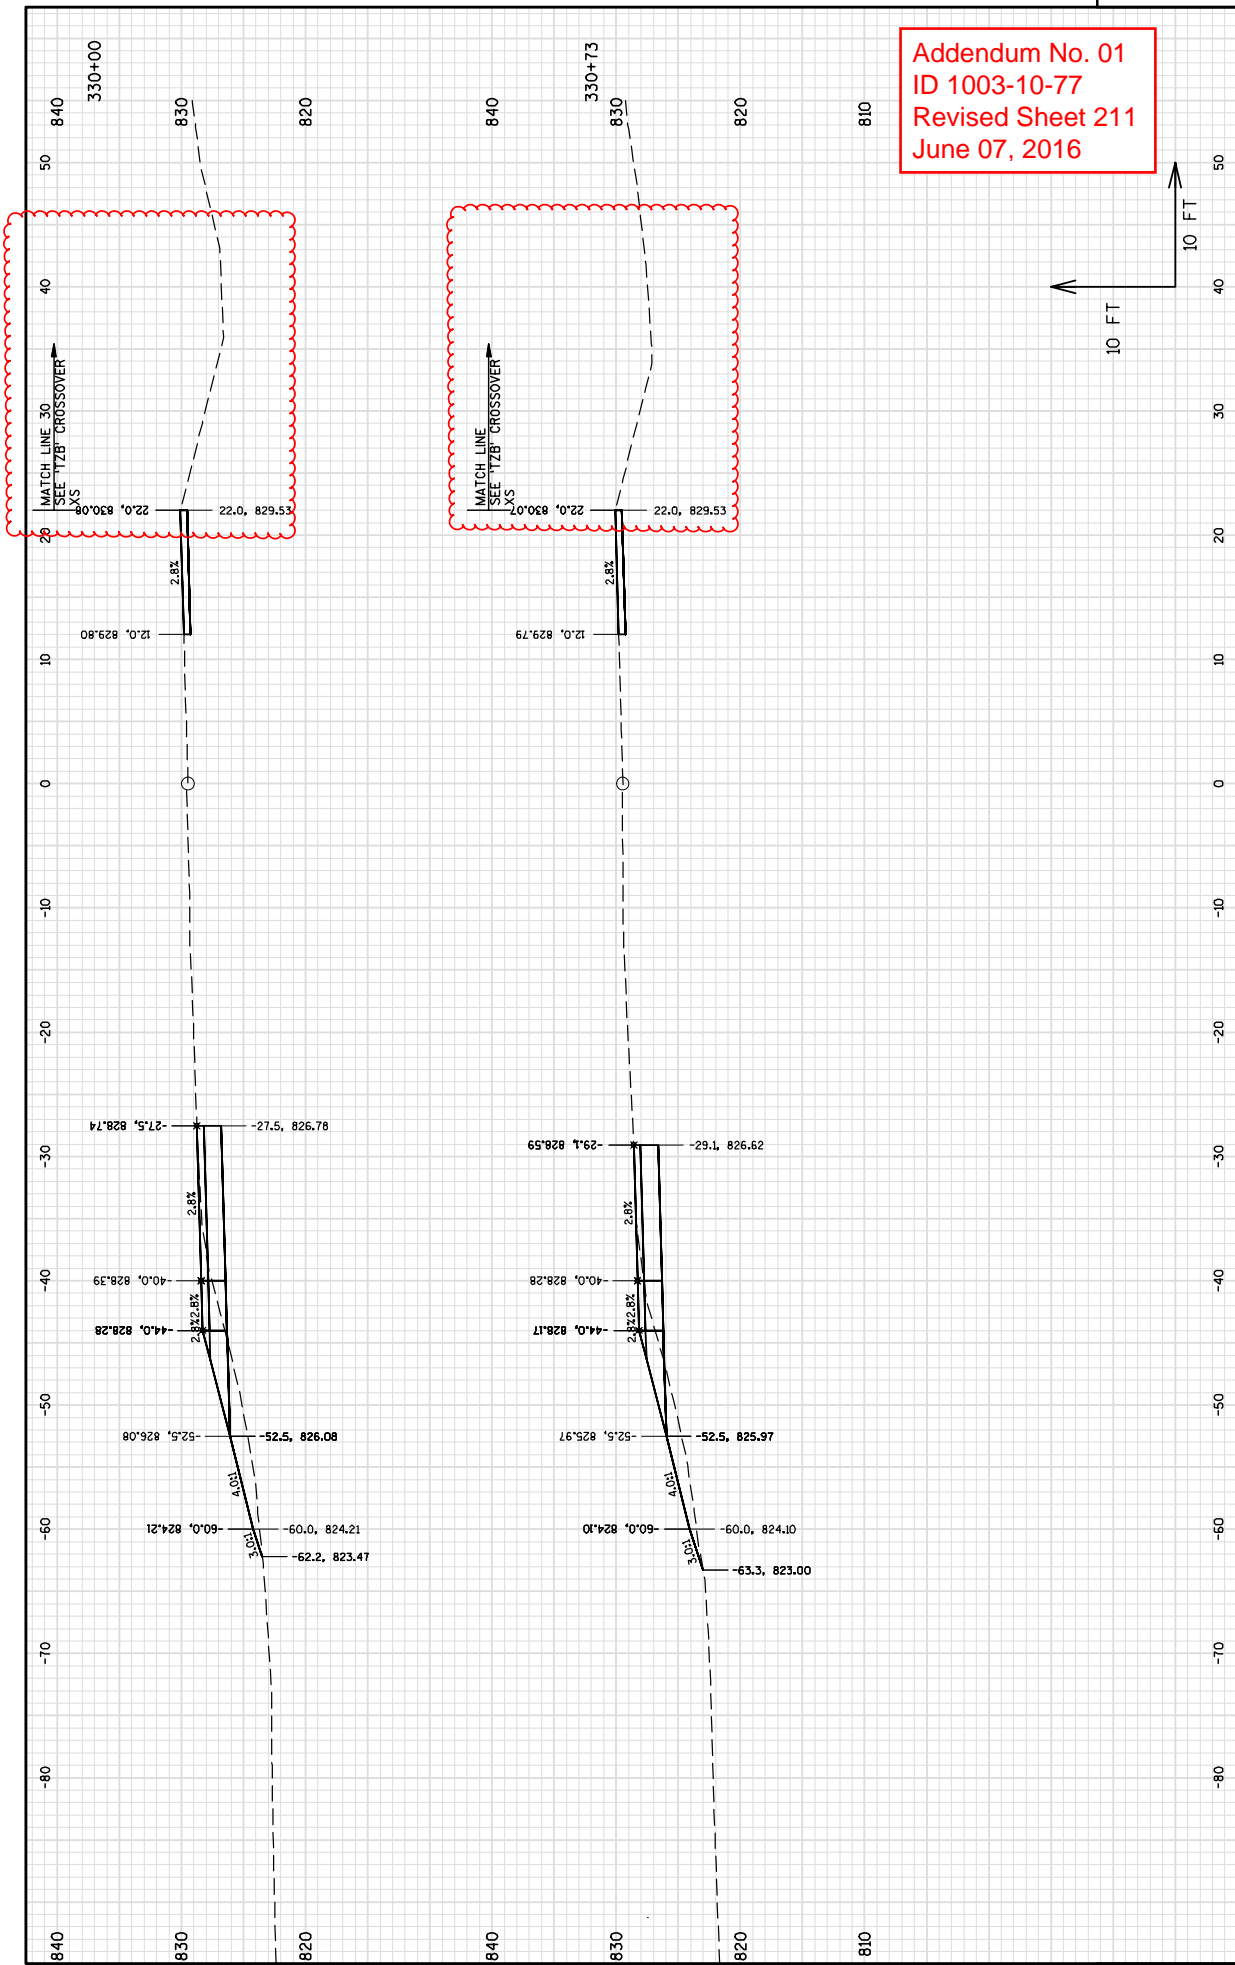

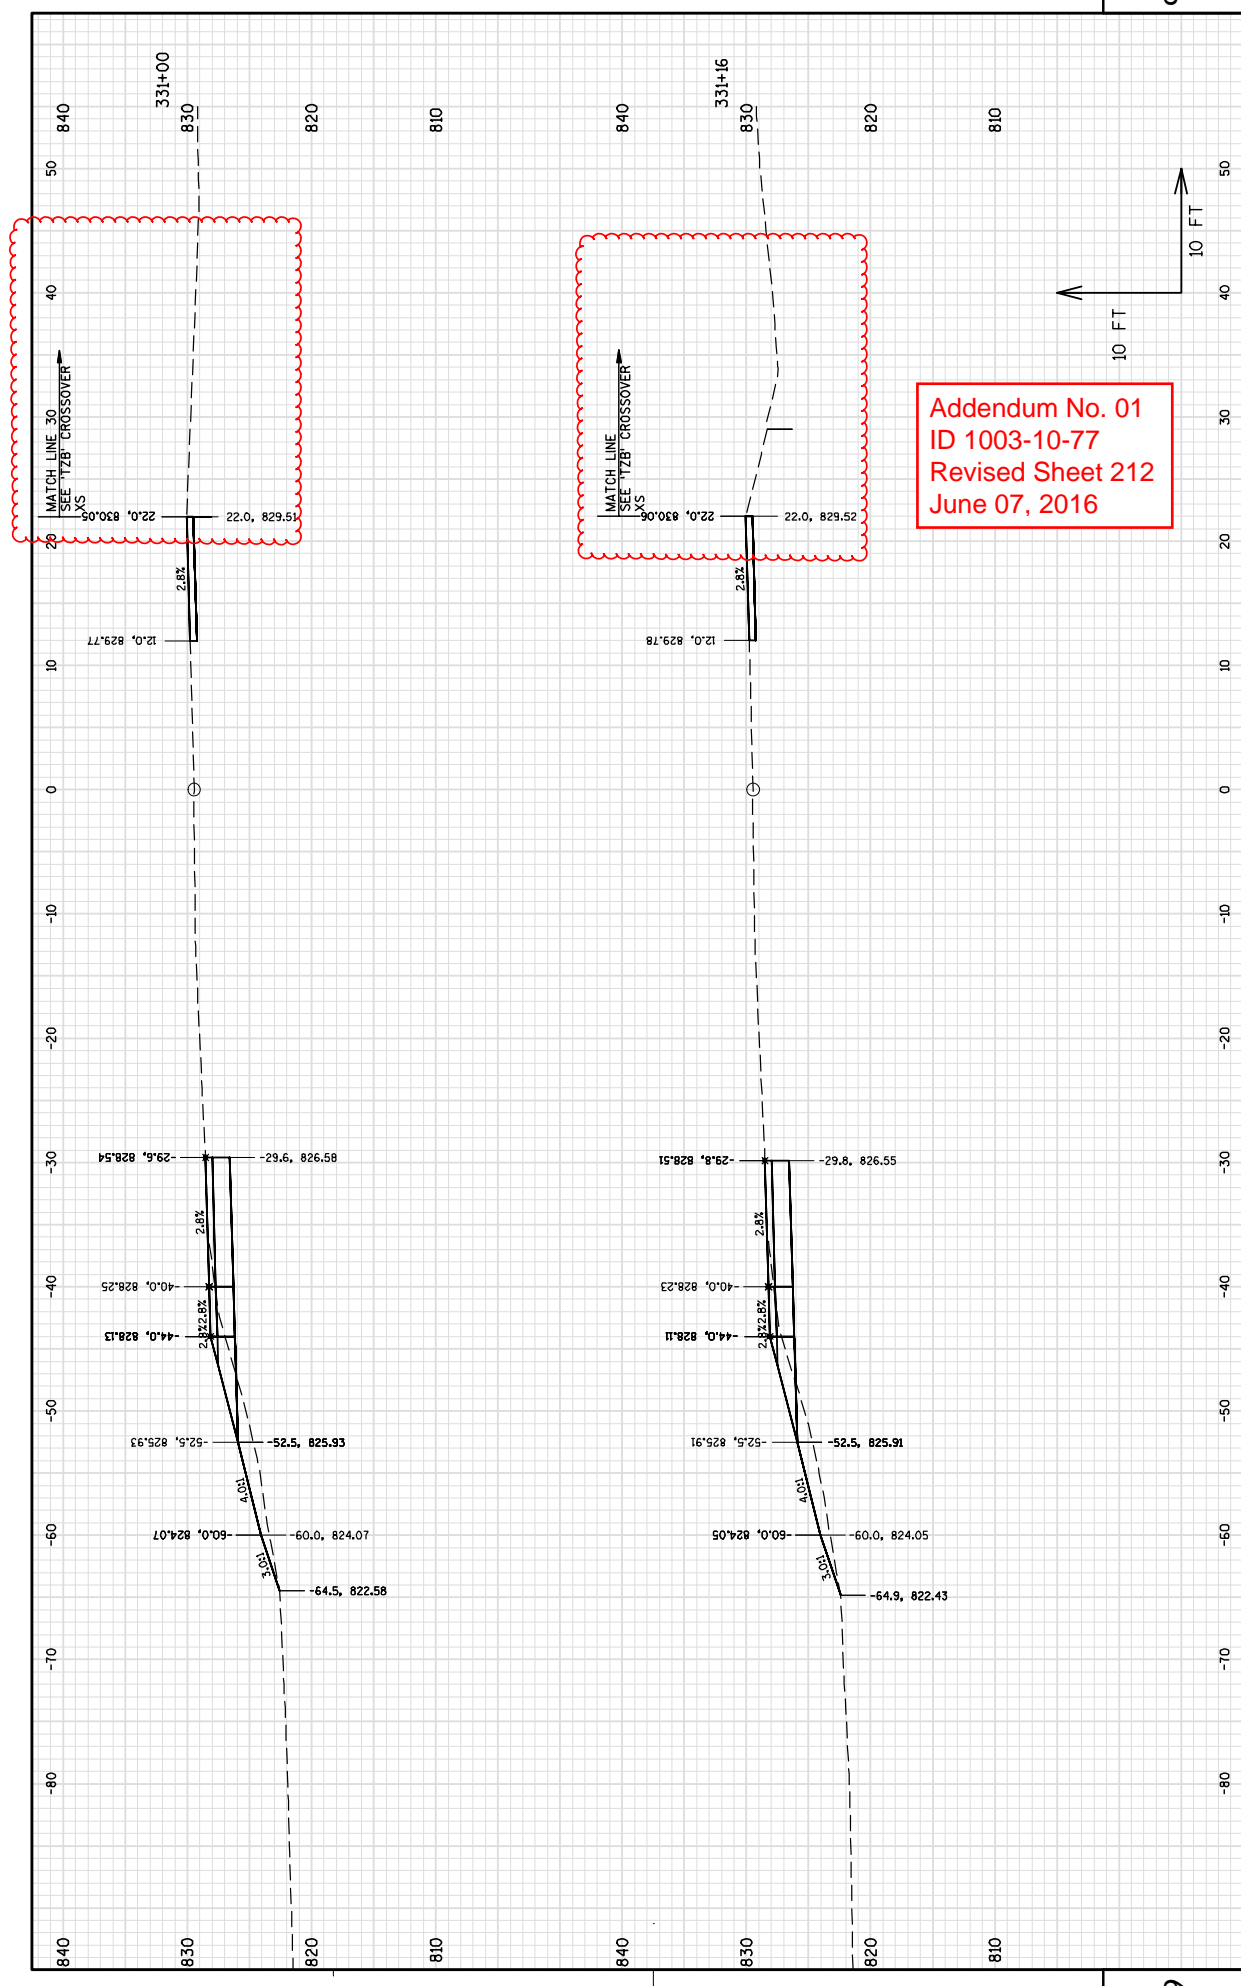


Addendum No. 01  
 ID 1003-10-77  
 Revised Sheet 212  
 June 07, 2016




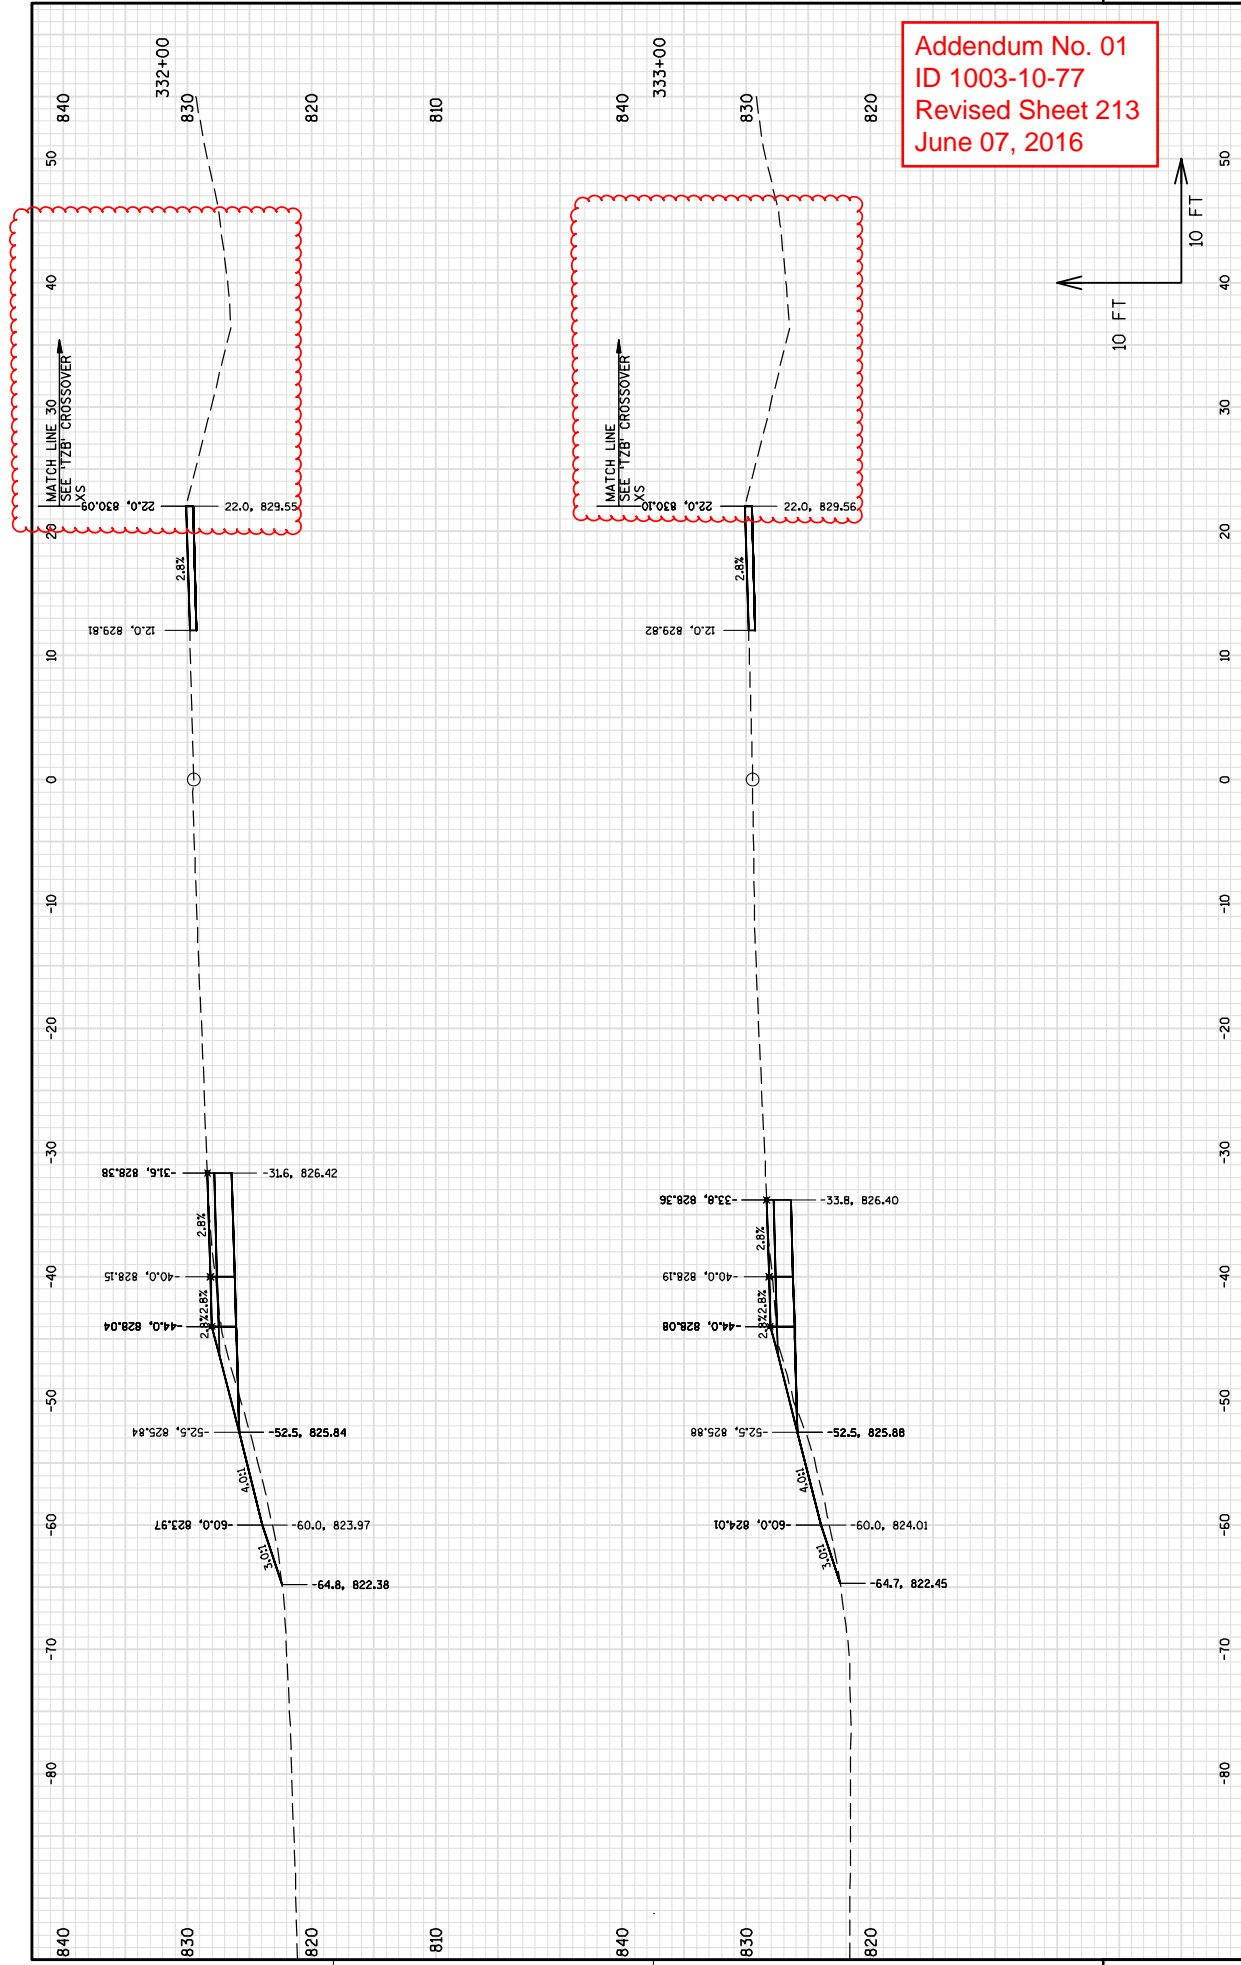

Addendum No. 01  
 ID 1003-10-77  
 Revised Sheet 213  
 June 07, 2016

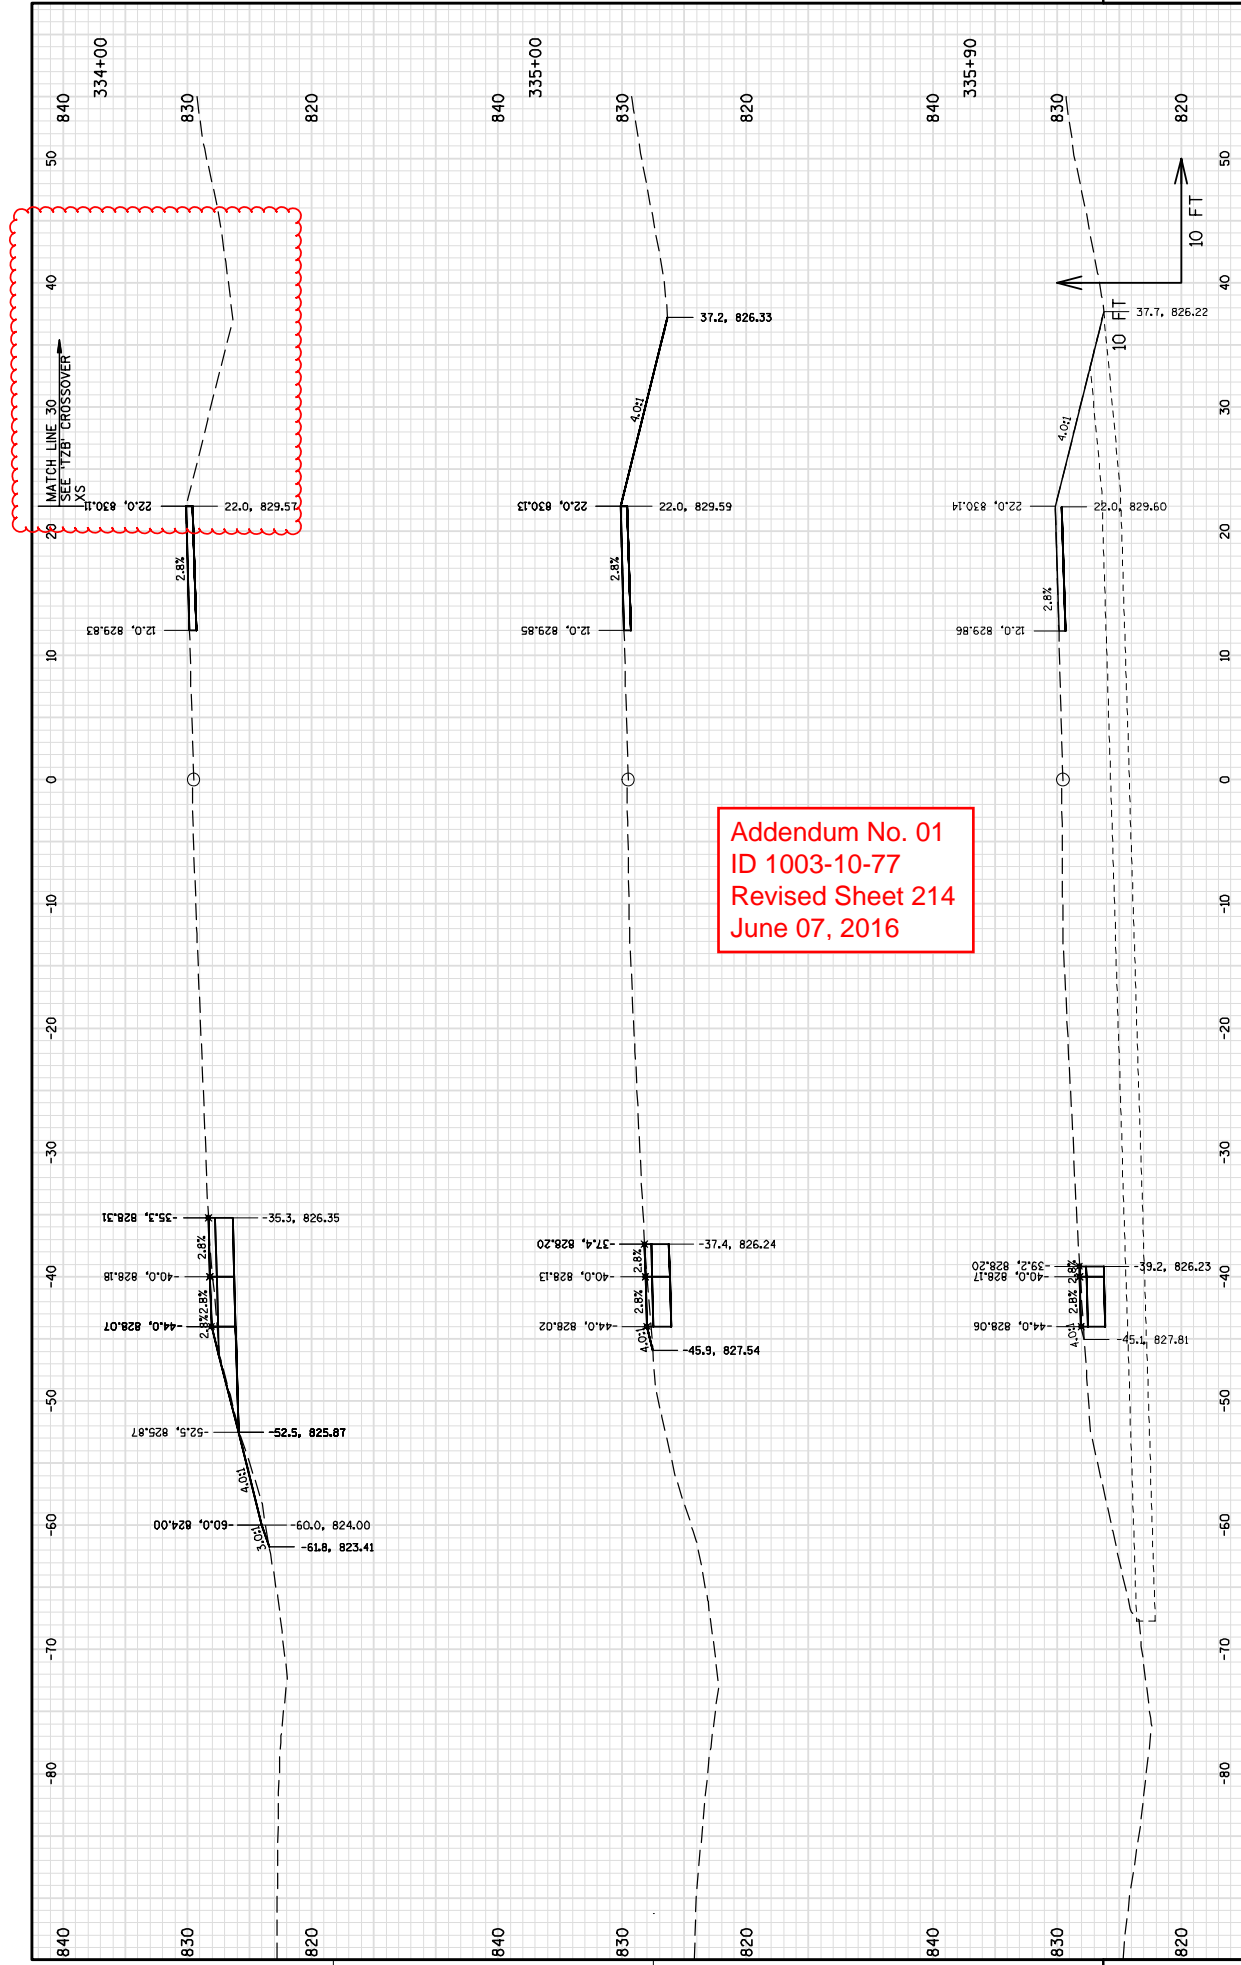


Addendum No. 01  
 ID 1003-10-77  
 Revised Sheet 214  
 June 07, 2016

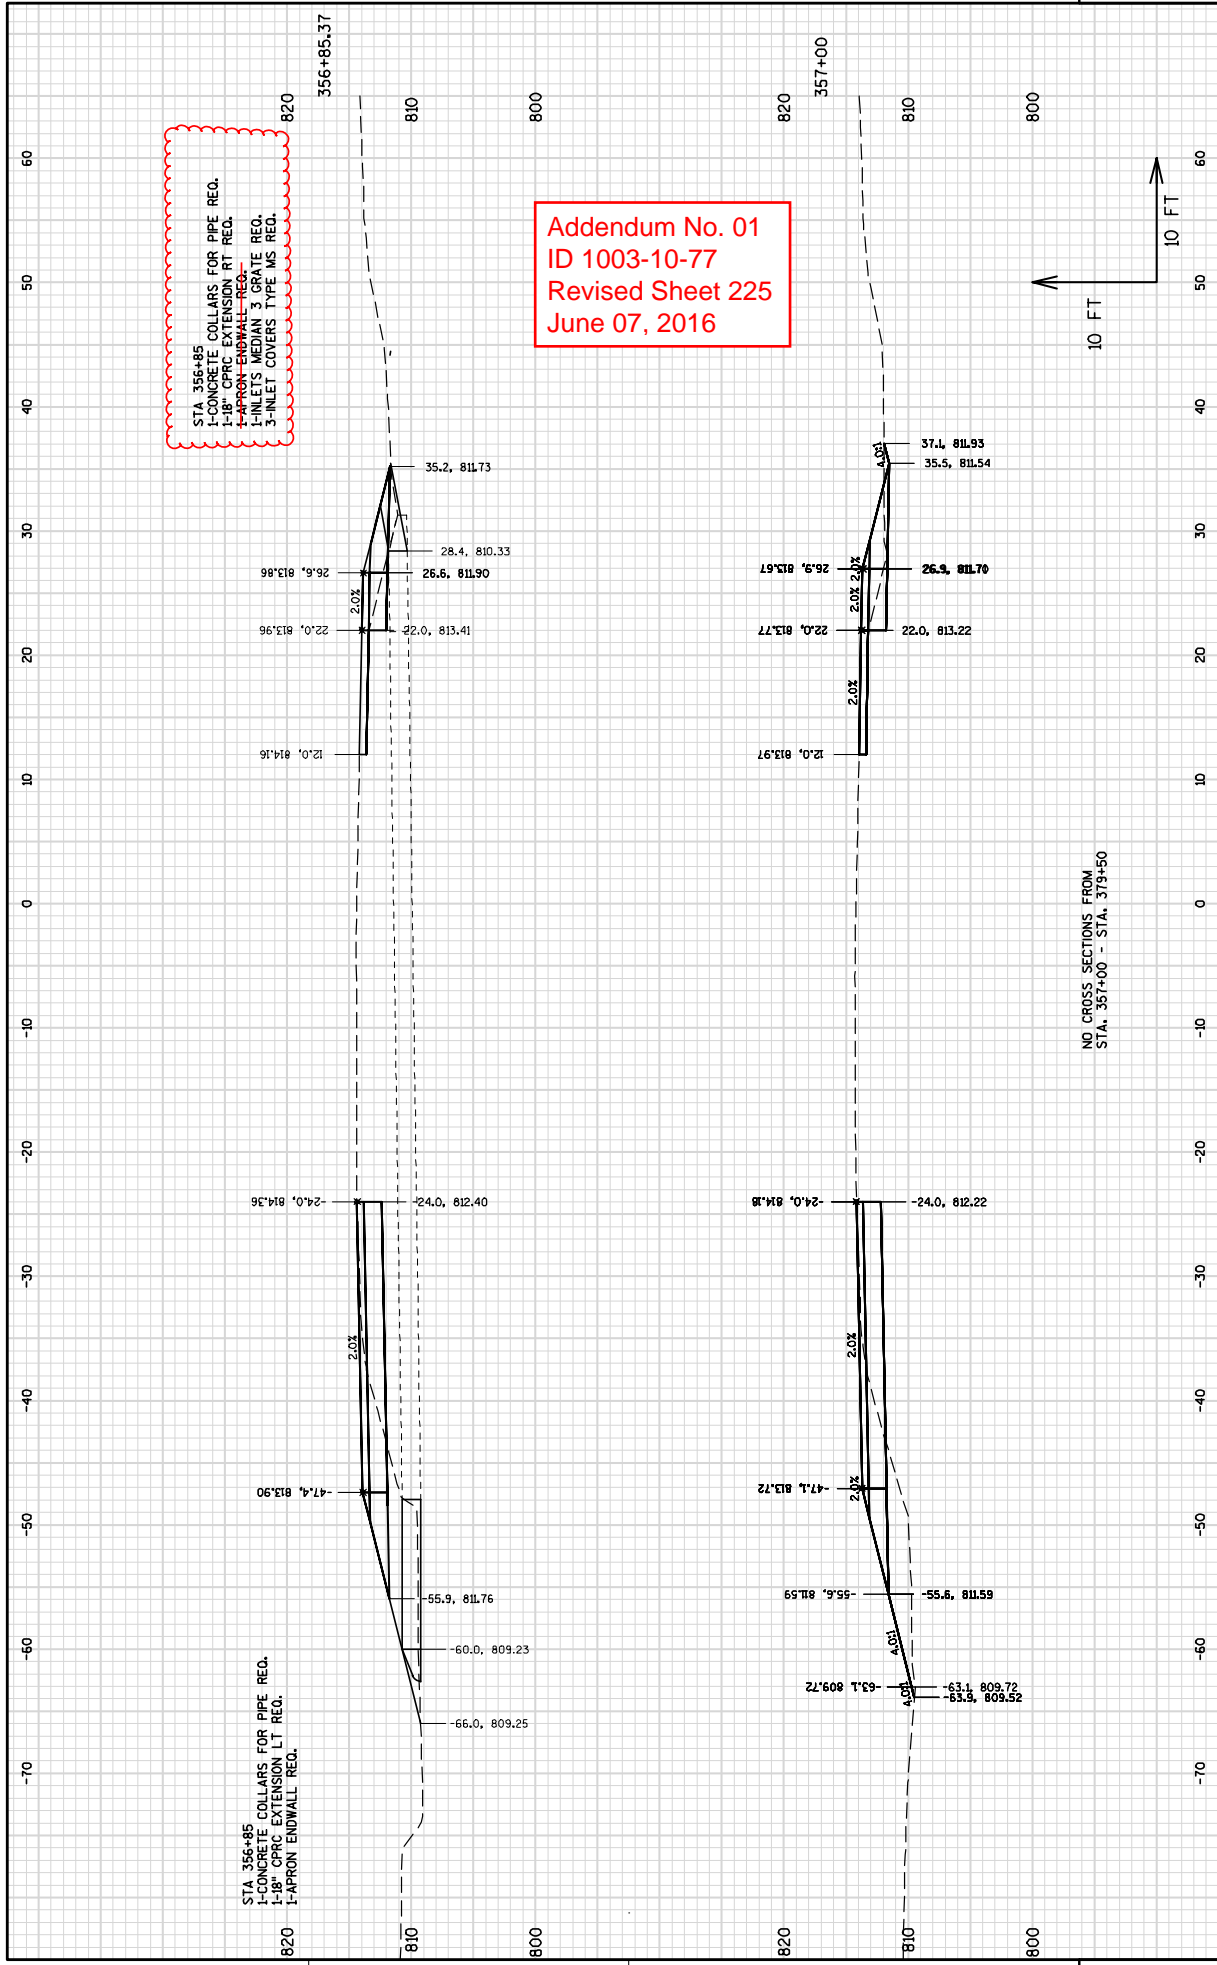

RUNOFF COEFFICIENT TABLE


LAND USE:	HYDROLOGIC SOIL GROUP								
	A		B		C		D		
	SLOPE RANGE (PERCENT)		SLOPE RANGE (PERCENT)		SLOPE RANGE (PERCENT)		SLOPE RANGE (PERCENT)		
	0-2	2-6	6 & OVER	0-2	2-6	6 & OVER	0-2	2-6	6 & OVER
ROW CROPS	.08	.16	.22	.12	.20	.27	.15	.24	.33
	.22	.30	.38	.26	.34	.44	.30	.37	.50
MEDIAN STRIP-	.19	.20	.24	.19	.22	.26	.20	.23	.30
TURF	.24	.26	.30	.25	.28	.33	.26	.30	.37
SIDE SLOPE-		.25			.27			.28	
TURF		.32			.34			.36	
PAVEMENT:									
ASPHALT	.70 - .95								
CONCRETE	.80 - .95								
BRICK	.70 - .80								
DRIVES, WALKS	.75 - .85								
ROOFS	.75 - .95								
GRAVEL ROADS, SHOULDERS	.40 - .60								

TOTAL PROJECT AREA = 36.386 ACRES  
 TOTAL AREA EXPECTED TO BE DISTURBED BY CONSTRUCTION ACTIVITIES = 23.388 ACRES



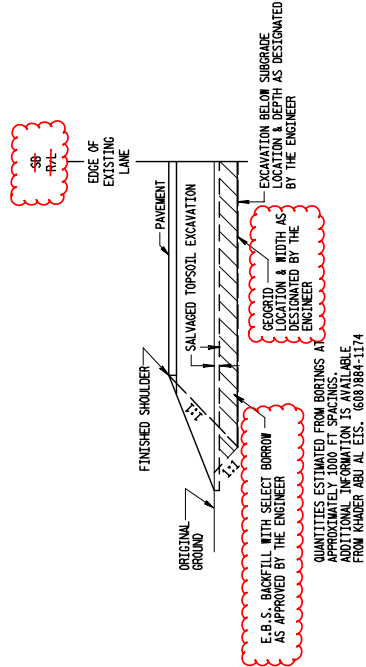


DETAIL FOR EXCAVATION BELOW SUBGRADE

THIS DETAIL TO BE USED FOR REMOVAL OF UNSUITABLE MATERIAL.

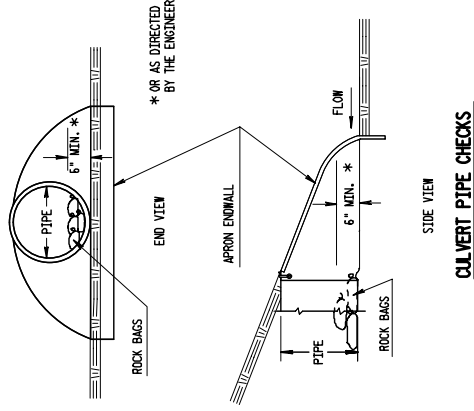


Addendum No. 01  
 ID 1003-10-78  
 Revised Sheet 10  
 June 07, 2016

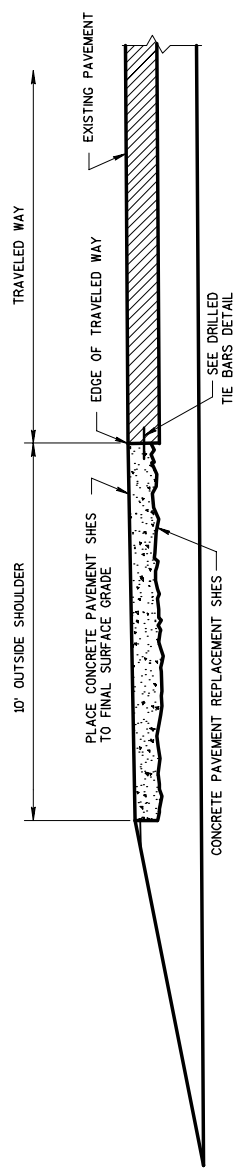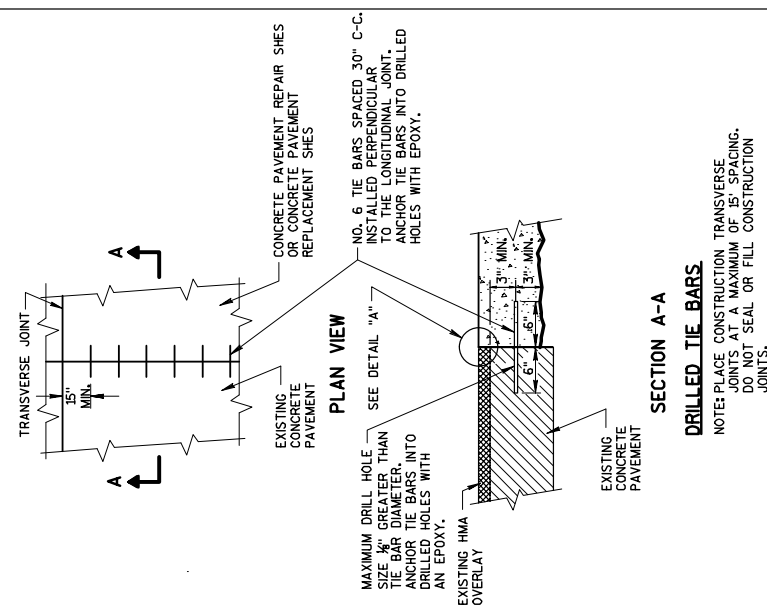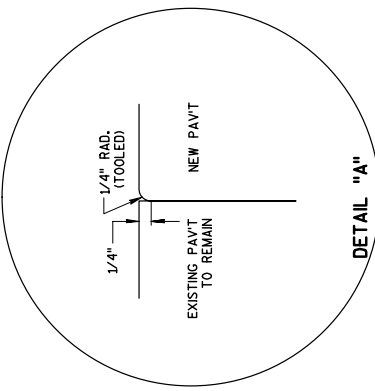

**CONCRETE PAVEMENT REPLACEMENT SHES**

STA. 118+91 - STA. 119+67 LT  
 STA. 127+70 - STA. 128+72 LT

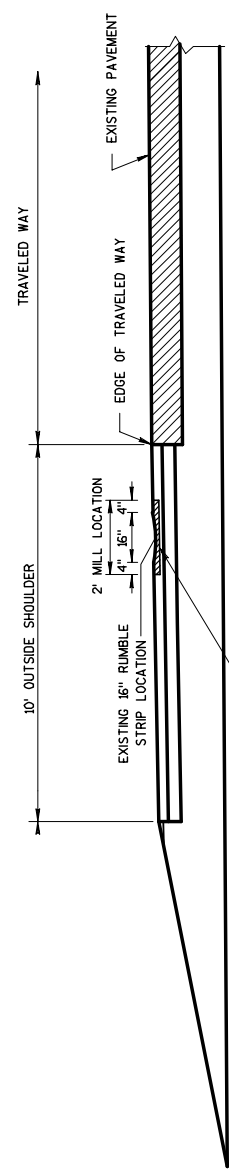

**REMOVING RUMBLE STRIPS - 2' WIDTH**

SEE MISC. QUANTITY SHEETS FOR LOCATIONS

**OUTSIDE SHOULDER REHABILITATION**

Addendum No. 01  
 ID 1003-10-78  
 Revised Sheet 12  
 June 07, 2016

PROJECT NO: 1003-10-78	HWY: IH 39	COUNTY: ROCK	CONSTRUCTION DETAILS	SHEET 12	E
FILE NAME : L:\WORK\PROJECTS\60242687\000_LOAD\001_DRAWINGS\1003-10-78-STATELINE TO CHI S_TEMP\1003\021004_CD.DWG					
PLOT DATE : 6/1/2016 11:04 AM					
PLOT BY : ARBUCKLE, ADRIAN					
PLOT NAME :					
PLOT SCALE : 1:120_XREF					
WISDOT/CADD SHEET 42					

EARTHWORK (PROJECT 1003-10-78)

Category	Division	From/To Station	Location	Excavation Common (CY) 205.0100		Fill (CY)	Roadway Embankment <sup>1</sup> (CY) (4) SPV/0035.001	Mass Ordinate +/- (5)	Select Borrow (CY) 208.1100
				Cut (CY) (2)	EBS (CY) (3)				
1000	1	112+50 - 202+00	SB,RT	5.334	0	3,985	3,985	1,350	0
		204+16 - 213+00	SB,RT	1,167	0	181	181	987	0
		243+00 - 246+49	SB,RT	0	0	52	52	-52	0
		246+49 - 320+00	SB,RT	656	0	1,344	1,344	-688	0
			UNDISTRIBUTED	0	0	0	0	0	0
		Project 1003-10-78 - Division 1 Subtotal		7,157	0	5,561	1,596	0	
		Project 1003-10-78 - Division 1 Total		7,157	0	5,561	1,596	0	
1000	2	110+00 - 202+00	SB,LT	11,249	10,755	7,754	7,754	3,495	10,755
		204+16 - 213+00	SB,LT	590	816	281	281	309	816
		243+00 - 246+49	SB,LT	279	322	29	29	250	322
		246+49 - 320+00	SB,LT	8,191	8,173	5,448	5,448	2,743	8,173
			UNDISTRIBUTED	0	3,010	0	-20,066	0	3,010
		Project 1003-10-78 - Division 2 Subtotal		20,309	23,076	13,512	6,797	23,076	
		Project 1003-10-78 - Division 2 Total		43,385	23,076	13,512	6,797	23,076	
		Project 1003-10-78 Totals		50,542	23,076	27,024	13,494	46,152	

- 1) Excavation Common = Cut + EBS Excavation. Item number 205.0100.
- 2) Cut volume includes concrete and asphaltic surface material.
- 3) EBS Excavation to be identified with Select Borrow.
- 4) Roadway Embankment (Fill)
- 5) The Mass Ordinate is calculated by division. A positive quantity indicates an excess of material within the Division and a negative quantity indicates a shortage of material within the Division. Structure Excavation is not included in this calculation. Mass Ordinate = Cut - Fill. The Mass Ordinate is for information purposes only as Common Excavation and Roadway Embankment are not balanced for quantity purposes and does not guarantee the quality of Common Excavation, and if it can be reused onsite. All EBS material is to be wasted offsite.

Addendum No. 01  
ID 1003-10-78  
Revised Sheet 34  
June 07, 2016

BASE AGGREGATE DENSE

STAGE	STATION -	STATION	LOCATION	211.0500 PREPARE FOUNDATION FOR BASE AGGREGATE	305.0110 BASE AGGREGATE DENSE	305.0120 BASE AGGREGATE DENSE	*624.0100 WATER
				(STA)	(TON)	(TON)	(MGAL)
2	110+00 -	135+00	RT	0	113	6,941	71
	135+00 -	145+00	RT	10	0	392	4
	145+00 -	148+00	RT	0	9	568	6
	148+00 -	161+14	RT	14	5	718	7
	162+70 -	201+28	RT	39	72	3,541	36
	201+28 -	201+80	RT	0	2	209	2
	203+93 -	212+68	RT	0	132	2,245	24
	243+00 -	320+00	RT	77	0	2,102	21
STAGE 2 TOTALS				140	333	16,716	170

STAGE	STATION -	STATION	LOCATION	211.0500 PREPARE FOUNDATION FOR BASE AGGREGATE	305.0110 BASE AGGREGATE DENSE	305.0120 BASE AGGREGATE DENSE	*624.0100 WATER
				(STA)	(TON)	(TON)	(MGAL)
2	110+00 -	135+00	RT	0	113	6,941	71
	135+00 -	145+00	RT	10	0	392	4
	145+00 -	148+00	RT	0	9	568	6
	148+00 -	161+14	RT	14	5	718	7
	162+70 -	201+28	RT	39	72	3,541	36
	201+28 -	201+80	RT	0	2	209	2
	203+93 -	212+68	RT	0	132	2,245	24
	243+00 -	320+00	RT	77	0	2,102	21
STAGE 2 TOTALS				140	333	16,716	170

STAGE	STATION -	STATION	LOCATION	211.0500 PREPARE FOUNDATION FOR BASE AGGREGATE	305.0110 BASE AGGREGATE DENSE	305.0120 BASE AGGREGATE DENSE	*624.0100 WATER
				(STA)	(TON)	(TON)	(MGAL)
3	110+00 -	135+00	LT	0	113	5,943	61
	135+00 -	145+00	LT	0	45	2,628	27
	145+00 -	148+00	LT	0	88	1,437	15
	148+00 -	161+14	LT	0	77	3,008	31
	162+70 -	201+28	LT	0	405	8,769	92
	201+28 -	201+80	LT	0	2	61	1
	203+93 -	212+68	LT	0	150	1,500	16
	243+00 -	320+00	LT	0	406	19,735	201
STAGE 3 TOTALS				0	1,285	43,080	444
UNDISTRIBUTED				0	160	7720	36
PROJECT TOTALS				140	1,778	67,516	672

\* ADDITIONAL QUANTITIES LISTED ELSEWHERE.

CONCRETE PAVEMENT

STAGE	STATION -	STATION	LOCATION	WIDTH (LF)	DRILLED TIE BARS (EACH)	CONCRETE REPLACEMENT SHES (SY)	*690.0250 SAWING CONCRETE
				(LF)	(EACH)	(SY)	(LF)
1	118+91 -	119+67	LT	10	42	85	96
1	127+70 -	128+72	LT	10	48	114	122
STAGE 1 TOTAL				90	199	199	218
PROJECT TOTALS				90	199	199	218

\* ADDITIONAL QUANTITIES SHOWN ELSEWHERE

Addendum No. 01  
ID 1003-10-78  
Revised Sheet 35  
June 07, 2016

PAVEMENT MARKING

STATION	STATION	LOCATION	YELLOW (LF)	WHITE (LF)	WHITE LANE LINE 12.5' LINE 37.5' SKIP MARKINGS (LF)	*646.0600 REMOVING PAVEMENT MARKINGS (LF)
110+00	320+00	RT	21,000	--	--	21,000
110+00	320+00	LT	--	21,000	--	21,000
110+00	320+00	MIDDLE	--	--	5,250	5,250
TOTALS			21,000	21,000	5,250	47,250
TOTAL FOR 646.0106			47,250			
PROJECT TOTALS			47,250			

\*ADDITIONAL QUANTITIES LISTED ELSEWHERE.

COVER PLATE LEFT IN PLACE

STAGE	STATION	LOCATION	STRUCTURE	(EACH)	SNOW FENCE SPV.0060.007 COVER PLATE LEFT IN PLACE	FURNISHING SPV.0090.008	INSTALLING SPV.0090.009	LF	LF
3	162+55	33' LT		1				4,200	4,200
STAGE 3 TOTAL								4,200	4,200
PROJECT TOTALS								4,200	4,200

GEOGRID REINFORCEMENT

SPV.0180.001  
GEOGRID

LOCATION	(SY)
UNDISTRIBUTED	4460
TOTALS	4,460

Addendum No. 01  
ID 1003-10-78  
Revised Sheet 42  
June 07, 2016


TEMPORARY PAVEMENT MARKING

SECTION	STAGE	YELLOW (LF)	WHITE (LF)	*646.0600 REMOVING PAVEMENT MARKING (LF)
SECTION 1	STAGE 2	7200	14200	32000
	STAGE 3	7200	14200	21400
	SECTION 1 TOTAL	7200	14200	21400
SECTION 2	STAGE 2	4000	8000	17000
	STAGE 3	4000	8000	12000
	SECTION 2 TOTAL	4000	8000	12000
SECTION 3	STAGE 1	3000	6000	11700
	STAGE 2	3000	6000	9000
	STAGE 3	7200	14200	21400
SECTION 3 TOTAL	7200	14200	21400	
SECTION 4	STAGE 1	7200	14200	32000
	STAGE 2	7200	14200	21400
	STAGE 3	7200	14200	21400
SECTION 4 TOTAL	14400	28400	42800	
PROJECT TOTALS		72000	97600	97600


\*ADDITIONAL QUANTITIES LISTED ELSEWHERE




Addendum No. 01  
 ID 1003-10-82  
 Revised Sheet 12  
 June 07, 2016

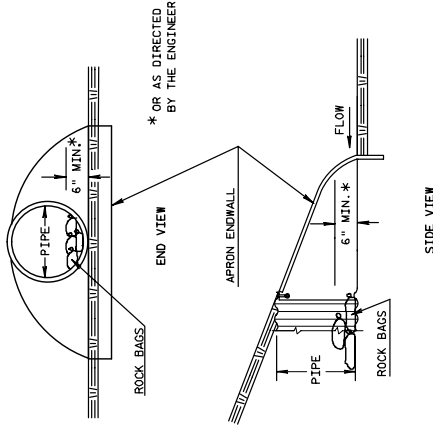

CULVERT PIPE CHECK

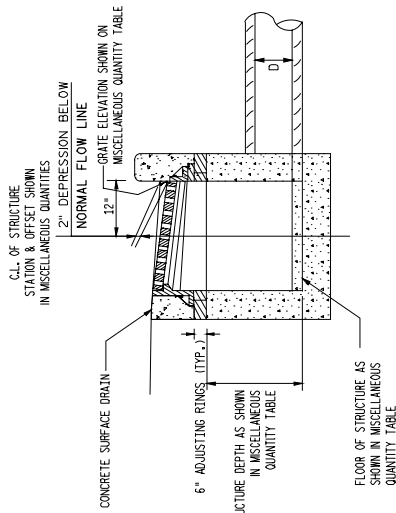

DETAIL OF INLETS AT CONCRETE SURFACE DRAINS

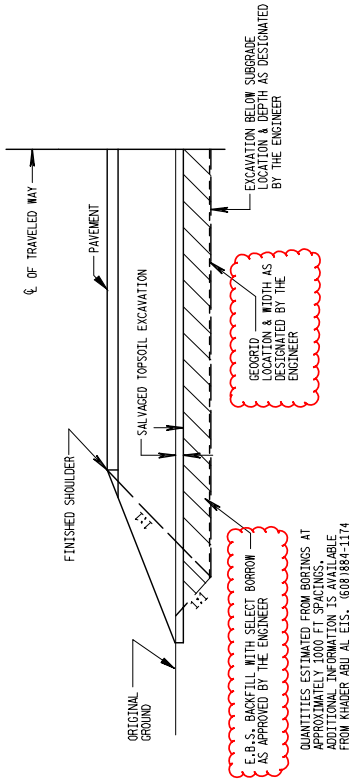

DETAIL FOR EXCAVATION BELOW SUBGRADE

THIS DETAIL TO BE USED FOR REMOVAL OF UNSUITABLE MATERIAL.

RUNOFF COEFFICIENT TABLE

LAND USE:	HYDROLOGIC SOIL GROUP											
	A			B			C			D		
	0-2	2-6	6 & OVER	0-2	2-6	6 & OVER	0-2	2-6	6 & OVER	0-2	2-6	6 & OVER
ROW CROPS	.08	.16	.22	.12	.20	.27	.15	.24	.33	.19	.28	.38
MEDIAN STRIP-TURF	.19	.20	.24	.26	.34	.44	.30	.37	.50	.34	.41	.56
SIDE SLOPE-TURF	.24	.26	.30	.25	.28	.33	.26	.30	.37	.27	.32	.40
PAVEMENT:												
ASPHALT												
CONCRETE												
BRICK												
DRIVES, WALKS												
ROOFS												
GRAVEL ROADS, SHOULDERS												

TOTAL PROJECT AREA = 12.943 ACRES  
 TOTAL AREA EXPECTED TO BE DISTURBED BY CONSTRUCTION ACTIVITIES = 3.479 ACRES

Addendum No. 01  
ID 1003-10-82  
Revised Sheet 119  
June 07, 2016

Category	Division	From/To Station	Location	Excavation Common (CY) 205.0100		Fill (CY)	Roadway Embankment (CY) SPV.0035.001	Mass Ordinate +/- (ft)	Select Borrow (CY) 208.1100
				Cut (CY) (2)	EBS (CY) (3)				
1000	1	13+25'SL' - 20+00'SL'	STATELINE RD	340	0	2,035	2,035	-1,695	0
		21+00'SL' - 26+50'SL'	STATELINE RD	342	0	656	656	-314	0
		100+50 - 108+10	IH 39 MEDIAN	798	0	61	61	738	0
		101+00 - 102+86	WEST ABUTMENT	0	0	401	401	-401	0
		101+50 - 103+50	EAST ABUTMENT	0	0	448	448	-448	0
		UNDISTRIBUTED		0	0	0	0	250	
		Project 1003-10-82 - Division 1 Subtotal		1,481	250	3,600	-2,119	250	
		Project 1003-10-82 - Division 1 Total		1,731	250	3,600		250	
		Project 1003-10-82 Totals		1,731		3,600		250	

- 1) Excavation Common = Cut + EBS Excavation. Item number 205.0100.
- 2) Cut volume includes concrete and asphaltic surface material.
- 3) EBS to be backfilled with Select Borrow.
- 4) Roadway Embankment = Fill
- 5) The Mass Ordinate is calculated by division. A positive quantity indicates an excess of material within the Division and a negative quantity indicates a shortage of material within the Division. Structure Excavation is not included in this calculation. Mass Ordinate = Cut - Fill. The Mass Ordinate is for information purposes only as Common Excavation and Roadway Embankment are not balanced for quantity purposes and does not guarantee the quality of Common Excavation, and it can be reused onsite. All EBS material is to be wasted onsite.

CONCRETE PAVEMENT APPROACH SLAB, CONCRETE SURFACE DRAINS

STATION	STATION	LOCATION	415.0410 CONCRETE PAVEMENT APPROACH SLAB (SY)	416.1010 CONCRETE SURFACE DRAINS (CY)
18+68'SL'	19+10'SL'	RT	--	6
18+79'SL'	19+19'SL'	LT	--	6
18+95'SL'	19+17'SL'	LT/RT	49	--
21+31'SL'	21+71'SL'	RT	--	6
21+33'SL'	21+55'SL'	LT/RT	49	--
21+40'SL'	21+82'SL'	LT	--	6
CATEGORY 1000 TOTALS			98	24
PROJECT TOTALS			98	24

BASE AGGREGATE DENSE

STATION	STATION	LOCATION	305.0110 BASE AGGREGATE DENSE 3/4-INCH (TON)	305.0120 BASE AGGREGATE DENSE 1 1/4-INCH (TON)	312.0110 SELECT GRUSHED MATERIAL (TON)	COMMENTS
13+25'SL'	19+18'SL'	STATELINE ROAD	70	2,420	--	
21+32'SL'	26+50'SL'	STATELINE ROAD	60	1,410	--	
100+66	108+10	IH 39 MEDIAN	140	1,410	--	STAGE 1
102+02	102+66	IH 39 MEDIAN	5	150	--	STAGE 4
		UNDISTRIBUTED	--	--	475	EBS-BACKFILL
CATEGORY 1000 TOTALS			275	5,390	-475	
PROJECT TOTALS			275	5,390	475	

Addendum No. 01  
ID 1003-10-82  
Revised Sheet 120  
June 07, 2016

HMA PAVEMENT ITEMS

STATION	STATION	LOCATION	PAVEMENT DEPTH (INCHES)	460.5223 HMA PAVEMENT (TON)	460.5224 HMA PAVEMENT (TON)	460.7222 HMA PAVEMENT (TON)	460.7424 HMA PAVEMENT (TON)	455.0605 TACK COAT (GAL)	COMMENTS
13+25'SL'	18+95'SL'	STATELINE ROAD	4	300	240	--	--	55	
21+55'SL'	26+50'SL'	STATELINE ROAD	4	250	200	--	--	50	
100+66	108+10	IH 39 SB	6.5	--	--	305	190	30	STAGE 1
101+45	103+10	IH 39 NB	6.5	--	--	30	20	5	STAGE 1
102+02	102+66	IH 39 NB	6.5	--	--	15	10	2	STAGE 4
108+10	118+00	IH 39 SB - RUMBLESTRIP OVERLAY	2	--	--	40	40	10	STAGE 1
100+66	115+51	IH 39 NB - RUMBLESTRIP OVERLAY	2	--	--	25	25	5	STAGE 1
CATEGORY 1000 TOTALS				550	440	350	285	157	
PROJECT TOTALS				550	440	350	285	157	

TEMPORARY PAVEMENT MARKING

STATION	LOCATION	649.0403 TEMPORARY PAVEMENT MARKING EPOXY 4-INCH		COMMENTS
		YELLOW (LF)	WHITE (LF)	
993+00TC' - 1018+00TC'	SB IH 39	2,500	1,950	600 STAGE 1
1008+00TC' - 1013+00TC'	SB CROSSEVER	500	500	-- STAGE 2
	CATEGORY 1000 TOTALS	3,000	2,450	600
	TOTAL FOR 649.0400	5,450		
	PROJECT TOTALS	5,450		600

3

ITS PULL BOX, COMMUNICATION VAULT, & BASE ITEMS

ITEM	STATION	OFFSET	653.0140 PULL BOXES STEEL		672.0250 BASE CAMERA POLE		673.0105 COMMUNICATION VAULT		SPV.0060.006 FIBER TRACER MARKER	
			EA	EA	EA	EA	EA	EA	EA	EA
PROJECT 1003-10-82										
PB1	18+88'SL'	23' LT	1	--	--	--	--	--	--	--
PB2	21+62'SL'	23' LT	1	--	--	--	--	--	--	--
PB3	18+99'SL'	23' RT	1	--	--	--	--	--	--	--
PB4	21+51'SL'	23' RT	1	--	--	--	--	--	--	--
CV1	18+49'SL'	30' LT	--	--	--	1	1	1	1	1
CP1	18+66'SL'	27' LT	--	1	--	--	--	--	--	--
EXCP1	13+20'SL'	46' LT	--	--	--	--	--	--	--	1
	PROJECT TOTALS		4	1	1	1	1	1	1	2

ITS CONDUIT ITEMS

FROM	TO	LINEAR DISTANCE	LF	652.0225 CONDUIT RIGID		671.0122 CONDUIT HDPE		671.0122 CONDUIT 2-DUCT	
				LF	EA	EA	LF	EA	LF
EXCV1	CV1	530	--	1	530	--	--	--	--
CV1	PB1	55	110	--	--	--	--	--	--
CV1	CP1	30	30	--	--	--	--	--	--
	PROJECT TOTALS		140	1	530				

\* ADDITIONAL QUANTITIES LISTED IN STRUCTURE PLANS

SAWING ASPHALT

STATION	STATION	LOCATION	(LF)	COMMENTS
13+25'SL' - 13+25'SL'		LT. & RT.	30	
26+50'SL' - 26+50'SL'		LT. & RT.	30	
100+66 - 108+10		SB IH 39	815	STAGE 1
101+45 - 103+10		NB IH 39	180	STAGE 1
102+02 - 102+66		NB IH 39	85	STAGE 4
		CATEGORY 1000 TOTALS	1,140	
		PROJECT TOTALS	1,140	

Addendum No. 01  
ID 1003-10-82  
Revised Sheet 127  
June 07, 2016

GEOGRID REINFORCEMENT

DESCRIPTION	(SY)
SPV.0180.001 GEOGRID REINFORCEMENT	
UNDISTRIBUTED	900
CATEGORY 1000 TOTALS	900
PROJECT TOTALS	900

MISCELLANEOUS QUANTITIES

COUNTY: ROCK

HWY: IH 39

PROJECT NO: 1003-10-82

SHEET 127

FILE NAME : ...030201.mxd

PLOT DATE : 6/7/2016 2:08 PM

PLOT BY :

PLOT NAME : 030201.mxd

PLOT SCALE : 1:1000000.00000

WISDOT/CADDS SHEET 42

3

## SCHEDULE OF ITEMS

REVISED:

CONTRACT:	PROJECT(S):	FEDERAL ID(S):
20160614003	1003-10-74	N/A
	1003-10-75	N/A
	1003-10-77	N/A
	1003-10-78	N/A
	1003-10-82	N/A

CONTRACTOR : \_\_\_\_\_

LINE NO	ITEM DESCRIPTION	APPROX. QUANTITY AND UNITS	UNIT PRICE		BID AMOUNT	
			DOLLARS	CTS	DOLLARS	CTS
0200	204.0245 Removing Storm Sewer (size) 001. 18-Inch	18.000 LF	.	.	.	.
0210	204.9060.S Removing (item description) 001. Apron Endwall	37.000 EACH	.	.	.	.
0220	205.0100 Excavation Common	126,345.000 CY	.	.	.	.
0230	206.1000 Excavation for Structures Bridges (structure) 001. B-53-316	LUMP	LUMP	.	.	.
0240	206.1000 Excavation for Structures Bridges (structure) 002. B-53-325	LUMP	LUMP	.	.	.
0250	206.1000 Excavation for Structures Bridges (structure) 003. B-53-319	LUMP	LUMP	.	.	.
0260	210.0100 Backfill Structure	2,088.000 CY	.	.	.	.
0270	211.0500 Prepare Foundation for Base Aggregate	250.000 STA	.	.	.	.
0280	213.0100 Finishing Roadway (project) 001. 1003-10-82	1.000 EACH	.	.	.	.

## SCHEDULE OF ITEMS

REVISED:

CONTRACT:	PROJECT(S):	FEDERAL ID(S):
20160614003	1003-10-74	N/A
	1003-10-75	N/A
	1003-10-77	N/A
	1003-10-78	N/A
	1003-10-82	N/A

CONTRACTOR : \_\_\_\_\_

LINE NO	ITEM DESCRIPTION	APPROX. QUANTITY AND UNITS	UNIT PRICE		BID AMOUNT	
			DOLLARS	CTS	DOLLARS	CTS
0290	213.0100 Finishing Roadway (project) 002. 1003-10-74	1.000 EACH	.		.	
0300	213.0100 Finishing Roadway (project) 003. 1003-10-75	1.000 EACH	.		.	
0310	213.0100 Finishing Roadway (project) 004. 1003-10-78	1.000 EACH	.		.	
0320	213.0100 Finishing Roadway (project) 005. 1003-10-77	1.000 EACH	.		.	
0330	305.0110 Base Aggregate Dense 3/4-Inch	7,200.000 TON	.		.	
0340	305.0120 Base Aggregate Dense 1 1/4-Inch	195,971.000 TON	.		.	
0350	305.0130 Base Aggregate Dense 3-Inch	10,854.000 TON	.		.	
0360	312.0110 Select Crushed Material	8,105.000 TON	.		.	
0370	415.0070 Concrete Pavement 7-Inch	42.000 SY	.		.	
0380	415.0080 Concrete Pavement 8-Inch	62.000 SY	.		.	

## SCHEDULE OF ITEMS

REVISED:

CONTRACT:	PROJECT(S):	FEDERAL ID(S):
20160614003	1003-10-74	N/A
	1003-10-75	N/A
	1003-10-77	N/A
	1003-10-78	N/A
	1003-10-82	N/A

CONTRACTOR : \_\_\_\_\_

LINE NO	ITEM DESCRIPTION	APPROX. QUANTITY AND UNITS	UNIT PRICE		BID AMOUNT	
			DOLLARS	CTS	DOLLARS	CTS
0680	517.1010.S Concrete Staining (structure) 001. B-53-316	8,500.000 SF	.	.	.	.
0690	517.1010.S Concrete Staining (structure) 002. B-53-325	7,040.000 SF	.	.	.	.
0700	517.1010.S Concrete Staining (structure) 003. B-53-319	8,110.000 SF	.	.	.	.
0710	520.8000 Concrete Collars for Pipe	55.000 EACH	.	.	.	.
0720	521.0124 Culvert Pipe Corrugated Steel 24-Inch	130.000 LF	.	.	.	.
0730	521.1012 Apron Endwalls for Culvert Pipe Steel 12-Inch	8.000 EACH	.	.	.	.
0740	521.1024 Apron Endwalls for Culvert Pipe Steel 24-Inch	4.000 EACH	.	.	.	.
0750	522.0118 Culvert Pipe Reinforced Concrete Class III 18-Inch	118.000 LF	.	.	.	.
0760	522.0124 Culvert Pipe Reinforced Concrete Class III 24-Inch	66.000 LF	.	.	.	.
0770	522.0130 Culvert Pipe Reinforced Concrete Class III 30-Inch	168.000 LF	.	.	.	.

## SCHEDULE OF ITEMS

REVISED:

CONTRACT:	PROJECT(S):	FEDERAL ID(S):
20160614003	1003-10-74	N/A
	1003-10-75	N/A
	1003-10-77	N/A
	1003-10-78	N/A
	1003-10-82	N/A

CONTRACTOR : \_\_\_\_\_

LINE NO	ITEM DESCRIPTION	APPROX. QUANTITY AND UNITS	UNIT PRICE		BID AMOUNT	
			DOLLARS	CTS	DOLLARS	CTS
0880	522.1018 Apron Endwalls for Culvert Pipe Reinforced Concrete 18-Inch	EACH 24.000	.		.	
0890	522.1024 Apron Endwalls for Culvert Pipe Reinforced Concrete 24-Inch	EACH 24.000	.		.	
0900	522.1030 Apron Endwalls for Culvert Pipe Reinforced Concrete 30-Inch	EACH 5.000	.		.	
0910	522.1036 Apron Endwalls for Culvert Pipe Reinforced Concrete 36-Inch	EACH 3.000	.		.	
0920	522.1048 Apron Endwalls for Culvert Pipe Reinforced Concrete 48-Inch	EACH 5.000	.		.	
0930	522.1054 Apron Endwalls for Culvert Pipe Reinforced Concrete 54-Inch	EACH 3.000	.		.	
0940	524.0618 Apron Endwalls for Culvert Pipe Salvaged 18-Inch	EACH 1.000	.		.	
0950	550.2126 Piling CIP Concrete 12 3/4 X 0. 375-Inch	LF 6,655.000	.		.	



## SCHEDULE OF ITEMS

REVISED:

CONTRACT:	PROJECT(S):	FEDERAL ID(S):
20160614003	1003-10-74	N/A
	1003-10-75	N/A
	1003-10-77	N/A
	1003-10-78	N/A
	1003-10-82	N/A

CONTRACTOR : \_\_\_\_\_

LINE NO	ITEM DESCRIPTION	APPROX. QUANTITY AND UNITS	UNIT PRICE		BID AMOUNT	
			DOLLARS	CTS	DOLLARS	CTS
0960	601.0553 Concrete Curb & Gutter 4-Inch Sloped 36-Inch Type D	335.000 LF	.	.	.	.
0970	601.0557 Concrete Curb & Gutter 6-Inch Sloped 36-Inch Type D	328.000 LF	.	.	.	.
0980	603.8000 Concrete Barrier Temporary Precast Delivered	20,258.000 LF	.	.	.	.
0990	603.8125 Concrete Barrier Temporary Precast Installed	27,448.000 LF	.	.	.	.
1000	604.0500 Slope Paving Crushed Aggregate	1,003.000 SY	.	.	.	.
1010	606.0200 Riprap Medium	100.000 CY	.	.	.	.
1020	608.0412 Storm Sewer Pipe Reinforced Concrete Class IV 12-Inch	1,080.000 LF	.	.	.	.
1030	608.0418 Storm Sewer Pipe Reinforced Concrete Class IV 18-Inch	15.000 LF	.	.	.	.
1040	611.0610 Inlet Covers Type BW	24.000 EACH	.	.	.	.
1050	611.0642 Inlet Covers Type MS	7.000 EACH	.	.	.	.

SCHEDULE OF ITEMS

REVISED:

CONTRACT:	PROJECT(S):	FEDERAL ID(S):
20160614003	1003-10-74	N/A
	1003-10-75	N/A
	1003-10-77	N/A
	1003-10-78	N/A
	1003-10-82	N/A

CONTRACTOR : \_\_\_\_\_

LINE NO	ITEM DESCRIPTION	APPROX. QUANTITY AND UNITS	UNIT PRICE		BID AMOUNT	
			DOLLARS	CTS	DOLLARS	CTS
1350	621.0100 Landmark Reference Monuments	4.000 EACH	.	.	.	.
1360	624.0100 Water	5,087.000 MGAL	.	.	.	.
1370	625.0500 Salvaged Topsoil	246,661.000 SY	.	.	.	.
1380	627.0200 Mulching	147,075.000 SY	.	.	.	.
1390	628.1504 Silt Fence	49,968.000 LF	.	.	.	.
1400	628.1520 Silt Fence Maintenance	49,968.000 LF	.	.	.	.
1410	628.1905 Mobilizations Erosion Control	29.000 EACH	.	.	.	.
1420	628.1910 Mobilizations Emergency Erosion Control	18.000 EACH	.	.	.	.
1430	628.2004 Erosion Mat Class I Type B	74,726.000 SY	.	.	.	.
1440	628.2023 Erosion Mat Class II Type B	2,624.000 SY	.	.	.	.

SCHEDULE OF ITEMS

REVISED:

CONTRACT:	PROJECT(S):	FEDERAL ID(S):
20160614003	1003-10-74	N/A
	1003-10-75	N/A
	1003-10-77	N/A
	1003-10-78	N/A
	1003-10-82	N/A

CONTRACTOR : \_\_\_\_\_

LINE NO	ITEM DESCRIPTION	APPROX. QUANTITY AND UNITS	UNIT PRICE		BID AMOUNT	
			DOLLARS	CTS	DOLLARS	CTS
2140	690.0150 Sawing Asphalt	21,513.000 LF	.	.	.	.
2150	690.0250 Sawing Concrete	57,388.000 LF	.	.	.	.
2160	715.0415 Incentive Strength Concrete Pavement	1,000.000 DOL	1.00000		1000.00	
2170	715.0502 Incentive Strength Concrete Structures	10,920.000 DOL	1.00000		10920.00	
2180	SPV.0035 Special 001. Roadway Embankment	237,383.000 CY	.	.	.	.
2190	SPV.0060 Special 001. Baseline CPM Progress Schedule	1.000 EACH	.	.	.	.
2200	SPV.0060 Special 002. CPM Progress Schedule Updates and Accepted Revisions	26.000 EACH	.	.	.	.
2210	SPV.0060 Special 003. Access Gate 6-Foot	4.000 EACH	.	.	.	.
2220	SPV.0060 Special 004. Salvage Terminal High-Tension Cable TL-3, Gibraltar	3.000 EACH	.	.	.	.

SCHEDULE OF ITEMS

REVISED:

CONTRACT:	PROJECT(S):	FEDERAL ID(S):
20160614003	1003-10-74	N/A
	1003-10-75	N/A
	1003-10-77	N/A
	1003-10-78	N/A
	1003-10-82	N/A

CONTRACTOR : \_\_\_\_\_

LINE NO	ITEM DESCRIPTION	APPROX. QUANTITY AND UNITS	UNIT PRICE		BID AMOUNT	
			DOLLARS	CTS	DOLLARS	CTS
2410	SPV.0105 Special 005. Survey Project 1003-10-82	LUMP	LUMP			.
2420	208.1100 Select Borrow	53,078.000 CY		.		.
2430	SPV.0060 Special 006. Removing Billboard Sign and Sign Structure	1.000 EACH		.		.
2440	SPV.0180 Special 001. Geogrid Reinforcement	15,932.000 SY		.		.
	SECTION 0001 TOTAL					.
	TOTAL BID					.