



# Wisconsin Department of Transportation

February 27, 2018

**Division of Transportation Systems Development**

Bureau of Project Development  
 4802 Sheboygan Avenue, Rm 601  
 P O Box 7916  
 Madison, WI 53707-7916

Telephone: (608) 266-1631  
 Facsimile (FAX): (608) 266-8459

**NOTICE TO ALL CONTRACTORS:**

**Proposal #29: 1517-75-73, WISC 2018 157  
 USH 10 – USH 10/STH 441  
 County CB – Oneida Street  
 USH 10  
 Winnebago County**

**1517-75-79, WISC 2018 158  
 USH 10 – USH 10/STH 441  
 County CB – Oneida Street  
 USH 10  
 Winnebago County**

**Letting of March 13, 2018**

This is Addendum No. 01, which provides for the following:

**Special Provisions:**

Revised Special Provisions	
Article No.	Description
2.1	Prosecution and Progress
7.1	Traffic
13.11	Wall Concrete Panel Mechanically Stabilized Earth R-08-002

Added Special Provisions	
Article No.	Description
1.7	Contractor Data Package

**Schedule of Items:**

Revised Bid Item Quantities					
Bid Item	Item Description	Unit	Old Quantity	Revised Quantity	Proposal Total
603.8000	Concrete Barrier Temporary Precast Delivered	LF	58,911	1,539	60,450
603.8125	Concrete Barrier Temporary Precast Installed	LF	82,509	591	83,100
608.0312	Storm Sewer Pipe Reinforced Concrete Class III 12-Inch	LF	2,749	10	2,759
608.0318	Storm Sewer Pipe Reinforced Concrete Class III 18-Inch	LF	2,884	5	2,889
611.0535	Manhole Covers Type J-S	LF	35	-1	34
611.0624	Inlet Covers Type H	Each	55	2	57
611.2005	Manholes 5-FT Diameter	Each	10	-1	9

611.3004	Inlets 4-FT Diameter	Each	95	2	97
SPV.0090.200	Maintain and Remove Concrete Barrier Temporary Precast Left in Place	LF	20,710	-3,806	16,904
SPV.0090.201	Concrete Barrier Temporary Precast Anchoring	LF	14,010	591	14,601

Added Bid Item Quantities					
Bid Item	Item Description	Unit	Old Quantity	Revised Quantity	Proposal Total
305.0500	Shaping Shoulders	STA	0	72	72

**Plan Sheets:**

Revised Plan Sheets	
Plan Sheet	Plan Sheet Title (brief description of changes to sheet)
<b>1517-75-73</b>	
3	1517-75-73 General Notes Revision
70	1517-75-73 Night Installation of Storm Sewer Construction Detail Revision
537-539	1517-75-73 Traffic Control Sheets updated with Temp Barrier Revisions
541-543	1517-75-73 Traffic Control Sheets updated with Temp Barrier Revisions
823	1517-75-73 Miscellaneous Quantity update to include note regarding clearing and grubbing
830-832	1517-75-73 Miscellaneous Quantity update to add Shoulder Shaping
841-842	1517-75-73 Miscellaneous Quantity update to revise Temporary Barrier quantities
1,249 & 1,253	1517-75-73 Structure Plan S-70-235 sheets 3 & 7 (of 10) revised
<b>1517-75-79</b>	
96-102	1517-75-79 Storm Sewer Plans Revision
189-190	1517-75-79 Miscellaneous Quantity update to revise Storm Sewer Structure quantities
193-194	1517-75-79 Miscellaneous Quantity update to revise Storm Sewer Pipe quantities

The responsibility for notifying potential subcontractors and suppliers of these changes remains with the prime contractor.

Sincerely,

*Mike Coleman*

Proposal Development Specialist  
Proposal Management Section

**ADDENDUM NO. 01**

**1517-75-73/79**

**February 27, 2018**

**Special Provisions**

**1.7 Contractor Data Packet.**

The department will provide electronic design data for projects 1517-75-73 and 1517-75-79. The data provided is for the bidder's general knowledge only and is not a part of the contract. The department assumes no responsibility for discrepancies between the data provided and the contract documents.

The department will provide the project contractor data packet before the project let date within 5 business days of a contractor request submitted by email to Garrett Vickman at [atgarrett.vickman@dot.wi.gov](mailto:atgarrett.vickman@dot.wi.gov).

The contractor data packet contains the following:

1. Existing topographic data, 2D AutoCAD DWG files
2. Reference line alignments and proposed profiles, LandXML v1.2 file(s)
3. Superelevation transition information, comma separated value (csv) text file(s)
4. Proposed roadway features, 2D AutoCAD DWG file
5. Proposed structure horizontal features, 2D in AutoCAD DWG file
6. Surface models, LandXML v1.2 files and AutoCAD DWG files containing 3D face objects representing surface TIN triangles of surface models as follows:
  - a. Existing ground surface
  - b. Proposed top surface
    - i. Top of topsoil outside the roadway subgrade shoulder points extended to the slope intercepts
    - ii. Top of shoulder and top of pavement within the roadway subgrade
  - c. Proposed datum surface
    - i. Top of topsoil outside the roadway subgrade shoulder points extended to the slope intercepts
    - ii. Subgrade surface within the roadway subgrade shoulder points
7. Proposed surface model longitudinal breaklines, 3D AutoCAD DWG files
8. Surface model outer boundaries, 3D AutoCAD DWG file
9. Slope stake report, comma separated value (csv) text file
10. Earthwork data, Excel spreadsheet xlsx file(s)
11. Right of Way and easement data, 2D AutoCAD DWG file

**2.1 Prosecution and Progress.**

*Add following paragraph*

No temporary pavement marking is to be placed on polymer overlays. Contractor may gap temporary pavement marking over the bridges with polymer overlays as needed.

**7.1 Traffic.**

*Replace entire section titled **Width Restrictions and Lane Closure System** with the following:*

**Width Restrictions and Lane Closure System**

Provide proper signing see construction detail- Lane Closure-Regulatory Speed Reduction without Barrier. Provide advanced signing at any location where the available lane width is less than 16-feet.

*Add the following section titled **Rolling Closures** at the end of the article:*

### **Rolling Closures**

For structure work and equipment moves, WIS 441/US 10 and US 41 may be closed for periods not to exceed 20 minutes between the hours of 10:00 PM to the following morning at 5:00 AM, Sunday, Monday, Tuesday, Wednesday, and Thursday nights. Allow all vehicle backups to clear the project area prior to setting up the next road closure during the above timeframe. The department has contracted with the Wisconsin State Highway Patrol to assist with traffic control operations by setting up rolling roadblocks for these closures. Coordinate with the Traffic Management Engineer, Susan Paulus 414-460-3409, on these road closures and provide 72 hours prior notice to the engineer. (NER441-20141017)

### **13.11 Wall Concrete Panel Mechanically Stabilized Earth R-08-002, Item SPV.0165.854.**

*Replace paragraph nine under section titled **B.2 Design Requirements** with the following:*

The wall facing shall be designed in accordance with AASHTO LRFD 11.10.2.3. The facing panels shall also be designed to resist compaction stresses that occur during the wall erection. The minimum thickness of the facing panel shall be 5.5 inches. The surface area of a standard single panel cannot exceed 30 square feet. The maximum height of a standard panel shall be 5 feet. The top and bottom panels may exceed 5 foot in height based on site topography subject to the approval by the Structures Design Section. The design of the steel reinforcement within the panels shall be based on one-way bending action. Design the wall panels and joints between panels to accommodate a maximum differential settlement of 1 foot over a 100-foot length, unless the plans indicate other.

### **Schedule of Items**

Attached, dated February 27, 2018, are the revised Schedule of Items Pages 8, 10, 11, 30, and 33.

### **Plan Sheets**

The following 8½ x 11-inch sheets are attached and made part of the plans for this proposal:

1517-75-73

Revised: 3, 70, 537 – 539, 541 – 543, 823, 830 – 832, 841, 842, 1249, and 1253.

1517-75-79

Revised: 96 – 102, 189, 190, 193, and 194.

END OF ADDENDUM

GENERAL NOTES

THE LOCATIONS OF EXISTING AND PROPOSED UTILITY INSTALLATIONS AS SHOWN ON THE PLANS ARE APPROXIMATE. THERE MAY BE OTHER UTILITY INSTALLATIONS WITHIN THE PROJECT AREA THAT ARE NOT SHOWN.

NOTIFY DIGGERS HOTLINE AND AFFECTED UTILITIES PRIOR TO THE START OF WORK. ANY LOCAL MUNICIPAL UTILITY WHICH IS NOT A MEMBER OF THE DIGGERS HOTLINE MUST BE CONTACTED SEPARATELY.

NO TREES OR SHRUBS ARE TO BE REMOVED WITHOUT APPROVAL OF THE ENGINEER.

RIGHT OF WAY LINES SHOWN ON CROSS SECTIONS ARE APPROXIMATE.

PROTECT INLETS WITH PROPER INLET PROTECTION AT LOCATIONS EXHIBITING RISK OF BEING IMPACTED BY CONSTRUCTION OPERATIONS AS SHOWN ON THE PLANS, OR AS DIRECTED BY THE ENGINEER.

THE CONTRACTOR SHALL BE RESPONSIBLE FOR RESHAPING AND SEEDING ANY PREVIOUSLY GRASSED AREAS WHICH ARE DISTURBED BY ANY OPERATION OUTSIDE OF THE NORMAL CONSTRUCTION LIMITS AT THE CONTRACTOR EXPENSE.

PLACE ALL SALVAGED TOPSOIL IN ALL GRASSED AREAS DESIGNATED BY THE ENGINEER IMMEDIATELY AFTER GRADING HAS BEEN COMPLETED. SEED, MULCH AND FERTILIZE OR SOD AND FERTILIZE ALL AREAS 5 DAYS AFTER PLACEMENT OF SALVAGED TOPSOIL.

ALL HOLES OR OPENINGS BELOW SUBGRADE RESULTING FROM ABANDONMENT OR REMOVAL OF EXISTING STRUCTURES SHALL BE FILLED WITH COMPACTED GRANULAR BACKFILL OR AS DIRECTED BY THE ENGINEER.

A SAWED JOINT IS REQUIRED WHERE NEW HMA PAVEMENT MEETS EXISTING HMA PAVEMENT. CURB AND GUTTER GRADES ARE GIVEN TO THE FLANGE. CURB AND GUTTER RADII ARE MEASURED TO THE FLANGE.

SAWCUT ASPHALTIC AND CONCRETE DRIVEWAYS AND/OR PARKING LOTS AT THE MATCHLINE AS SHOWN ON THE PAVING DETAILS OR AS DIRECTED BY THE ENGINEER.

TEMPORARY STORAGE OF ANY EXCAVATED MATERIAL WILL NOT BE PERMITTED IN WETLANDS, FLOODWAY OR FLOODPLAIN OF ANY WATERWAY.

FERTILIZER SHALL NOT BE USED NEAR NAVIGABLE WATERWAYS OR WETLANDS.

BROKEN CONCRETE CONTAINING STEEL SHALL NOT BE USED AS RIPRAP OR HEAVY RIPRAP. THE EXACT LOCATIONS AND LIMITS OF PRIVATE ENTRANCES SHALL BE DETERMINED BY THE ENGINEER.

VERIFY PROPOSED BEAUGUARD AND THRIE BEAM POST SPACING PRIOR TO SIGN STRUCTURE AND DRAINAGE STRUCTURE PLACEMENT.

PLACE ALL TOPSOIL IN ALL GRASSED AREAS DESIGNATED BY THE ENGINEER IMMEDIATELY AFTER GRADING HAS BEEN COMPLETED. SEED, MULCH AND FERTILIZE OR SOD AND FERTILIZE ALL AREAS 5 DAYS AFTER PLACEMENT OF TOPSOIL.

CROSS SECTIONS SHOWN INCLUDE THE THICKNESS OF TOPSOIL WHERE REQUIRED. TOPSOIL SHALL BE REPLACED WITH SPECIFIED THICKNESS AS OUTLINED IN THE STANDARD SPECIFICATIONS AND SPECIAL PROVISIONS.

THE EROSION CONTROL FEATURES AS SHOWN ON THE PLANS ARE AT SUGGESTED LOCATIONS. EXACT LOCATION WILL BE DETERMINED BY THE ENGINEER.

REMOVAL OF EROSION CONTROL DEVICES IS INCIDENTAL TO THE COST OF THEIR RESPECTIVE BID ITEMS.

EROSION CONTROL DEVICES SHALL BE PLACED IN SEQUENCE WITH CONSTRUCTION OPERATIONS OR AS DETERMINED BY THE ENGINEER.

TRAFFIC CONTROL DEVICES SHALL BE ADJUSTED TO FIELD CONDITIONS AS DIRECTED BY THE ENGINEER.

SIGNS IN CONFLICT WITH TRAFFIC CONTROL "IN USE" SHALL BE COVERED AS DIRECTED BY THE ENGINEER AND PAID FOR UNDER THE ITEM "TRAFFIC CONTROL COVERING SIGNS TYPE 1 OR TYPE 2".

BENCHMARK LOCATIONS SHOWN ON PLAN ARE APPROXIMATE AND SHOULD BE VERIFIED.

ALL ITEMS ASSOCIATED WITH STONING REMOVALS ARE SHOWN ON STONING PLAN, EXCEPT FOR REMOVING OLD SIGN STRUCTURES.

PRIOR TO ORDERING DRAINAGE PIPES AND STRUCTURES, THE CONTRACTOR SHALL VERIFY RELATED DRAINAGE INFORMATION IN THE PLAN AND PROVIDE DOCUMENTATION TO THE ENGINEER IN ACCORDANCE WITH THE SPECIFICATIONS. THIS ALSO INCLUDES VERIFICATION OF INVERT ELEVATIONS AT ALL PROPOSED STORM SEWER CONNECTION POINTS TO EXISTING SYSTEMS.


ANY MESH MATERIAL THAT IS FOUND IN EXISTING PAVEMENT WILL BE INCIDENTAL TO THE REMOVAL OF THE PAVEMENT IN THAT SECTION. EXISTING PAVEMENT DEPTHS ARE BASED ON AS-BUILT DATA AND MAY VARY IN THE FIELD.

STATIONING, DISTANCES AND OFFSETS FOR SIGNS SHOWN IN THE PLANS ARE APPROXIMATE AND THE FINAL LOCATIONS ARE TO BE DETERMINED BY THE ENGINEER.

EXCAVATION REQUIRED FOR ALL SIGN STRUCTURES, BRIDGES, AND RETAINING WALLS IS TO BE ACCURATE TO THE COMPUTER EARTHWORK AND IS INCIDENTAL TO THE PERTINENT STRUCTURE ITEMS. SEE STRUCTURE PLANS FOR ADDITIONAL GUIDANCE ON REQUIRED EXCAVATION LIMITS.

NO TEMPORARY PAVEMENT MARKING IS TO BE PLACED ON POLYMER OVERLAYS. CONTRACTOR MAY GAP TEMPORARY PAVEMENT MARKING OVER THE BRIDGES WITH POLYMER OVERLAYS AS NEEDED.

Addendum No. 01  
ID 1517-75-73  
Revised Sheet 3  
February 27, 2018

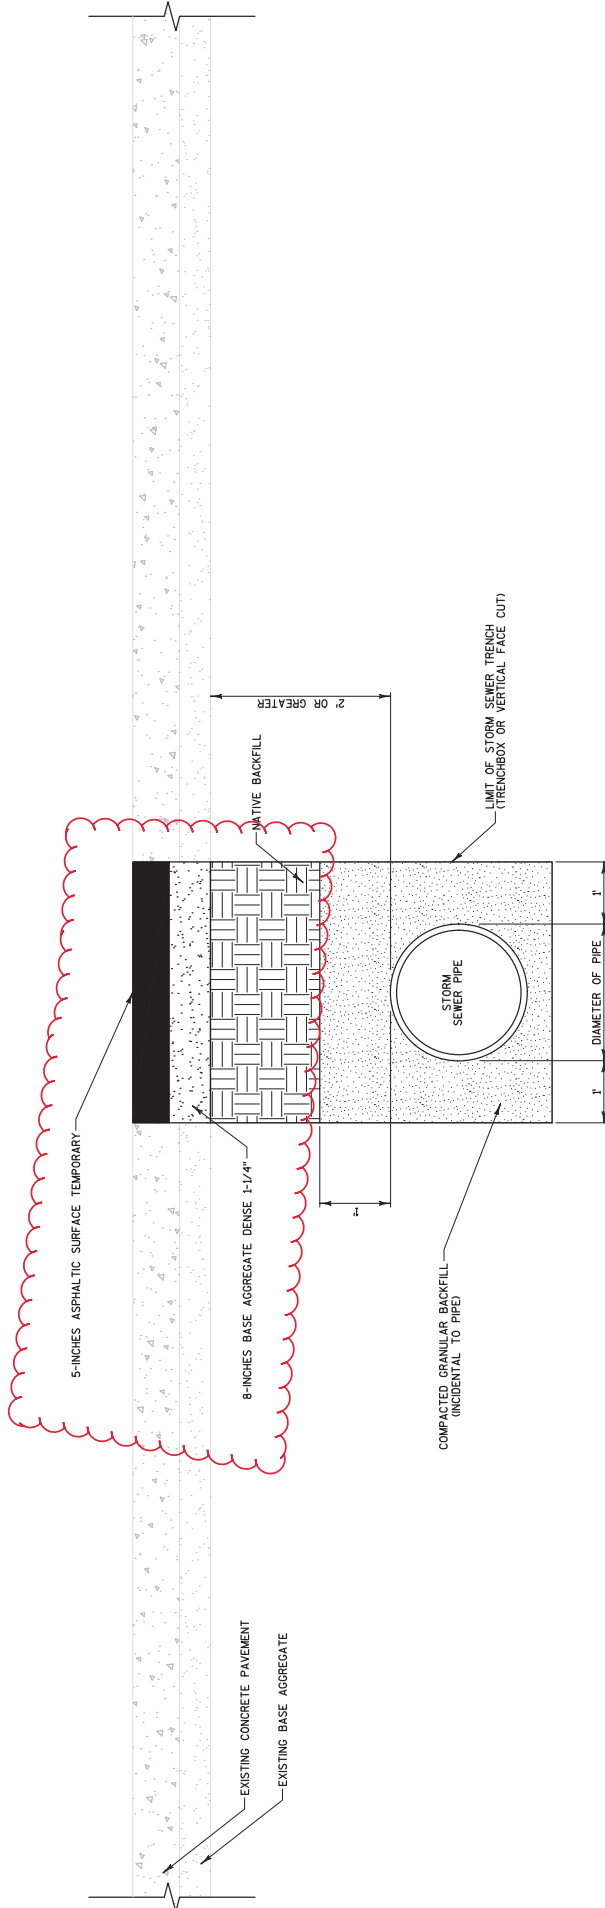

NOTES:

- 1) NATIVE BACKFILL SHALL BE FREE OF LARGE LUMPS, CLODS, OR ROCK.
- 2) HMA PAVEMENT AND BASE AGGREGATE DENSE WILL BE PAID FOR UNDER THEIR APPROPRIATE BID ITEMS.

**TYPICAL NIGHT TIME CLOSURE  
FOR STORM SEWER INSTALLATION**

Addendum No. 01  
ID 1517-75-73  
Revised Sheet 70  
February 27, 2018

PROJECT NO: 1517-75-73

HWY: STH 441/USH 10

COUNTY: WINNEBAGO

PLAN: CONSTRUCTION DETAIL

SHEET 70

E

FILE NAME : S:\NPOS\G30\WIS441\15177574-75\SHEETS\PLAN\15177574\021000\_CD\1517-75-73\NE-15177573-021001-CD.DWG  
NE-15177573-021001-CD - 021014-cd


PLOT DATE : 2/20/2018 1:28 PM

PLOT BY : MARTENS, JOHN M

PLOT SCALE : 1 IN:10 FT

WISDOT/CADD SHEET 42

IP

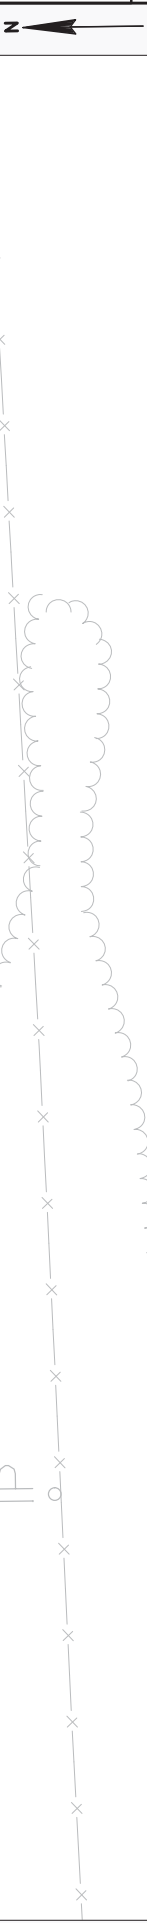

325EB+87 MATCH LINE

319EB+86 MATCH LINE

Addendum No. 01  
 ID 1517-75-73  
 Revised Sheet 537  
 February 27, 2018


SIGN

FOOTBRIDGE

FOOTBRIDGE

PROJECT NO: 1517-75-73	HWY: STH 441/USH 10	COUNTY: WINNEBAGO	TRAFFIC CONTROL STAGE 2	SHEET 537	E
FILE NAME : S:\NPOS\C30\WIS441\15177574-79\SHEETS\PLAN\15177574-025001.LTC\1517-75-73\NE-15177573-026101-TCS2.DWG					
LAYOUT NAME - 026106-TCS2					
PLOT DATE : 2/22/2018 11:44 AM					
PLOT BY : MARTENS, JOHN M					
PLOT NAME :					
PLOT SCALE : 1 IN=40 FT					
WISDOT/CADD'S SHEET 42					


Addendum No. 01  
 ID 1517-75-73  
 Revised Sheet 538  
 February 27, 2018

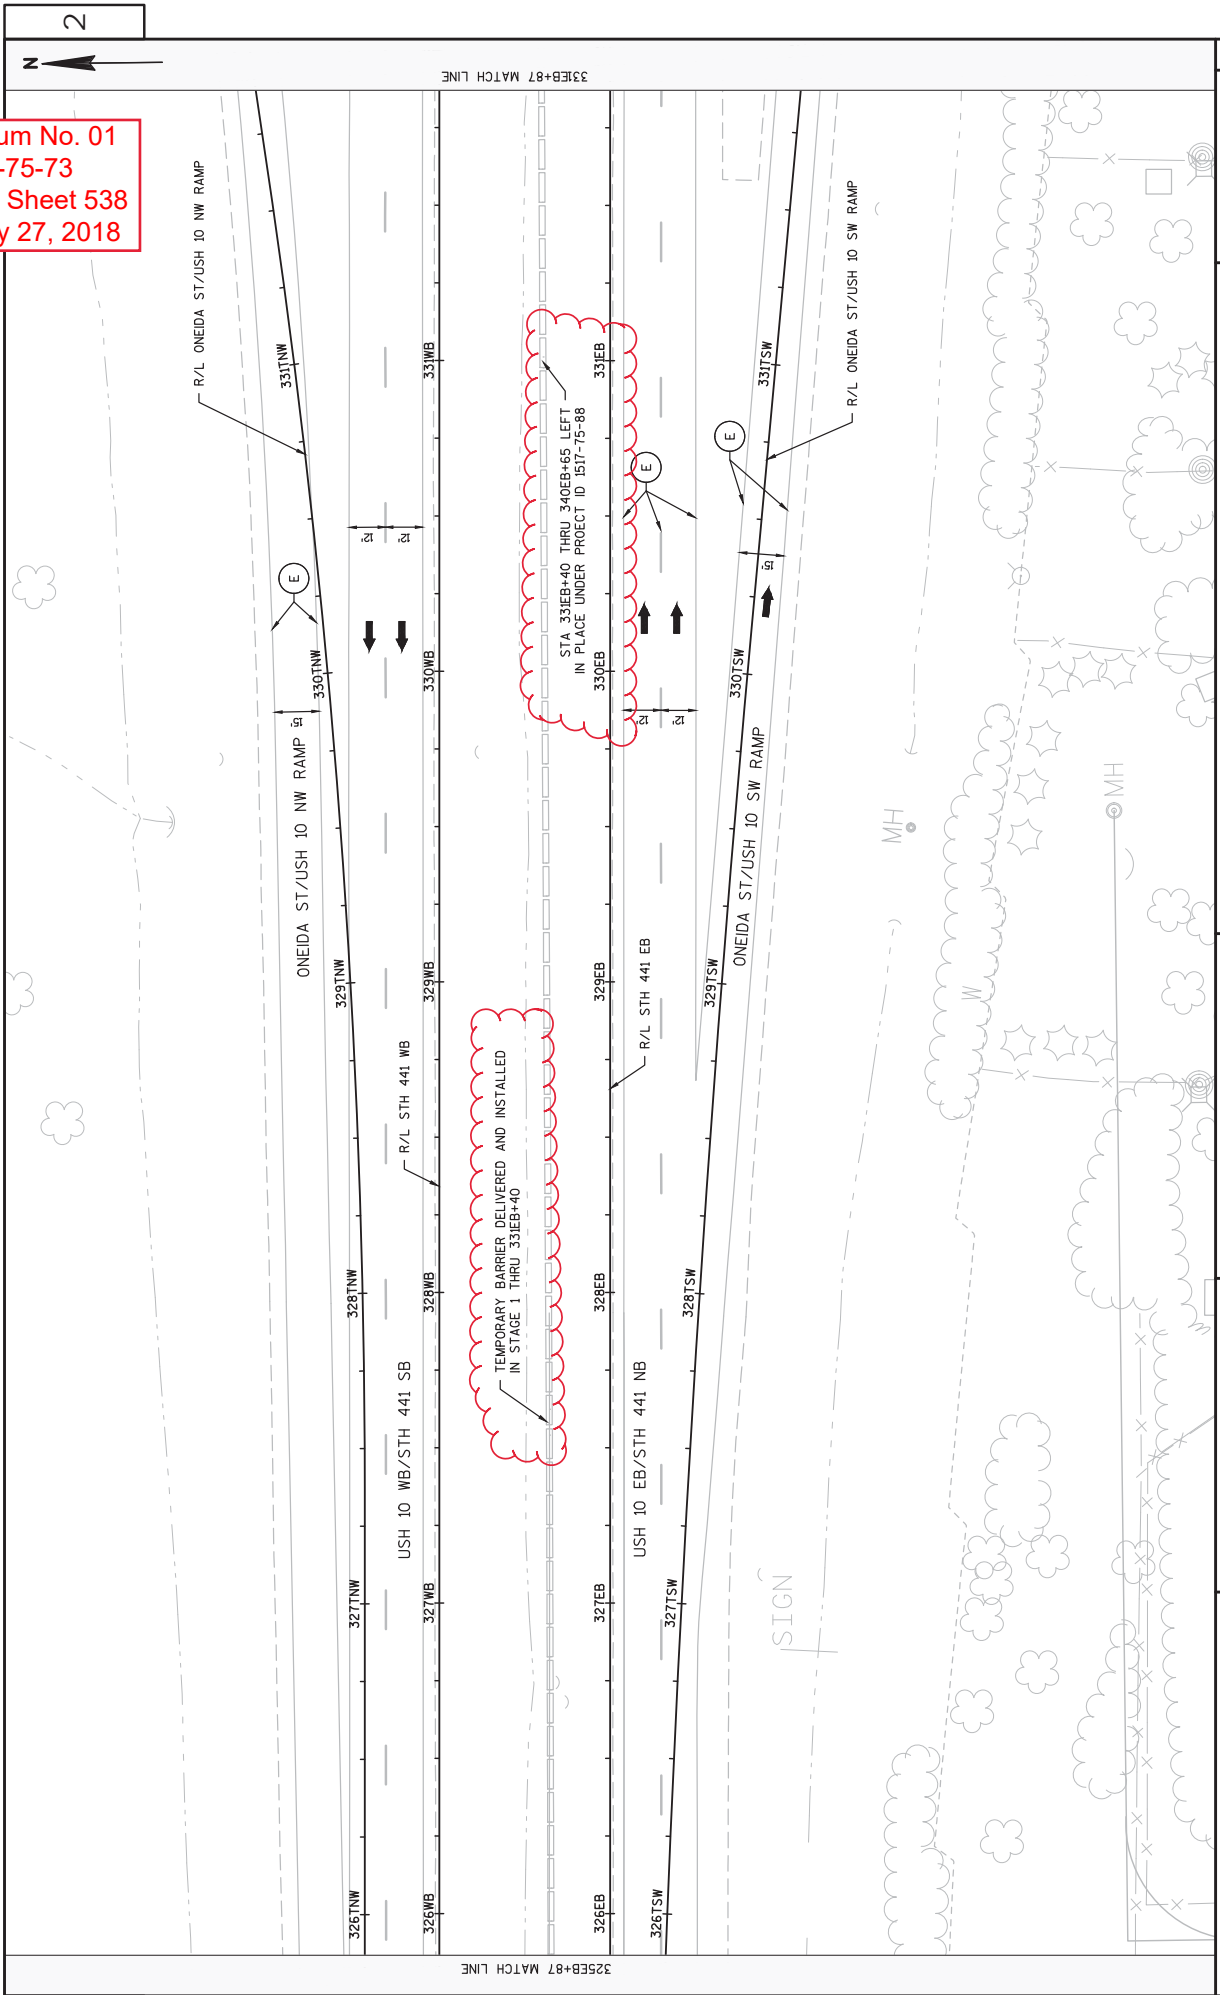


PROJECT NO: 1517-75-73	HWY: STH 441/USH 10	COUNTY: WINNEBAGO	TRAFFIC CONTROL STAGE 2	SHEET 538
FILE NAME : S:\NPOS\C3D\WIS441\15177574-79\SHEETS\PLAN\15177574-025001.LTC\1517-75-73\NE-15177573-026101-TCS2.DWG LAYOUT NAME - 026107-TCS2 PLOT DATE : 2/22/2018 11:44 AM PLOT BY : MARTENS, JOHN M PLOT NAME : PLOT SCALE : 1 IN=40 FT WISDOT/CADD SHEET 42				



**Addendum No. 01**  
**ID 1517-75-73**  
**Revised Sheet 539**  
**February 27, 2018**

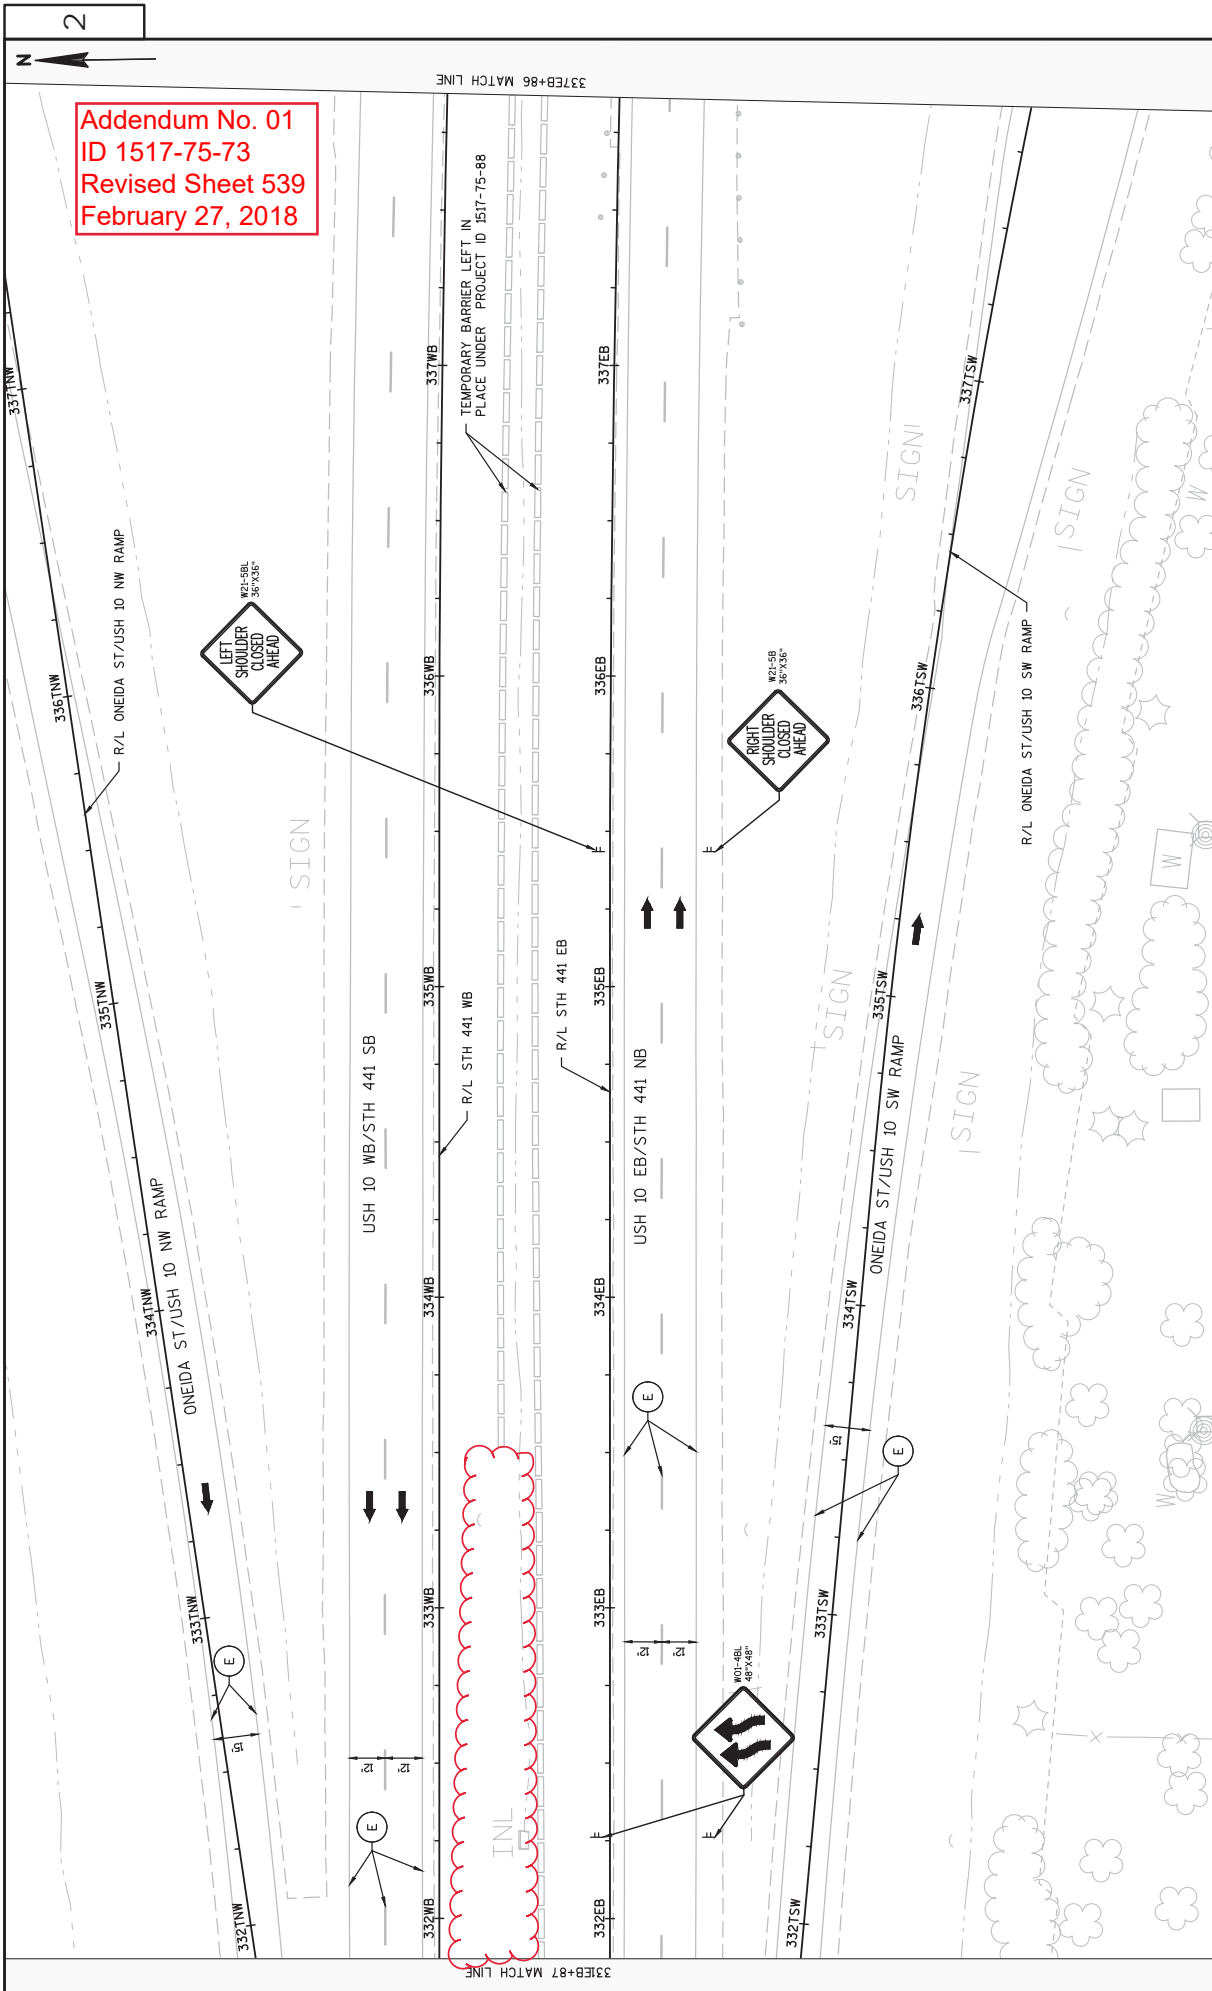

Addendum No. 01  
 ID 1517-75-73  
 Revised Sheet 541  
 February 27, 2018

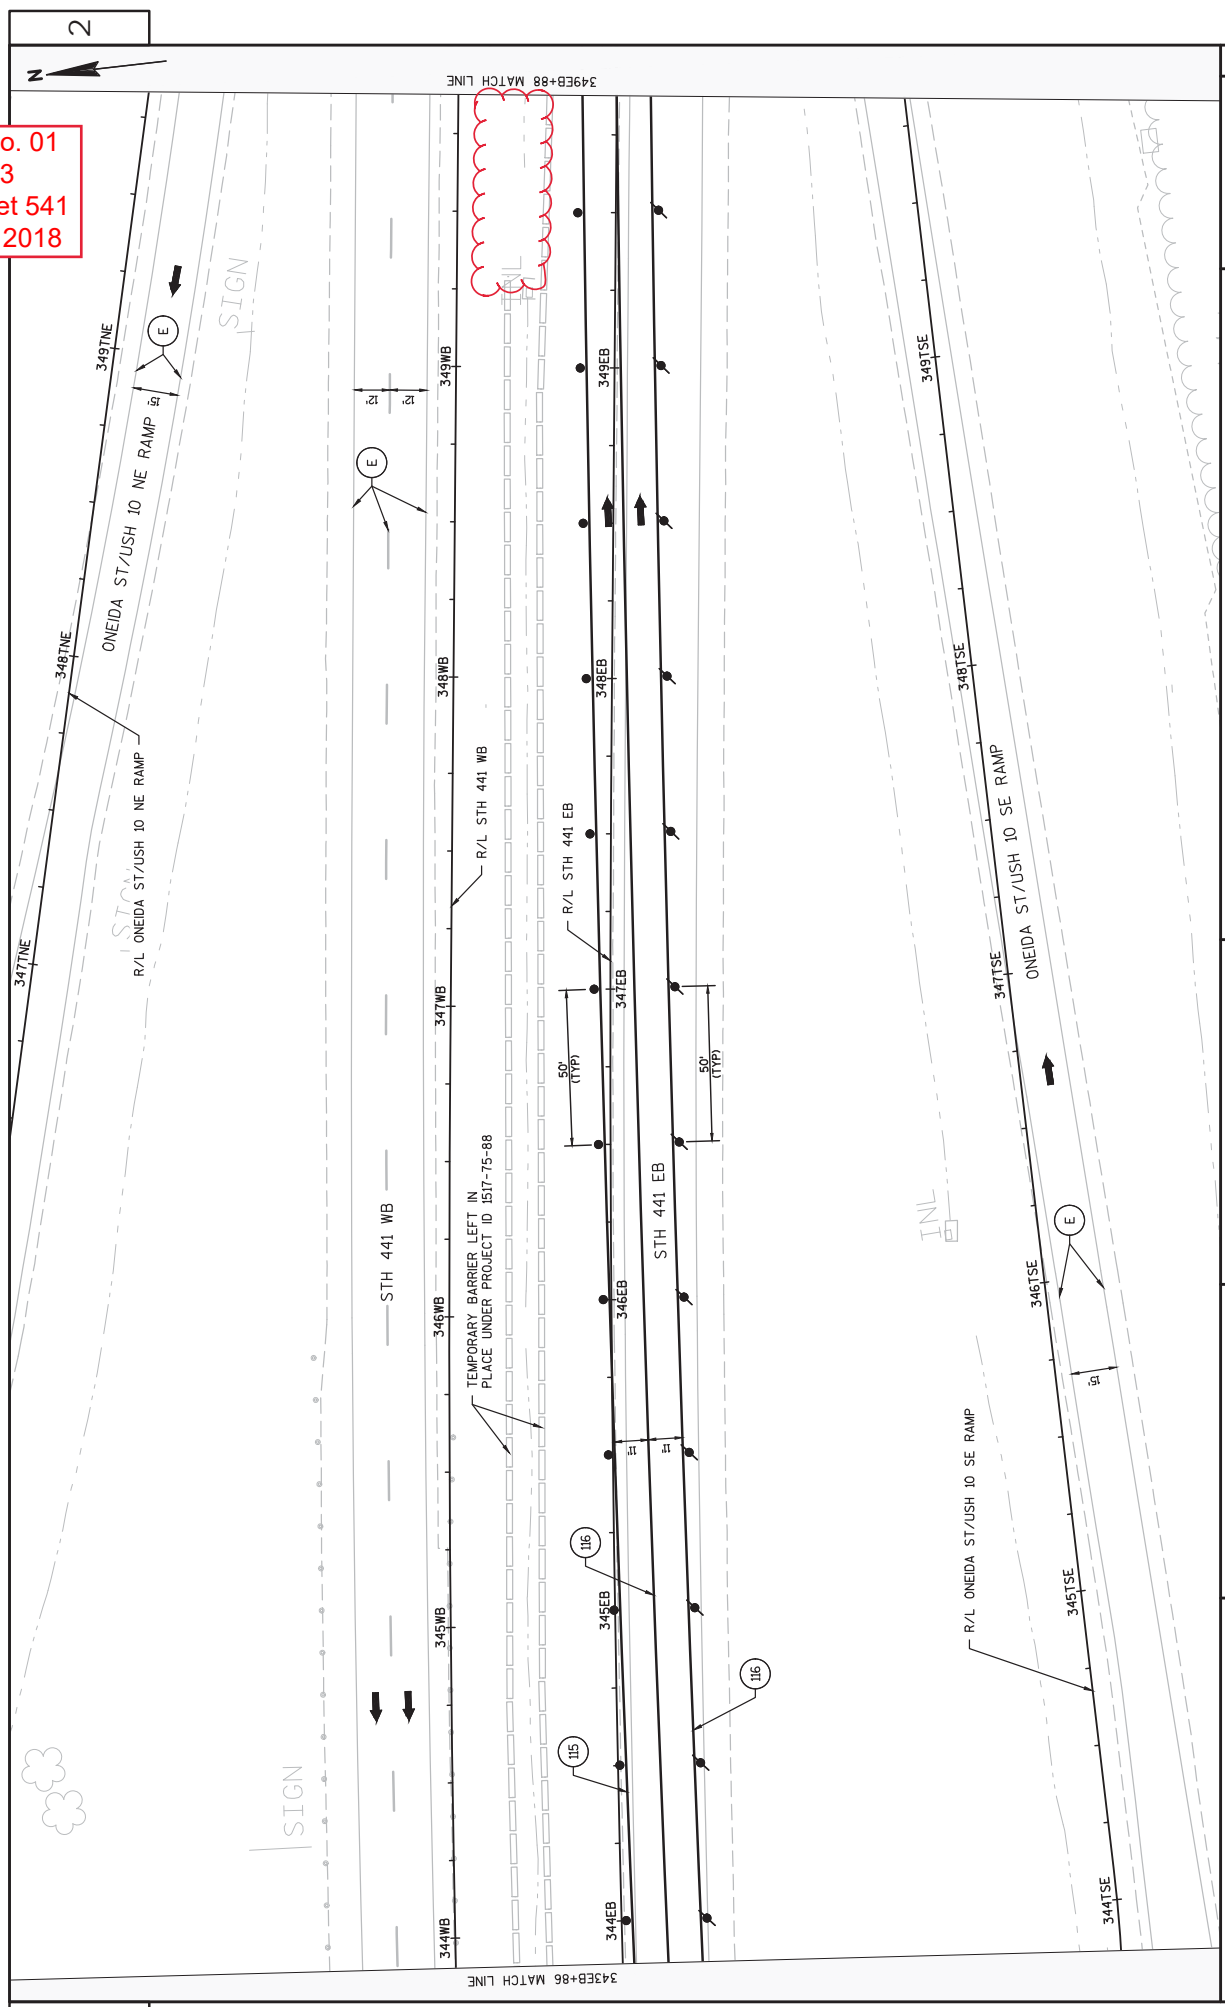


2


2

PROJECT NO: 1517-75-73	HWY: STH 441/USH 10	COUNTY: WINNEBAGO	TRAFFIC CONTROL STAGE 2	SHEET 541	E
FILE NAME : S:\NPOS\G30\WIS441\15177574-79\SHSHEETSP\LAN15177574\025001.LTC\1517-75-73\NE-15177573-026101-TCS2.DWG					
LAYOUT NAME - 026110-TCS2					
PLOT DATE : 2/22/2018 7:44 AM					
PLOT BY : MARTENS, JOHN M					
PLOT NAME :					
PLOT SCALE : 1 IN=40 FT					

Addendum No. 01  
 ID 1517-75-73  
 Revised Sheet 542  
 February 27, 2018

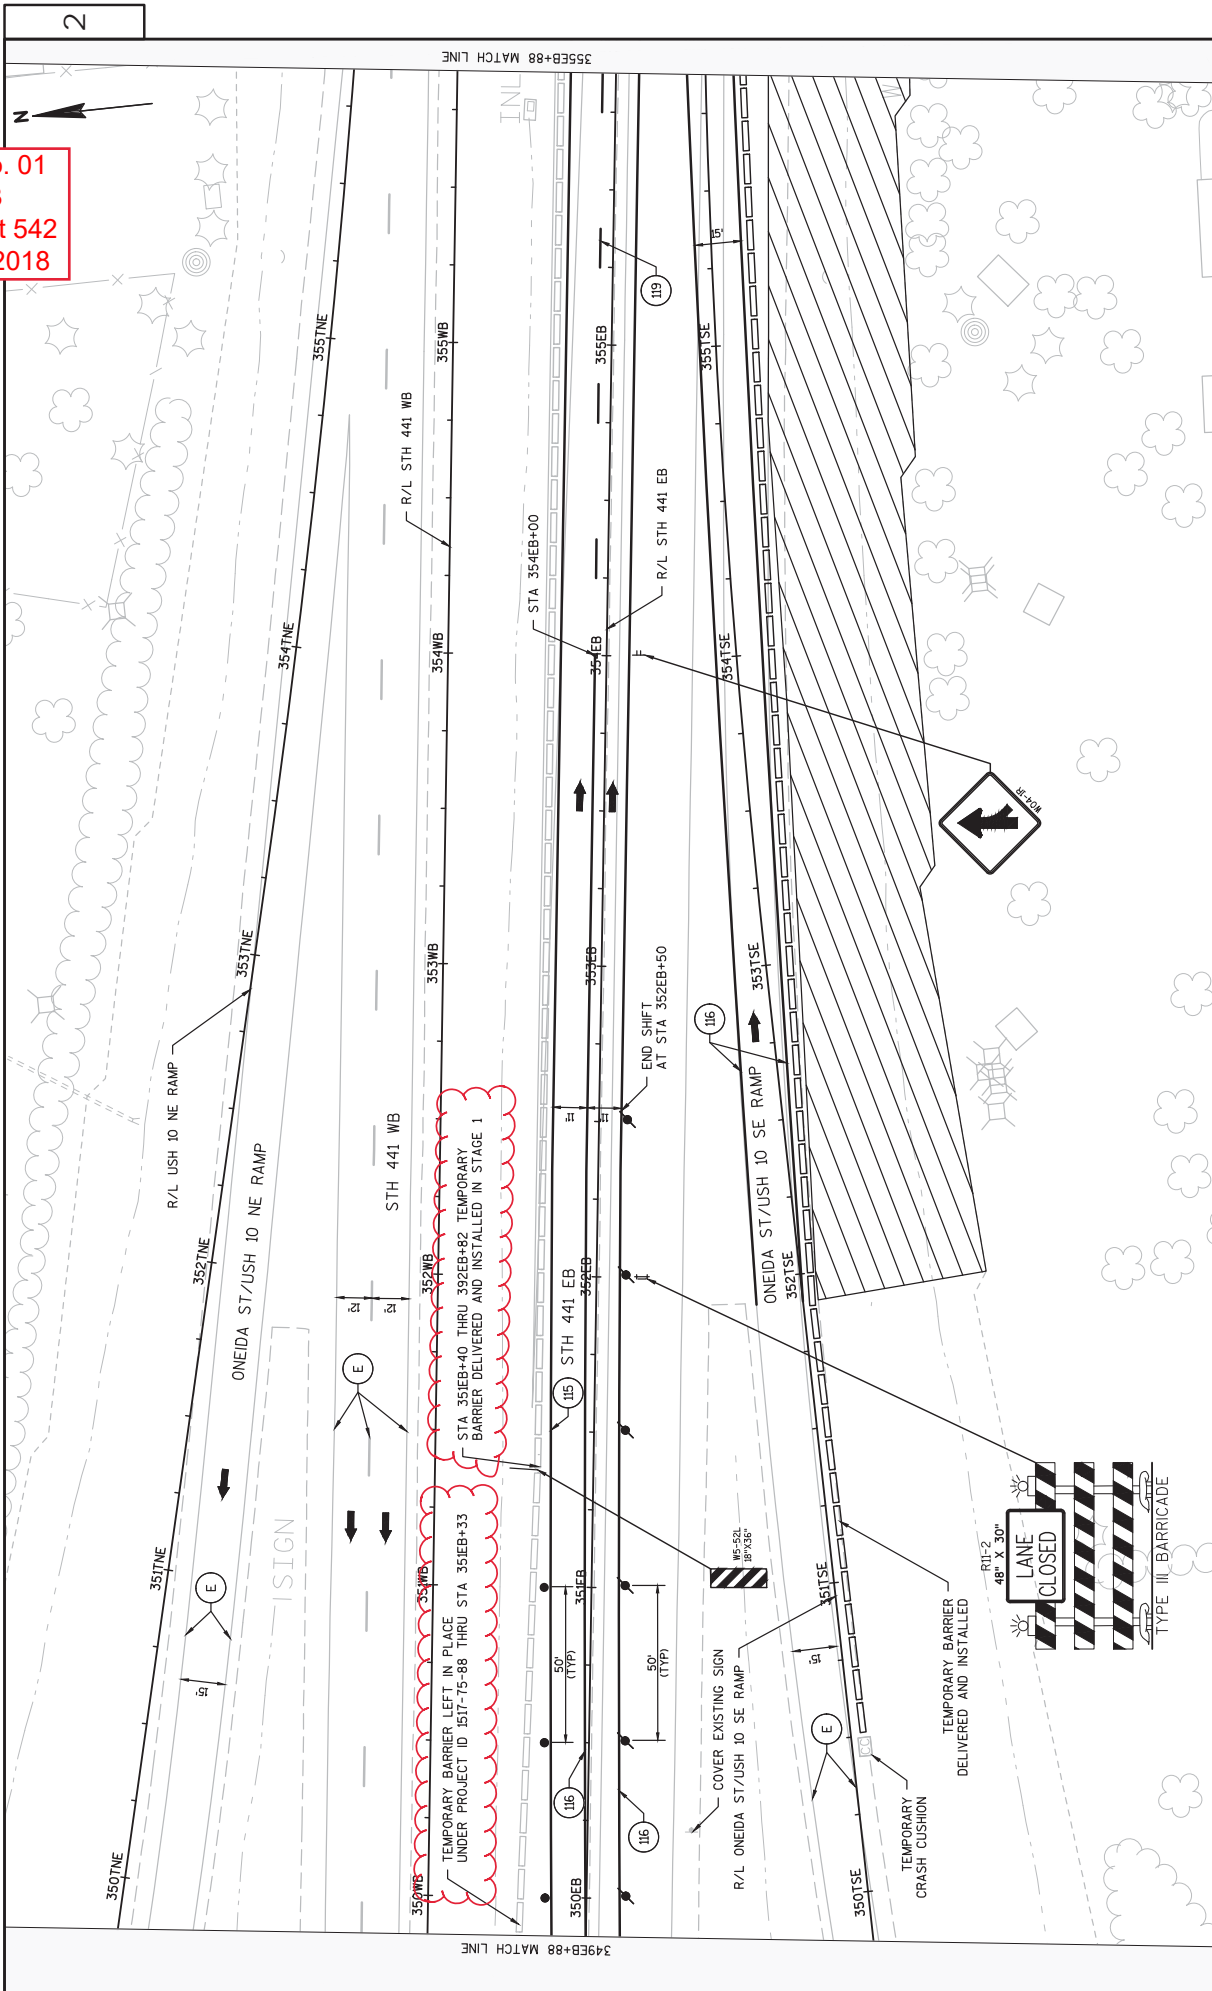

Addendum No. 01  
 ID 1517-75-73  
 Revised Sheet 543  
 February 27, 2018

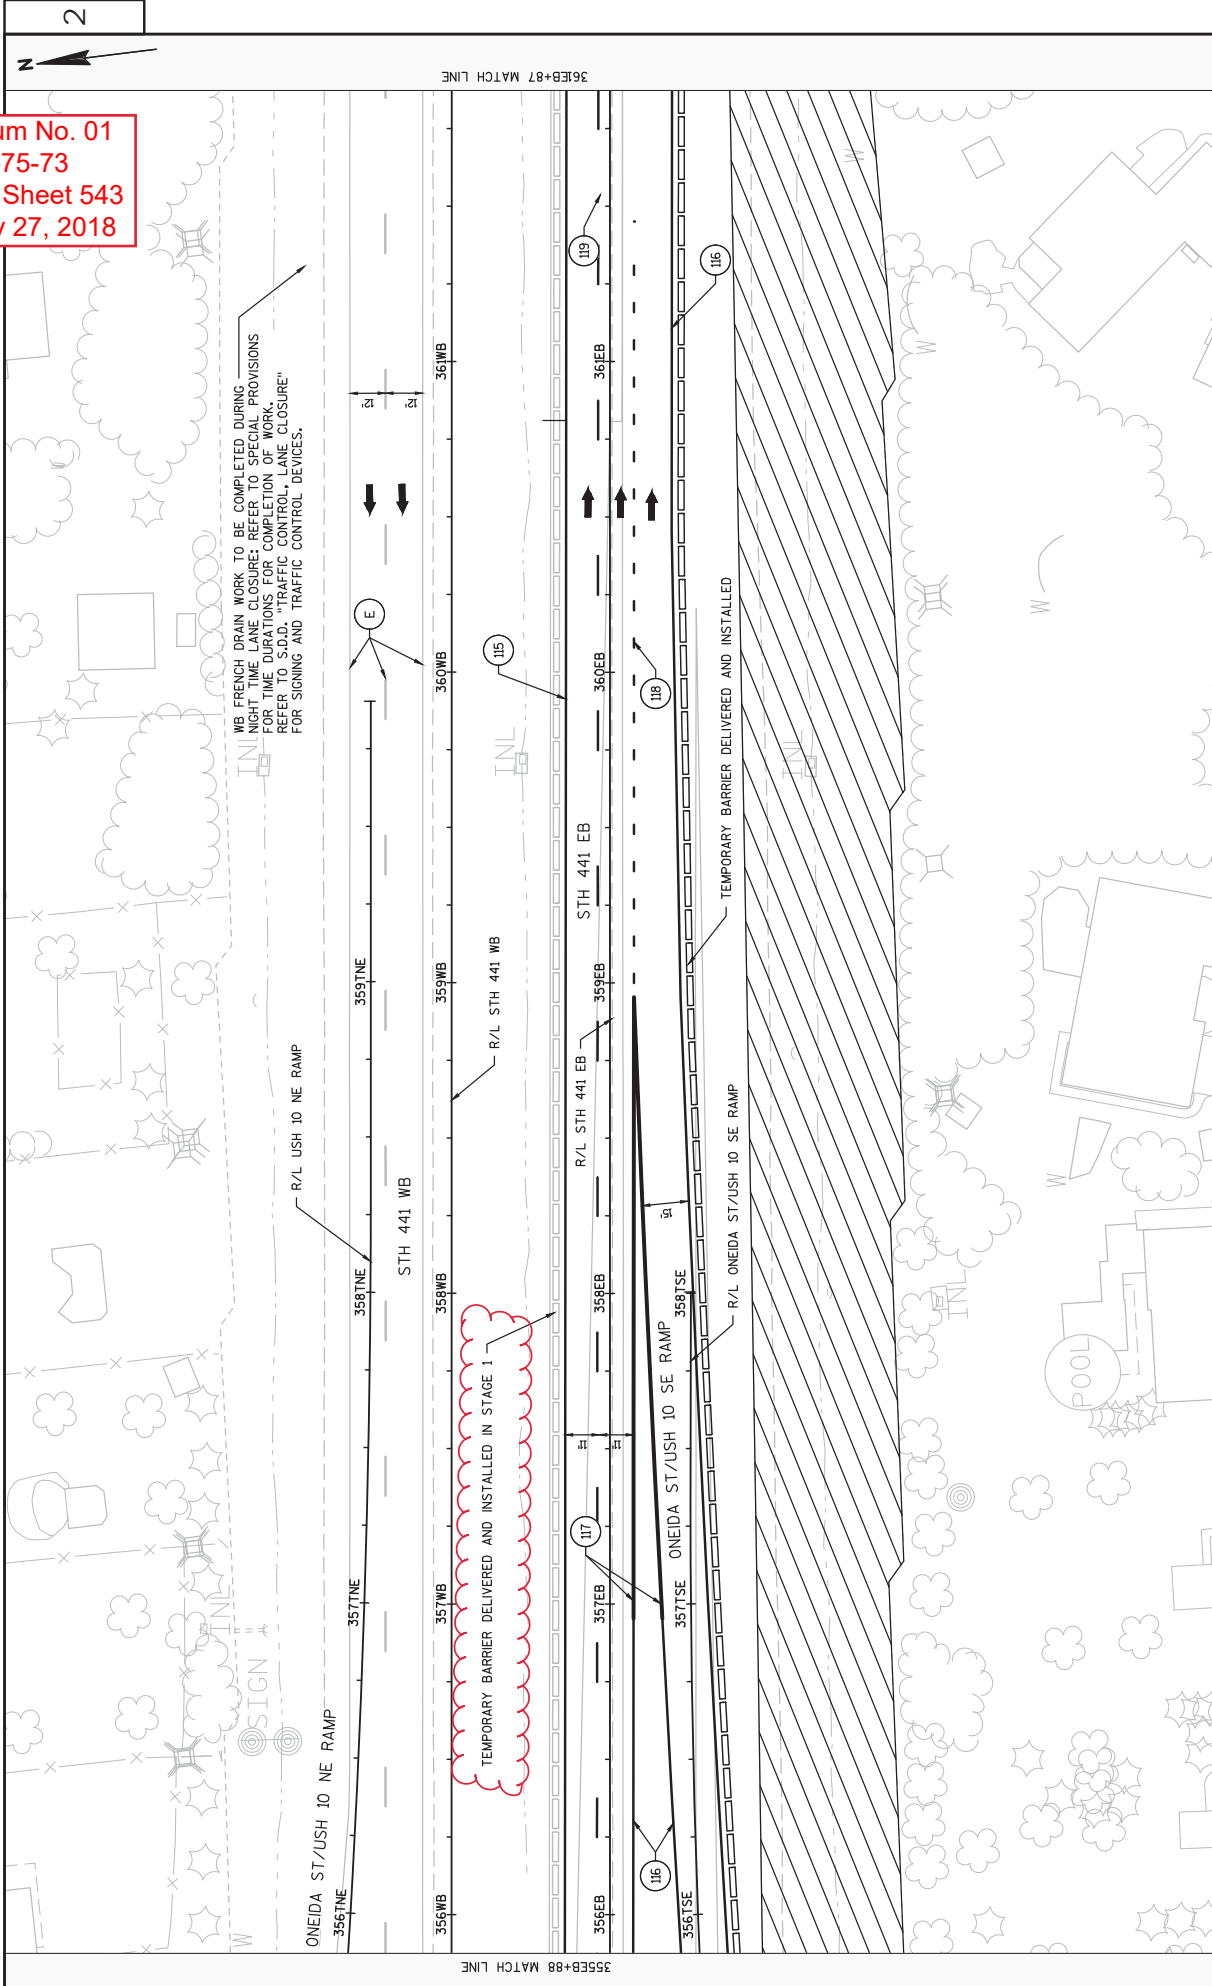

CATEGORY	ROADWAY	STATION	TO	STATION	OFFSET	201.0105		203.0100		REMARKS		
						CLEARING	STA	REMOVING SMALL	EACH			
1000	CATEGOR Y	<b>CLEARING &amp; GRUBBING</b>										
		STAGE 3A	STH 441 SB/USH 10 WB	294WB+14	-	340WB+62	LT	47	47	12"	CMCP	
		STAGE 3A SUBTOTAL										
		STAGE 4A	STH 441 SB/USH 10 WB	266WB+50	-	268WB+50	LT	2	2	12"	CMCP	
		STH 441 SB/USH 10 WB	275WB+00	-	276WB+00	LT	1	1	12"	CMCP		
		APPLETON RD NW RAMP	1281ANW+13	-	1283ANW+06	LT	2	2	12"	CMCP		
		APPLETON RD SE RAMP	1290ASE+91	-	1292ASE+78	RT	2	2	12"	CMCP		
		APPLETON RD SE RAMP	1295ASE+72	-	1302ASE+79	RT	7	7	12"	CMCP		
		STH 441 NB/USH 10 EB	315EB-38	-	316EB+49	RT	2	2	18"	RCCP		
		STH 441 NB/USH 10 EB	317EB+40	-	317EB+99	RT	1	1	12"	RCCP		
		STH 441 NB/USH 10 EB	318EB+69	-	323EB+50	RT	5	5	12"	CMCP		
		STH 441 NB/USH 10 EB	325EB+57	-	338EB+30	RT	13	13	18"	RCCP		
STAGE 4A SUBTOTAL												
PROJECT 1517-75-73 TOTAL												

\*\* \*\*  
201.0105  
CLEARING  
STA

\*\* \*\*  
203.0100  
REMOVING SMALL  
CULVERT PIPES  
EACH

\*\* \*\*  
201.0205  
GRUBBING  
STA

\*\* \*\*  
204.0165  
REMOVING  
GUARDRAIL  
LF

\*\* ADDITIONAL QUANTITIES SHOWN ELSEWHERE

CATEGORY	ROADWAY	STATION	TO	STATION	OFFSET	204.0165		REMARKS	
						REMOVING	LF		
1000	CATEGOR Y	<b>REMOVING GUARDRAIL</b>							
		STAGE 3A	STH 441 SB/USH 10 WB	290WB+02	-	292WB+65	LT	263	204.0170
		STH 441 SB/USH 10 WB	342WB+31	-	345WB+89	LT	358	REMOVING	
		STH 441 NB/USH 10 EB	370EB+01	-	371EB+42	LT	292	FENCE	
		STAGE 3A SUBTOTAL							
		STAGE 4A	STH 441 NB/USH 10 EB	337EB+11	-	340EB+69	RT	357	
		STAGE 4A SUBTOTAL							
		PROJECT 1517-75-73 TOTAL							

PROJECT 1517-75-73 TOTAL

Addendum No. 01  
ID 1517-75-73  
Revised Sheet 823  
February 27, 2018

Addendum No. 01  
ID 1517-75-73  
Revised Sheet 830  
February 27, 2018

BASE AGGREGATE

CATEGORY	ROADWAY	STATION	TO	STATION	OFFSET	TON	TON	TON	TON	TON	TON	TON	TON	TON	TON	TON	TON	TON
						305.0110	305.0120	310.0110	311.0110	312.0110	305.0500							
						BASE AGGREGATE DENSE 3/4 INCH	BASE AGGREGATE DENSE 1 1/4 INCH	BASE AGGREGATE OPEN-GRADED	BREAKER RUN	SELECT CRUSHED MATERIAL	SHAPING SHOULDERS							
1000																		
	STAGE 1																	
		STH 441 NB/USH 10 EB	294EB+30	-	331EB+18	L/R	-	5417	-	4876	-	28						
		STH 441 NB/USH 10 EB	351EB+58	-	408EB+50	L/R	-	9134	-	8221	-	44						
		STAGE 1 SUBTOTAL					0	14551	0	13097	0	72						
	STAGE 2																	
		STH 441 NB/USH 10 EB	361EB+00	-	369EB+00	RT	-	-	113	-	1084	-						
		STH 441 NB/USH 10 EB	373EB+00	-	389EB+00	RT	-	-	337	-	2188	-						
		STH 441 NB/USH 10 EB	389EB+00	-	390EB+00	RT	-	-	21	-	95	-						
		STH 441 SB/USH 10 WB	361NB+00	-	368NB+95	LT	-	-	167	-	1087	-						
		STH 441 SB/USH 10 WB	373NB+00	-	389NB+01	LT	-	-	338	-	2189	-						
		STH 441 SB/USH 10 WB	389NB+01	-	390NB+01	LT	-	-	21	-	95	-						
		STAGE 2 SUBTOTAL					0	0	997	0	6738	0						
	STAGE 3A																	
		STH 441 SB/USH 10 WB	289NB+25	-	309NB+59	L/R	1543	5204	-	10141	-	-						
		STH 441 SB/USH 10 WB	300NB+00	-	326NB+70	RT	-	-	-	13979	-	-						
		STH 441 SB/USH 10 WB	305NB+60	-	338NB+00	LT	-	-	-	2906	-	-						
		STH 441 SB/USH 10 WB	309NB+59	-	317NB+76	L/R	621	2500	-	4908	-	-						
		STH 441 SB/USH 10 WB	317NB+76	-	333NB+52	L/R	1196	4240	-	8054	-	-						
		STH 441 SB/USH 10 WB	333NB+52	-	335NB+98	L/R	187	643	-	1281	-	-						
		STH 441 SB/USH 10 WB	335NB+98	-	340NB+49	L/R	326	1173	-	2336	-	-						
		STH 441 SB/USH 10 WB	342NB+11	-	346NB+43	L/R	311	1169	-	2321	-	-						
		STH 441 SB/USH 10 WB	346NB+43	-	348NB+89	L/R	187	653	-	1301	-	-						
		STH 441 SB/USH 10 WB	348NB+89	-	361NB+00	L/R	411	2860	-	5415	-	-						
		STH 441 SB/USH 10 WB	360NB+30	-	396NB+00	RT	-	-	-	19658	-	-						
		STH 441 SB/USH 10 WB	361NB+00	-	364NB+34	L/R	234	935	-	1849	-	-						
		STH 441 SB/USH 10 WB	364NB+34	-	389NB+00	L/R	1775	6355	-	12667	-	-						
		APPLETON RD NE RAMP	1297ANE+00	-	1302ANE+00	RT	-	-	-	423	-	863						
		APPLETON RD NE RAMP	1299ANE+50	-	1305ANE+34	L/R	597	976	-	2054	-	-						
		TEMPORARY APPLETON RD NE RAMP	0TEMPANE+00	-	6TEMPANE+04	L/R	-	228	-	820	-	-						
		STAGE 3A SUBTOTAL					7388	26936	0	90113	863	0						
	STAGE 3B																	
		ONEIDA ST/USH 10 NW RAMP	325TWN+16	-	338TWN+00	L/R	1287	2509	-	5452	-	-						
		ONEIDA ST/USH 10 NE RAMP	346TNE+00	-	349TNE+61	L/R	247	730	-	1677	-	-						
		ONEIDA ST/USH 10 NE RAMP	349TNE+61	-	359TNE+91	L/R	683	1460	-	3296	-	-						
		ONEIDA ST/USH 10 SW RAMP	322TSW+77	-	334TSW+00	L/R	951	1948	-	4141	-	-						
		TEMPORARY ONEIDA ST/USH 10 SW RAMP	328TSW-32	-	333TSW+94	L/R	-	283	-	254	-	-						
		STAGE 3B SUBTOTAL					3168	6930	0	14820	0	0						

Addendum No. 01  
ID 1517-75-73  
Revised Sheet 831  
February 27, 2018

BASE AGGREGATE (CONTINUED)

CATEGORY	ROADWAY	STATION TO	STATION	OFFSET	TON	TON	TON	TON	TON	TON	TON	TON	STA
					BASE AGGREGATE DENSE 3/4 INCH	BASE AGGREGATE DENSE 1 1/4 INCH	BASE AGGREGATE OPEN-GRADED	BREAKER RUN	SELECT CRUSHED MATERIAL	SHAPING SHOULDERS			
STAGE 3C													
	STH 441 SB/USH 10 WB	279WB+53	-	288WB+34	LT	662	-	-	-	-	-	-	
	STH 441 SB/USH 10 WB	279WB+53	-	288WB+34	L/R	-	2526	-	-	-	-	-	
	TEMPORARY STH 441 SB/USH 10 WB	324WB+94	-	327WB+13	RT	-	183	165	-	-	-	-	
	TEMPORARY ONEIDA ST/USH 10 SE RAMP	347TSE+00	-	351TSE+50	L/R	-	478	430	-	-	-	-	
STAGE 3C SUBTOTAL						662	3187	0	595	0	0	0	305.0500
STAGE 3D													
	STH 441 SB/USH 10 WB	392WB+97	-	403WB+86	RT	-	487	-	439	-	-	-	
STAGE 3D SUBTOTAL						0	487	0	439	0	0	0	
STAGE 4A													
	MI DWAY RD SW RAMP	234MSW+23	-	240MSW+00	LT	304	-	-	-	-	-	-	
	MI DWAY RD SW RAMP	232MSW+14	-	240MSW+00	RT	271	-	-	-	-	-	-	
	STH 441 SB/USH 10 WB	232WB+18	-	239WB+40	LT	506	-	-	-	-	-	-	
	STH 441 SB/USH 10 WB	243WB+25	-	255WB+96	LT	907	-	-	-	-	-	-	
	MI DWAY RD NW RAMP	242MMW+00	-	255MMW+62	RT	533	-	-	-	-	-	-	
	STH 441 SB/USH 10 WB	242MMW+00	-	1282ANW+50	LT	2831	-	-	-	-	-	-	
	APPLETON RD NW RAMP	1279ANW+50	-	1282ANW+50	RT	113	-	-	-	-	-	-	
	STH 441 SB/USH 10 WB	210WB+50	-	222WB+31	L/R	-	682	-	-	-	-	-	
	STH 441 SB/USH 10 WB	222WB+31	-	240WB+20	L/R	-	6742	-	-	-	-	-	
	STH 441 SB/USH 10 WB	242WB+00	-	1282ANW+50	L/R	-	16956	-	-	-	-	-	
	STH 441 SB/USH 10 WB	222WB+32	-	240MSW+00	L/R	-	-	4917	-	-	-	-	
	STH 441 SB/USH 10 WB	267WB+00	-	1282ANW+50	L/R	-	-	9522	-	-	-	-	
	STH 441 NB/USH 10 EB	342EB+54	-	342EB+65	L/R	9	31	61	-	-	-	-	
	STH 441 NB/USH 10 EB	342EB+65	-	348EB+89	L/R	474	1659	3297	-	-	-	-	
	STH 441 NB/USH 10 EB	348EB+89	-	361EB+00	L/R	394	3055	5805	-	-	-	-	
	STH 441 NB/USH 10 EB	361EB+00	-	364EB+34	L/R	241	999	1964	-	-	-	-	
	STH 441 NB/USH 10 EB	362EB+50	-	396EB+00	LT	-	-	15791	-	-	-	-	
	STH 441 NB/USH 10 EB	364EB+34	-	373EB+00	L/R	658	2378	4718	-	-	-	-	
	STH 441 NB/USH 10 EB	373EB+00	-	389EB+00	L/R	1214	4149	8268	-	-	-	-	
	ONEIDA ST/USH 10 SE RAMP	347TSE+00	-	352TSE+16	L/R	262	1008	2330	-	-	-	-	
	ONEIDA ST/USH 10 SE RAMP	352TSE+16	-	358TSE+01	L/R	297	800	1755	-	-	-	-	
	TEMP ONEIDA ST/USH 10 SE RAMP	OTEMPASE+00	-	15TEMPASE+14	L/R	-	345	1243	-	-	-	-	
	TEMP ONEIDA ST/USH 10 SE RAMP	OTEMPSW+00	-	10TEMPSW+54	L/R	-	300	1080	-	-	-	-	
STAGE 4A SUBTOTAL						9014	39104	0	60751	0	0	0	

Addendum No. 01  
ID 1517-75-73  
Revised Sheet 832  
February 27, 2018

BASE AGGREGATE (CONTINUED)

305.0110 305.0120 310.0110 311.0110 312.0110  
305.0500  
SHAPING  
SHOULDERS

ROADWAY	STATION	TO	STATION	OFFSET	TON	TON	TON	TON	TON	TON	TON	TON	STA
CATEGORY	ROADWAY	STATION	TO	STATION	OFFSET	TON	TON	TON	TON	TON	TON	TON	STA
1000	STAGE 4B												
		STH 441 MB/USH 10 EB	-	225EB-31	RT	158	180	-	438	-	-	-	
		MIDWAY RD SE RAMP	-	225MBE-31	L/R	862	1708	-	3382	-	-	-	
		STH 441 MB/USH 10 EB	-	290EB-01	L/R	1251	4258	-	8195	-	-	-	
		STH 441 MB/USH 10 EB	-	300EB-00	LT	-	-	-	6122	-	-	-	
		STH 441 MB/USH 10 EB	-	306EB-50	L/R	1230	5130	-	10052	-	-	-	
		STH 441 MB/USH 10 EB	-	307EB-50	LT	-	-	-	1622	-	-	-	
		STH 441 MB/USH 10 EB	-	307EB-90	RT	-	-	-	2236	-	-	-	
		STH 441 MB/USH 10 EB	-	322EB-72	L/R	797	2247	-	4096	-	-	-	
		STH 441 MB/USH 10 EB	-	333EB-22	L/R	182	654	-	1298	-	-	-	
		STH 441 MB/USH 10 EB	-	335EB-62	L/R	386	1447	-	2858	-	-	-	
		APPLETON RD SE RAMP	-	1299ASE+50	L/R	622	837	-	1850	-	-	-	
		STAGE 4B SUBTOTAL				5488	16461	0	42149	0	0	0	
		UNDI SDTRIBUTED				25720	107656	997	228214	7601	72	72	
		PROJECT 1517-75-73 TOTAL											

CURB & GUTTER ITEMS

ROADWAY	STATION	TO	STATION	OFFSET	LF	SY	SY
CATEGORY	ROADWAY	STATION	TO	STATION	OFFSET	SY	SY
1000	STAGE 4B						
		MIDWAY RD SE RAMP	-	237MBE+50	LT	175	-
		MIDWAY RD SE RAMP	-	237MBE+50	RT	177	-
		STH 441 MB/USH 10 EB	-	340EB+69	RT	20	1340
		STAGE 4B SUBTOTAL				372	1340
		PROJECT 1517-75-73 TOTAL				372	1340

SLOPE PAVING

ROADWAY	STATION	TO	STATION	OFFSET	SY	SY	
CATEGORY	ROADWAY	STATION	TO	STATION	OFFSET	SY	
1000	STAGE 4A						
		STH 441 SB/USH 10 MB	-	227MB+47	LT	825	-
		STH 441 SB/USH 10 MB	-	227MB+47	LT	-	1340
		STAGE 4A SUBTOTAL				825	1340
		PROJECT 1517-75-73 TOTAL				825	1340





## TEMPORARY CONCRETE BARRIER (CONTINUED)

CATEGORY	ROADWAY	STATION	TO	STATION	OFFSET	603.8000		603.8125		SPV.0060.207		SPV.0090.200		SPV.0090.201		REMARKS
						CONCRETE BARRIER TEMPORARY PRECAST DELIVERED	CONCRETE BARRIER TEMPORARY PRECAST INSTALLED	CONCRETE BARRIER TEMPORARY PRECAST ON LEFT IN PLACE	EACH	LEFT IN PLACE	CONCRETE BARRIER TEMPORARY PRECAST ANCHORING	LEFT IN PLACE	CONCRETE BARRIER TEMPORARY PRECAST ANCHORING			
STAGE 3C	STH 441 NB/USH 10 EB	298EB+75	-	307EB+00	LT	-	825	-	-	-	-	-	825	-	-	-
	STH 441 NB/USH 10 EB	322EB+75	-	324EB+38	LT	-	161	-	-	-	-	-	161	-	-	-
	STH 441 NB/USH 10 EB	326EB+15	-	327EB+42	LT	-	130	-	-	-	-	-	130	-	-	-
	STH 441 NB/USH 10 EB	326EB+00	-	335EB+23	RT	-	723	-	-	-	-	-	723	-	-	-
	STAGE 3C SUBTOTAL						723	1,839	0	0	0	0	0	1,116	-	-
STAGE 3D	STH 441 NB/USH 10 EB	214EB+00	-	222EB+74	LT	-	-	-	-	-	-	1,770	-	-	-	LEFT IN PLACE UNDER PROJECT ID 1517-75-72
	STH 441 NB/USH 10 EB	214EB+00	-	290EB+00	RT	-	-	-	1	-	-	7,610	-	-	-	LEFT IN PLACE UNDER PROJECT ID 1517-75-72
	STH 441 NB/USH 10 EB	214EB+65	-	219EB+32	L/R	-	-	-	-	-	-	469	-	-	-	LEFT IN PLACE UNDER PROJECT ID 1517-75-72
	STH 441 NB/USH 10 EB	220EB+80	-	225EB+57	LT	-	-	-	-	-	-	476	-	-	-	LEFT IN PLACE UNDER PROJECT ID 1517-75-72
	STH 441 NB/USH 10 EB	239EB+50	-	240EB+73	LT	-	-	-	1	-	-	123	-	-	-	LEFT IN PLACE UNDER PROJECT ID 1517-75-72
	STH 441 NB/USH 10 EB	238EB+52	-	239EB+50	RT	-	-	-	-	-	-	98	-	-	-	LEFT IN PLACE UNDER PROJECT ID 1517-75-72
	STH 441 NB/USH 10 EB	242EB+73	-	245EB+50	LT	-	-	-	1	-	-	77	-	-	-	LEFT IN PLACE UNDER PROJECT ID 1517-75-72
	STH 441 NB/USH 10 EB	268EB+00	-	276EB+23	LT	-	-	-	-	-	-	832	-	-	-	LEFT IN PLACE UNDER PROJECT ID 1517-75-72
	STH 441 NB/USH 10 EB	281EB+00	-	290EB+00	LT	-	905	-	-	-	-	-	-	-	-	-
	MI DWAY RD EB	17EMEB+60	-	22EMEB+75	RT	-	-	-	-	-	-	515	-	-	-	LEFT IN PLACE UNDER PROJECT ID 1517-75-72
	MI DWAY RD WB	16EMEB+25	-	22EMEB+50	L/R	-	-	-	-	-	-	995	-	-	-	LEFT IN PLACE UNDER PROJECT ID 1517-75-72
	STH 441 SB/USH 10 WB	290MB+00	-	293MB+96	RT	-	393	-	-	-	-	-	-	-	-	-
	STH 441 NB/USH 10 EB	290EB+00	-	404EB+00	RT	-	11,400	-	-	-	-	-	-	-	-	-
STAGE 3D SUBTOTAL						1,298	12,668	3	-	-	12,965	0	-	-	-	-
STAGE 4A	STH 441 NB/USH 10 EB	268EB+00	-	276EB+25	LT	-	825	-	-	-	-	-	-	-	-	-
	STH 441 NB/USH 10 EB	276EB+25	-	285EB+20	LT	-	895	-	-	-	-	-	-	-	-	-
	STH 441 NB/USH 10 EB	281EB+00	-	285EB+00	LT	-	400	-	-	-	-	-	-	-	-	-
	STH 441 NB/USH 10 EB	268EB+00	-	301EB+25	LT	-	1,620	-	-	-	-	-	-	-	-	-
	STH 441 NB/USH 10 EB	279EB+00	-	294EB+00	LT	-	1,500	-	-	-	-	-	-	-	-	-
STAGE 4B	STH 441 SB/USH 10 WB	294MB+00	-	403MB+83	L/R	-	10,985	-	-	-	-	-	-	-	-	-
	STH 441 SB/USH 10 WB	307MB+75	-	325MB+42	RT	-	1,766	-	-	-	-	-	-	-	-	-
	STH 441 SB/USH 10 WB	329MB+45	-	400MB+75	RT	-	7,154	-	-	-	-	-	-	-	-	-
	STAGE 4B SUBTOTAL					22,420	25,145	0	0	0	0	0	0	-	-	-
STAGE 4B	STH 441 NB/USH 10 EB	266EB+25	-	290EB+00	L/R	-	2,380	-	-	-	-	-	-	-	-	-
	STH 441 NB/USH 10 EB	281EB+13	-	286EB+35	L/R	-	726	-	-	-	-	-	-	-	-	-
	STH 441 SB/USH 10 WB	301MB+25	-	307MB+75	RT	-	650	-	-	-	-	-	-	-	-	-
	STH 441 SB/USH 10 WB	307MB+75	-	309MB+30	RT	-	155	-	-	-	-	-	-	-	-	-
	STH 441 SB/USH 10 WB	325MB+30	-	331MB+25	RT	-	595	-	-	-	-	-	-	-	-	-
STH 441 SB/USH 10 WB	331MB+25	-	332MB+75	RT	-	150	-	-	-	-	-	-	-	-	-	
STAGE 4B SUBTOTAL						1,245	4,656	0	0	0	0	0	-	-	-	-
STAGE 5	STH 441 SB/USH 10 WB	279MB+38	-	290MB+00	LT	-	1,062	-	-	-	-	-	-	-	-	-
	STH 441 NB/USH 10 EB	278EB+90	-	402EB+00	LT	-	12,310	-	-	-	-	-	-	-	-	-
	STH 441 SB/USH 10 WB	339MB+00	-	402MB+00	LT	-	600	-	-	-	-	-	-	-	-	-
STAGE 5 SUBTOTAL						13,972	-	0	0	0	0	0	0	-	-	-
PROJECT 1517-75-73 TOTAL						55,971	60,450	7	7	7	207,710	14,801	14,801	-	-	-

Addendum No. 01  
ID 1517-75-73  
Revised Sheet 842  
February 27, 2018

PROJECT NO: 1517-75-73

HWY: STH 441/USH 10

COUNTY: WINNEBAGO

MISCELLANEOUS QUANTITIES

SHEET: 842

PLOT NAME:

PLOT BY: A.R.H.

PLOT DATE: June 14, 1911

PLOT SCALE: 1:1

FILE NAME: N\FPDS\...030200\_mq.ppk

STATE PROJECT NUMBER	1517-75-73
----------------------	------------

**NOTES:**

TRUSS SECTIONS SHALL BE MADE IN MULTIPLES OF 6'-0" EXCEPT THAT THE BRACING PANEL NEAREST EACH POST MAY VARY TO MAKE UP THE NEEDED LENGTH. ALL WELDED JOINTS SHALL BE FULL PENETRATION WELDED EXCEPT IN CANTILEVER TRUSSES AS NOTED BELOW.

CANTILEVER TRUSS SHALL BE SUPPLIED AS A SINGLE UNIT.

UNLESS OTHERWISE SHOWN, ALL WELDS SHALL BE 1/4" FILLET WELDS ALL AROUND.

BOLTED SPLICES SHALL NOT BE LOCATED BEHIND DIMS SIGNS.

PROVIDE 2" x 1/2" BRASS, STAINLESS STEEL OR GALVANIZED STEEL SHIMS AT EACH FLANGE TO BRING TRUSS INTO CORRECT CAMBER AND ALIGNMENT.







TRUSSES SHALL BE SHOP ASSEMBLED AND MATCH MARKED.

ALL VIEWS OF THE TRUSSES ARE DRAWN FROM THE INSIDE OF THE TRUSS LOOKING OUT.

SEE SHEET 7 FOR POST CONNECTION DETAILS.

CHORD SPLICES, IF REQUIRED, SHALL BE IN ACCORDANCE WITH PLATE "F" DETAIL.

CHORD SPLICES SHALL BE AT THE TOP OF DIAGONAL MEMBERS FOR PROPER WELDING.

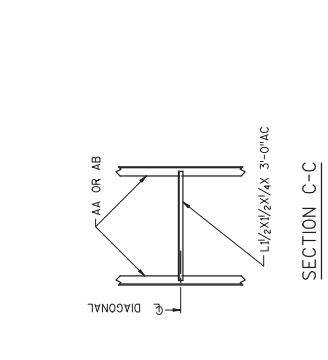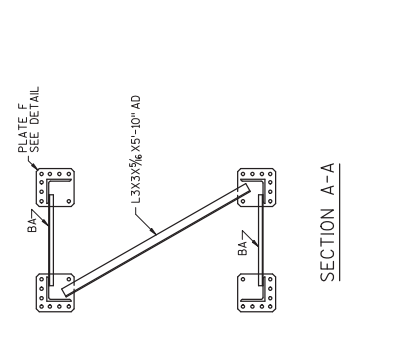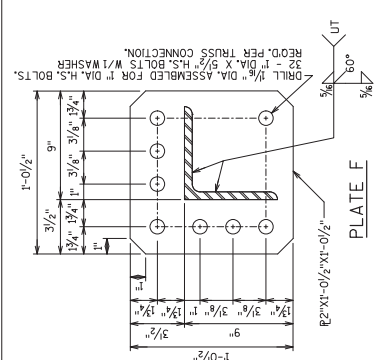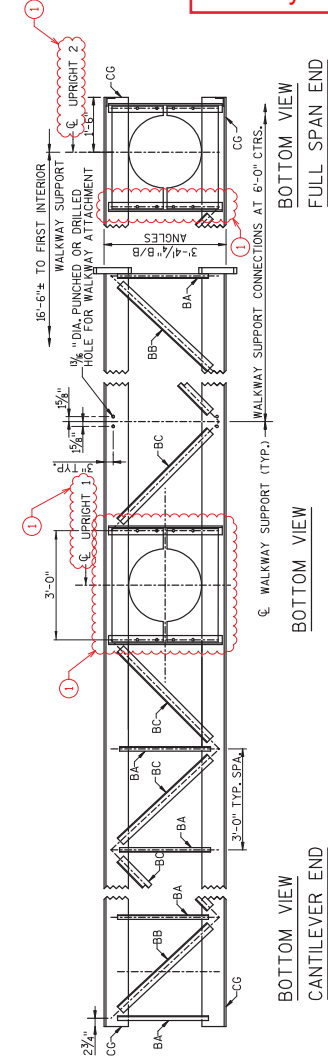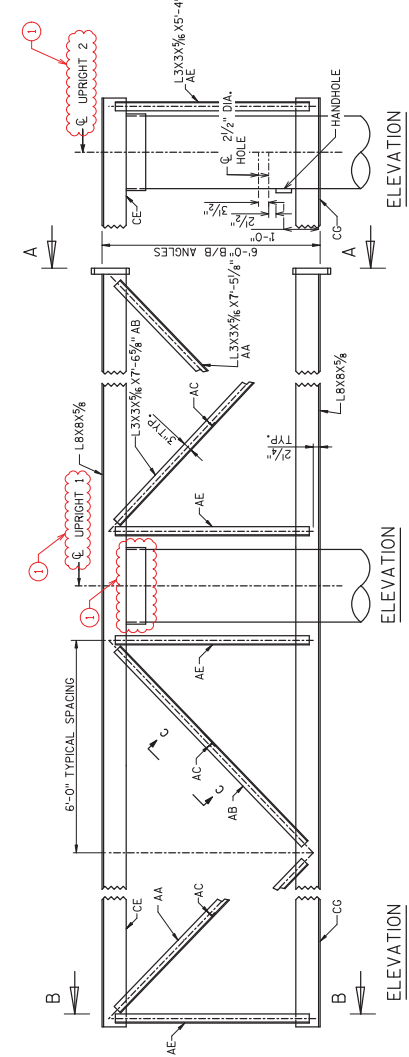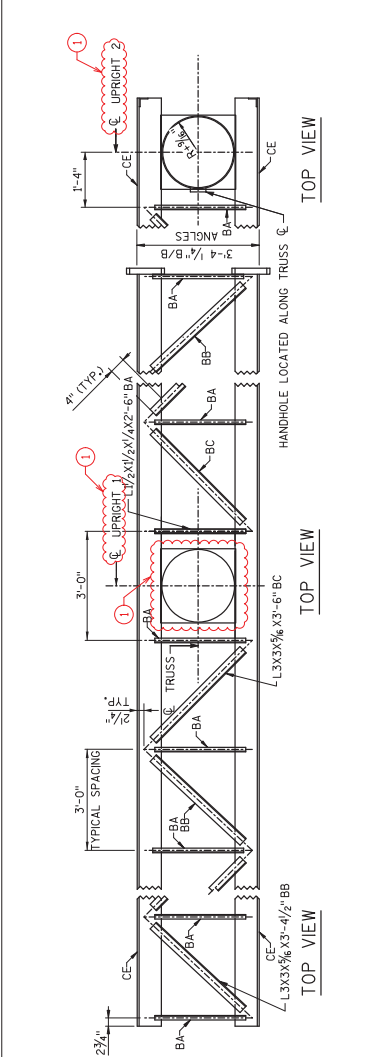

**Addendum No. 01**  
**ID 1517-75-73**  
**Revised Sheet 1,249**  
**February 27, 2018**

*William C. Decker, SDR*

02/26/18

NOTES:  
 THE BOTTOM VIEW IS DETAILED TO PROVIDE FOR WALKWAY ATTACHMENT. WHERE THE WALKWAY IS OMITTED, PROVIDE STRUT "BA" AS INDICATED.

NO.	DATE	REVISION	BY
1	2/21/18	UPPER/LOWER JUNCTION UPDATE	CEB

STATE OF WISCONSIN  
 DEPARTMENT OF TRANSPORTATION






STRUCTURE S-70-235

DRAWN BY: CEB  
 CHECKED BY: MJA

SHEET 3 OF 10

TRUSS DETAIL

1,249

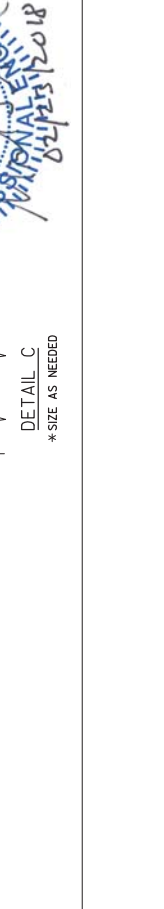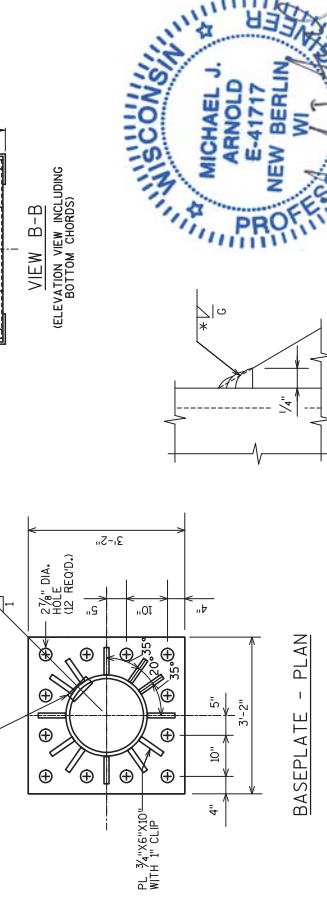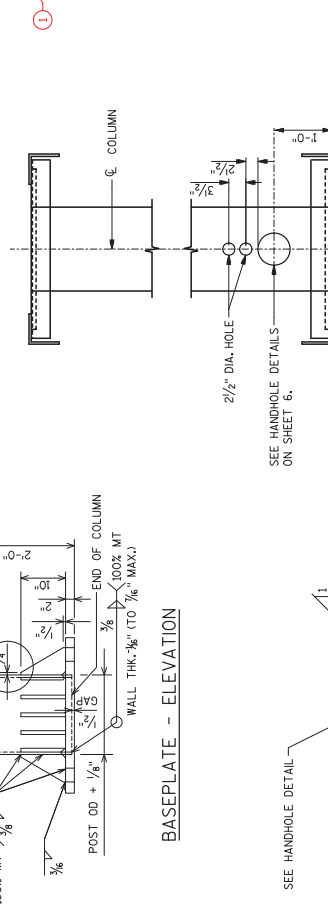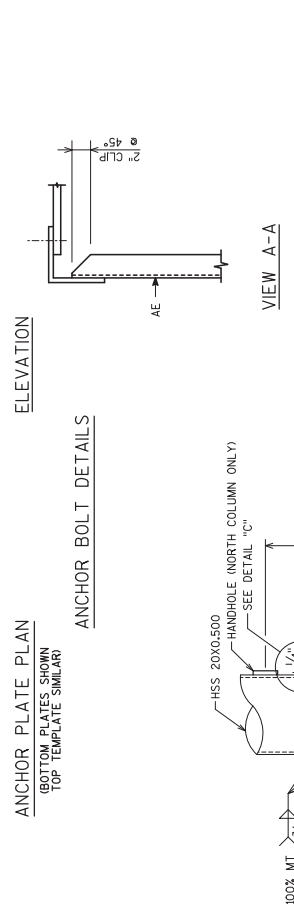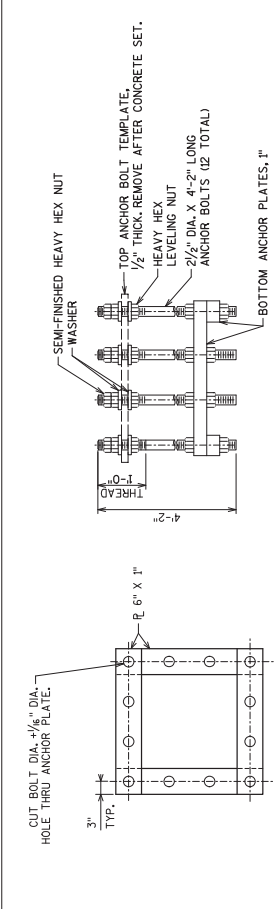

**Addendum No. 01**  
**ID 1517-75-73**  
**Revised Sheet 1,253**  
**February 27, 2018**

STATE PROJECT NUMBER <b>1517-75-73</b>	
NO.	DATE
REVISION	
UPPER/LOWER JUNCTION UPDATE	
STATE OF WISCONSIN	
DEPARTMENT OF TRANSPORTATION	
STRUCTURE S-70-235	
DESIGNED BY	CEB
CHECKED BY	MAJA
POST CONNECTION AND BASEPLATE	
SHEET 7 OF 10	
1,253	



NOTE:  
 CHOKER PLATES AND HANDHOLE COVERS  
 SHALL BE GALVANIZED SEPARATELY.

*William C. Decker*  
 SPR

02/26/18



Addendum No. 01  
 ID 1517-75-79  
 Revised Sheet 96  
 February 27, 2018

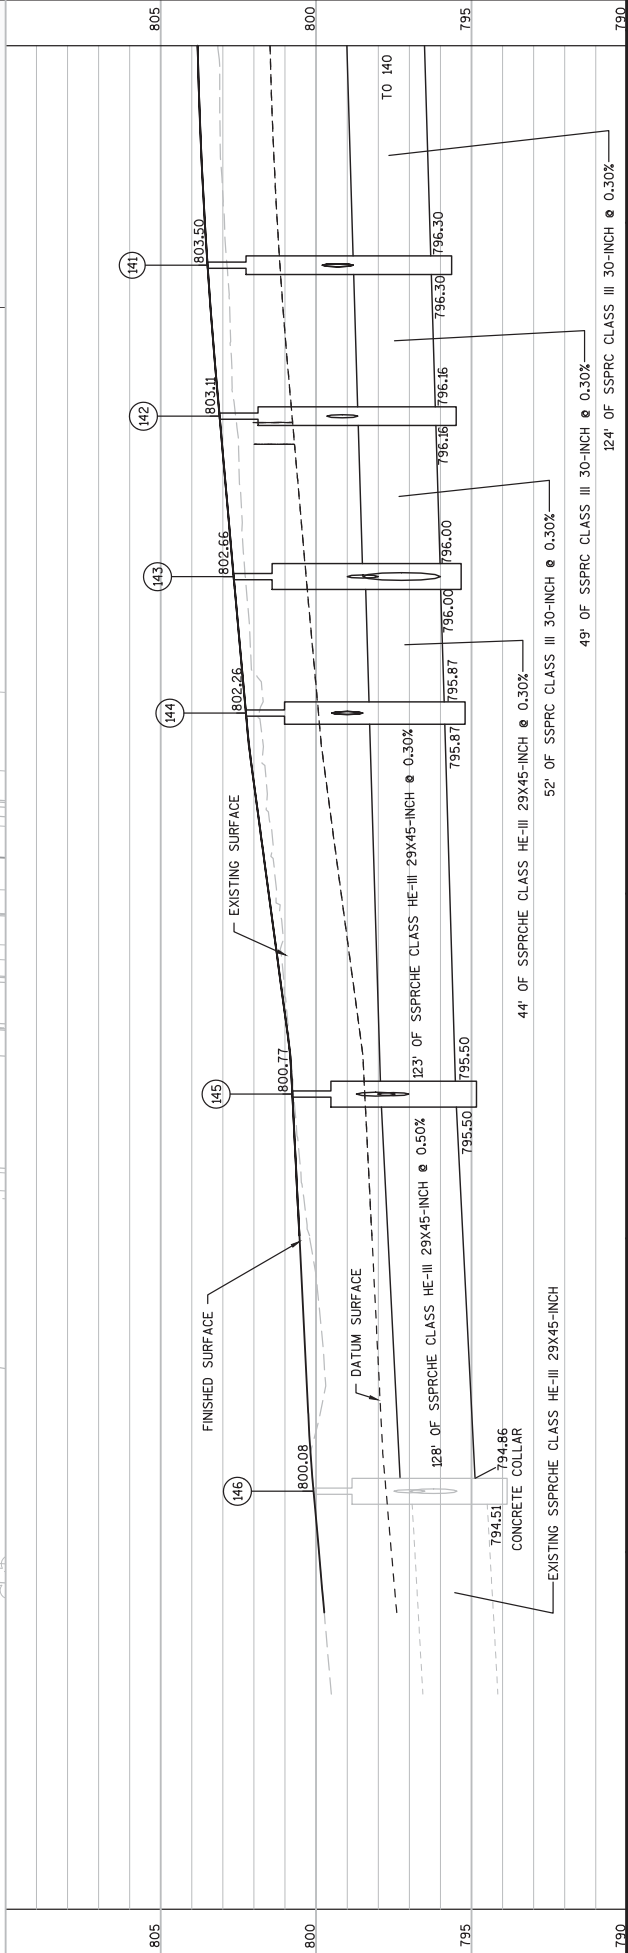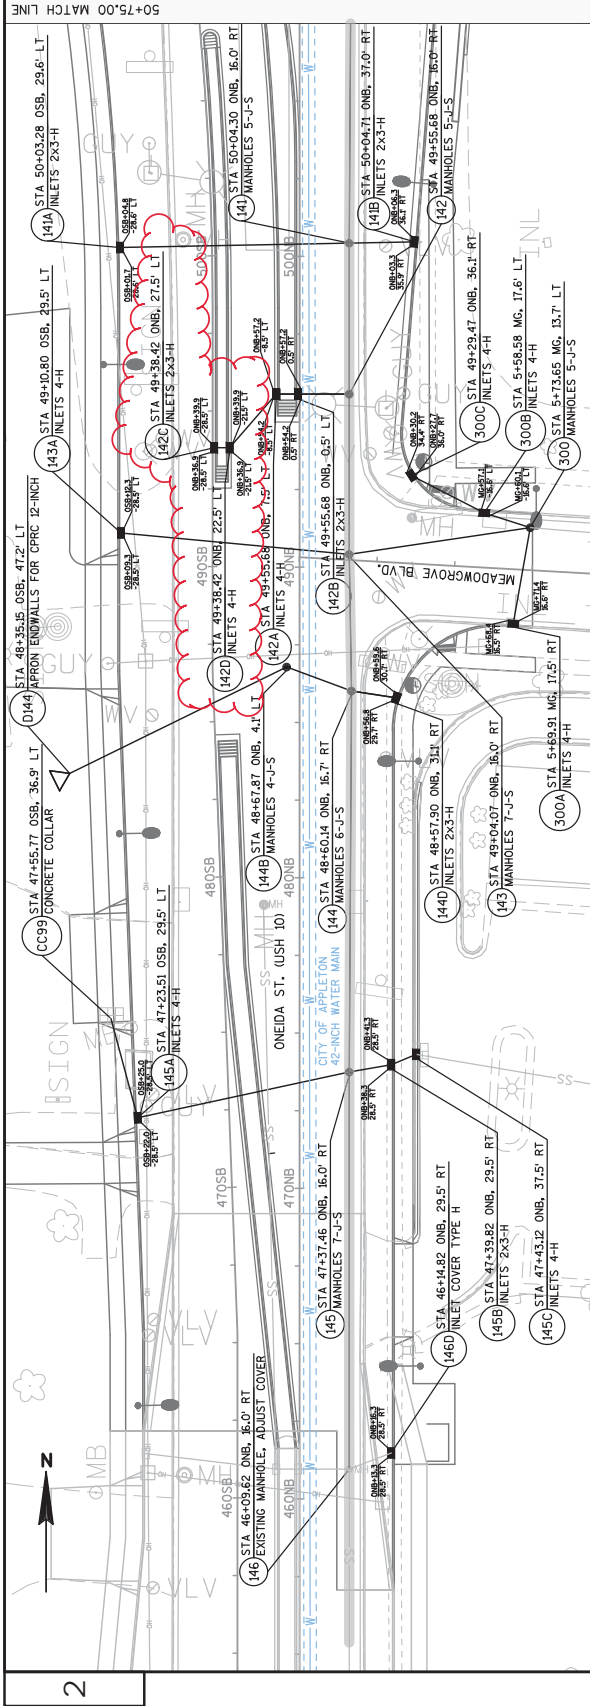


PROJECT NO: 1517-75-79	HWY: STH 441/ USH 10	COUNTY: WINNEBAGO	STORM SEWER	SHEET 96
FILE NAME : S:\NPOS\C30\WIS441\15177574-79\SSHEETS\PLAN\15177579_83_022500_SS\1517-75-79\VE-15177579-022500_SSPOSTPSE.DWG				
LAYOUT NAME - 022501A-SS				
PLOT DATE : 2.6.2018 9:49 AM				
PLOT BY : VICKMAN, GARRETT T. PLOT NAME :				
PLOT SCALE : 1 IN=40 FT				


2

50+75.00 MATCH LINE

**Addendum No. 01**  
**ID 1517-75-79**  
**Revised Sheet 97**  
**February 27, 2018**

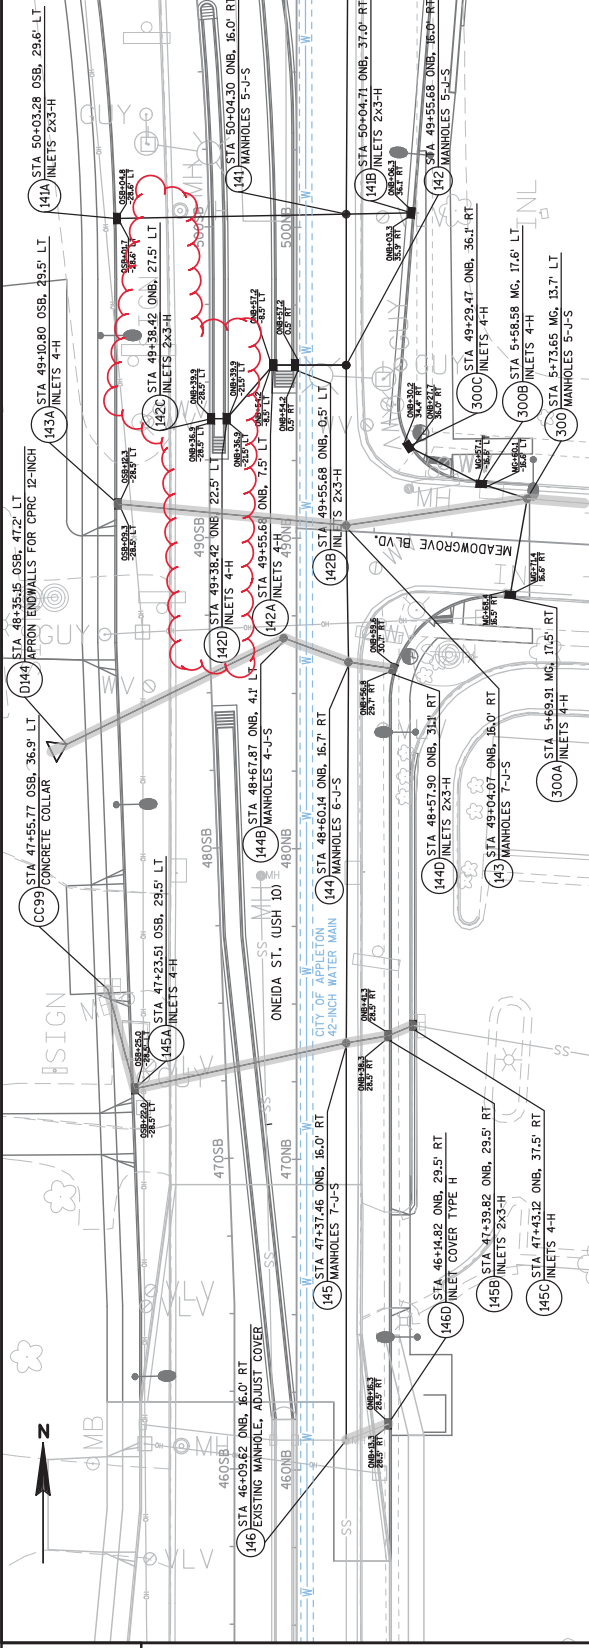


2

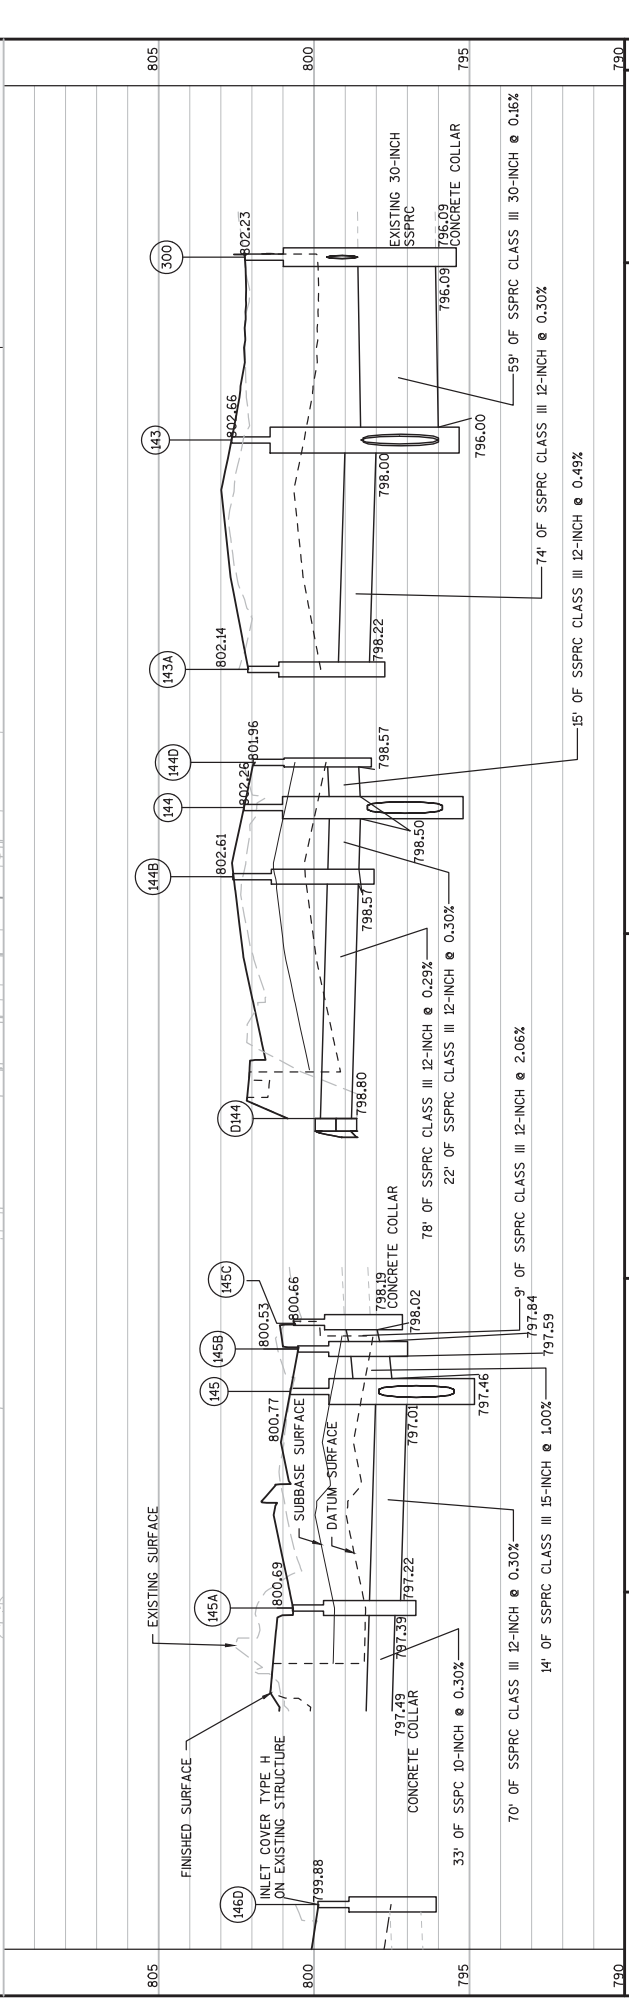


2

PROJECT NO: 1517-75-79			COUNTY: WINNEBAGO			STORM SEWER			SHEET 97		
HWY: STH 441/ USH 10			PLOT DATE : 2.6.2018 9:50 AM			PLOT SCALE : 1 IN=40 FT			WISDOT/CADD SHEET 41		
FILE NAME : S:\POS\GD\WIS441\15177574-79\SSHEETS\PLAN\15177579_83\022500_SS\1517-75-79\VE-15177579-022500_SSPOSTPSE.DWG			LAYOUT NAME - 022501B-SS			VICKMAN, GARRETT T			PLOT NAME :		

Addendum No. 01  
ID 1517-75-79  
Revised Sheet 98  
February 27, 2018


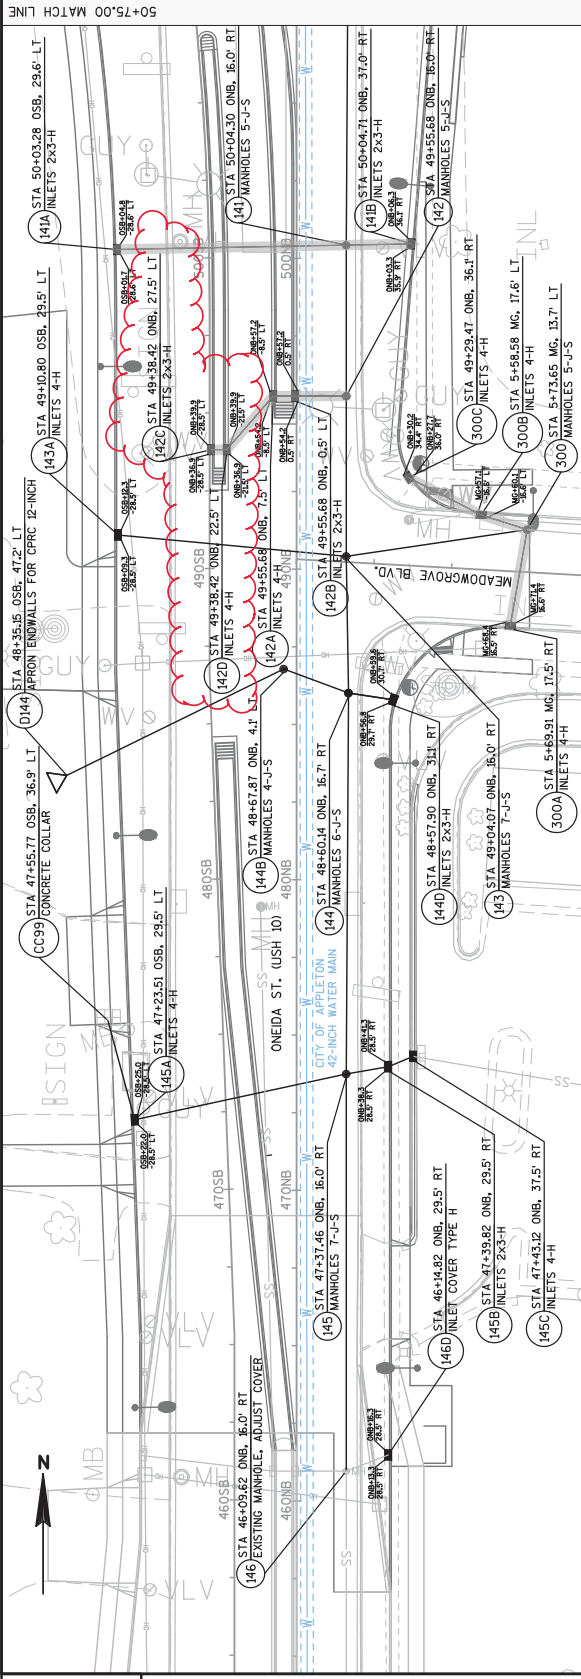


50+75.00 MATCH LINE

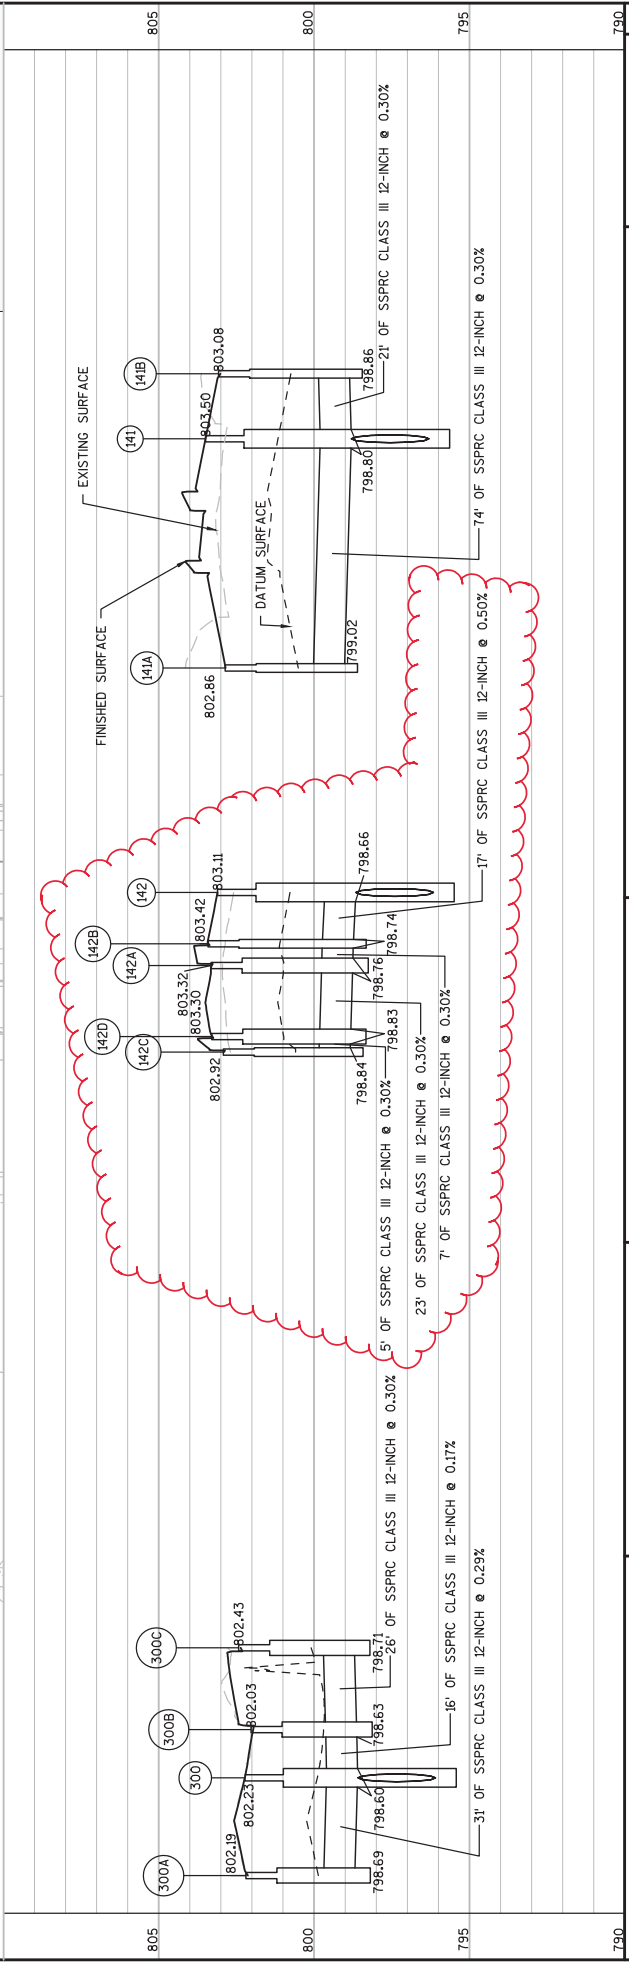

PROJECT NO: 1517-75-79	HWY: STH 441/ USH IO	COUNTY: WINNEBAGO	STORM SEWER	SHEET 98
------------------------	----------------------	-------------------	-------------	----------



**Addendum No. 01**  
**ID 1517-75-79**  
**Revised Sheet 99**  
**February 27, 2018**

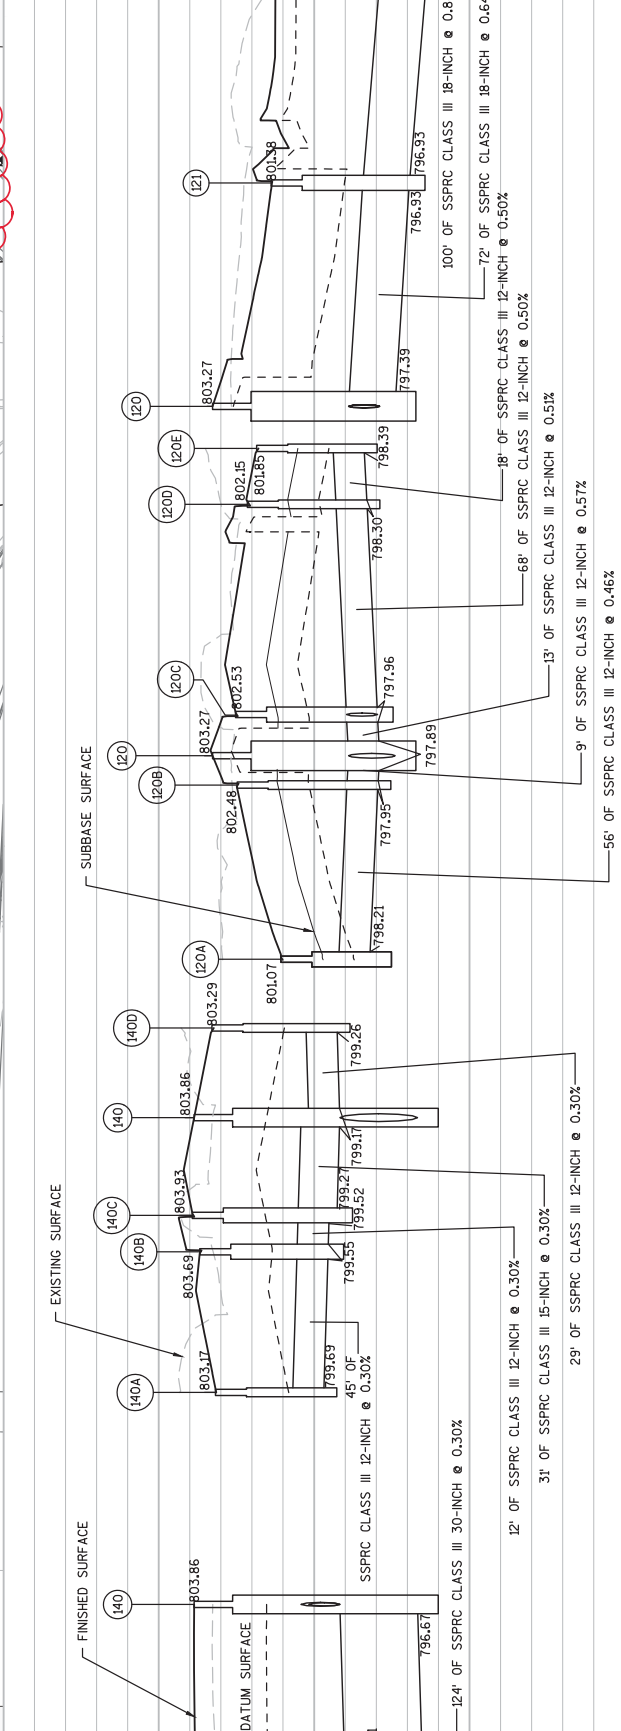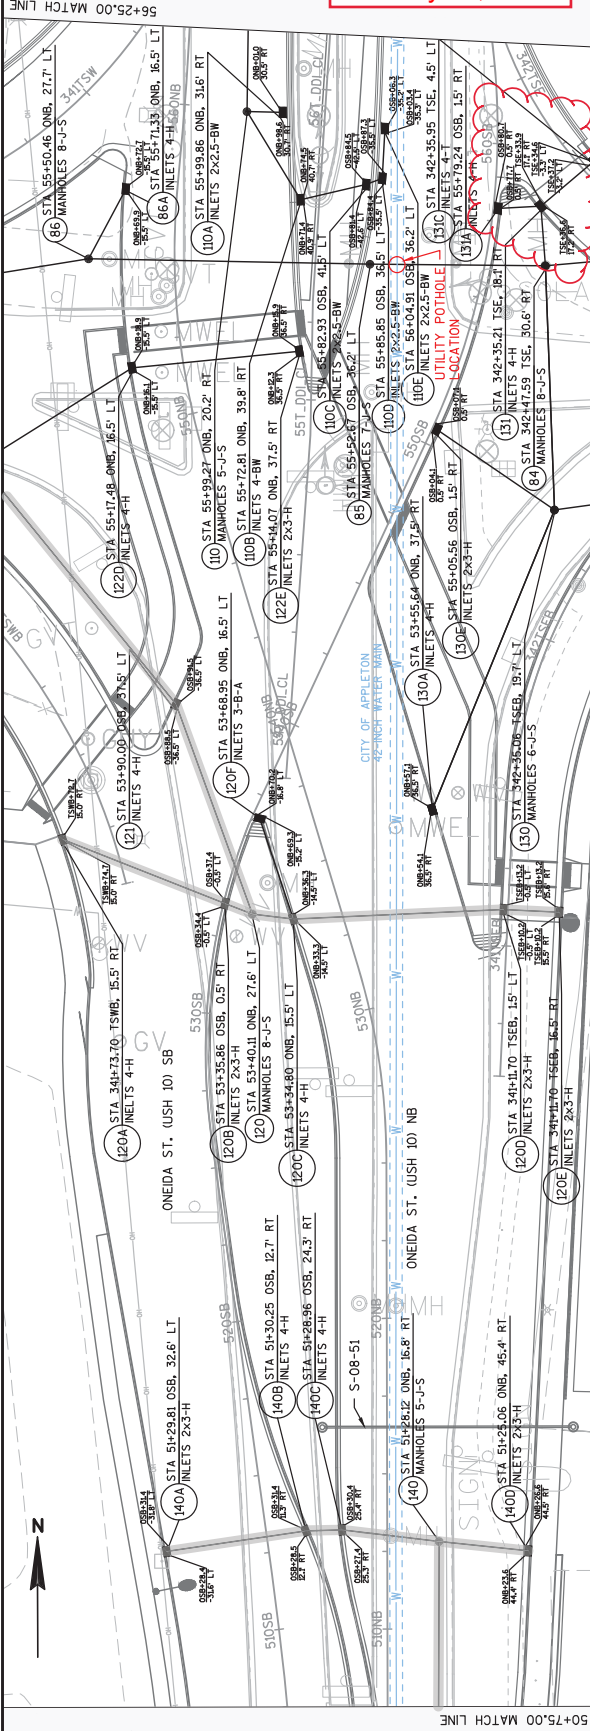

PROJECT NO: 1517-75-79	HWY: STH 441/ USH 10	COUNTY: WINNEBAGO	STORM SEWER	SHEET 99
FILE NAME : S:\NPOS\CD\WIS441\15177574-79\A\SHEETSP\LAN\15177579_83\022500_S5\1517-75-79\VE-15177579-022500_SSP0STPSE.DWG				
LAYOUT NAME - 022502A-SS				
PLOT DATE : 2.6.2018 9:52 AM				
PLOT BY : VICKIMAN, GARRETT T				
PLOT NAME :				
PLOT SCALE : 1 IN=40 FT				





**Addendum No. 01  
ID 1517-75-79  
Revised Sheet 100  
February 27, 2018**

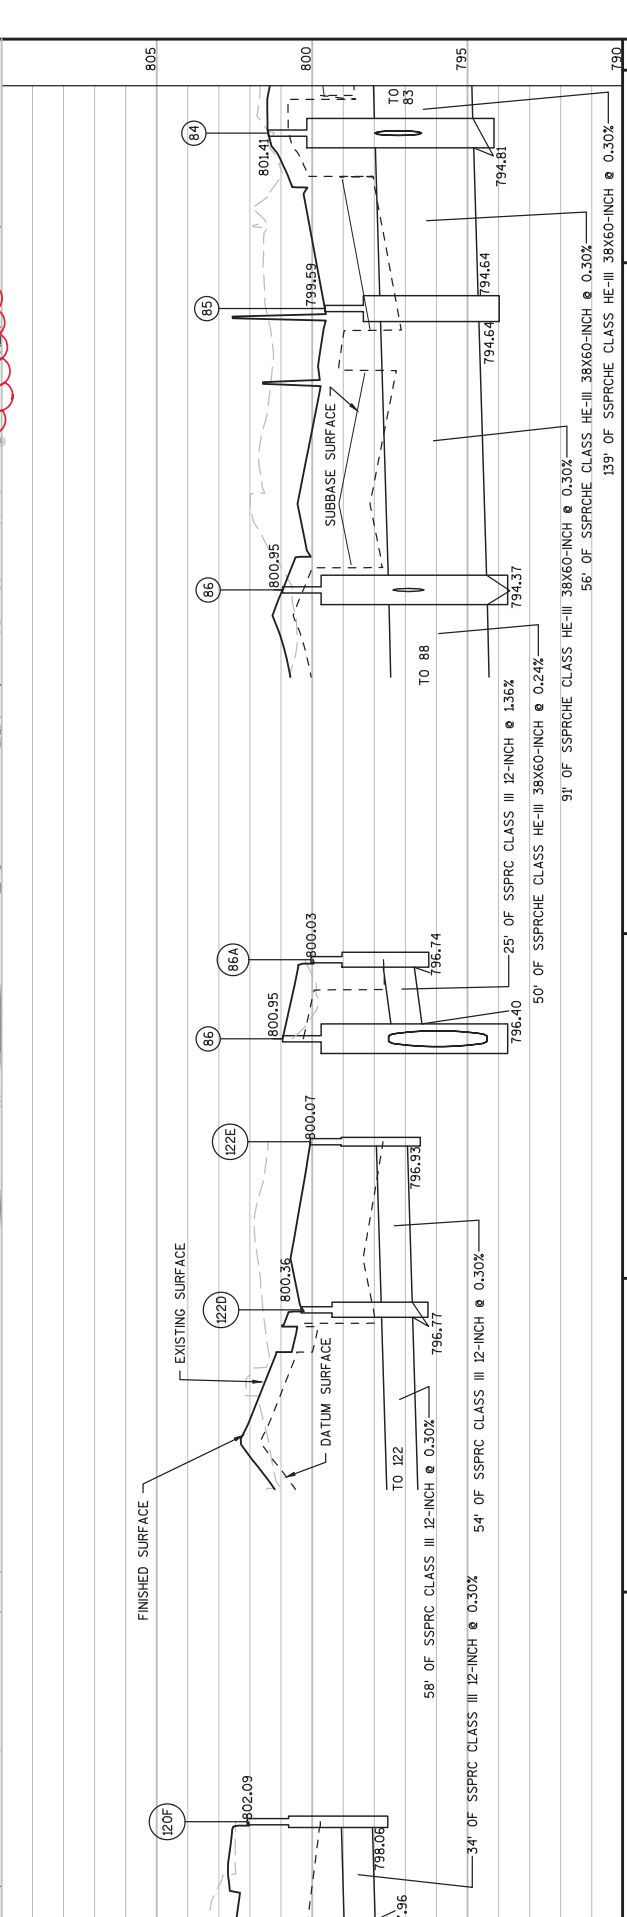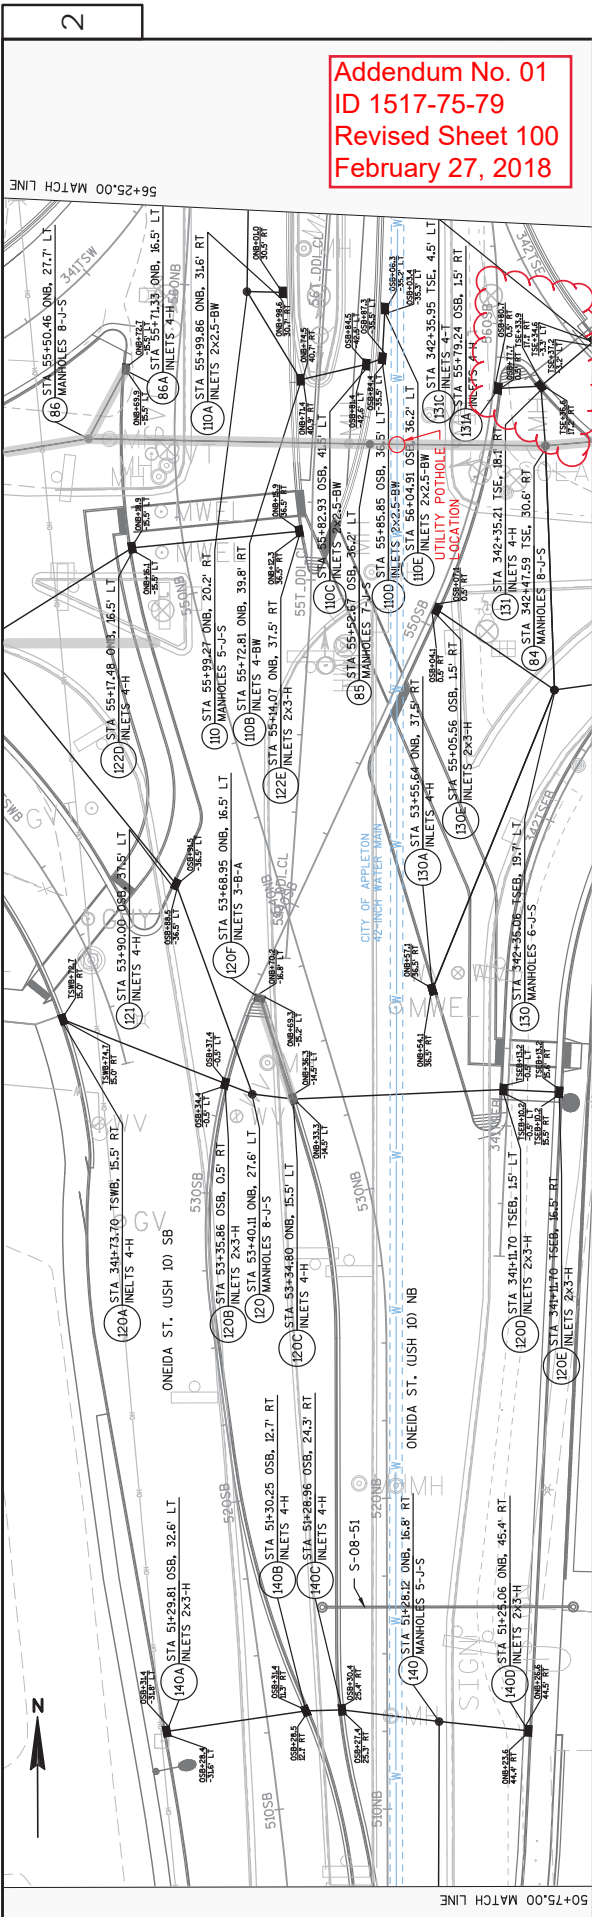

PROJECT NO: 1517-75-79	HWY: STH 441/ USH 10	COUNTY: WINNEBAGO	STORM SEWER	SHEET 100
FILE NAME : S:\NPOS\CSO\WIS441\15177574-79\SHEETS\PLAN\15177579_83\022500_SS\1517-75-79\VE-15177579-022500_SSPRSTPSE.DWG				
LAYOUT NAME : 022502B-SS				
PLOT DATE : 2.6.2018 9:53 AM				
PLOT BY : VICKMAN, GARRETT T				
PLOT NAME : 100				
PLOT SCALE : 1:1 IN=40 FT				
WISDOT/CADDSS SHEET 41				

Addendum No. 01  
ID 1517-75-79  
Revised Sheet 101  
February 27, 2018

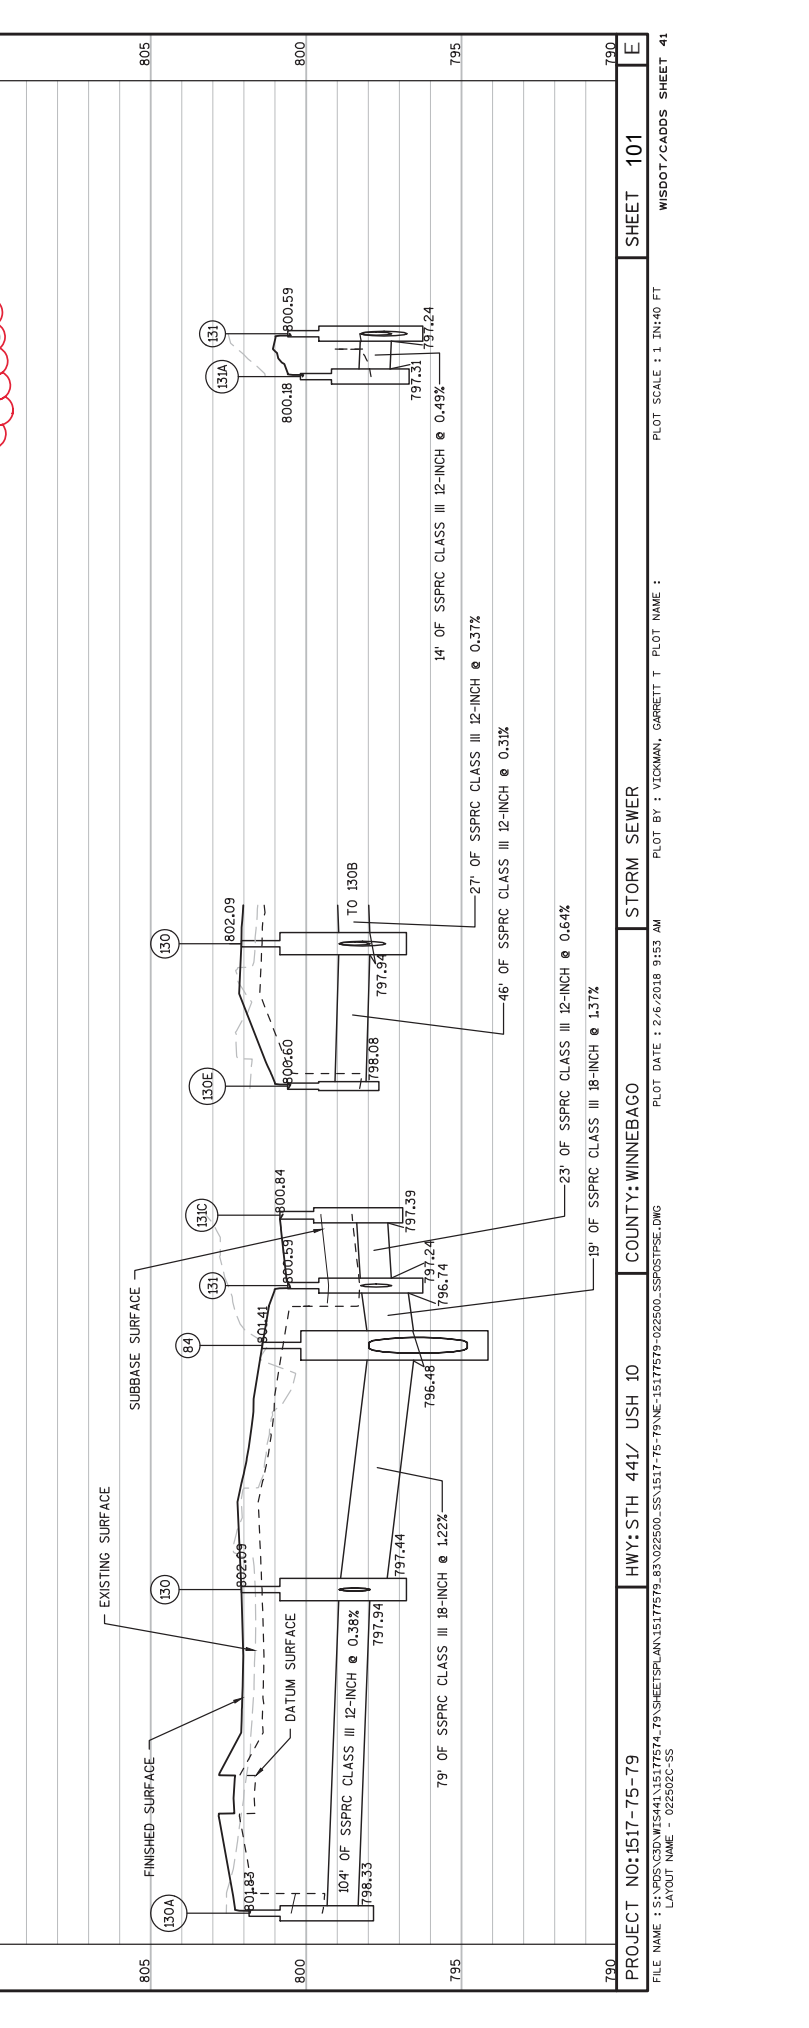
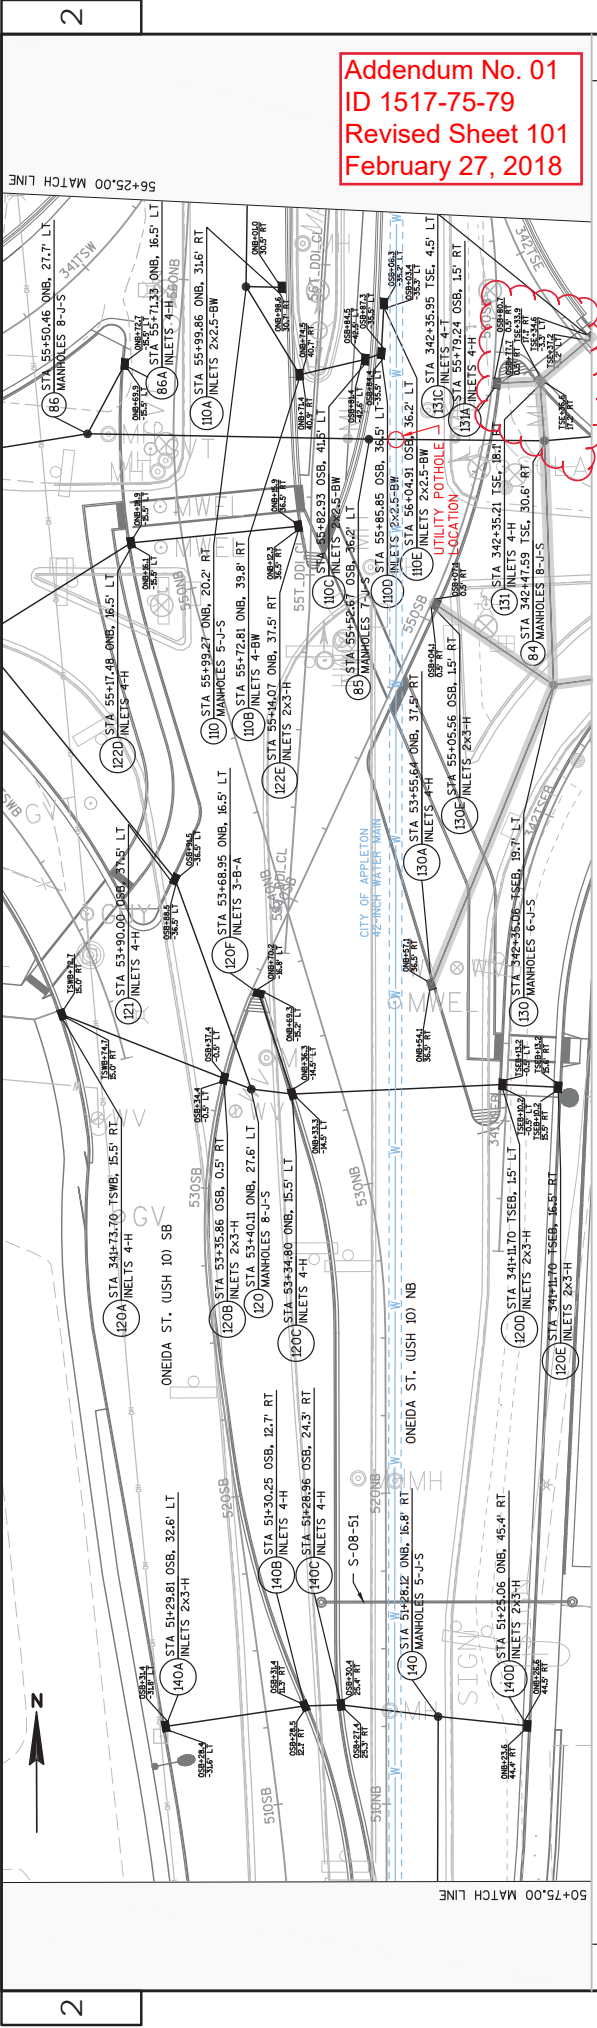


2

2

PROJECT NO: 1517-75-79	HWY: STH 441/ USH 10	COUNTY: WINNEBAGO	STORM SEWER	SHEET 101	E
FILE NAME : S:\PROJECTS\CADD\15177574-79\SSHEETSPLAN\15177579_83\022500_SS151775-79\VE-15177579-022500_SSPROFSEP.DWG					
LAYOUT NAME - 022502C-SS					
PLOT DATE : 2.6.2018 9:53 AM					
PLOT BY : VICKMAN, GARRETT T					
PLOT SCALE : 1 1/4"=40 FT					

**Addendum No. 01**  
**ID 1517-75-79**  
**Revised Sheet 102**  
**February 27, 2018**

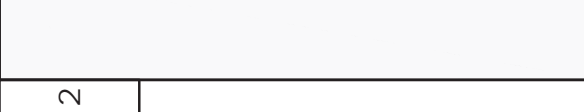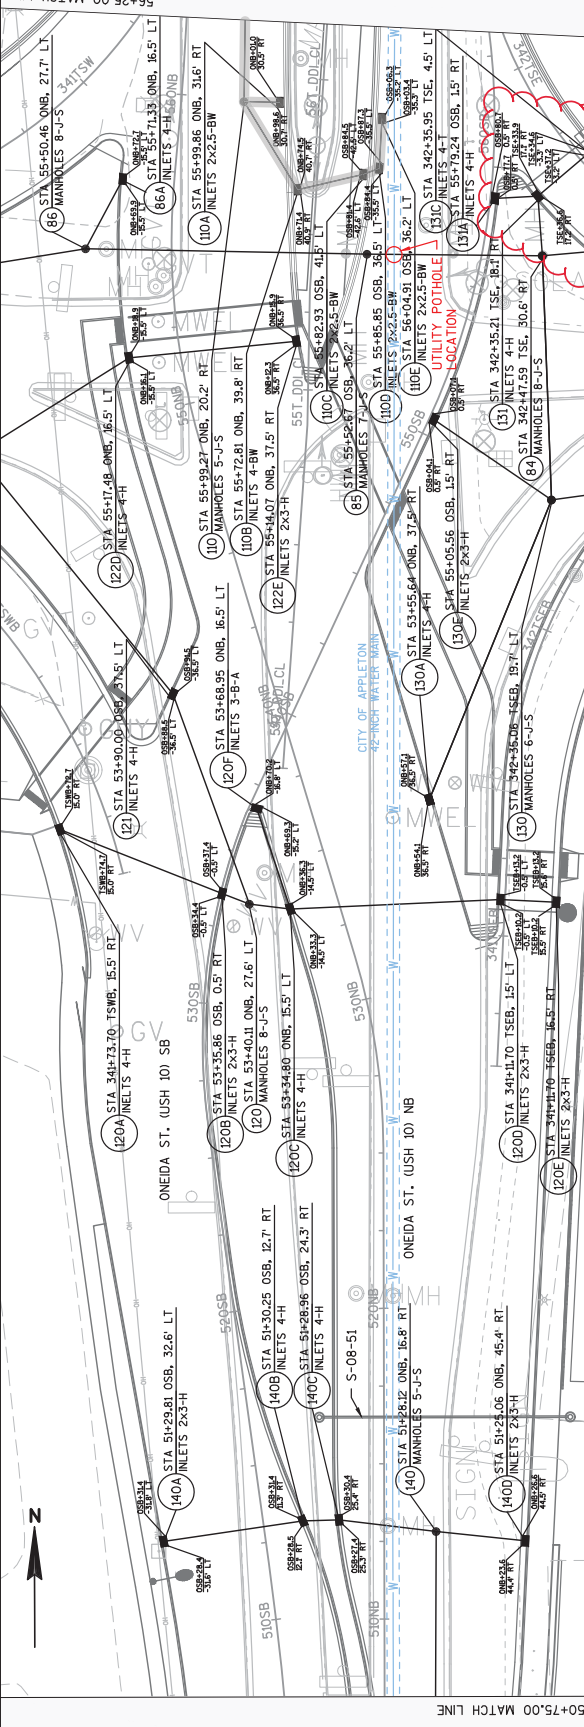

805	EXISTING SURFACE	805
800	FINISHED SURFACE	800
795	16' OF SSPPC CLASS III 12-INCH @ 0.30% 22' OF SSPPC CLASS III 18-INCH @ 0.29% 33' OF SSPPC CLASS III 18-INCH @ 0.46% 39' OF SSPPC CLASS III 27-INCH @ 0.20% 6' OF SSPPC CLASS III 18-INCH @ 0.41% 22' OF SSPPC CLASS III 18-INCH @ 0.29% 33' OF SSPPC CLASS III 18-INCH @ 0.46%	795
790	PROJECT NO: 1517-75-79 HWY: STH 441/ USH 10 COUNTY: WINNEBAGO STORM SEWER	790
FILE NAME : S:\NPD\330\WIS441\15177574-79\9\SHWTS\PLAN\15177579_83_022500_SS\1517-75-79\VE-15177579-022500_SSPOSTPSE.DWG		FILE NAME :
PLOT DATE : 2.6.2018 9:54 AM		PLOT DATE :
PLOT SCALE : 1:1 IN:40 FT		PLOT SCALE :
PLOT BY : VICKMAN, GARRETT T		PLOT NAME :
SHEET 102		SHEET 102
WISDOT/CADD SHEET 41		WISDOT/CADD SHEET 41

STORM SEWER STRUCTURE ITEMS CONTINUED

CATEGORY	STRUCTURE NUMBER	REFERENCE ALIGNMENT	STATION	OFFSET	STRUCTURE DESCRIPTION	RIM ELEVATION (FT)	DEPTH (FT)	APRON ENDWALL FOR CP/RCH		APRON ENDWALL FOR CP/RCH		MANHOLE COVERS		INLET COVERS		MANHOLES		MANHOLES		MANHOLES		INLETS		INLETS			
								12-INCH	24-INCH	18x30-INCH	TYPE J	TYPE I-S	TYPE B	TYPE A	TYPE BW	TYPE H-S	TYPE M-S	5-FT DIA.	4-FT DIA.	6-FT DIA.	7-FT DIA.	8-FT DIA.	3-FT DIA.	4-FT DIA.	2x3-FT	2x2.5-FT	2x3-FT
	1000																										
	122A	TSWB	340+13.91	14.7	INLETS 24x3-H-S	799.13	2.16						1														
	122B	TSWB	340+32.26	14.7	CATCH BASINS 5-H-S	799.11	2.77							1													
	122C	TSWB	340+32.26	14.7	INLETS 4-H-S	799.62	3.38																				
	122D	TSWB	340+32.26	14.7	INLETS 4-H-S	799.62	3.38																				
	122E	ONB	340+32.26	14.7	INLETS 4-H-S	800.36	2.72																				
	122F	ONB	340+32.26	14.7	INLETS 24x3-H	800.07	2.27																				
	130	TSWB	342+35.06	37.5	MANHOLES 6x1-S	802.09	3.40																				
	130A	ONB	342+35.06	37.5	MANHOLES 6x1-S	801.83	2.63																				
	130B	TSWB	342+53.74	15.5	INLETS 4-H-S	801.52	2.61																				
	130C	TSWB	342+53.74	15.5	INLETS 4-H-S	801.16	2.13																				
	130D	TSWB	342+70.07	19.5	INLETS 24x3-H-S	801.17	2.06																				
	130E	OSB	342+70.07	19.5	INLETS 24x3-H-S	800.60	1.64																				
	131	TSW	342+35.21	18.1	INLET 4-H	800.59	2.80																				
	131A	OSB	342+35.21	18.1	INLET 4-H	800.18	2.00																				
	131B	OSB	342+46.59	39.5	MANHOLES 4-H	800.83	2.65																				
	131C	TSW	342+35.95	4.5	INLETS 4-T	800.84	2.37																				
	131D	TSW	342+35.95	4.5	INLETS 4-T	800.84	2.37																				
	D83	TSWB	344+26.66	32.9	APRON ENDWALLS FOR CP/RCH																						
	83A	TSW	344+10.07	-19.2	INLETS MEDIAN JG-MS	798.88	2.05																				
	83C	TSWB	344+21.71	13.9	INLETS 4-H	801.88	3.70																				
	84	TSW	342+47.59	30.6	MANHOLES 8x1-S	801.41	5.35																				
	85	OSB	55+52.67	-36.2	MANHOLES 7x1-S	799.59	3.70																				
	86	ONB	55+50.46	-27.7	MANHOLES 8x1-S	800.95	5.33																				
	86A	ONB	55+71.33	-16.5	INLETS 4-H	800.03	2.41																				
	D88	TSW	340+26.08	-29.2	APRON ENDWALLS FOR CP/RCH																						
	88	TSWB	340+31.24	26.7	MANHOLES 8x1-S	800.41	4.91																				
	88A	TSWB	340+34.18	-18.7	CATCH BASINS 5-T	798.98	2.66																				
	88B	TSWB	340+34.18	12.5	CATCH BASINS 5-H-S	799.64	3.64																				
	88	TSWB	337+04.18	47.1	MANHOLES 6-I	802.61	7.87																				
	D102	TNE	343+24.60	12.3	APRON ENDWALLS FOR CP/RCH																						
	94A	ONB	60+87.80	50.0	INLETS 4-H	803.58	2.32																				
	94B	ONB	60+51.13	37.5	INLETS 4-H	804.07	2.61																				
	95A	ONB	61+38.39	37.5	INLETS 4-H	803.09	3.06																				
	95B	ONB	61+26.78	41.7	MANHOLES 1x1-S	805.09	4.68																				
	95C	ONB	60+45.86	0.5	INLETS 4-H-S	804.52	3.70																				
	95D	ONB	60+45.86	0.5	INLETS 4-H-S	804.62	3.80																				
	960	ONB	51+93.12	16.8	MANHOLES 5x1-S	803.86	5.94																				
	40A	OSB	51+92.81	-32.6	INLETS 2x2x3-H	803.17	2.69																				
	40B	OSB	51+30.25	32.7	INLETS 4-H	803.69	3.27																				
	40C	OSB	51+28.96	24.3	INLETS 4-H	803.93	3.78																				
							SUBTOTALS	0	2	1	1	1	7	0	0	0	0	0	0	0	2	1	3	1	2	1	6

2) TOP OF STRUCTURE ELEVATIONS = RIM/GRATE ELEVATION  
 3) STRUCTURE DEPTH - RIM ELEVATION - INVERT ELEVATION - RING ADJUSTMENTS (0.5') - CASTING DEPTH.  
 4) ADDITIONAL SECTIONS OF STORM SEWER PIPE JOINTS ARE INCIDENTAL TO REINFORCED CONCRETE PIPE STORM SEWER.  
 5) CONTRACTOR SHALL VERIFY EXISTING PIPE SIZES, MATERIALS AND INVERT ELEVATIONS WHEN CONNECTING NEW STORM SEWER INTO EXISTING PIPES PRIOR TO MANUFACTURING STRUCTURE.  
 6) STATION/OFFSET OF INLETS AND MANHOLES IS AT CENTER OF STRUCTURE.

Addendum No. 01  
 ID 1517-75-79  
 Revised Sheet 189  
 February 27, 2018

STORM SEWER STRUCTURE ITEMS CONTINUED

CATEGORY NUMBER	STRUCTURE REFERENCE ALIGNMENT	STATION	OFFSET	STRUCTURE DESCRIPTION	RIM ELEVATION (FT)	DEPTH (FT)	APRON ENDWALL FOR CPIC 12-INCH EACH	APRON ENDWALL FOR CPIC 24-INCH EACH	522.2619	611.0530	611.0535	611.0606	611.0606	611.0609	611.0610	611.0624	611.0639	611.0642	611.0652	611.0652	611.1005	611.1006	611.2004	611.2005	611.2006	611.2007	611.2008	611.3003	611.3004	611.3225	611.3230	611.3901	611.3902		
1000																																			
140D	ONB	51+5.06'	45.2'	INLETS 2x3-H	803.29	3.15	-	-	-	-	-	-	-	-	-	-	-	-	-	-	-	-	-	-	-	-	-	-	-	-	-	-	-	-	
141	ONB	50+04.30'	16.0'	MANHOLES 5x1-S	803.50	5.95	-	-	-	-	-	-	-	-	-	-	-	-	-	-	-	-	-	-	-	-	-	-	-	-	-	-	-	-	-
141A	OSB	50+03.28'	-29.6'	INLETS 2x3-H	802.86	3.97	-	-	-	-	-	-	-	-	-	-	-	-	-	-	-	-	-	-	-	-	-	-	-	-	-	-	-	-	-
141B	ONB	50+04.71'	37.0'	INLETS 2x3-H	803.08	3.95	-	-	-	-	-	-	-	-	-	-	-	-	-	-	-	-	-	-	-	-	-	-	-	-	-	-	-	-	-
142	ONB	49+55.68'	16.0'	MANHOLES 5x1-S	803.11	5.70	-	-	-	-	-	-	-	-	-	-	-	-	-	-	-	-	-	-	-	-	-	-	-	-	-	-	-	-	-
142A	ONB	49+55.68'	-7.5'	INLETS 4-H	803.32	3.69	-	-	-	-	-	-	-	-	-	-	-	-	-	-	-	-	-	-	-	-	-	-	-	-	-	-	-	-	-
142B	ONB	49+55.68'	-0.5'	INLETS 2x3-H	803.42	3.80	-	-	-	-	-	-	-	-	-	-	-	-	-	-	-	-	-	-	-	-	-	-	-	-	-	-	-	-	-
D144	OSB	48+35.15'	-47.2'	APRON ENDWALLS FOR CPIC 12-INCH	-	-	1	-	-	-	-	-	-	-	-	-	-	-	-	-	-	-	-	-	-	-	-	-	-	-	-	-	-	-	-
143	ONB	49+04.07'	16.0'	MANHOLES 7x1-S	802.66	5.41	-	-	-	-	-	-	-	-	-	-	-	-	-	-	-	-	-	-	-	-	-	-	-	-	-	-	-	-	-
143A	OSB	49+10.80'	-29.5'	INLETS 4-H	802.14	3.04	-	-	-	-	-	-	-	-	-	-	-	-	-	-	-	-	-	-	-	-	-	-	-	-	-	-	-	-	-
144	ONB	48+60.14'	16.7'	MANHOLES 6x1-S	802.26	5.14	-	-	-	-	-	-	-	-	-	-	-	-	-	-	-	-	-	-	-	-	-	-	-	-	-	-	-	-	-
144B	ONB	48+67.87'	-4.1'	MANHOLES 4x1-S	802.61	2.79	-	-	-	-	-	-	-	-	-	-	-	-	-	-	-	-	-	-	-	-	-	-	-	-	-	-	-	-	-
144D	ONB	48+57.90'	31.1'	INLETS 2x3-H	801.96	2.51	-	-	-	-	-	-	-	-	-	-	-	-	-	-	-	-	-	-	-	-	-	-	-	-	-	-	-	-	-
145	ONB	47+37.46'	16.0'	MANHOLES 7x1-S	800.77	4.02	-	-	-	-	-	-	-	-	-	-	-	-	-	-	-	-	-	-	-	-	-	-	-	-	-	-	-	-	-
145A	OSB	47+23.51'	-29.5'	INLETS 4-H	800.69	2.60	-	-	-	-	-	-	-	-	-	-	-	-	-	-	-	-	-	-	-	-	-	-	-	-	-	-	-	-	-
145B	ONB	47+39.82'	29.5'	INLETS 2x3-H	800.53	2.06	-	-	-	-	-	-	-	-	-	-	-	-	-	-	-	-	-	-	-	-	-	-	-	-	-	-	-	-	-
145C	ONB	47+43.12'	37.5'	INLETS 4-H	800.66	1.76	-	-	-	-	-	-	-	-	-	-	-	-	-	-	-	-	-	-	-	-	-	-	-	-	-	-	-	-	-
145D	ONB	46+14.82'	29.5'	INLET COVER TYPE H	799.88	-	-	-	-	-	-	-	-	-	-	-	-	-	-	-	-	-	-	-	-	-	-	-	-	-	-	-	-	-	-
300	MG	5+73.65'	-13.7'	MANHOLES 5x1-S	802.23	4.89	-	-	-	-	-	-	-	-	-	-	-	-	-	-	-	-	-	-	-	-	-	-	-	-	-	-	-	-	-
300A	MG	5+69.91'	17.5'	INLETS 4-H	802.19	2.63	-	-	-	-	-	-	-	-	-	-	-	-	-	-	-	-	-	-	-	-	-	-	-	-	-	-	-	-	-
300B	MG	5+58.58'	-17.6'	INLETS 4-H	802.03	2.52	-	-	-	-	-	-	-	-	-	-	-	-	-	-	-	-	-	-	-	-	-	-	-	-	-	-	-	-	-
300C	ONB	49+29.47'	36.1'	INLETS 4-H	802.43	2.84	-	-	-	-	-	-	-	-	-	-	-	-	-	-	-	-	-	-	-	-	-	-	-	-	-	-	-	-	-
				SUBTOTALS	1	0	0	0	0	0	0	0	0	0	0	0	0	0	0	0	0	0	0	0	0	0	0	0	0	0	0	0	0	0	0
				<b>PROJECT TOTALS</b>	<b>1</b>	<b>3</b>	<b>2</b>	<b>1</b>	<b>27</b>	<b>37</b>	<b>24</b>	<b>1</b>	<b>1</b>	<b>11</b>	<b>30</b>	<b>52</b>	<b>26</b>	<b>3</b>	<b>2</b>	<b>4</b>	<b>1</b>	<b>3</b>	<b>5</b>	<b>9</b>	<b>4</b>	<b>7</b>	<b>1</b>	<b>3</b>	<b>49</b>	<b>6</b>	<b>29</b>	<b>1</b>	<b>1</b>		

Addendum No. 01  
ID 1517-75-79  
Revised Sheet 190  
February 27, 2018

2) TOP OF STRUCTURE ELEVATIONS = RIM/GRATE ELEVATION  
3) STRUCTURE DEPTH - RIM ELEVATION - INVERT ELEVATION - RING ADJUSTMENTS (0.5') - CASTING DEPTH.  
4) ADDITIONAL SECTIONS OF STORM SEWER PIPE JOINTS ARE INCIDENTAL TO REINFORCED CONCRETE PIPE, STORM SEWER.  
5) CONTRACTOR SHALL VERIFY EXISTING PIPE SIZES, MATERIALS AND INVERT ELEVATIONS WHEN CONNECTING NEW STORM SEWER INTO EXISTING PIPES PRIOR TO MANUFACTURING STRUCTURE  
6) STATION/OFFSET OF INLETS AND MANHOLES IS AT CENTER OF STRUCTURE.

Addendum No. 01  
ID 1517-75-79  
Revised Sheet 193  
February 27, 2018

STORM SEWER PIPE ITEMS CONTINUED

CATEGORY	STRUCTURE NUMBER FROM TO	INVERT ELEVATION		SLOPE	520.8000 CONCRETE COLLARS EACH	STORM SEWER PIPE REINFORCED CONCRETE CLASS III												STORM SEWER PIPE CONCRETE CLASS IV		STORM SEWER PIPE COMPOSITE	
		INLET	DISCHARGE			608.0312 12-INCH LF	608.0315 15-INCH LF	608.0318 18-INCH LF	608.0324 24-INCH LF	608.0327 27-INCH LF	608.0330 30-INCH LF	608.0336 36-INCH LF	608.0342 42-INCH LF	608.2319 19x30-INCH LF	608.2329 29x45-INCH LF	608.2338 38x60-INCH LF	608.0430 30-INCH LF	608.2419 19x30-INCH LF	608.6010 10-INCH LF		
1000	122A	122B	796.09	796.05	0.41%	-	11	-	-	-	-	-	-	-	-	-	-	-	-		
	122B	122C	795.46	795.36	0.33%	-	-	-	-	-	-	-	-	-	-	-	-	30	-		
	122C	122	795.36	795.31	0.15%	-	-	-	-	-	-	-	-	-	-	-	-	35	-		
	122D	122	796.77	796.60	0.30%	-	58	-	-	-	-	-	-	-	-	-	-	-	-		
	122E	122D	796.93	796.77	0.30%	-	54	-	-	-	-	-	-	-	-	-	-	-	-		
	130	84	797.44	796.48	1.22%	-	-	79	-	-	-	-	-	-	-	-	-	-	-		
	130A	130	798.33	797.94	0.38%	-	104	-	-	-	-	-	-	-	-	-	-	-	-		
	130B	130	798.04	797.94	0.37%	-	27	-	-	-	-	-	-	-	-	-	-	-	-		
	130C	130B	798.16	798.04	0.58%	-	21	-	-	-	-	-	-	-	-	-	-	-	-		
	130D	130C	798.23	798.16	0.50%	-	14	-	-	-	-	-	-	-	-	-	-	-	-		
	130E	130	798.08	797.94	0.31%	-	46	-	-	-	-	-	-	-	-	-	-	-	-		
	131	84	796.74	796.48	1.37%	-	-	19	-	-	-	-	-	-	-	-	-	-	-		
	131A	131	797.31	797.24	0.49%	-	14	-	-	-	-	-	-	-	-	-	-	-	-		
	131B	131	797.31	797.24	0.50%	-	14	-	-	-	-	-	-	-	-	-	-	-	-		
	131C	131	797.39	797.24	0.64%	-	23	-	-	-	-	-	-	-	-	-	-	-	-		
	83	84	795.23	794.81	0.30%	1	-	-	-	-	-	-	-	-	-	-	139	-	-		
	D83	83C	797.79	797.31	2.46%	-	-	20	-	-	-	-	-	-	-	-	-	-	-		
	83A	83B	796.16	796.04	1.00%	1	-	13	-	-	-	-	-	-	-	-	-	-	-		
	83C	83A	797.31	796.16	2.46%	-	-	47	-	-	-	-	-	-	-	-	-	-	-		
	84	85	794.81	794.64	0.30%	-	-	-	-	-	-	-	-	-	-	-	56	-	-		
	85	86	794.64	794.37	0.30%	-	-	-	-	-	-	-	-	-	-	-	91	-	-		
	86	88	794.37	794.25	0.24%	-	-	-	-	-	-	-	-	-	-	-	50	-	-		
	86A	86	796.74	796.40	1.36%	-	25	-	-	-	-	-	-	-	-	-	-	-	-		
	D88	88A	795.47	795.24	1.86%	-	-	-	-	-	-	-	-	-	13	-	-	-	-		
	88	89	794.25	793.43	0.24%	1	-	-	-	-	-	-	-	-	-	-	-	-	-		
	88A	88B	795.24	795.12	0.33%	-	-	-	-	-	-	-	-	-	36	-	-	-	-		
	88B	88	795.12	795.09	0.33%	-	-	-	10	-	-	-	-	-	-	-	-	-	-		
	D102	92	795.55	797.33	2.76%	1	-	80	-	-	-	-	-	-	-	-	-	-	-		
	94A	94	800.39	800.00	0.50%	1	77	-	-	-	-	-	-	-	-	-	-	-	-		
	94B	94A	800.59	800.39	0.50%	-	41	-	-	-	-	-	-	-	-	-	-	-	-		
	94D	95C	799.97	799.94	0.29%	-	10	-	-	-	-	-	-	-	-	-	-	-	-		
	95C	95B	799.94	799.86	0.30%	-	28	-	-	-	-	-	-	-	-	-	-	-	-		
	95B	95	799.36	799.25	0.30%	1	-	35	-	-	-	-	-	-	-	-	-	-	-		
	95A	95B	799.99	799.86	0.30%	-	44	-	-	-	-	-	-	-	-	-	-	-	-		
	140	141	796.67	796.30	0.30%	-	-	-	-	124	-	-	-	-	-	-	-	-	-		
	140A	140B	799.69	799.55	0.30%	-	45	-	-	-	-	-	-	-	-	-	-	-	-		
	140B	140C	799.55	799.52	0.30%	-	12	-	-	-	-	-	-	-	-	-	-	-	-		
	140C	140	799.27	799.17	0.30%	-	31	-	-	-	-	-	-	-	-	-	-	-	-		
						6	672	654	31	133	170	0	124	0	0	0	675	0	65		
						SUBTOTAL															

STORM SEWER PIPE ITEMS CONTINUED

CATEGORY	STRUCTURE NUMBER FROM TO	INVERT ELEVATION	SLOPE	520.8000 CONCRETE COLLARS EACH	STORM SEWER PIPE REINFORCED CONCRETE CLASS III												STORM SEWER PIPE CONCRETE CLASS IV		STORM SEWER PIPE COMPOSITE
					608.0312 12-INCH LF	608.0315 15-INCH LF	608.0318 18-INCH LF	608.0324 24-INCH LF	608.0327 27-INCH LF	608.0330 30-INCH LF	608.0336 36-INCH LF	608.0342 42-INCH LF	608.2319 19x30-INCH LF	608.2329 29x45-INCH LF	608.2338 38x60-INCH LF	608.0430 30-INCH LF	608.2419 19x30-INCH LF	608.6010 10-INCH LF	
1000	140D	799.26	0.30%	-	29	-	-	-	-	-	-	-	-	-	-	-	-	-	
	141	796.30	0.30%	-	-	-	-	49	-	-	-	-	-	-	-	-	-	-	
	141A	799.02	0.30%	-	74	-	-	-	-	-	-	-	-	-	-	-	-	-	
	141B	798.86	0.30%	-	21	-	-	-	-	-	-	-	-	-	-	-	-	-	
	142	796.16	0.30%	-	-	-	-	52	-	-	-	-	-	-	-	-	-	-	
	142A	798.76	0.30%	-	7	-	-	-	-	-	-	-	-	-	-	-	-	-	
	142B	798.74	0.50%	-	17	-	-	-	-	-	-	-	-	-	-	-	-	-	
	143	796.00	0.30%	-	-	-	-	-	-	44	-	-	-	-	-	-	-	-	
	143A	798.22	0.30%	-	74	-	-	-	-	-	-	-	-	-	-	-	-	-	
	144	795.87	0.30%	-	-	-	-	-	-	-	-	-	-	-	-	-	-	-	
	D144	798.80	0.29%	-	78	-	-	-	-	-	-	-	-	123	-	-	-	-	
	144B	798.57	0.30%	-	22	-	-	-	-	-	-	-	-	-	-	-	-	-	
	144D	798.57	0.49%	-	15	-	-	-	-	-	-	-	-	-	-	-	-	-	
	145	795.50	0.50%	1	-	-	-	-	-	-	-	-	-	-	-	-	-	-	
	CC99	797.49	0.30%	1	-	-	-	-	-	-	-	-	-	-	-	-	-	33	
	145A	797.22	0.30%	-	70	-	-	-	-	-	-	-	-	-	-	-	-	-	
	145B	797.59	1.00%	-	-	-	-	-	-	-	-	-	-	-	-	-	-	-	
	145C	798.02	2.06%	1	9	-	-	-	-	-	-	-	-	-	-	-	-	-	
	300	796.09	0.16%	1	-	-	-	59	-	-	-	-	-	-	-	-	-	-	
	300A	798.69	0.29%	-	31	-	-	-	-	-	-	-	-	-	-	-	-	-	
	300B	798.63	0.17%	-	16	-	-	-	-	-	-	-	-	-	-	-	-	-	
	300C	798.71	0.30%	-	26	-	-	-	-	-	-	-	-	-	-	-	-	-	
				4	489	517	14	0	0	0	0	0	0	160	295	0	0	33	
				16	1,957	632		627	936	39	470	167	164	49	295	675	60	80	
				PROJECT TOTALS	138	5	23	5	23	5	23	5	23	5	23	5	23	5	
				142C	142D	142A	142B	142C	142D	142A	142B	142C	142D	142A	142B	142C	142D	142A	
				798.84	798.83	798.83	798.76	798.83	798.83	798.76	798.83	798.83	798.76	798.83	798.83	798.76	798.83	798.83	
				0.30%	0.30%	0.30%	0.30%	0.30%	0.30%	0.30%	0.30%	0.30%	0.30%	0.30%	0.30%	0.30%	0.30%	0.30%	

Addendum No. 01  
 ID 1517-75-79  
 Revised Sheet 194  
 February 27, 2018



Proposal Schedule of Items

Proposal ID: 20180313029 Project(s): 1517-75-73, 1517-75-79

Federal ID(s): WISC 2018157, WISC 2018158

SECTION: 0001

Contract Items

Alt Set ID:

Alt Mbr ID:

Proposal Line Number	Item ID Description	Approximate Quantity and Units	Unit Price	Bid Amount
0214	603.3559 Concrete Barrier Transition Type S42 to S56	8.000 EACH	_____.	_____.
0216	603.8000 Concrete Barrier Temporary Precast Delivered	60,450.000 LF	_____.	_____.
0218	603.8125 Concrete Barrier Temporary Precast Installed	83,100.000 LF	_____.	_____.
0220	604.0400 Slope Paving Concrete	1,675.000 SY	_____.	_____.
0222	604.0500 Slope Paving Crushed Aggregate	1,340.000 SY	_____.	_____.
0224	606.0200 Riprap Medium	212.000 CY	_____.	_____.
0226	606.0300 Riprap Heavy	2,100.000 CY	_____.	_____.
0228	608.0312 Storm Sewer Pipe Reinforced Concrete Class III 12-Inch	2,759.000 LF	_____.	_____.
0230	608.0315 Storm Sewer Pipe Reinforced Concrete Class III 15-Inch	138.000 LF	_____.	_____.
0232	608.0318 Storm Sewer Pipe Reinforced Concrete Class III 18-Inch	2,889.000 LF	_____.	_____.
0234	608.0324 Storm Sewer Pipe Reinforced Concrete Class III 24-Inch	12,910.000 LF	_____.	_____.
0236	608.0327 Storm Sewer Pipe Reinforced Concrete Class III 27-Inch	39.000 LF	_____.	_____.
0238	608.0330 Storm Sewer Pipe Reinforced Concrete Class III 30-Inch	545.000 LF	_____.	_____.
0240	608.0336 Storm Sewer Pipe Reinforced Concrete Class III 36-Inch	3,142.000 LF	_____.	_____.





Proposal Schedule of Items

Proposal ID: 20180313029 Project(s): 1517-75-73, 1517-75-79

Federal ID(s): WISC 2018157, WISC 2018158

SECTION: 0001

Contract Items

Alt Set ID:

Alt Mbr ID:

Proposal Line Number	Item ID Description	Approximate Quantity and Units	Unit Price	Bid Amount
0266	611.0430 Reconstructing Inlets	5.000 EACH	_____.	_____.
0268	611.0530 Manhole Covers Type J	22.000 EACH	_____.	_____.
0270	611.0535 Manhole Covers Type J-Special	34.000 EACH	_____.	_____.
0272	611.0606 Inlet Covers Type B	1.000 EACH	_____.	_____.
0274	611.0609 Inlet Covers Type B-A	1.000 EACH	_____.	_____.
0276	611.0610 Inlet Covers Type BW	11.000 EACH	_____.	_____.
0278	611.0612 Inlet Covers Type C	33.000 EACH	_____.	_____.
0280	611.0624 Inlet Covers Type H	57.000 EACH	_____.	_____.
0282	611.0639 Inlet Covers Type H-S	26.000 EACH	_____.	_____.
0284	611.0642 Inlet Covers Type MS	19.000 EACH	_____.	_____.
0286	611.0652 Inlet Covers Type T	2.000 EACH	_____.	_____.
0288	611.0654 Inlet Covers Type V	117.000 EACH	_____.	_____.
0290	611.1005 Catch Basins 5-FT Diameter	10.000 EACH	_____.	_____.
0292	611.1006 Catch Basins 6-FT Diameter	4.000 EACH	_____.	_____.
0294	611.2004 Manholes 4-FT Diameter	23.000 EACH	_____.	_____.
0296	611.2005 Manholes 5-FT Diameter	9.000 EACH	_____.	_____.
0298	611.2006 Manholes 6-FT Diameter	21.000 EACH	_____.	_____.



## Proposal Schedule of Items

Proposal ID: 20180313029 Project(s): 1517-75-73, 1517-75-79

Federal ID(s): WISC 2018157, WISC 2018158

SECTION: 0001

Contract Items

Alt Set ID:

Alt Mbr ID:

Proposal Line Number	Item ID Description	Approximate Quantity and Units	Unit Price	Bid Amount
0300	611.2007 Manholes 7-FT Diameter	9.000 EACH	_____.	_____.
0302	611.2008 Manholes 8-FT Diameter	17.000 EACH	_____.	_____.
0304	611.3003 Inlets 3-FT Diameter	1.000 EACH	_____.	_____.
0306	611.3004 Inlets 4-FT Diameter	97.000 EACH	_____.	_____.
0308	611.3225 Inlets 2x2.5-FT	61.000 EACH	_____.	_____.
0310	611.3230 Inlets 2x3-FT	34.000 EACH	_____.	_____.
0312	611.3901 Inlets Median 1 Grate	1.000 EACH	_____.	_____.
0314	611.3902 Inlets Median 2 Grate	9.000 EACH	_____.	_____.
0316	611.8110 Adjusting Manhole Covers	19.000 EACH	_____.	_____.
0318	611.8115 Adjusting Inlet Covers	52.000 EACH	_____.	_____.
0320	612.0406 Pipe Underdrain Wrapped 6-Inch	3,700.000 LF	_____.	_____.
0322	612.0408 Pipe Underdrain Wrapped 8-Inch	2,450.000 LF	_____.	_____.
0324	612.0806 Apron Endwalls for Underdrain Reinforced Concrete 6-Inch	1.000 EACH	_____.	_____.
0326	614.0150 Anchor Assemblies for Steel Plate Beam Guard	1.000 EACH	_____.	_____.
0328	614.0397 Guardrail Mow Strip Emulsified Asphalt	3,416.000 SY	_____.	_____.
0330	614.0905 Crash Cushions Temporary	8.000 EACH	_____.	_____.



Proposal Schedule of Items

Proposal ID: 20180313029 Project(s): 1517-75-73, 1517-75-79

Federal ID(s): WISC 2018157, WISC 2018158

SECTION: 0001

Contract Items

Alt Set ID:

Alt Mbr ID:

Proposal Line Number	Item ID Description	Approximate Quantity and Units	Unit Price	Bid Amount
0878	SPV.0060 Special 410. Plaques Sequence Identification	4.000 EACH	_____.	_____.
0880	SPV.0060 Special 650. Utility Line Opening	1.000 EACH	_____.	_____.
0882	SPV.0060 Special 651. Adjusting Sanitary Manhole Covers	17.000 EACH	_____.	_____.
0884	SPV.0060 Special 652. Adjusting Water Valves	23.000 EACH	_____.	_____.
0886	SPV.0060 Special 653. Adjusting Water Curb Stops	23.000 EACH	_____.	_____.
0888	SPV.0075 Special 001. Street Sweeping	140.000 HRS	_____.	_____.
0890	SPV.0085 Special 001. Pond Edge Seed	485.000 LB	_____.	_____.
0892	SPV.0090 Special 001. Concrete Curb and Gutter 18-Inch Type D SHES	141.000 LF	_____.	_____.
0894	SPV.0090 Special 002. Concrete Curb Pedestrian A	81.000 LF	_____.	_____.
0896	SPV.0090 Special 003. Concrete Barrier Type S56 (36-Inch Wide Base)	3,799.000 LF	_____.	_____.
0898	SPV.0090 Special 004. Concrete Barrier Type S56A (36-Inch Wide Base)	270.000 LF	_____.	_____.
0900	SPV.0090 Special 100. Trenched Rodent Protection	2,145.000 LF	_____.	_____.
0902	SPV.0090 Special 200. Maintain and Remove Concrete Barrier Temporary Precast Left In Place	16,904.000 LF	_____.	_____.
0904	SPV.0090 Special 201. Concrete Barrier Temporary Precast Anchoring	14,601.000 LF	_____.	_____.



Proposal Schedule of Items

Proposal ID: 20180313029 Project(s): 1517-75-73, 1517-75-79

Federal ID(s): WISC 2018157, WISC 2018158

SECTION: 0001

Contract Items

Alt Set ID:

Alt Mbr ID:

Proposal Line Number	Item ID Description	Approximate Quantity and Units	Unit Price	Bid Amount
0958	SPV.0180 Special 006. Colored & Stamped Concrete 5-Inch, Color 16293	4,377.000 SY	_____.	_____.
0960	SPV.0180 Special 007. Colored Concrete 5-Inch	627.000 SY	_____.	_____.
0962	SPV.0180 Special 008. Colored Concrete 10-Inch	151.000 SY	_____.	_____.
0964	SPV.0195 Special 001. Cold Patch	20.000 TON	_____.	_____.
0966	305.0500 Shaping Shoulders	72.000 STA	_____.	_____.
Section: 0001			Total:	_____.
			Total Bid:	_____.